

NOTE

- 1 DFC WORKS ARE SHOWN IN RED.
2 IR NEW WORKS ARE SHOWN IN VIOLET.
3 ALL DIMENSIONS ARE SHOWN IN METERS.
4 THIS DRAWING IS PREPARED BASED ON LATEST SURVEY DATA HELD ON APRIL-2022. GTS BENCH
5 MARK OF 261.850M CONSIDERED ON TOP OF CANAL BRIDGE ABUTMENT AT DORRAH VALLEY ALONG THE
6
7 DFC-NEW CHAINAGE OF 1075.950M IS WITH REFERENCE TO THE IR KM OF 187.500KM END OF KM OF
8 CP-30/SECTION P-3 PILKHAJEND AGAINST THE EXISTING DFC CHAINAGE. 116277.742M ISSUED BY
9 ILMU SCIMDI 10/01/2022 SURVEY 2022. 17.00% CUSHION DITCH DOWN IN SSCM ON GE-14
10 BALLAST PROFILE HAS BEEN PROVIDED ACCORDING TO THE CLAUSE 1.11.3 OF STANDARD SCHEDULE
11 CONTRACT DOCUMENTS FOR RAILWAY PROJECTS. SEE SPECIFICATION PART 1000 AND 1000A
12 ON PAGE 17. SPECIFICATIONS & RECOMMENDATIONS 2. TWO LAYER SYSTEM FGD.


DRG NO - 301-2/AL/A/1297

REFERENCE DRAWINGS :


1. FOR KEY PLAN REFER DRAWING NO. 301-2/AL/0001
2. FOR LEGEND AND ABBREVIATIONS REFER DRAWING NO. 301-2/AL/1000
3. FOR TYPICAL SECTION OF BALLAST PROFILE (FL-RL) REFFER DRG. NO. 301-2/TK/TFD/-004 (TR.1952)

0	03.10.2024	SUBMISSION OF AS-BUILT DRAWING	FOR APPROVAL
REV.	DATE	REVISION DETAILS	PURPOSE OF ISSUE

LEGEND:

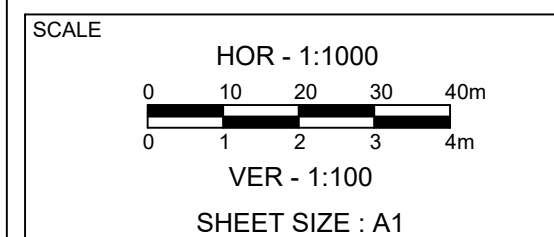

-
- IR TRACK
 DFCC TRACK
 DFCC FUTURE PROPOSALS
 STRUCTURE / BUILDING
 DFCC TOE LINE
 DFCC FORMATION
 RETAINING WALL
 ROAD
 STREAM, DRAIN, NALA, CANAL,
 FENCE
 POWER LINES
 TBM
 ELECTRIC POLE/OHE MAST
 IR RAILWAY BOUNDARY
 DFCC BOUNDARY
- The legend defines the following symbols:
 - IR TRACK: Solid black line.
 - DFCC TRACK: Dashed blue line.
 - DFCC FUTURE PROPOSALS: Dashed red line.
 - STRUCTURE / BUILDING: Red hatched area.
 - DFCC TOE LINE: Solid purple line.
 - DFCC FORMATION: Solid blue line.
 - RETAINING WALL: Solid orange line.
 - ROAD: Solid black line with cross-ticks.
 - STREAM, DRAIN, NALA, CANAL, FENCE: Wavy blue line.
 - POWER LINES: Line with cross-ticks.
 - TBM: Circle with 'TBM' text and a downward arrow.
 - ELECTRIC POLE/OHE MAST: Circle with a cross symbol.
 - IR RAILWAY BOUNDARY: Dashed black line.
 - DFCC BOUNDARY: Dashed purple line.

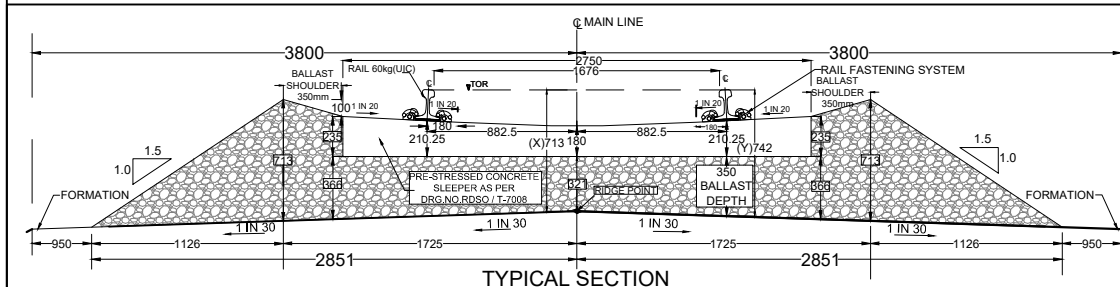

TRACK STRUCTURE		
RAIL SECTION: 60Kg/m (UIC 60Kg/m) DFC LINE: 60Kg/m (UIC 60Kg/m) IR MAIN LINE: 52Kg/m	Difference between FL- RL (Below Rail Seat)	
	IR Line	DFC
	172mm	172mm
RUBBER PAD	6mm	10mm
SLEEPER DEPTH	210mm	210mm
BALLAST CUSHION	300mm	350mm
Total Depth (FL TO RL)	688mm	742mm

OWNER

DEDICATED FREIGHT CORRIDOR CORPORATION OF INDIA LTD.



एनईपी
सेक्रेटरीजेट फ्रेट कोरीलो

ENGINEER:

DB Engineering & Consulting GmbH
Deutsche Bahn Engineering & Consulting GmbH

CONTRACTOR

GIL - TPL JV



SUBMITTED BY	GIL - TPL JV		
	DATED	NAME	SIGNATURE
PREPARED BY			
CHECKED BY	03.10.2024	VIJAY PRATAP	
APPROVED BY	03.10.2024	PARASURAM KOTYADA	

APPROVED BY	DEUTSCHE BAHN ENGINEERING & CONSULTING GMBH
-------------	---

	DATED	NAME	SIGNATURE
Sr. DE./CHIEF ENGINEER		SURESH K.YALANGI	
CHIEF TRACK ENGINEER		RAJ PAL SINGH	
T.L.		H.D. VIDJAK	

STAMP

A AS-BUILT DRAWING
TR. Ref.....
ENGINEER Sign.:

EMPLOYER (DFCCIL):	DEDICATED FREIGHT CORRIDOR CORPORATION OF INDIA LTD
--------------------	---

AS BUILT DRAWING

TITLE AS-BUILT PLAN AND PROFILE FROM IR KM: 335.500 TO 336.000 FROM DFC KM: 1226.375 to 1226.875	DFCC APPR. NO. -	STATUS A
	ENGG. APPR. NO. -	
	DRG. NO. -301-2/AL/A/1297	
	SHEET NO. : 1 OF 1	
	DATE : 03.10.2024	

 TD |