
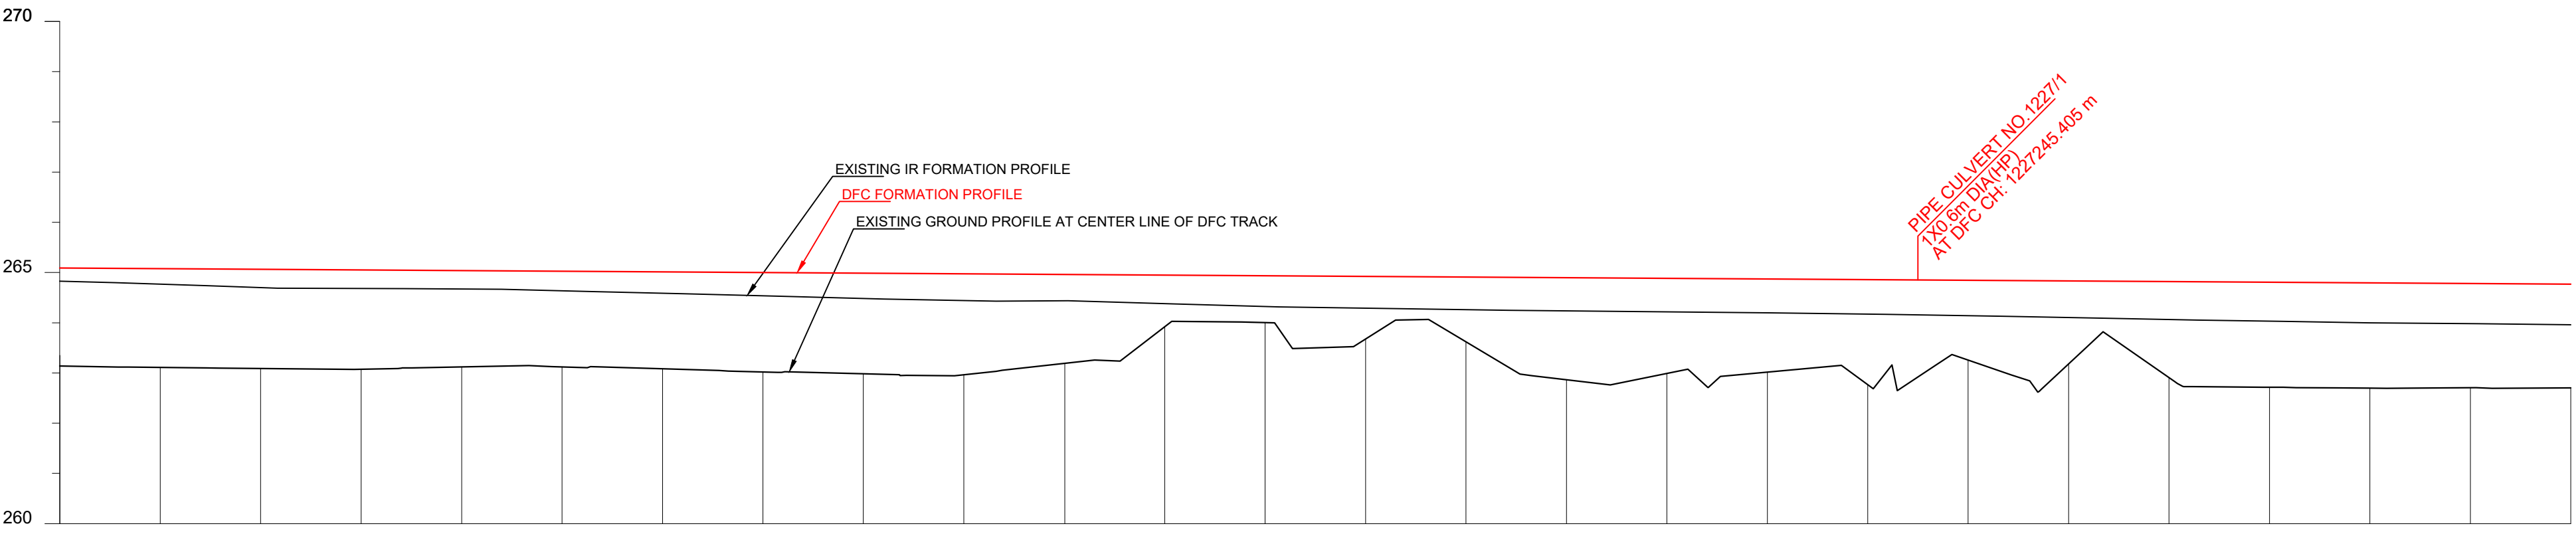


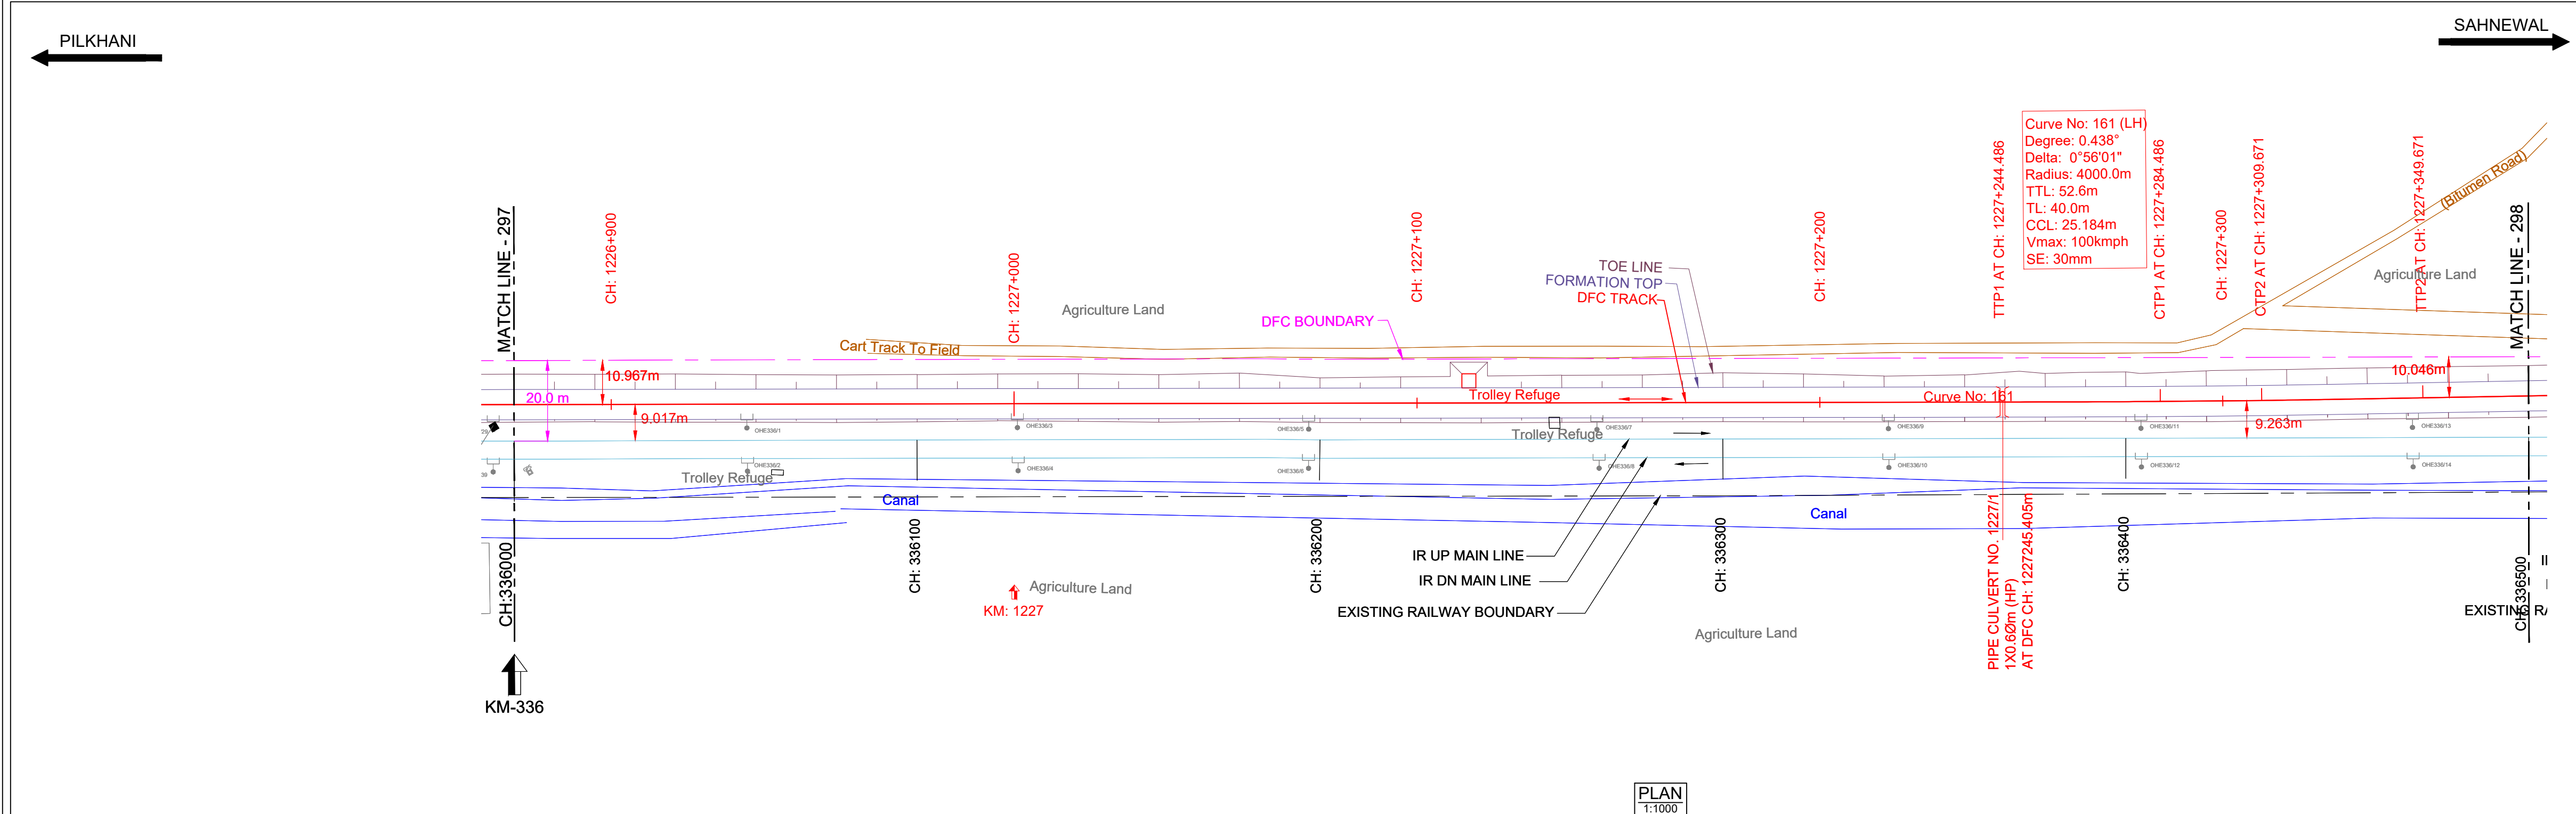

HORIZONTAL ALIGNMENT	L = 1774.686m																				TL= 40m	R = -4000m	TL= 40m	L = 273.505m
VERTICAL ALIGNMENT	L=1921.354 m 1 IN 1556.943 F																							
TRACK DISTANCE FROM EXISTING NEAREST IR UP MAIN LINE TO DFC MAIN LINE	9.055																							
HEIGHT OF BANKING(+) / DEPTH OF CUTTING(-) (PFL-GL)	+1.952																							
EXG GROUND LEVEL AT CENTER LINE OF DFC TRACK (GL)	-263.139																							
EXG GROUND LEVEL AT TOE LOCATION OF DFC TRACK	-263.085																							
DIFFERENCE BETWEEN DFC FORMATION LEVEL AND EXG.FORMATION LEVEL.(PFL-EFL)	0.261																							
DFC FORMATION LEVEL (PFL)	-265.091																							
EXG. FORMATION LEVEL OF EXG IR UP MAIN LINE (EFL)	-264.830																							
DIFFERENCE BETWEEN DFC RAIL LEVEL AND EXG. RAIL LEVEL (PRL - ERL)	0.302																							
DFC RAIL LEVEL (PRL)	-265.804																							
EXG.RAIL LEVEL OF NEAREST IR UP MAIN LINE(ERL)	-265.502																							
EQUIVALENT CHAINAGE ON DFC TRACK	-1226875.3																							
EXISTING IR CHAINAGE	336000.0																							

L - SECTION

NOTE:-

- DFCC WORKS ARE SHOWN IN RED.
- IR NEW WORKS ARE SHOWN IN VIOLET.
- ALL DIMENSIONS ARE SHOWN IN METRES.
- THIS DRAWING IS PREPARED BASED ON LATEST SURVEY DATA HELD ON APRIL-2022. GTS BENCH MARK OF 261.850M CONSIDERED ON TOP OF CANAL BRIDGE ABUTMENT AT DORAHA VILLAGE ALONG THE NH1.
- DFC NEW CHAINAGE OF 1075.950M IS WITH REFERENCE TO THE IR KM OF 187.500KM END OF KM OF CP-303(SECTION P-3 PILKHANI END) AGAINST THE EXISTING DFC CHAINAGE. 116277.742M ISSUED VIDE LETTER NO. COM/DFCC/UM/SURVEY/2021-301-230116-011173.DT. 17.01.2023.
- BALLAST PROFILE HAS BEEN PROVIDED ACCORDING TO THE CLAUSE 1.11.3 OF STANDARD SCHEDULE OF DIMENSION(EASTERN CORRIDOR) & THE BALLAST CUSHION DIMENSION SHOWN IN 35CM ON GE-14 PARA 17. SPECIFICATIONS & RECOMMENDATIONS 2. TWO LAYER SYSTEM FIG.10.

REFERENCE DRAWINGS :-

- FOR KEY PLAN REFER DRAWING NO. 301-2/AL/0001
- FOR LEGEND AND ABBREVIATIONS REFER DRAWING NO. 301-2/AL/1000
- FOR TYPICAL SECTION OF BALLAST PROFILE (FL-RL) REFER DRG. NO. 301-2/TK/TFD/-004 (TR.1952)

03.10.2024SUBMISSION OF AS-BUILT DRAWINGFOR APPROVAL

REV. DATE REVISION DETAILS PURPOSE OF ISSUE

SCALE
HOR - 1:1000
VER - 1:100
SHEET SIZE : A1

LEGEND:

- IR TRACK
- DFCC TRACK
- DFCC FUTURE PROPOSALS
- STRUCTURE / BUILDING
- DFCC TOE LINE
- DFCC FORMATION
- RETAINING WALL
- ROAD
- STREAM, DRAIN, NALA, CANAL.
- FENCE
- POWER LINES
- TBM
- ELECTRIC POLE/OHE MAST
- IR RAILWAY BOUNDARY
- DFCC BOUNDARY

TRACK STRUCTURE

RAIL SECTION: 60Kg/m (UIC 60Kg/m)	Difference between FL- RL (Below Rail Seat)	
DFC LINE: 60Kg/m (UIC 60Kg/m)	IR Line	DFC
IR MAIN LINE: 52Kg/m	172mm	172mm
RUBBER PAD	6mm	10mm
SLEEPER DEPTH	210mm	210mm
BALLAST CUSHION	300mm	350mm
Total Depth (FL TO RL)	688mm	742mm

OWNER

DEDICATED FREIGHT CORRIDOR CORPORATION OF INDIA LTD.
(A GOVERNMENT OF INDIA ENTERPRISE)
PROJECT OFFICE(AMBALA UNIT): OLD RAILWAY COLONY (NEAR ANAND MARKET),AMBALA CANTT-133001.
CORPORATE IDENTITY NO. : U60232DL2006GGI155068

ENGINEER:

DB Engineering & Consulting GmbH
Deutsche Bahn Engineering & Consulting GmbH

CONTRACTOR:

GIL - TPL JV
GAR TATA

SUBMITTED BY

GIL - TPL JV

PREPARED BY

DATED

NAME

SIGNATURE

CHECKED BY

03.10.2024

VIJAY PRATAP

APPROVED BY

03.10.2024

PARASURAM KOTYADA

APPROVED BY

DEUTSCHE BAHN ENGINEERING & CONSULTING GMBH

Sr. DE./CHIEF ENGINEER

SURESH K.YALANGI

CHIEF TRACK ENGINEER

RAJ PAL SINGH

T.L.

H.D. VIDJAK

STAMP

A AS-BUILT DRAWING
TR. Ref.....
ENGINEER Sign.:

EMPLOYER (DFCCIL):

DEDICATED FREIGHT CORRIDOR CORPORATION OF INDIA LTD.

AS BUILT DRAWING

TITLE

AS-BUILT PLAN AND PROFILE

FROM IR KM: 336.000 TO 336.500

FROM DFC KM: 1226.875 TO 1227.375

DFCC APPR. NO. -

ENG. APPR. NO. -

DRG. NO. -301-2/AL/A/1298

SHEET NO. : 1 OF 1

DATE : 03.10.2024

STATUS

A

TR.