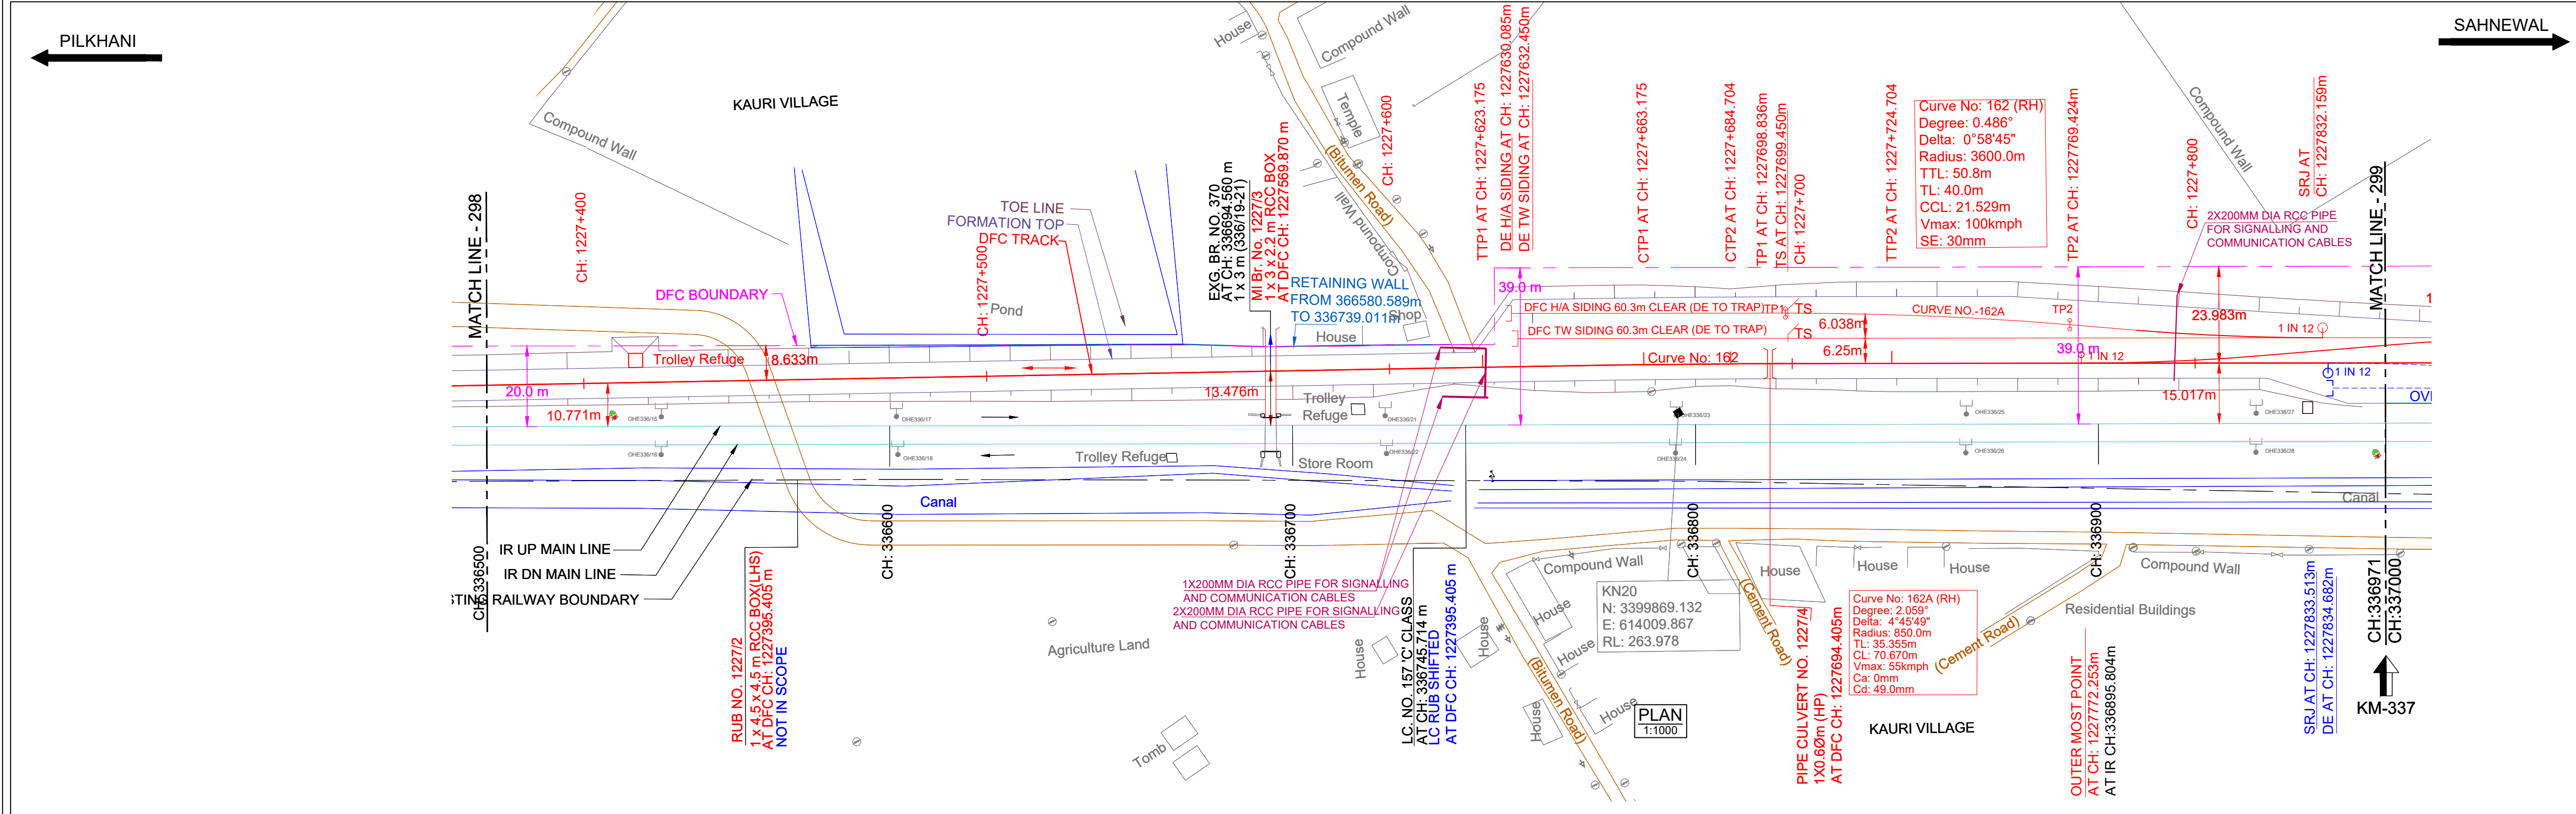


HORIZONTAL ALIGNMENT	L = 273.505m TL= 40m R =3600m TL= 40m L = 2876.804m																								
VERTICAL ALIGNMENT	L=1921.354 m 1 IN 1556.943 F																								
TRACK DISTANCE FROM EXISTING NEAREST IR UP MAIN LINE TO DFC MAIN LINE	10.271																								
HEIGHT OF BANKING(+) / DEPTH OF CUTTING(-) (PFL-GL)	+2.067																								
EXG GROUND LEVEL AT CENTER LINE OF DFC TRACK (GL)	-262.702	-262.648	-262.562	-262.515	-262.438	-262.342	-262.105	-262.031	-261.524	-261.477	-261.575	-262.186	-264.258	-263.156	-262.889	-263.376	-263.128	-262.510	-262.410	-262.462	-262.466	-262.500	-262.607	-262.547	-262.487
EXG GROUND LEVEL AT TOE LOCATION OF DFC TRACK	-262.773	-262.658	-262.618	-262.643	-262.600	-260.182	-260.376	-260.486	-260.450	-262.294	-261.820	-262.383	-264.107	-263.246	-262.579	-263.152	-263.026	-262.622	-262.575	-262.579	-262.527	-262.541	-262.601	-262.559	-262.511
DIFFERENCE BETWEEN DFC FORMATION LEVEL AND EXG.FORMATION LEVEL.(PFL-EFL)	0.810	0.816	0.823	0.825	0.829	0.829	0.829	0.833	0.825	0.811	0.796	0.697	0.588	0.618	0.671	0.713	0.750	0.786	0.796	0.805	0.815	0.826	0.831	0.822	0.819
DFC FORMATION LEVEL (PFL)	-264.769	-264.757	-264.744	-264.731	-264.718	-264.705	-264.692	-264.679	-264.667	-264.654	-264.641	-264.628	-264.615	-264.602	-264.590	-264.577	-264.564	-264.551	-264.538	-264.525	-264.512	-264.500	-264.487	-264.474	-264.467
EXG. FORMATION LEVEL OF EXG IR UP MAIN LINE (EFL)	-263.960	-263.941	-263.921	-263.905	-263.889	-263.876	-263.863	-263.847	-263.841	-263.843	-263.845	-263.931	-264.027	-263.984	-263.918	-263.864	-263.814	-263.765	-263.742	-263.720	-263.674	-263.656	-263.652	-263.648	-263.648
DIFFERENCE BETWEEN DFC RAIL LEVEL AND EXG. RAIL LEVEL (PRL - ERL)	0.851	0.857	0.864	0.867	0.871	0.870	0.871	0.874	0.867	0.852	0.837	0.738	0.629	0.660	0.712	0.754	0.791	0.827	0.837	0.847	0.867	0.867	0.872	0.863	0.860
DFC RAIL LEVEL (PRL)	-265.483	-265.470	-265.457	-265.444	-265.431	-265.418	-265.406	-265.393	-265.380	-265.367	-265.354	-265.341	-265.329	-265.316	-265.303	-265.290	-265.277	-265.264	-265.251	-265.239	-265.226	-265.213	-265.200	-265.187	-265.180
EXG.RAIL LEVEL OF NEAREST IR UP MAIN LINE(ERL)	-264.632	-264.613	-264.593	-264.577	-264.561	-264.548	-264.535	-264.519	-264.513	-264.515	-264.517	-264.603	-264.699	-264.656	-264.590	-264.536	-264.486	-264.437	-264.414	-264.392	-264.346	-264.328	-264.324	-264.320	-264.320
EQUIVALENT CHAINAGE ON DFC TRACK	-1227375.3	-1227395.3	-1227415.3	-1227435.3	-1227455.3	-1227475.3	-1227495.3	-1227515.3	-1227535.3	-1227555.3	-1227575.3	-1227595.3	-1227615.3	-1227635.3	-1227655.3	-1227675.3	-1227695.3	-1227715.3	-1227735.3	-1227755.3	-1227775.3	-1227795.3	-1227815.3	-1227835.3	-1227855.3
EXISTING IR CHAINAGE	336500.0	336520.0	336540.0	336560.0	336580.0	336600.0	336620.0	336640.0	336660.0	336680.0	336700.0	336720.0	336740.0	336760.0	336780.0	336800.0	336820.0	336840.0	336860.0	336880.0	336900.0	336920.0	336940.0	336960.0	336971.3
																									337000.0

L - SECTION

NOTE:-

- DFCC WORKS ARE SHOWN IN RED.
- IR NEW WORKS ARE SHOWN IN VIOLET.
- ALL DIMENSIONS ARE SHOWN IN METRES.
- THIS DRAWING IS PREPARED BASED ON LATEST SURVEY DATA HELD ON APRIL-2022. GTS BENCH MARK OF 261.850M CONSIDERED ON TOP OF CANAL BRIDGE ABUTMENT AT DORAHA VILLAGE ALONG THE NH1.
- DFC NEW CHAINAGE OF 1075.950M IS WITH REFERENCE TO THE IR KM OF 187.500KM END OF KM OF CP-303(SECTION P-3 PILKHANI END) AGAINST THE EXISTING DFC CHAINAGE. 116277.742M ISSUED VIDE LETTER NO. COM/DFCC/UM/SURVEY/2021-301-230116-011173 DT. 17.01.2023.
- BALLAST PROFILE HAS BEEN PROVIDED ACCORDING TO THE CLAUSE 1.11.3 OF STANDARD SCHEDULE OF DIMENSION(EASTERN CORRIDOR) & THE BALLAST CUSHION DIMENSION SHOWN IN 35CM ON GE-14 PARA 17. SPECIFICATIONS & RECOMMENDATIONS 2. TWO LAYER SYSTEM FIG.10.

REFERENCE DRAWINGS :-

- FOR KEY PLAN REFER DRAWING NO. 301-2/AL/0001
- FOR LEGEND AND ABBREVIATIONS REFER DRAWING NO. 301-2/AL/1000
- FOR TYPICAL SECTION OF BALLAST PROFILE (FL-RL) REFER DRG. NO. 301-2/TK/TFD/-004 (TR.1952)

03.10.2024SUBMISSION OF AS-BUILT DRAWINGFOR APPROVAL

REV. DATE REVISION DETAILS PURPOSE OF ISSUE

SCALE
HOR - 1:1000
VER - 1:100
SHEET SIZE : A1

LEGEND:

- IR TRACK
- DFCC TRACK
- DFCC FUTURE PROPOSALS
- STRUCTURE / BUILDING
- DFCC TOE LINE
- DFCC FORMATION
- RETAINING WALL
- ROAD
- STREAM, DRAIN, NALA, CANAL.
- FENCE
- POWER LINES
- TBM
- ELECTRIC POLE/OHE MAST
- IR RAILWAY BOUNDARY
- DFCC BOUNDARY

TYPICAL SECTION

TRACK STRUCTURE		
RAIL SECTION: 60Kg/m (UIC 60Kg/m) DFC LINE: 60Kg/m (UIC 60Kg/m) IR MAIN LINE: 52Kg/m	Difference between FL- RL (Below Rail Seat)	
	IR Line	DFC
RUBBER PAD	172mm	172mm
SLEEPER DEPTH	210mm	210mm
BALLAST CUSHION	300mm	350mm
Total Depth (FL TO RL)	688mm	742mm

OWNER
DEDICATED FREIGHT CORRIDOR CORPORATION OF INDIA LTD.
(A GOVERNMENT OF INDIA ENTERPRISE)
PROJECT OFFICE(AMBALA UNIT): OLD RAILWAY COLONY (NEAR ANAND MARKET),AMBALA CANTT-133001.
CORPORATE IDENTITY NO. : U60232DL2006GGI155068

ENGINEER:
DB Engineering & Consulting GmbH
Deutsche Bahn Engineering & Consulting GmbH

CONTRACTOR:
GIL - TPL JV
GAR TATA

SUBMITTED BY	GIL - TPL JV		
	DATED	NAME	SIGNATURE
PREPARED BY			
CHECKED BY	03.10.2024	VIJAY PRATAP	
APPROVED BY	03.10.2024	PARASURAM KOTYADA	

APPROVED BY	DEUTSCHE BAHN ENGINEERING & CONSULTING GMBH		
	DATED	NAME	SIGNATURE
Sr. DE./CHIEF ENGINEER		SURESH K.YALANGI	
CHIEF TRACK ENGINEER		RAJ PAL SINGH	
T.L.		H.D. VIDJAK	

STAMP
A AS-BUILT DRAWING
TR. Ref.:.....
ENGINEER Sign.:.....

EMPLOYER (DFCCIL): DEDICATED FREIGHT CORRIDOR CORPORATION OF INDIA LTD.

TITLE
AS-BUILT PLAN AND PROFILE
FROM IR KM: 336.500 TO 337.000
FROM DFC KM: 1227.375 TO 1227.847

DFCC APPR. NO. -
ENGG. APPR. NO. -
DRG. NO. :301-2/AL/A/1299
SHEET NO. :1 OF 1
DATE : 03.10.2024

STATUS
A

TR.