
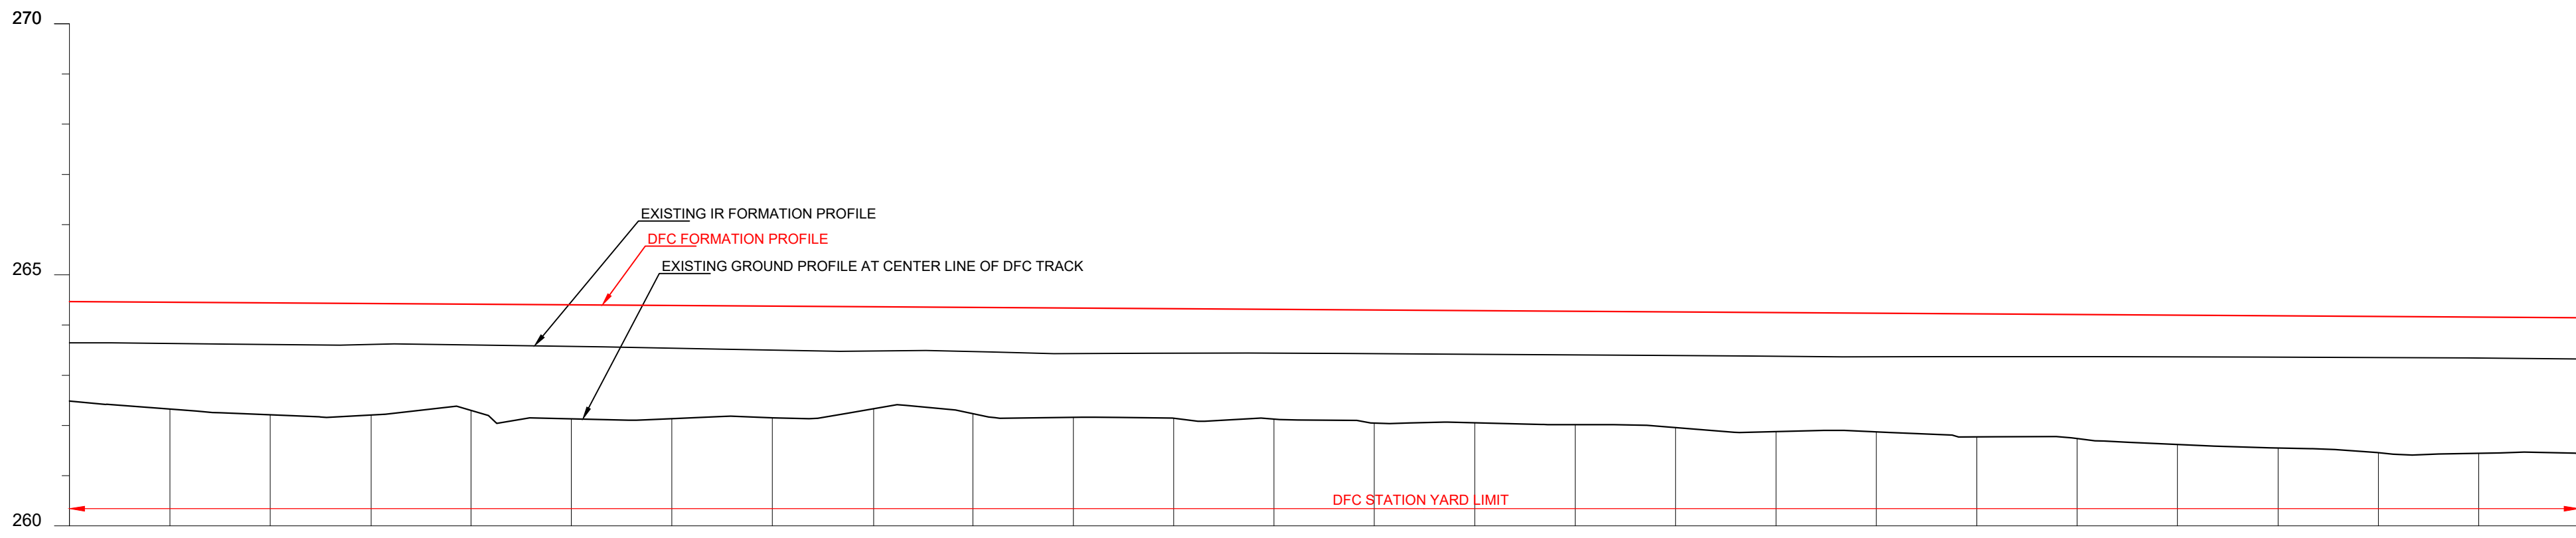


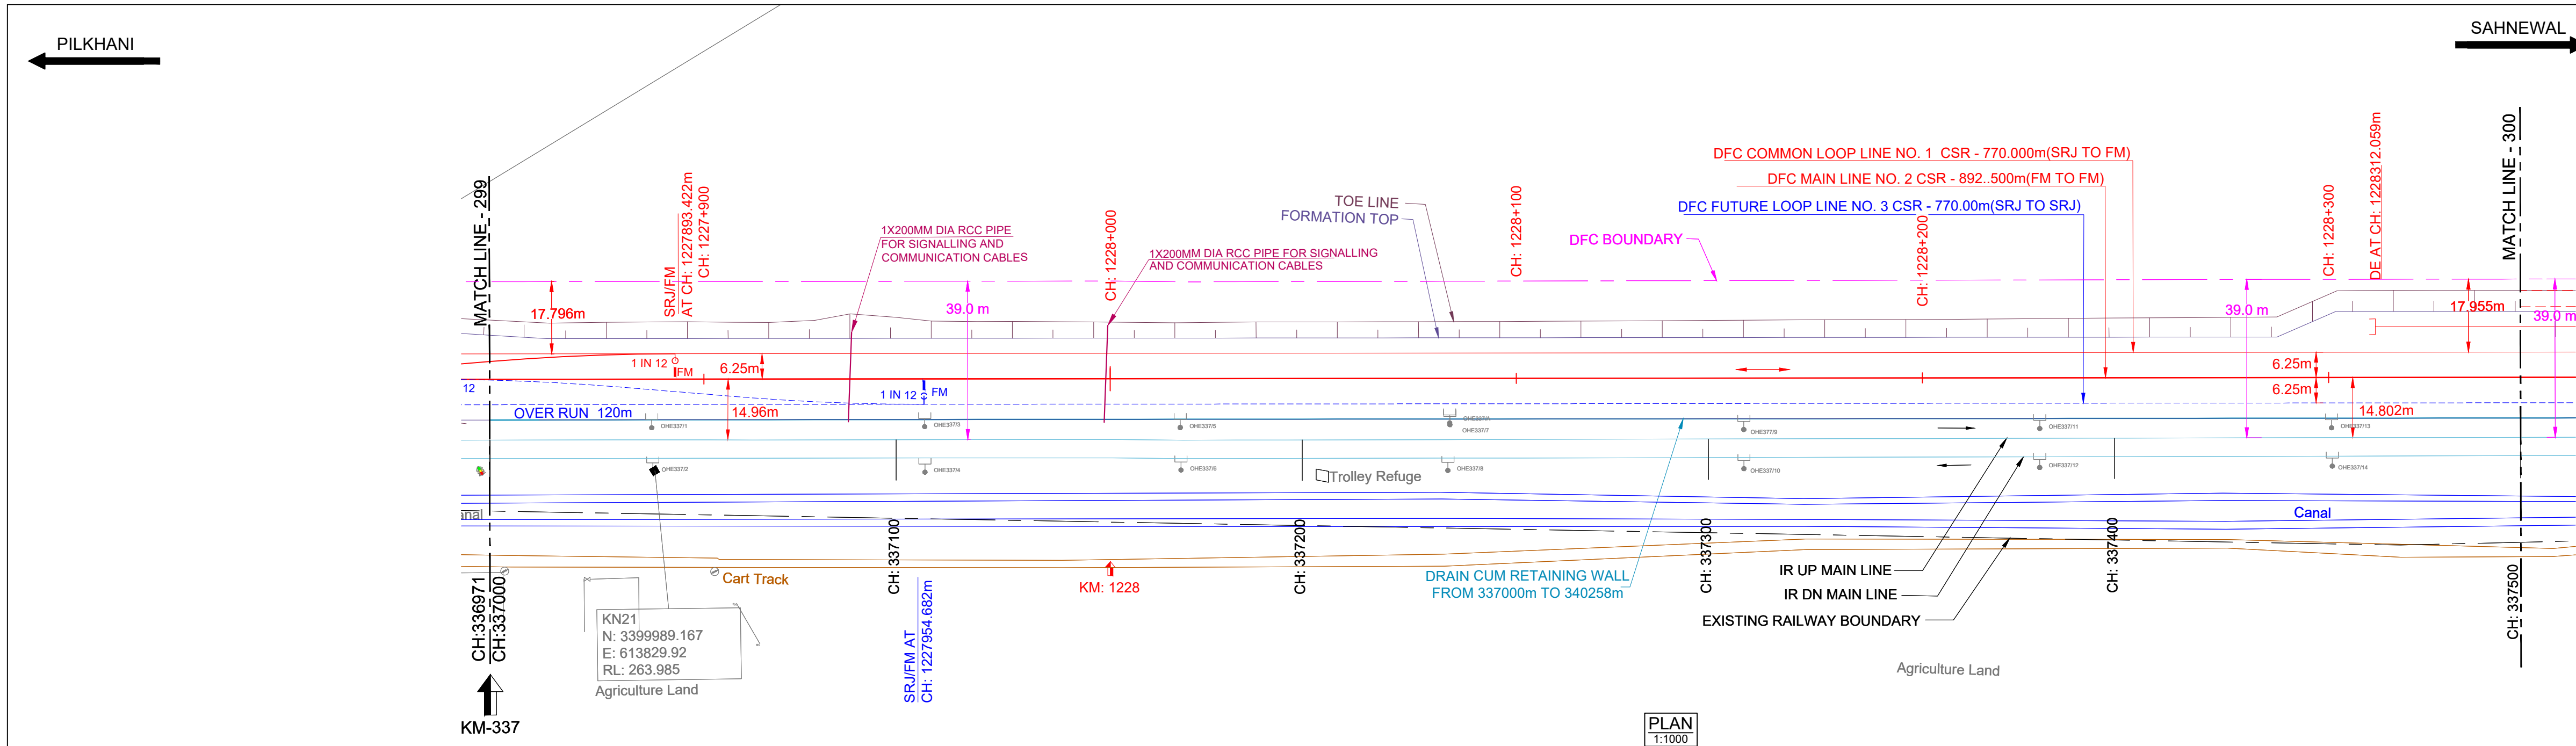

HORIZONTAL ALIGNMENT	L = 2876.804m																			
VERTICAL ALIGNMENT	L=1921.354 m 1 IN 1556.943 F																			
TRACK DISTANCE FROM EXISTING NEAREST IR UP MAIN LINE TO DFC MAIN LINE	14.907	14.907	14.952	14.942	14.967	14.975	14.955	14.950	14.952	15.037	15.150	15.111	15.095	15.072	15.025	14.989	14.973	14.956	14.938	14.783
HEIGHT OF BANKING(+) / DEPTH OF CUTTING(-) (PFL-GL)	+1.980		+2.127	+2.229	+2.218	+2.114	+2.271	+2.255	+2.223	+2.032	+2.116	+2.174	+2.182	+2.187	+2.254	+2.235	+2.258	+2.303	+2.371	+2.704
EXG GROUND LEVEL AT CENTER LINE OF DFC TRACK (GL)	262.487	262.487	262.327	262.212	262.210	262.301	262.131	262.135	262.154	262.332	262.235	262.164	262.143	262.126	262.046	262.052	262.016	261.958	261.877	261.442
EXG GROUND LEVEL AT TOE LOCATION OF DFC TRACK	262.511	262.403	262.327	262.297	262.323	262.206	261.705	262.245	262.246	262.348	262.313	262.265	262.245	262.229	262.175	262.124	262.070	261.833	261.606	261.465
DIFFERENCE BETWEEN DFC FORMATION LEVEL AND EXG FORMATION LEVEL (PFL-EFL)	0.819	0.821	0.827	0.814	0.812	0.826	0.849	0.875	0.882	0.879	0.906	0.886	0.871	0.870	0.868	0.867	0.852	0.838	0.830	0.823
DFC FORMATION LEVEL (PFL)	264.467	264.454	264.441	264.428	264.415	264.402	264.390	264.377	264.364	264.351	264.338	264.325	264.313	264.300	264.287	264.274	264.261	264.248	264.235	264.222
EXG. FORMATION LEVEL OF EXG IR UP MAIN LINE (EFL)	263.648	263.633	263.614	263.614	263.604	263.576	263.541	263.502	263.482	263.472	263.432	263.439	263.441	263.430	263.419	263.407	263.394	263.380	263.367	263.354
DIFFERENCE BETWEEN DFC RAIL LEVEL AND EXG. RAIL LEVEL (PRL - ERL)	0.860	0.862	0.868	0.855	0.853	0.867	0.890	0.916	0.923	0.920	0.948	0.928	0.912	0.911	0.909	0.908	0.908	0.893	0.879	0.864
DFC RAIL LEVEL (PRL)	265.180	265.167	265.154	265.141	265.129	265.116	265.103	265.090	265.077	265.064	265.051	265.039	265.026	265.013	265.000	264.987	264.974	264.962	264.949	264.936
EXG. RAIL LEVEL OF NEAREST IR UP MAIN LINE (ERL)	264.320	264.305	264.286	264.286	264.276	264.248	264.213	264.174	264.154	264.144	264.104	264.111	264.113	264.102	264.091	264.079	264.066	264.052	264.039	264.026
EQUIVALENT CHAINAGE ON DFC TRACK	1227846.6	1227866.6	1227886.6	1227906.6	1227926.6	1227946.6	1227966.6	1227986.6	1228006.6	1228026.6	1228046.6	1228066.6	1228086.6	1228106.6	1228126.6	1228146.6	1228166.6	1228186.6	1228206.6	1228226.6
EXISTING IR CHAINAGE	336971.3	337000.0	337020.0	337040.0	337060.0	337080.0	337100.0	337120.0	337140.0	337160.0	337180.0	337200.0	337220.0	337240.0	337260.0	337280.0	337300.0	337320.0	337340.0	337360.0

L - SECTION

NOTE:-

- DFCC WORKS ARE SHOWN IN RED.
- IR NEW WORKS ARE SHOWN IN VIOLET.
- ALL DIMENSIONS ARE SHOWN IN METRES.
- THIS DRAWING IS PREPARED BASED ON LATEST SURVEY DATA HELD ON APRIL-2022. GTS BENCH MARK OF 261.850M CONSIDERED ON TOP OF CANAL BRIDGE ABUTMENT AT DORAHA VILLAGE ALONG THE NH1.
- DFC NEW CHAINAGE OF 1075.950M IS WITH REFERENCE TO THE IR KM OF 187.500KM END OF KM OF CP-303(SECTION P-3 PILKHANI END) AGAINST THE EXISTING DFC CHAINAGE. 116277.742M ISSUED VIDE LETTER NO. COM/DFCC/MB/SURVEY/2021-301-230116-011173 DT. 17.01.2023.
- BALLAST PROFILE HAS BEEN PROVIDED ACCORDING TO THE CLAUSE 1.11.3 OF STANDARD SCHEDULE OF DIMENSION(EASTERN CORRIDOR) & THE BALLAST CUSHION DIMENSION SHOWN IN 35CM ON GE-14 PARA 17. SPECIFICATIONS & RECOMMENDATIONS 2. TWO LAYER SYSTEM FIG.10.

REFERENCE DRAWINGS :-

- FOR KEY PLAN REFER DRAWING NO. 301-2/AL/0001
- FOR LEGEND AND ABBREVIATIONS REFER DRAWING NO. 301-2/AL/1000
- FOR TYPICAL SECTION OF BALLAST PROFILE (FL-RL) REFER DRG. NO. 301-2/TK/TFD/-004 (TR. 1952)

03.10.2024SUBMISSION OF AS-BUILT DRAWINGFOR APPROVAL

REV. DATE REVISION DETAILS PURPOSE OF ISSUE

SCALE
HOR - 1:1000
VER - 1:100
SHEET SIZE : A1

LEGEND:

- IR TRACK
- DFCC TRACK
- DFCC FUTURE PROPOSALS
- STRUCTURE / BUILDING
- DFCC TOE LINE
- DFCC FORMATION
- RETAINING WALL
- ROAD
- STREAM, DRAIN, NALA, CANAL.
- FENCE
- POWER LINES
- TBM
- ELECTRIC POLE/OHE MAST
- IR RAILWAY BOUNDARY
- DFCC BOUNDARY

TYPICAL SECTION

TRACK STRUCTURE

RAIL SECTION: 60Kg/m (UIC 60Kg/m)	Difference between FL- RL (Below Rail Seat)	
DFC LINE: 60Kg/m (UIC 60Kg/m)	IR Line	DFC
IR MAIN LINE: 52Kg/m	172mm	172mm
RUBBER PAD	6mm	10mm
SLEEPER DEPTH	210mm	210mm
BALLAST CUSHION	300mm	350mm
Total Depth (FL TO RL)	688mm	742mm

OWNER
DEDICATED FREIGHT CORRIDOR CORPORATION OF INDIA LTD.
(A GOVERNMENT OF INDIA ENTERPRISE)
PROJECT OFFICE (AMBALA UNIT): OLD RAILWAY COLONY (NEAR ANAND MARKET), AMBALA CANTT-133001.
CORPORATE IDENTITY NO. : U60232DL2006GGI155068

ENGINEER:
DB Engineering & Consulting GmbH
Deutsche Bahn Engineering & Consulting GmbH

CONTRACTOR:
GIL - TPL JV
GAR TATA

SUBMITTED BY	GIL - TPL JV		
	DATED	NAME	SIGNATURE
PREPARED BY			
CHECKED BY	03.10.2024	VIJAY PRATAP	
APPROVED BY	03.10.2024	PARASURAM KOTYADA	

APPROVED BY	DEUTSCHE BAHN ENGINEERING & CONSULTING GMBH		
	DATED	NAME	SIGNATURE
Sr. DE./CHIEF ENGINEER		SURESH K.YALANGI	
CHIEF TRACK ENGINEER		RAJ PAL SINGH	
T.L.		H.D. VIDJAK	

STAMP
A
AS-BUILT DRAWING
TR. Ref.:.....
ENGINEER Sign.:.....

EMPLOYER (DFCCIL): DEDICATED FREIGHT CORRIDOR CORPORATION OF INDIA LTD.

AS BUILT DRAWING

TITLE
AS-BUILT PLAN AND PROFILE
FROM IR KM: 337.000 TO 337.500
FROM DFC KM: 1227.847 to 1228.347

DFCC APPR. NO. -
ENGG. APPR. NO. -
DRG. NO. - 301-2/AL/A/1300
SHEET NO. : 1 OF 1
DATE : 03.10.2024

STATUS
A

TR.