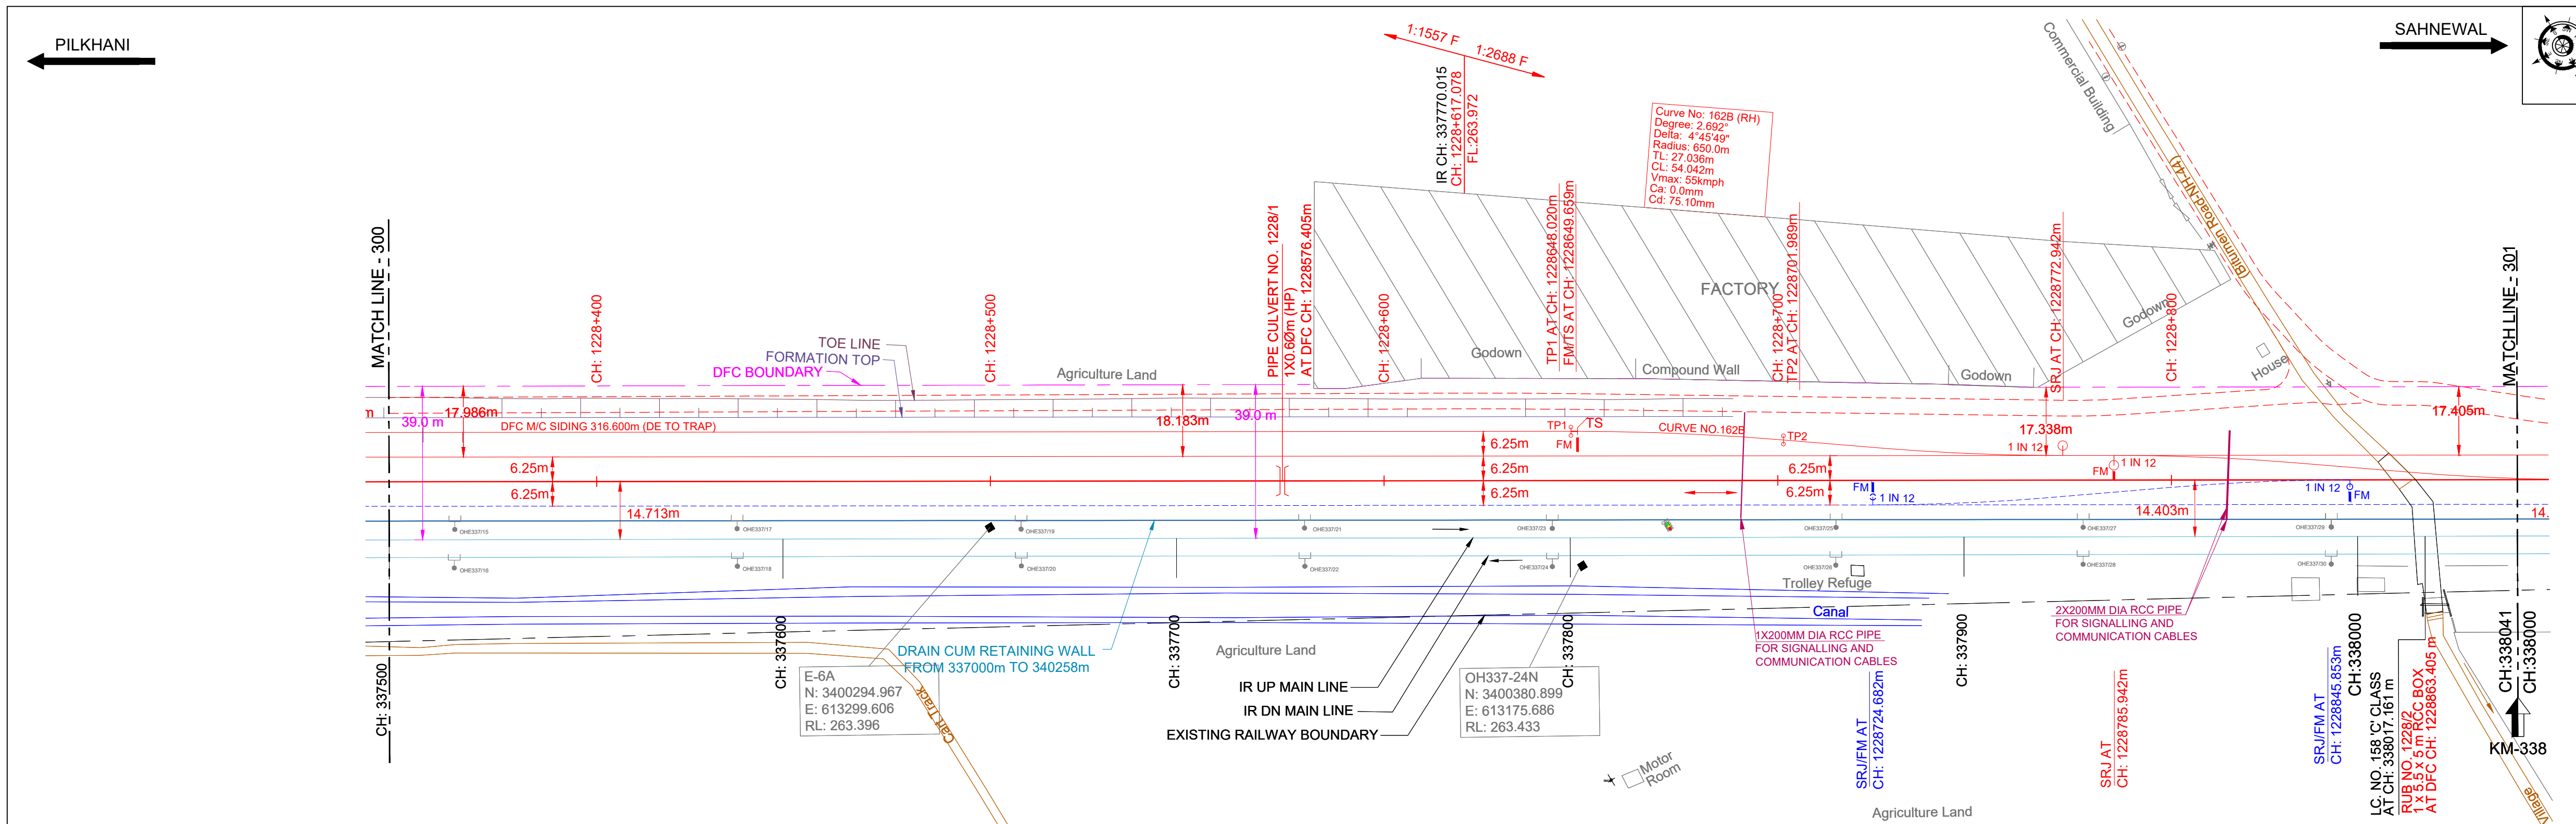


| HORIZONTAL ALIGNMENT                                                     | <div>L = 2876.804m</div>                                                                                                   |           |           |--------------------------------------------------------------------------|----------------------------------------------------------------------------------------------------------------------------|-----------|-----------|-----------|-----------|-----------|-----------|-----------|-----------|-----------|-----------|-----------|-----------|-----------|-----------|-----------|-----------|-----------|-----------|-----------|-----------|-----------|-----------|-----------|-----------|-----------|-----------|-----------|
| VERTICAL ALIGNMENT                                                       | <div>L=1921.354 m<br/>1 IN 1556.943 F</div> <div>L=20.0 m<br/>R=7400.4 m</div> <div>L=1922.051 m<br/>1 IN 2687.971 F</div> |           |           | TRACK DISTANCE FROM EXISTING NEAREST IR UP MAIN LINE TO DFC MAIN LINE    | 14.783                                                                                                                     | 14.762    | 14.735    | 14.711    | 14.691    | 14.671    | 14.650    | 14.630    | 14.610    | 14.589    | 14.569    | 14.554    | 14.540    | 14.522    | 14.507    | 14.467    | 14.434    | 14.435    | 14.433    | 14.416    | 14.404    | 14.402    | 14.396    | 14.380    | 14.357    | 14.321    | 14.320    |           |
| HEIGHT OF BANKING(+) / DEPTH OF CUTTING(-) (PFL-GL)                      | +2.704                                                                                                                     | +2.577    | +2.480    | +2.661    | +2.645    | +2.556    | +2.385    | +2.390    | +2.437    | +2.490    | +2.609    | +2.801    | +2.566    | +2.470    | +2.585    | +2.621    | +2.573    | +2.765    | +2.578    | +2.336    | +1.638    | +1.527    | +1.342    | +1.368    | +1.368    | +2.173    | +2.167    |           |
| EXG GROUND LEVEL AT CENTER LINE OF DFC TRACK (GL)                        | -261.442                                                                                                                   | -261.556  | -261.640  | -261.446  | -261.449  | -261.525  | -261.683  | -261.666  | -261.606  | -261.540  | -261.408  | -261.403  | -261.402  | -261.491  | -261.369  | -261.325  | -261.366  | -261.166  | -261.206  | -261.338  | -261.573  | -262.263  | -262.367  | -262.545  | -262.511  | -261.689  | -261.684  |           |
| EXG GROUND LEVEL AT TOE LOCATION OF DFC TRACK                            | -261.465                                                                                                                   | -261.537  | -261.634  | -261.577  | -261.596  | -261.666  | -261.812  | -261.785  | -261.692  | -261.639  | -261.504  | -261.536  | -261.619  | -261.611  | -261.645  | -261.576  | -261.828  | -261.572  | -261.572  | -261.484  | -261.398  | -261.573  | -261.815  | -262.311  | -262.509  | -262.647  | -261.808  | -261.802  |
| DIFFERENCE BETWEEN DFC FORMATION LEVEL AND EXG.FORMATION LEVEL (PFL-EFL) | 0.823                                                                                                                      | 0.838     | 0.868     | 0.883     | 0.878     | 0.873     | 0.868     | 0.863     | 0.858     | 0.870     | 0.896     | 0.924     | 0.965     | 0.971     | 0.977     | 0.953     | 0.930     | 0.913     | 0.893     | 0.865     | 0.832     | 0.782     | 0.735     | 0.693     | 0.690     | 0.749     | 0.751     |           |
| DFC FORMATION LEVEL (PFL)                                                | -264.146                                                                                                                   | -264.133  | -264.120  | -264.107  | -264.094  | -264.081  | -264.068  | -264.056  | -264.043  | -264.030  | -264.017  | -264.004  | -263.968  | -263.961  | -263.954  | -263.946  | -263.939  | -263.931  | -263.924  | -263.916  | -263.909  | -263.901  | -263.894  | -263.887  | -263.879  | -263.872  | -263.871  |           |
| EXG. FORMATION LEVEL OF EXG IR UP MAIN LINE (EFL)                        | -263.322                                                                                                                   | -263.295  | -263.252  | -263.224  | -263.216  | -263.209  | -263.200  | -263.192  | -263.184  | -263.160  | -263.121  | -263.080  | -263.003  | -262.990  | -262.977  | -262.993  | -263.008  | -263.018  | -263.030  | -263.051  | -263.077  | -263.119  | -263.159  | -263.193  | -263.189  | -263.123  | -263.121  |           |
| DIFFERENCE BETWEEN DFC RAIL LEVEL AND EXG. RAIL LEVEL (PRL - ERL)        | 0.864                                                                                                                      | 0.879     | 0.909     | 0.924     | 0.919     | 0.914     | 0.909     | 0.905     | 0.900     | 0.912     | 0.937     | 0.965     | 1.006     | 1.012     | 1.018     | 0.995     | 0.972     | 0.954     | 0.934     | 0.906     | 0.873     | 0.823     | 0.776     | 0.734     | 0.731     | 0.790     | 0.792     |           |
| DFC RAIL LEVEL (PRL)                                                     | -264.859                                                                                                                   | -264.846  | -264.833  | -264.820  | -264.807  | -264.795  | -264.782  | -264.769  | -264.756  | -264.743  | -264.730  | -264.718  | -264.681  | -264.674  | -264.667  | -264.659  | -264.652  | -264.644  | -264.637  | -264.629  | -264.622  | -264.614  | -264.607  | -264.600  | -264.592  | -264.585  | -264.584  |           |
| EXG.RAIL LEVEL OF NEAREST IR UP MAIN LINE(ERL)                           | -263.994                                                                                                                   | -263.967  | -263.924  | -263.896  | -263.888  | -263.881  | -263.872  | -263.864  | -263.856  | -263.832  | -263.793  | -263.752  | -263.675  | -263.662  | -263.649  | -263.665  | -263.680  | -263.690  | -263.702  | -263.723  | -263.749  | -263.791  | -263.831  | -263.865  | -263.881  | -263.795  | -263.793  |           |
| EQUIVALENT CHAINAGE ON DFC TRACK                                         | 1228346.6                                                                                                                  | 1228366.6 | 1228386.6 | 1228406.6 | 1228426.6 | 1228446.6 | 1228466.6 | 1228486.6 | 1228506.6 | 1228526.6 | 1228546.6 | 1228566.6 | 1228586.6 | 1228606.6 | 1228626.6 | 1228646.6 | 1228666.6 | 1228686.6 | 1228706.6 | 1228726.6 | 1228746.6 | 1228766.6 | 1228786.6 | 1228806.6 | 1228826.6 | 1228846.6 | 1228866.6 | 1228886.2 |
| EXISTING IR CHAINAGE                                                     | 337500.0                                                                                                                   | 337520.0  | 337540.0  | 337560.0  | 337580.0  | 337600.0  | 337620.0  | 337640.0  | 337660.0  | 337680.0  | 337700.0  | 337720.0  | 337740.0  | 337760.0  | 337780.0  | 337800.0  | 337820.0  | 337840.0  | 337860.0  | 337880.0  | 337900.0  | 337920.0  | 337940.0  | 337960.0  | 337980.0  | 338000.0  | 338020.0  | 338040.0  |

NOTE:-

- DFCC WORKS ARE SHOWN IN RED.
- IR NEW WORKS ARE SHOWN IN VIOLET.
- ALL DIMENSIONS ARE SHOWN IN METRES.
- THIS DRAWING IS PREPARED BASED ON LATEST SURVEY DATA HELD ON APRIL-2022. GTS BENCH MARK OF 261.850M CONSIDERED ON TOP OF CANAL BRIDGE ABUTMENT AT DORANA VILLAGE ALONG THE NH1.
- DFC NEW CHAINAGE OF 1075.950M IS WITH REFERENCE TO THE IR KM OF 187.500KM END OF KM OF CP-303(SECTION P-3 PILKHANI END) AGAINST THE EXISTING DFC CHAINAGE. 116277.742M ISSUED VIDE LETTER NO. COM/DFCC/SURVEY/2021-301-230116-011173 DT. 17.01.2023.
- BALLAST PROFILE HAS BEEN PROVIDED ACCORDING TO THE CLAUSE 1.11.3 OF STANDARD SCHEDULE OF DIMENSION(EASTERN CORRIDOR) & THE BALLAST CUSHION DIMENSION SHOWN IN 35CM ON GE-14 PARA 17. SPECIFICATIONS & RECOMMENDATIONS 2. TWO LAYER SYSTEM FIG.10.

REFERENCE DRAWINGS :-

- FOR KEY PLAN REFER DRAWING NO. 301-2/AL/0001
- FOR LEGEND AND ABBREVIATIONS REFER DRAWING NO. 301-2/AL/1000
- FOR TYPICAL SECTION OF BALLAST PROFILE (FL-RL) REFER DRG. NO. 301-2/TK/TFD/-004 (TR.1952)

|      |            |                                |                  |
|------|------------|--------------------------------|------------------|
| 0    | 03.10.2024 | SUBMISSION OF AS-BUILT DRAWING | FOR APPROVAL     |
| REV. | DATE       | REVISION DETAILS               | PURPOSE OF ISSUE |

LEGEND:

- IR TRACK
- DFCC TRACK
- DFCC FUTURE PROPOSALS
- STRUCTURE / BUILDING
- DFCC TOE LINE
- DFCC FORMATION
- RETAINING WALL
- ROAD
- STREAM, DRAIN, NALA, CANAL.
- FENCE
- POWER LINES
- TBM
- ELECTRIC POLE/OHE MAST
- IR RAILWAY BOUNDARY
- DFCC BOUNDARY

SCALE

HOR - 1:1000

VER - 1:100

SHEET SIZE : A1

TYPICAL SECTION

| TRACK STRUCTURE                                                                            |                                             |
|--------------------------------------------------------------------------------------------|---------------------------------------------|
| RAIL SECTION: 60Kg/m (UIC 60Kg/m)<br>DFC LINE: 60Kg/m (UIC 60Kg/m)<br>IR MAIN LINE: 52Kg/m | Difference between FL- RL (Below Rail Seat) |
|                                                                                            | IR Line      DFC                            |
| RUBBER PAD                                                                                 | 172mm      172mm                            |
| SLEEPER DEPTH                                                                              | 6mm      10mm                               |
| BALLAST CUSHION                                                                            | 210mm      210mm                            |
| Total Depth (FL TO RL)                                                                     | 300mm      350mm                            |

OWNER

DEDICATED FREIGHT CORRIDOR CORPORATION OF INDIA LTD.

(A GOVERNMENT OF INDIA ENTERPRISE)

PROJECT OFFICE(AMBALA UNIT): OLD RAILWAY COLONY (NEAR ANAND MARKET),AMBALA CANTT-133001.

CORPORATE IDENTITY NO. : U60232DL2006GGI155068

ENGINEER:

DB Engineering & Consulting GmbH

Deutsche Bahn Engineering & Consulting GmbH

CONTRACTOR:

GIL - TPL JV

GAR TATA

| SUBMITTED BY | GIL - TPL JV |                   |           |
|--------------|--------------|-------------------|-----------|
|              | DATED        | NAME              | SIGNATURE |
| PREPARED BY  |              |                   |           |
| CHECKED BY   | 03.10.2024   | VIJAY PRATAP      |           |
| APPROVED BY  | 03.10.2024   | PARASURAM KOTYADA |           |

APPROVED BY

DEUTSCHE BAHN ENGINEERING & CONSULTING GMBH

| DATED | NAME             | SIGNATURE |
|-------|------------------|-----------|
|       | SURESH K.YALANGI |           |
|       | RAJ PAL SINGH    |           |
| T.L.  | H.D. VIDJAK      |           |

STAMP

A AS-BUILT DRAWING TR. Ref.:..... ENGINEER Sign.:.....

EMPLOYER (DFCCIL):

DEDICATED FREIGHT CORRIDOR CORPORATION OF INDIA LTD.

AS BUILT DRAWING

TITLE

AS-BUILT PLAN AND PROFILE

FROM IR KM: 337.500 TO 338.000

FROM DFC KM: 1228.347 TO 1228.887

DFCC APPR. NO. -

ENGG. APPR. NO. -

DRG. NO. :301-2/AL/A/1301

SHEET NO. : 1 OF 1

DATE : 03.10.2024

STATUS

A

TR.