


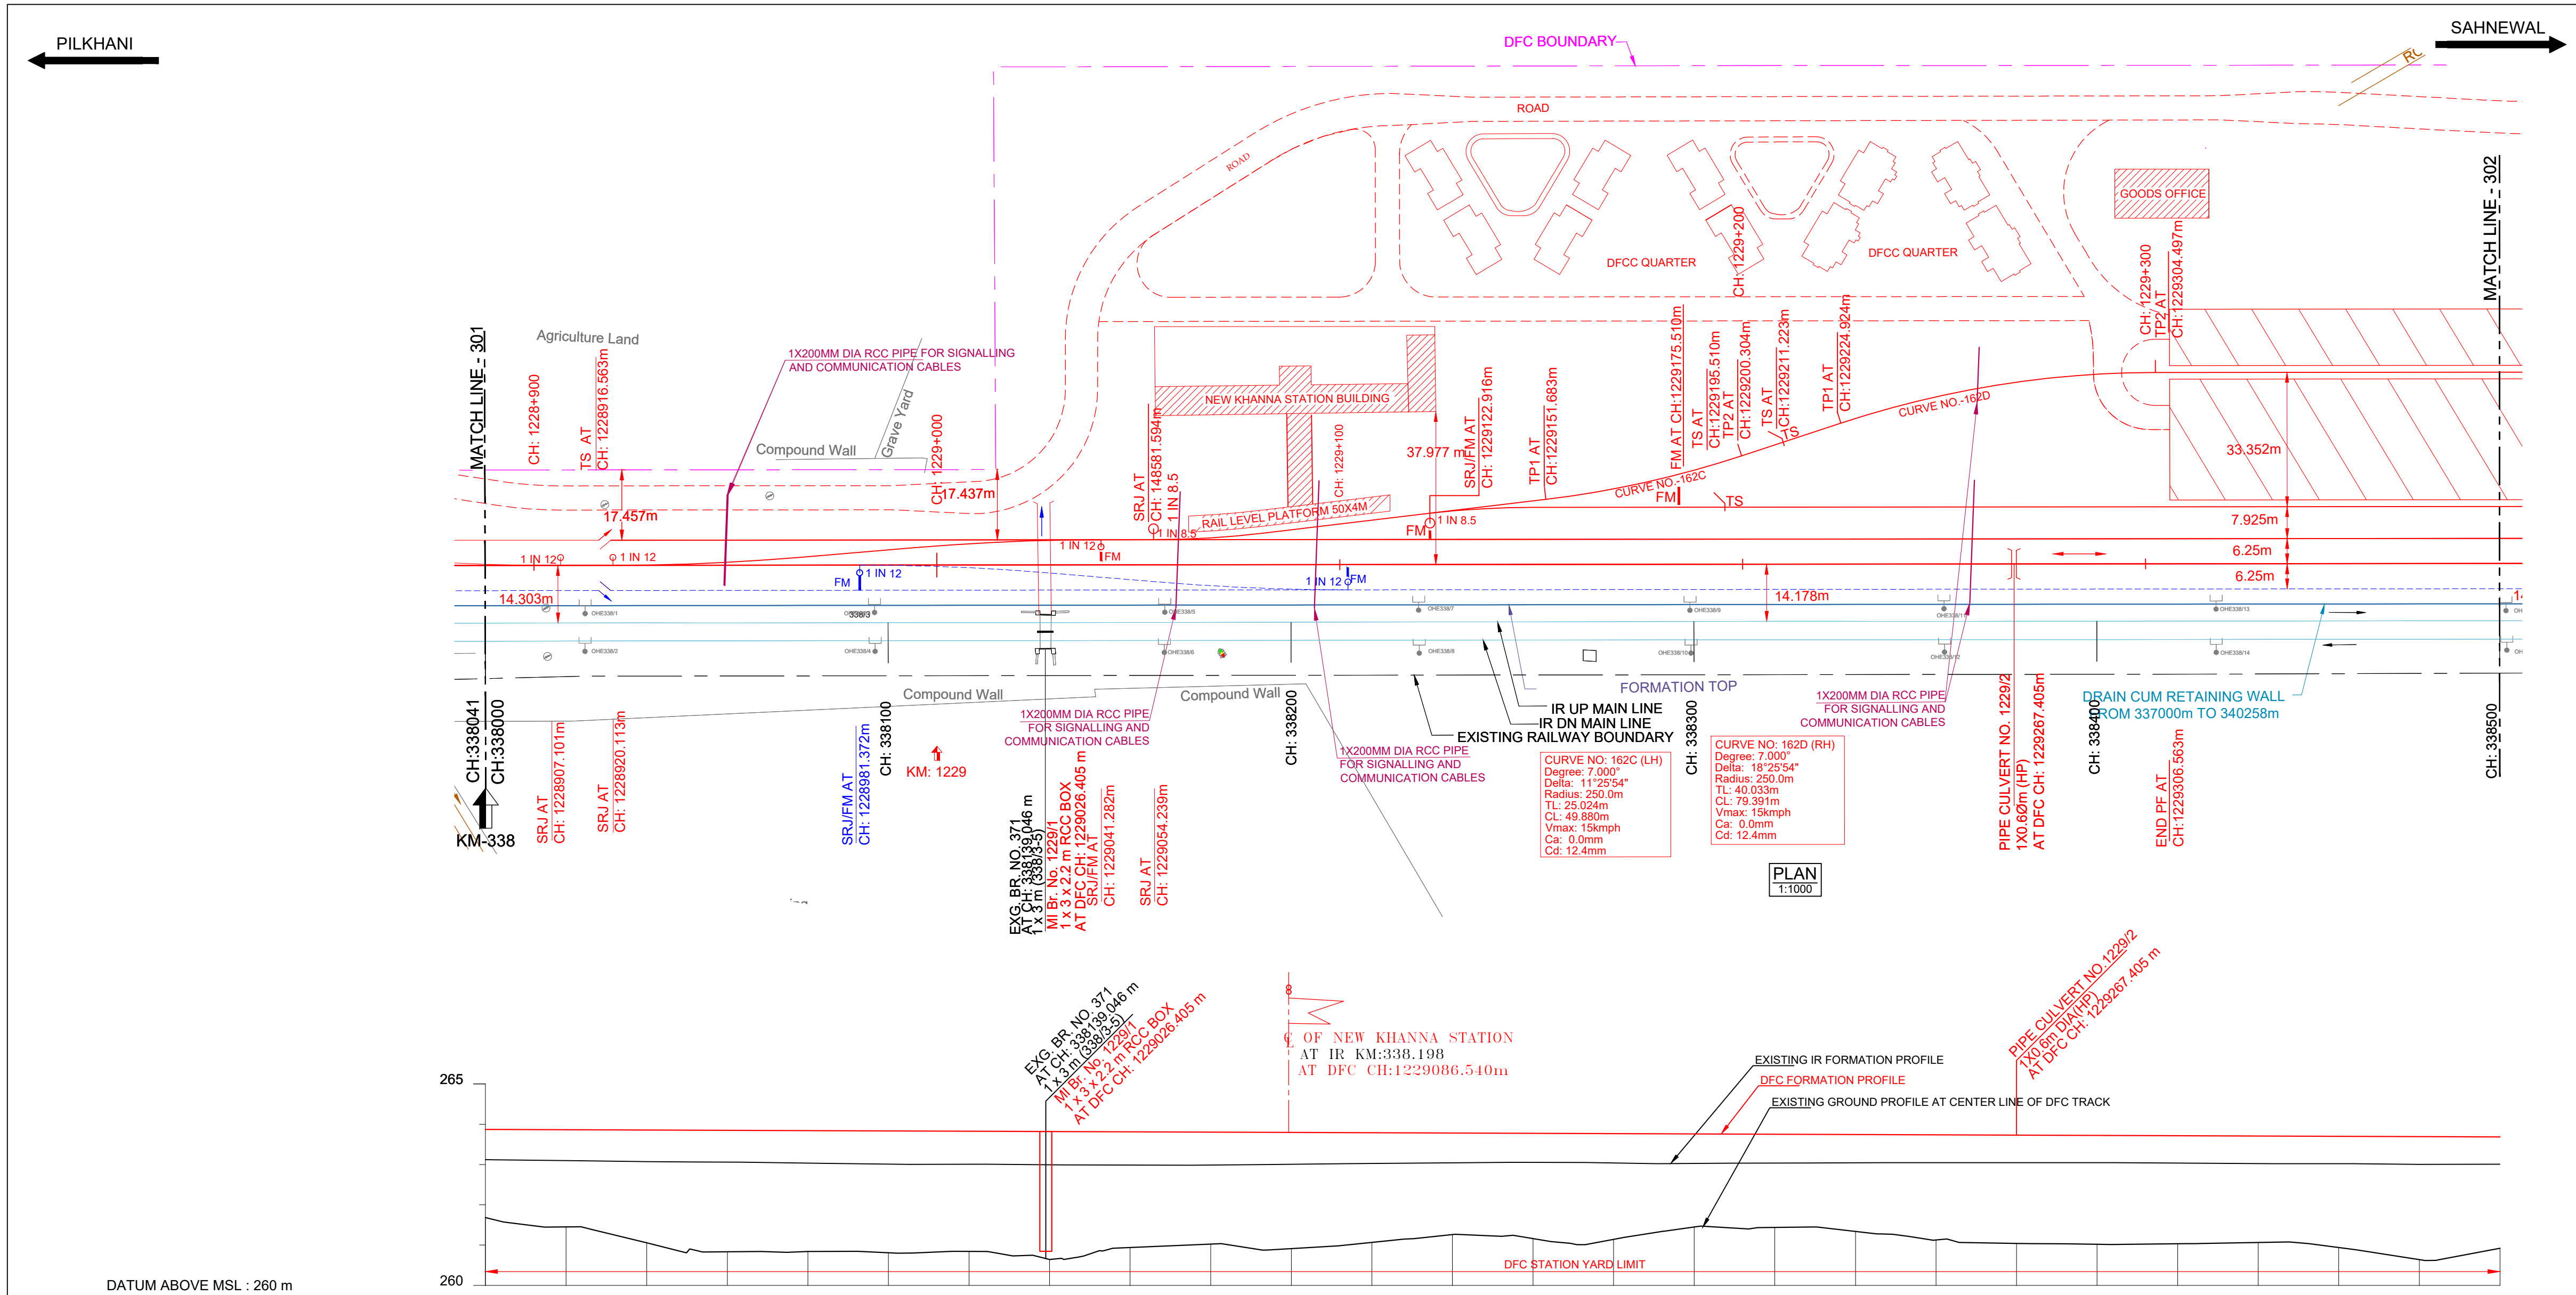

HORIZONTAL ALIGNMENT	L = 2876.804m																									
VERTICAL ALIGNMENT	L=1922.051 m 1 IN 2687.971 F																									
TRACK DISTANCE FROM EXISTING NEAREST IR UP MAIN LINE TO DFC MAIN LINE		14.320																								
HEIGHT OF BANKING(+) / DEPTH OF CUTTING(-) (PFL-GL)		+2.187																								
EXG GROUND LEVEL AT CENTER LINE OF DFC TRACK (GL)		-261.684																								
EXG GROUND LEVEL AT TOE LOCATION OF DFC TRACK		-261.802																								
DIFFERENCE BETWEEN DFC FORMATION LEVEL AND EXG.FORMATION LEVEL (PFL-EFL)		0.751																								
DFC FORMATION LEVEL (PFL)		-263.871																								
EXG. FORMATION LEVEL OF EXG IR UP MAIN LINE (EFL)		-263.121																								
DIFFERENCE BETWEEN DFC RAIL LEVEL AND EXG. RAIL LEVEL (PRL - ERL)		0.792																								
DFC RAIL LEVEL (PRL)		-264.584																								
EXG.RAIL LEVEL OF NEAREST IR UP MAIN LINE(ERL)		-263.793																								
EQUIVALENT CHAINAGE ON DFC TRACK		-1228887.2																								
EXISTING IR CHAINAGE	338040.6	338050.0	338060.0	338070.0	338080.0	338090.0	338100.0	338110.0	338120.0	338130.0	338140.0	338150.0	338160.0	338170.0	338180.0	338190.0	338200.0	338210.0	338220.0	338230.0	338240.0	338250.0	338260.0	338270.0	338280.0	338290.0
		-1228887.2																								
		-1228907.2																								
		-1228927.2																								
L - SECTION

NOTE:-

- DFCC WORKS ARE SHOWN IN RED.
- IR NEW WORKS ARE SHOWN IN VIOLET.
- ALL DIMENSIONS ARE SHOWN IN METRES.
- THIS DRAWING IS PREPARED BASED ON LATEST SURVEY DATA HELD ON APRIL-2022. GTS BENCH MARK OF 261.850M CONSIDERED ON TOP OF CANAL BRIDGE ABUTMENT AT DORANA VILLAGE ALONG THE NH1.
- DFC NEW CHAINAGE OF 1075.950M IS WITH REFERENCE TO THE IR KM OF 187.500KM END OF KM OF CP-303(SECTION P-3 PILKHANI END) AGAINST THE EXISTING DFC CHAINAGE. 116277.742M ISSUED VIDE LETTER NO. COM/DFCC/MB/SURVEY/2021-301-2301/16-01/173.DT. 17.01.2023.
- BALLAST PROFILE HAS BEEN PROVIDED ACCORDING TO THE CLAUSE 1.11.3 OF STANDARD SCHEDULE OF DIMENSION(EASTERN CORRIDOR) & THE BALLAST CUSHION DIMENSION SHOWN IN 35CM ON GE-14 PARA 17. SPECIFICATIONS & RECOMMENDATIONS 2. TWO LAYER SYSTEM FIG.10.

REFERENCE DRAWINGS :-

- FOR KEY PLAN REFER DRAWING NO. 301-2/AL/0001
- FOR LEGEND AND ABBREVIATIONS REFER DRAWING NO. 301-2/AL/1000
- FOR TYPICAL SECTION OF BALLAST PROFILE (FL-RL) REFER DRG. NO. 301-2/TK/TFD/-004 (TR.1952)

DRG NO. - 301-2/AL/A/1302

0	03.10.2024	SUBMISSION OF AS-BUILT DRAWING	FOR APPROVAL
REV.	DATE	REVISION DETAILS	PURPOSE OF ISSUE

LEGEND:

SCALE

HOR - 1:1000

VER - 1:100

SHEET SIZE - A1

TYPICAL SECTION

TRACK STRUCTURE		
RAIL SECTION: 60Kg/m (UIC 60Kg/m)	Difference between FL- RL (Below Rail Seat)	
DFC LINE: 60Kg/m (UIC 60Kg/m)	IR Line	DFC
IR MAIN LINE: 52Kg/m	172mm	172mm
RUBBER PAD	6mm	10mm
SLEEPER DEPTH	210mm	210mm
BALLAST CUSHION	300mm	350mm
Total Depth (FL TO RL)	688mm	742mm

OWNER

DEDICATED FREIGHT CORRIDOR CORPORATION OF INDIA LTD.

(A GOVERNMENT OF INDIA ENTERPRISE)

PROJECT OFFICE(AMBALA UNIT): OLD RAILWAY COLONY (NEAR ANAND MARKET),AMBALA CANTT-133001.

CORPORATE IDENTITY NO. : U60232DL2006GGI155068

ENGINEER:

DB Engineering & Consulting GmbH

Deutsche Bahn Engineering & Consulting GmbH

CONTRACTOR:

GIL - TPL JV

GAR TATA

SUBMITTED BY	GIL - TPL JV		
	DATED	NAME	SIGNATURE
PREPARED BY			
CHECKED BY	03.10.2024	VIJAY PRATAP	
APPROVED BY	03.10.2024	PARASURAM KOTYADA	
APPROVED BY	DEUTSCHE BAHN ENGINEERING & CONSULTING GMBH		
	DATED	NAME	SIGNATURE
Sr. DE./CHIEF ENGINEER		SURESH K.YALANGI	
CHIEF TRACK ENGINEER		RAJ PAL SINGH	
T.L.		H.D. VIDJAK	

STAMP

A AS-BUILT DRAWING TR. Ref.:..... ENGINEER Sign.:.....

EMPLOYER (DFCCIL): DEDICATED FREIGHT CORRIDOR CORPORATION OF INDIA LTD.

AS BUILT DRAWING	
TITLE	AS-BUILT PLAN AND PROFILE
DFCC APPR. NO. -	
ENGG. APPR. NO. -	
DRG. NO. - 301-2/AL/A/1302	
SHEET NO. : 1 OF 1	
DATE : 03.10.2024	
STATUS	A

TR.