


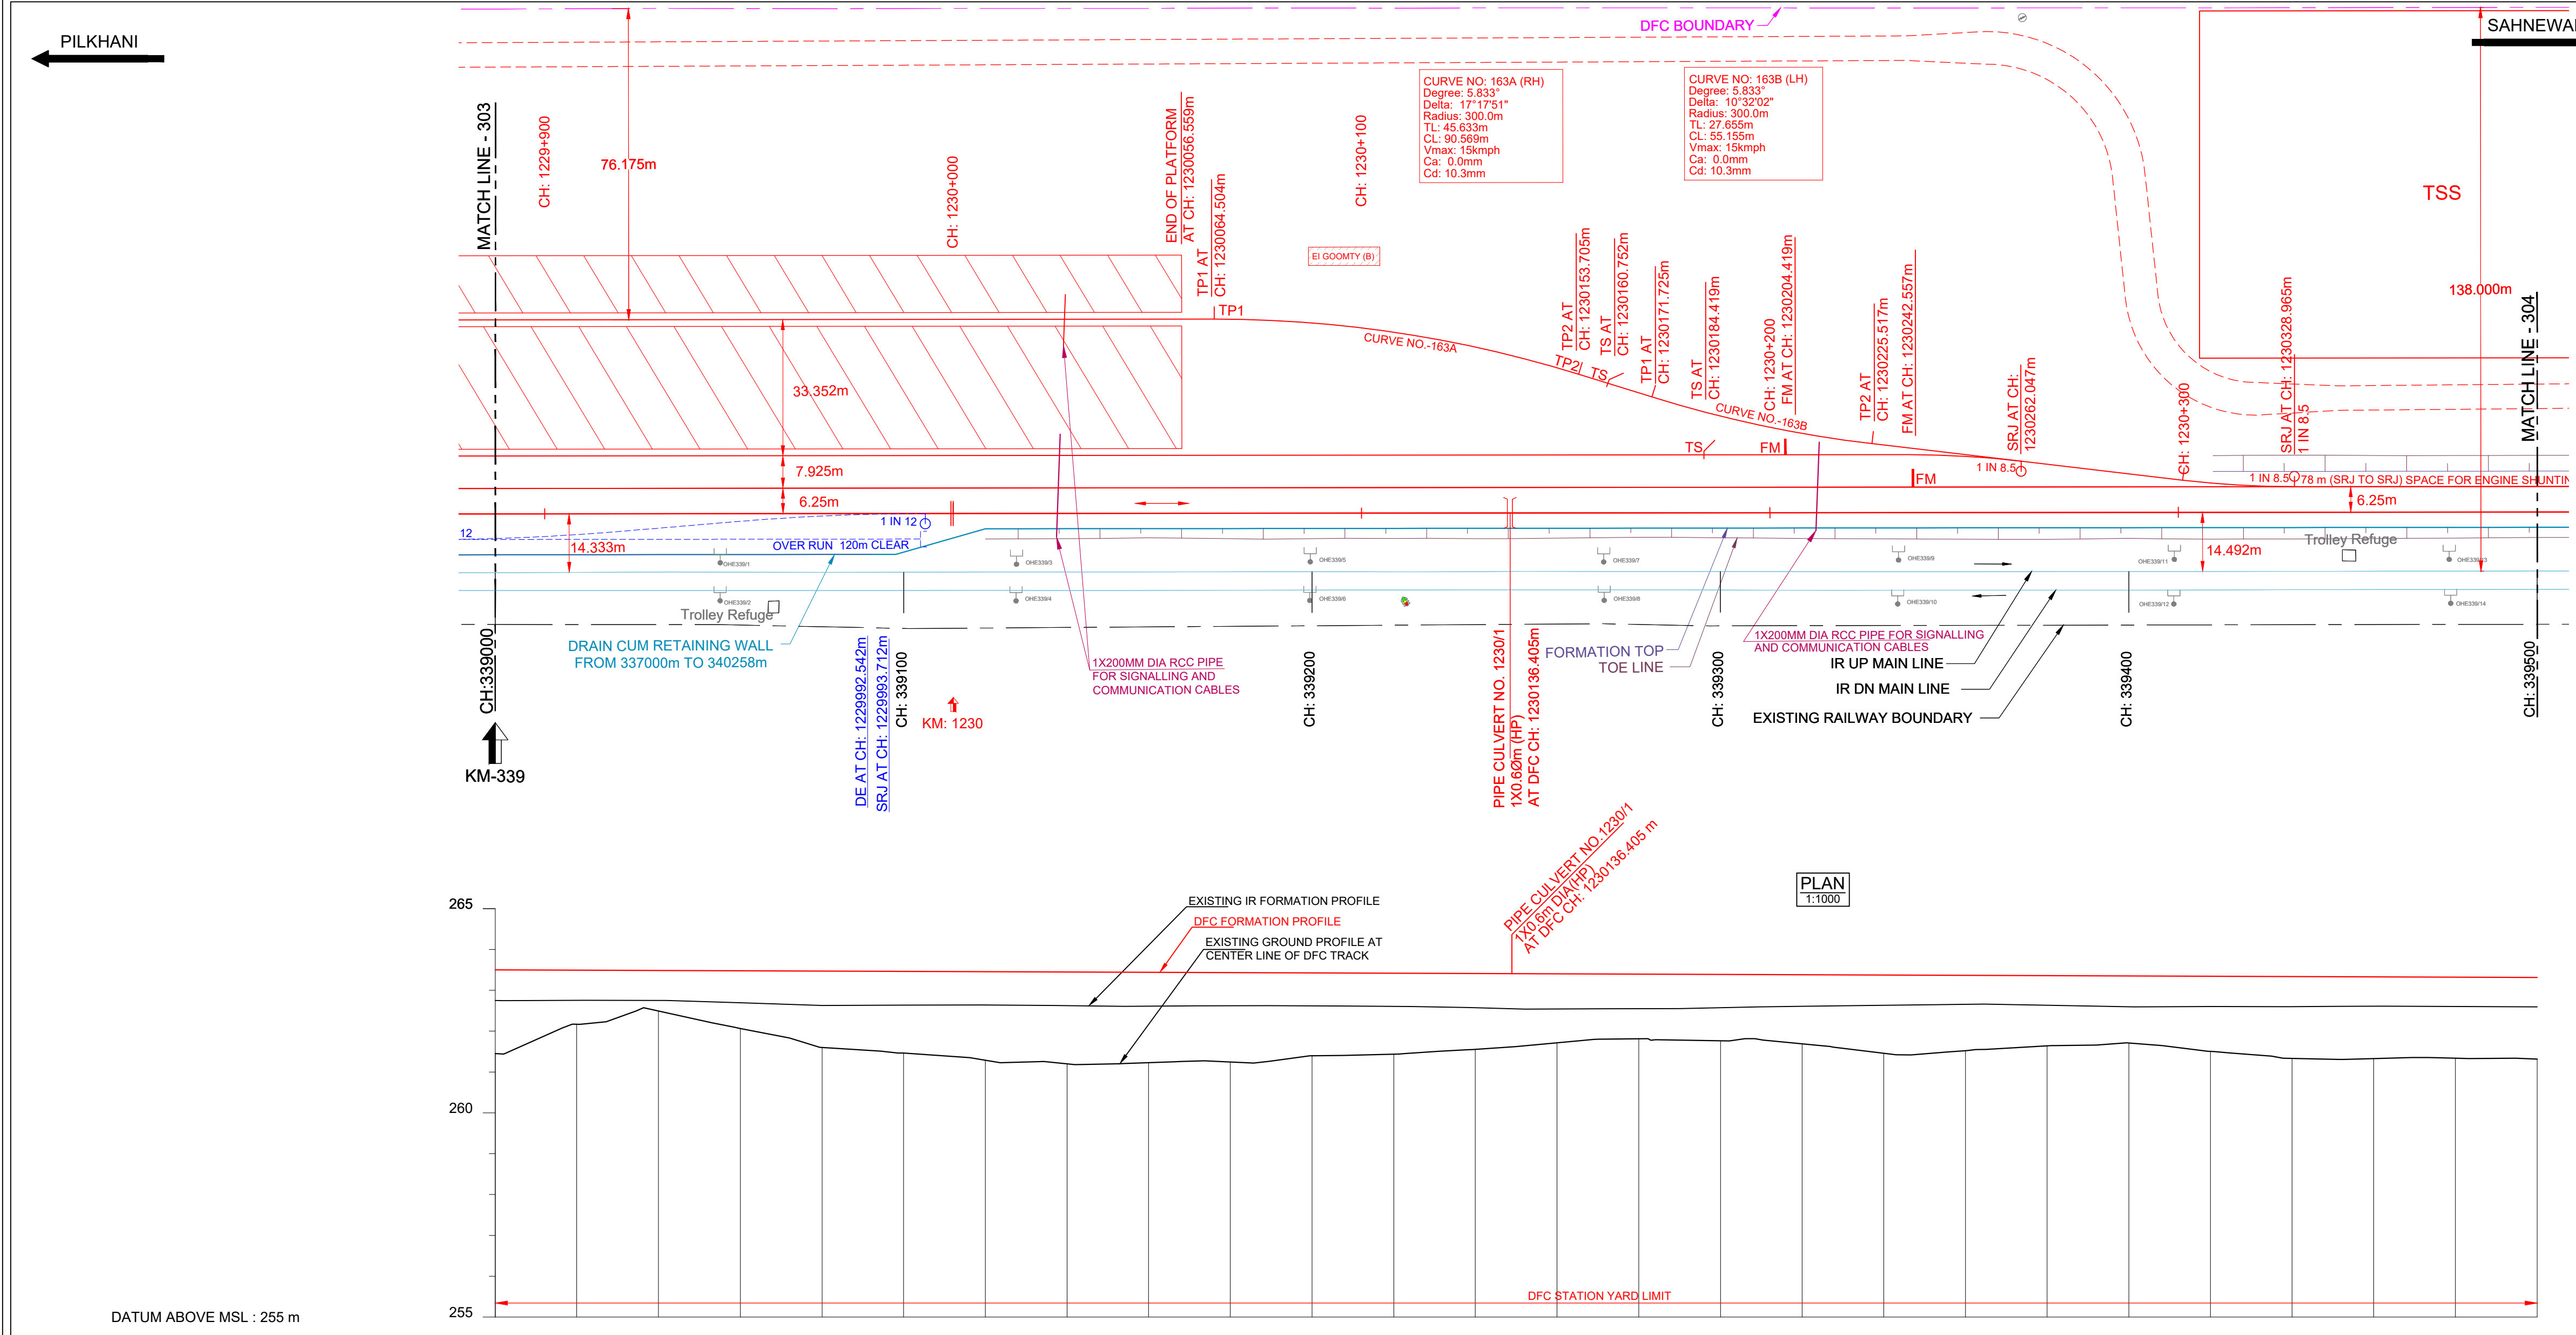

DATUM ABOVE MSL : 255 m

HORIZONTAL ALIGNMENT	L = 2876.804m																			
VERTICAL ALIGNMENT	L=1922.051 m 1 IN 2687.971 F																			
TRACK DISTANCE FROM EXISTING NEAREST IR UP MAIN LINE TO DFC MAIN LINE	14.382	14.327	14.263	14.316	14.383	14.348	14.317	14.348	14.362	14.335	14.340	14.371	14.342	14.323	14.344	14.379	14.428	14.455	14.464	14.464
HEIGHT OF BANKING(+) / DEPTH OF CUTTING(-) (PFL-GL)	+2.049	+1.324	+0.991	+1.413	+1.870	+1.999	+2.167	+2.246	+2.213	+2.187	+2.026	+1.981	+1.856	+1.689	+1.581	+1.625	+1.691	+1.914	+1.845	+1.996
EXG GROUND LEVEL AT CENTER LINE OF DFC TRACK (GL)	-261.450	-261.188	-262.494	-262.084	-261.600	-261.463	-261.288	-261.201	-261.227	-261.245	-261.397	-261.437	-261.554	-261.714	-261.814	-261.763	-261.689	-261.459	-261.520	-261.317
EXG GROUND LEVEL AT TOE LOCATION OF DFC TRACK	-261.502	-261.194	-262.082	-261.821	-261.442	-261.463	-261.403	-261.349	-261.298	-261.352	-261.369	-261.386	-261.447	-261.510	-261.535	-261.635	-261.723	-261.378	-261.369	-261.270
DIFFERENCE BETWEEN DFC FORMATION LEVEL AND EXG FORMATION LEVEL (PFL-EFL)	0.749	0.737	0.733	0.784	0.842	0.823	0.813	0.823	0.827	0.810	0.807	0.811	0.835	0.860	0.846	0.814	0.774	0.741	0.709	0.720
DFC FORMATION LEVEL (PFL)	-263.499	-263.492	-263.465	-263.477	-263.470	-263.462	-263.455	-263.447	-263.440	-263.432	-263.425	-263.418	-263.410	-263.403	-263.395	-263.388	-263.380	-263.373	-263.365	-263.313
EXG. FORMATION LEVEL OF EXG IR UP MAIN LINE (EFL)	-262.750	-262.755	-262.751	-262.693	-262.628	-262.639	-262.642	-262.625	-262.613	-262.622	-262.618	-262.607	-262.575	-262.543	-262.549	-262.574	-262.607	-262.632	-262.657	-262.594
DIFFERENCE BETWEEN DFC RAIL LEVEL AND EXG. RAIL LEVEL (PRL - ERL)	0.790	0.778	0.774	0.825	0.883	0.865	0.854	0.864	0.868	0.851	0.848	0.852	0.877	0.901	0.887	0.855	0.815	0.782	0.750	0.761
DFC RAIL LEVEL (PRL)	-264.212	-264.205	-264.198	-264.190	-264.183	-264.175	-264.168	-264.160	-264.153	-264.146	-264.138	-264.131	-264.123	-264.116	-264.108	-264.101	-264.093	-264.086	-264.079	-264.026
EXG. RAIL LEVEL OF NEAREST IR UP MAIN LINE (ERL)	-263.422	-263.427	-263.423	-263.365	-263.300	-263.311	-263.294	-263.297	-263.285	-263.294	-263.290	-263.279	-263.247	-263.215	-263.221	-263.246	-263.279	-263.304	-263.329	-263.266
EQUIVALENT CHAINAGE ON DFC TRACK	-1229887.3	-1229907.2	-1229927.2	-1229947.3	-1229967.3	-1229987.2	-1230007.3	-1230027.3	-1230047.2	-1230067.2	-1230087.3	-1230107.3	-1230127.2	-1230147.3	-1230167.3	-1230187.3	-1230207.3	-1230227.3	-1230247.3	-1230267.3
EXISTING IR CHAINAGE	339000.0	339020.0	339040.0	339060.0	339080.0	339100.0	339120.0	339140.0	339160.0	339180.0	339200.0	339220.0	339240.0	339260.0	339280.0	339300.0	339320.0	339340.0	339360.0	339380.0

L - SECTION

NOTE:-

- DFCC WORKS ARE SHOWN IN RED.
- IR NEW WORKS ARE SHOWN IN VIOLET.
- ALL DIMENSIONS ARE SHOWN IN METRES.
- THIS DRAWING IS PREPARED BASED ON LATEST SURVEY DATA HELD ON APRIL-2022. GTS BENCH MARK OF 261.850M CONSIDERED ON TOP OF CANAL BRIDGE ABUTMENT AT DORANA VILLAGE ALONG THE NH1.
- DFC NEW CHAINAGE OF 1075.950M IS WITH REFERENCE TO THE IR KM OF 187.500KM END OF KM OF CP-303 (SECTION P-3 PILKHANI END) AGAINST THE EXISTING DFC CHAINAGE. 116277.742M ISSUED VIDE LETTER NO. COM/DFCC/CLUB/SURVEY/2021-301-2301/16-01/173.DT. 17.01.2023.
- BALLAST PROFILE HAS BEEN PROVIDED ACCORDING TO THE CLAUSE 1.11.3 OF STANDARD SCHEDULE OF DIMENSION (EASTERN CORRIDOR) & THE BALLAST CUSHION DIMENSION SHOWN IN 35CM ON GE-14 PARA 17. SPECIFICATIONS & RECOMMENDATIONS 2. TWO LAYER SYSTEM FIG. 10.

REFERENCE DRAWINGS :-

- FOR KEY PLAN REFER DRAWING NO. 301-2/AL/0001
- FOR LEGEND AND ABBREVIATIONS REFER DRAWING NO. 301-2/AL/1000
- FOR TYPICAL SECTION OF BALLAST PROFILE (FL-RL) REFFER DRG. NO. 301-2/TK/TFD/-004 (TR. 1952)

03.10.2024SUBMISSION OF AS-BUILT DRAWINGFOR APPROVAL

REV. DATE REVISION DETAILS PURPOSE OF ISSUE

SCALE
HOR - 1:1000
VER - 1:100
SHEET SIZE : A1

LEGEND:

- IR TRACK
- DFCC TRACK
- DFCC FUTURE PROPOSALS
- STRUCTURE / BUILDING
- DFCC TOE LINE
- DFCC FORMATION
- RETAINING WALL
- ROAD
- STREAM, DRAIN, NALA, CANAL.
- FENCE
- POWER LINES
- TBM
- ELECTRIC POLE/OHE MAST
- IR RAILWAY BOUNDARY
- DFCC BOUNDARY

TYPICAL SECTION

TRACK STRUCTURE

RAIL SECTION: 60Kg/m (UIC 60Kg/m)	Difference between FL- RL (Below Rail Seat)	
DFC LINE: 60Kg/m (UIC 60Kg/m)	IR Line	DFC
IR MAIN LINE: 52Kg/m	172mm	172mm
RUBBER PAD	6mm	10mm
SLEEPER DEPTH	210mm	210mm
BALLAST CUSHION	300mm	350mm
Total Depth (FL TO RL)	688mm	742mm

OWNER
DEDICATED FREIGHT CORRIDOR CORPORATION OF INDIA LTD.
(A GOVERNMENT OF INDIA ENTERPRISE)
PROJECT OFFICE (AMBALA UNIT): OLD RAILWAY COLONY (NEAR ANAND MARKET), AMBALA CANTT-133001.
CORPORATE IDENTITY NO. : U60232DL2006GGI155068

ENGINEER:
DB Engineering & Consulting GmbH
Deutsche Bahn Engineering & Consulting GmbH

CONTRACTOR:
GIL - TPL JV
GAR TATA

SUBMITTED BY	GIL - TPL JV		
	DATED	NAME	SIGNATURE
PREPARED BY	03.10.2024	VIJAY PRATAP	
CHECKED BY	03.10.2024	PARASURAM KOTYADA	
APPROVED BY	DEUTSCHE BAHN ENGINEERING & CONSULTING GMBH		
	DATED	NAME	SIGNATURE
Sr. DE./CHIEF ENGINEER		SURESH K.YALANGI	
CHIEF TRACK ENGINEER		RAJ PAL SINGH	
T.L.		H.D. VIDJAK	

STAMP
A AS-BUILT DRAWING
TR. Ref.:.....
ENGINEER Sign.:.....

EMPLOYER (DFCCIL): DEDICATED FREIGHT CORRIDOR CORPORATION OF INDIA LTD.

AS BUILT DRAWING

TITLE AS-BUILT PLAN AND PROFILE FROM IR KM: 339.000 TO 339.500 FROM DFC KM: 1229.887 to 1230.387	DFCC APPR. NO. - ENGG. APPR. NO. - DRG. NO. -301-2/AL/A/1304 SHEET NO. : 1 OF 1 DATE : 03.10.2024	STATUS A
---	---	-------------

TR.