


- REFERENCE DRAWINGS :

- | | | | |
|------|------------|--------------------------------|------------------|
| | | | |
| 0 | 03.10.2024 | SUBMISSION OF AS-BUILT DRAWING | FOR APPROVAL |
| REV. | DATE | REVISION DETAILS | PURPOSE OF ISSUE |

OWNER	DEDICATED FREIGHT CORRIDOR CORPORATION OF INDIA LTD.
-------	--

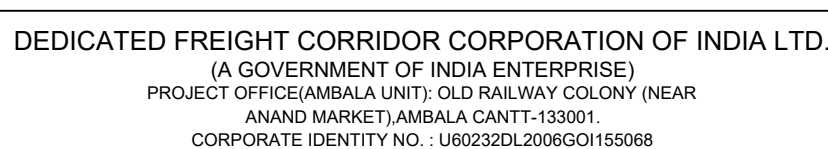

 **DB Engineering & Consulting GmbH**
Deutsche Bahn Engineering & Consulting GmbH

Oil Trillium



APPROVED BY	DEUTSCHE BAHN ENGINEERING & CONSULTING GMBH
-------------	---

[illegible]

AS BUILT DRAWING

TITLE	DFCC APPR. NO. -
AC BUILT PLAN AND PROFILE	

TR.
