
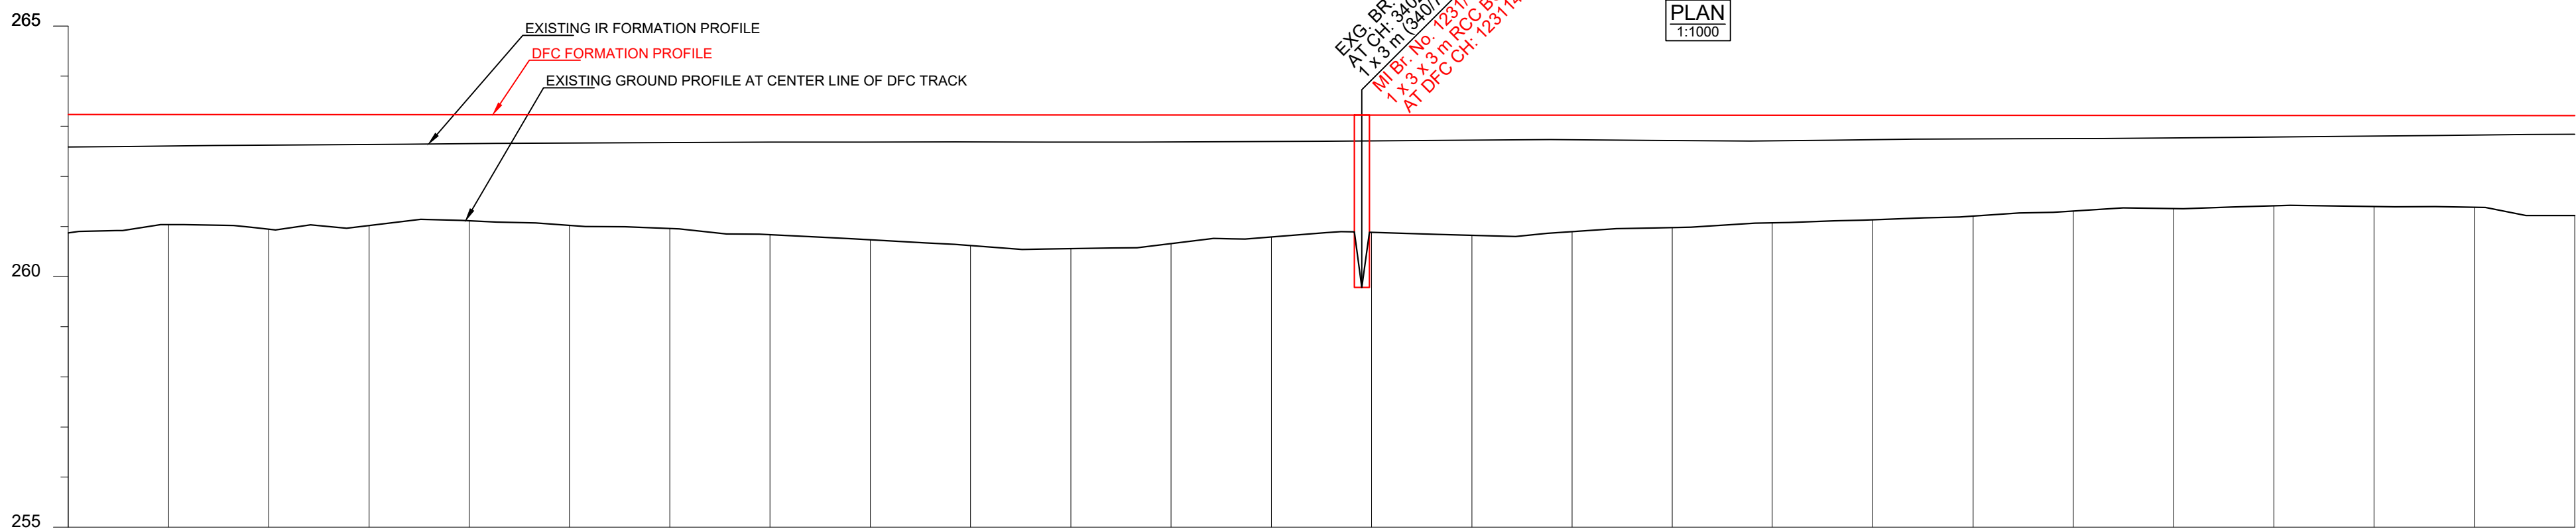


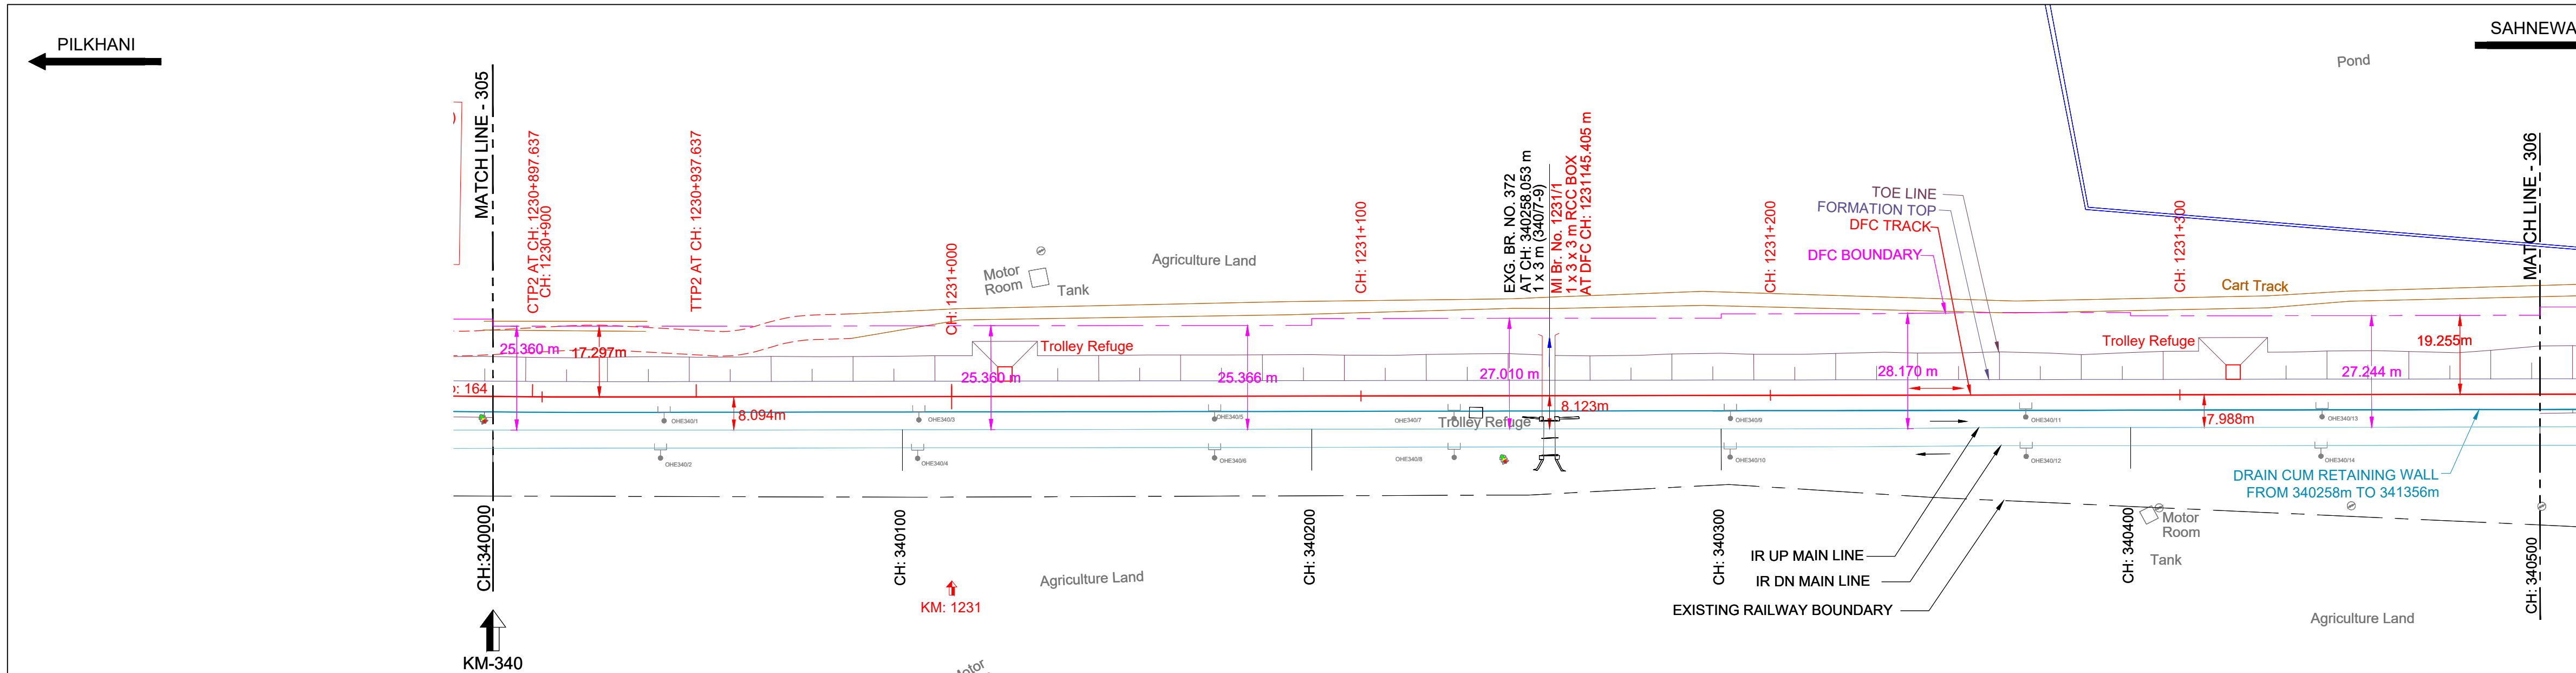

DATUM ABOVE MSL : 255 m

HORIZONTAL ALIGNMENT	R = 3000m TL = 40m		L = 2129.106m																							
VERTICAL ALIGNMENT			L=1641.322 m 1 IN 22147.416 F																							
TRACK DISTANCE FROM EXISTING NEAREST IR UP MAIN LINE TO DFC MAIN LINE	8.185	8.073	8.066	8.098	8.100	8.091	8.085	8.087	8.104	8.117	8.117	8.116	8.112	8.126	8.157	8.183	8.190	8.162	8.014	7.963	7.979	7.988	7.994	7.995	7.985	7.987
HEIGHT OF BANKING(+) / DEPTH OF CUTTING(-) (PFL-GL)	+2.363	+2.194	+2.287	+2.213	+2.116	+2.206	+2.267	+2.390	+2.493	+2.605	+2.669	+2.565	+2.434	+2.341	+2.396	+2.323	+2.241	+2.146	+2.066	+2.011	+1.907	+1.856	+1.801	+1.815	+1.829	+1.994
EXG GROUND LEVEL AT CENTER LINE OF DFC TRACK (GL)	260.872	261.040	260.946	261.019	261.115	261.024	260.962	260.838	260.735	260.622	260.557	260.660	260.790	260.882	260.826	260.898	260.979	261.073	261.133	261.207	261.310	261.360	261.414	261.399	261.384	261.218
EXG GROUND LEVEL AT TOE LOCATION OF DFC TRACK	260.133	260.225	260.098	260.147	260.121	260.080	260.016	260.043	259.956	259.989	259.944	260.054	259.869	260.109	260.087	259.841	259.992	259.756	259.827	259.886	259.677	259.677	259.809	259.639	259.919	259.105
DIFFERENCE BETWEEN DFC FORMATION LEVEL AND EXG FORMATION LEVEL (PFL-EFL)	0.650	0.627	0.609	0.596	0.579	0.566	0.556	0.545	0.542	0.540	0.542	0.539	0.529	0.516	0.500	0.491	0.505	0.510	0.484	0.468	0.462	0.447	0.429	0.409	0.387	0.372
DFC FORMATION LEVEL (PFL)	263.235	263.234	263.233	263.232	263.231	263.230	263.229	263.228	263.228	263.227	263.226	263.225	263.224	263.223	263.222	263.221	263.220	263.219	263.219	263.218	263.217	263.216	263.215	263.214	263.213	263.212
EXG. FORMATION LEVEL OF EXG IR UP MAIN LINE (EFL)	262.585	262.607	262.624	262.636	262.653	262.664	262.674	262.684	262.686	262.686	262.684	262.686	262.695	262.707	262.723	262.730	262.715	262.709	262.735	262.749	262.755	262.769	262.786	262.805	262.826	262.840
DIFFERENCE BETWEEN DFC RAIL LEVEL AND EXG. RAIL LEVEL (PRL - ERL)	0.691	0.668	0.651	0.637	0.620	0.607	0.597	0.586	0.583	0.582	0.583	0.580	0.570	0.557	0.541	0.532	0.546	0.552	0.525	0.510	0.503	0.489	0.470	0.451	0.429	0.413
DFC RAIL LEVEL (PRL)	263.946	263.947	263.946	263.945	263.945	263.944	263.943	263.942	263.941	263.940	263.939	263.938	263.937	263.936	263.935	263.934	263.934	263.933	263.932	263.931	263.930	263.929	263.928	263.927	263.927	263.926
EXG. RAIL LEVEL OF NEAREST IR UP MAIN LINE (ERL)	263.257	263.279	263.296	263.308	263.325	263.336	263.346	263.356	263.358	263.358	263.356	263.358	263.367	263.379	263.395	263.402	263.387	263.381	263.407	263.421	263.441	263.441	263.458	263.477	263.498	263.512
EQUIVALENT CHAINAGE ON DFC TRACK	-1230887.3	-1230907.3	-1230927.3	-1230947.3	-1230967.3	-1230987.3	-1231007.3	-1231027.3	-1231047.3	-1231067.3	-1231087.3	-1231107.3	-1231127.3	-1231147.3	-1231167.3	-1231187.3	-1231207.3	-1231227.3	-1231247.3	-1231267.3	-1231287.3	-1231307.3	-1231327.3	-1231347.3	-1231367.3	-1231387.3
EXISTING IR CHAINAGE	340000.0	340020.0	340040.0	340060.0	340080.0	340100.0	340120.0	340140.0	340160.0	340180.0	340200.0	340220.0	340240.0	340260.0	340280.0	340300.0	340320.0	340340.0	340360.0	340380.0	340400.0	340420.0	340440.0	340460.0	340480.0	340500.0

L - SECTION

DRG NO. - 301-2/AL/A/1306

NOTE:-
1. DFC WORKS ARE SHOWN IN RED.
2. IR NEW WORKS ARE SHOWN IN VIOLET.
3. ALL DIMENSIONS ARE SHOWN IN METRES.
4. THIS DRAWING IS PREPARED BASED ON LATEST SURVEY DATA HELD ON APRIL-2022. GTS BENCH MARK OF 261.850M CONSIDERED ON TOP OF CANAL BRIDGE ABUTMENT AT DORANA VILLAGE ALONG THE NH1.
5. DFC NEW CHAINAGE OF 1075.950M IS WITH REFERENCE TO THE IR KM OF 187.500KM END OF KM OF CP-303(SECTION P-3 PILKHANI END) AGAINST THE EXISTING DFC CHAINAGE. 116277.742M ISSUED VIDE LETTER NO. COM/DFCC/MB/SURVEY/2021-301-230116-011173 DT. 17.01.2023.
6. BALLAST PROFILE HAS BEEN PROVIDED ACCORDING TO THE CLAUSE 1.11.3 OF STANDARD SCHEDULE OF DIMENSION(EASTERN CORRIDOR) & THE BALLAST CUSHION DIMENSION SHOWN IN 35CM ON GE-14 PARA 17. SPECIFICATIONS & RECOMMENDATIONS 2. TWO LAYER SYSTEM FIG.10.

REFERENCE DRAWINGS :-
1. FOR KEY PLAN REFER DRAWING NO. 301-2/AL/0001
2. FOR LEGEND AND ABBREVIATIONS REFER DRAWING NO. 301-2/AL/1000
3. FOR TYPICAL SECTION OF BALLAST PROFILE (FL-RL) REFER DRG. NO. 301-2/TK/TFD/-004 (TR.1952)

03.10.2024

SUBMISSION OF AS-BUILT DRAWING

FOR APPROVAL

REV.

DATE

REVISION DETAILS

PURPOSE OF ISSUE

SCALE
HOR - 1:1000
VER - 1:100
SHEET SIZE : A1

LEGEND:
IR TRACK
DFCC TRACK
DFCC FUTURE PROPOSALS
STRUCTURE / BUILDING
DFCC TOE LINE
DFCC FORMATION
RETAINING WALL
ROAD
STREAM, DRAIN, NALA, CANAL.
FENCE
POWER LINES
TBM
ELECTRIC POLE/OHE MAST
IR RAILWAY BOUNDARY
DFCC BOUNDARY

TYPICAL SECTION

TRACK STRUCTURE

RAIL SECTION: 60Kg/m (UIC 60Kg/m) DFC LINE: 60Kg/m (UIC 60Kg/m) IR MAIN LINE: 52Kg/m	Difference between FL - RL (Below Rail Seat)	
	IR Line	DFC
	172mm	172mm
RUBBER PAD	6mm	10mm
SLEEPER DEPTH	210mm	210mm
BALLAST CUSHION	300mm	350mm
Total Depth (FL TO RL)	688mm	742mm

OWNER

DEDICATED FREIGHT CORRIDOR CORPORATION OF INDIA LTD.
(A GOVERNMENT OF INDIA ENTERPRISE)
PROJECT OFFICE (AMBALA UNIT): OLD RAILWAY COLONY (NEAR ANAND MARKET), AMBALA CANTT-133001.
CORPORATE IDENTITY NO. : U60232DL2006GGI155068

ENGINEER:

DB Engineering & Consulting GmbH
Deutsche Bahn Engineering & Consulting GmbH

CONTRACTOR:

GIL - TPL JV
GAR TATA

SUBMITTED BY	GIL - TPL JV		
	DATED	NAME	SIGNATURE
PREPARED BY			
CHECKED BY	03.10.2024	VIJAY PRATAP	
APPROVED BY	03.10.2024	PARASURAM KOTYADA	

APPROVED BY	DEUTSCHE BAHN ENGINEERING & CONSULTING GMBH		
	DATED	NAME	SIGNATURE
Sr. DE./CHIEF ENGINEER		SURESH K.YALANGI	
CHIEF TRACK ENGINEER		RAJ PAL SINGH	
T.L.		H.D. VIDJAK	

STAMP

A AS-BUILT DRAWING
TR. Ref.:.....
ENGINEER Sign.:.....

EMPLOYER (DFCCIL):

DEDICATED FREIGHT CORRIDOR CORPORATION OF INDIA LTD.

AS BUILT DRAWING

TITLE
AS-BUILT PLAN AND PROFILE
FROM IR KM: 340.000 TO 340.500
FROM DFC KM: 1230.887 to 1231.387

DFCC APPR. NO. -
ENGG. APPR. NO. -
DRG. NO. - 301-2/AL/A/1306
SHEET NO. : 1 OF 1
DATE : 03.10.2024

STATUS
A

TR.