
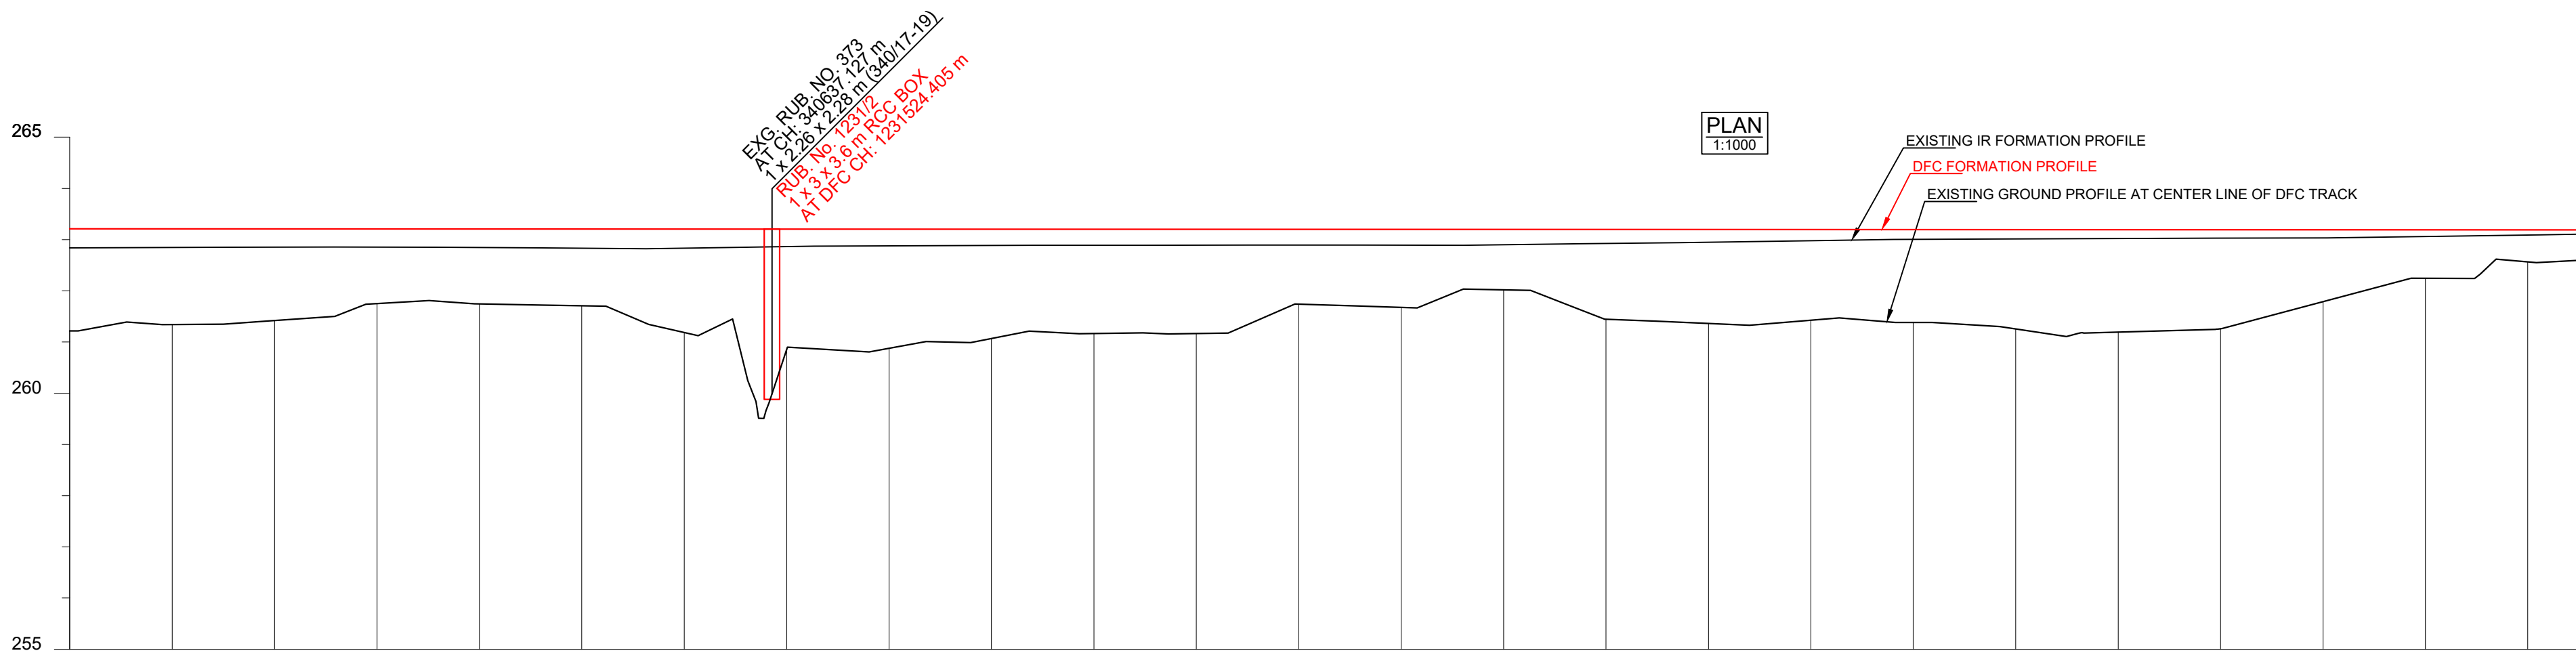


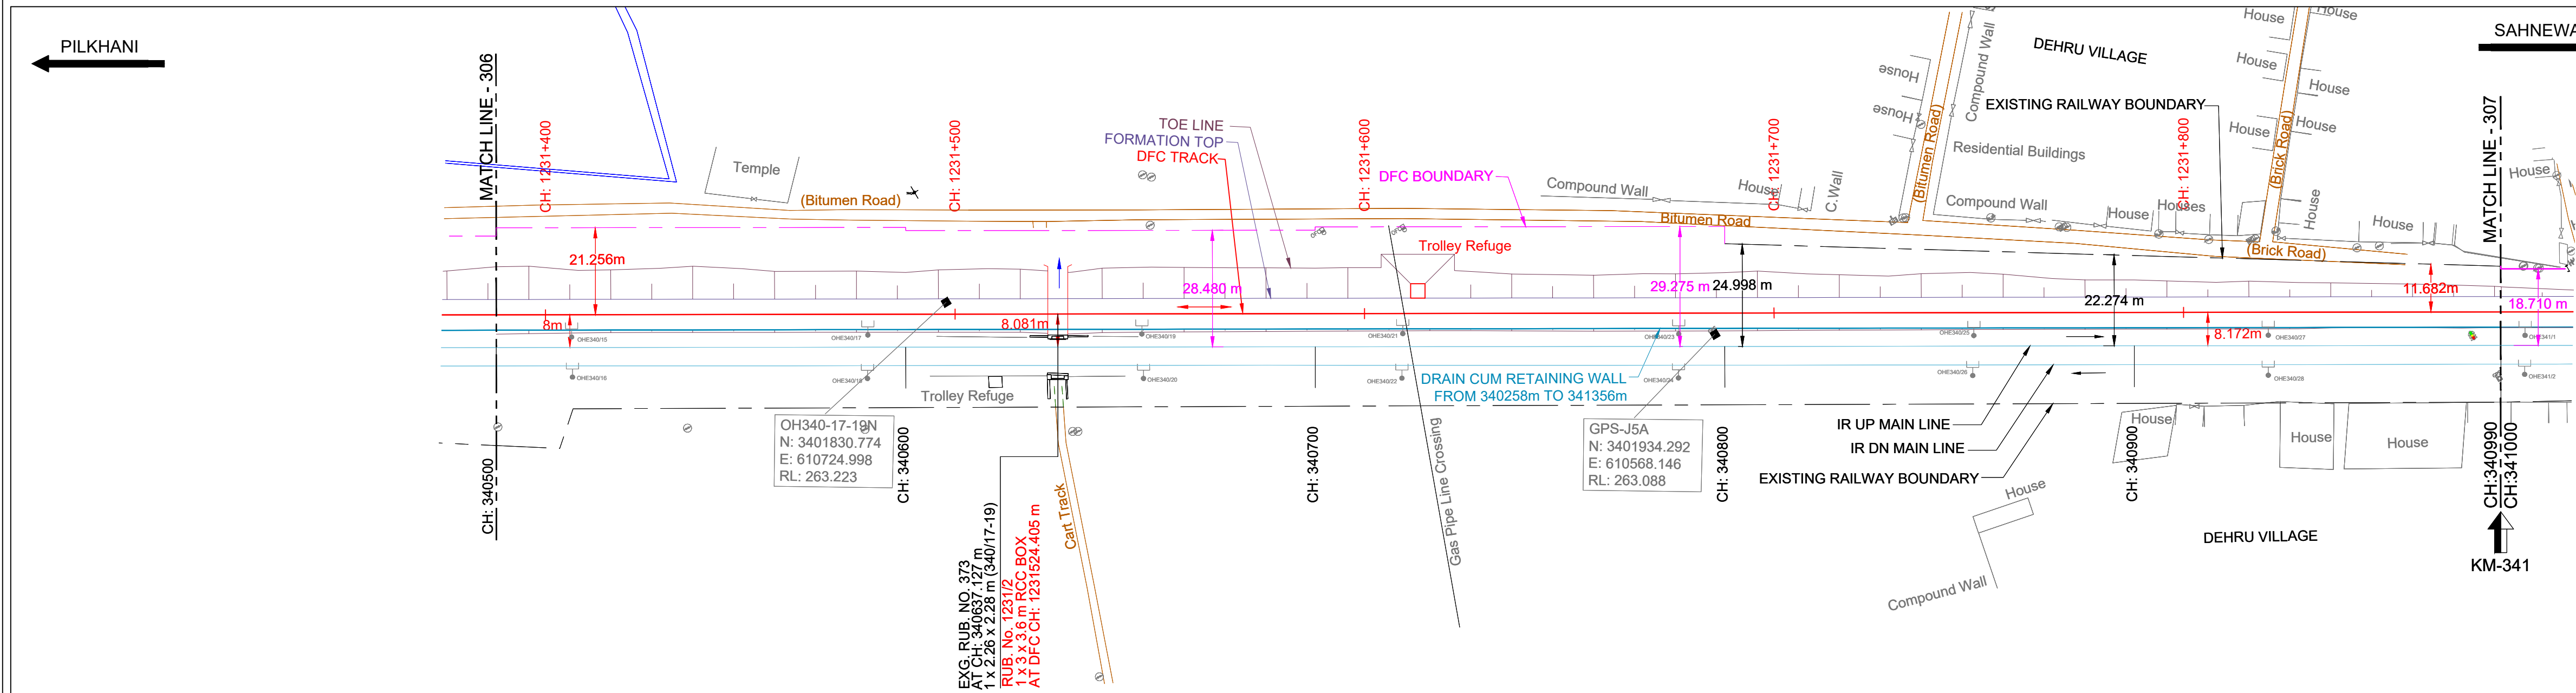

|                                                                          |                                  |--------------------------------------------------------------------------|----------------------------------|------------|------------|------------|------------|------------|------------|------------|------------|------------|------------|------------|------------|------------|------------|------------|------------|------------|------------|
| HORIZONTAL ALIGNMENT                                                     | L = 2129.106m                    |            |            |            |            |            |            |            |            |            |            |            |            |            |            |            |            |            |            |
| VERTICAL ALIGNMENT                                                       | L=1641.322 m<br>1 IN 22147.416 F |            |            |            |            |            |            |            |            |            |            |            |            |            |            |            |            |            |            |
| TRACK DISTANCE FROM EXISTING NEAREST IR UP MAIN LINE TO DFC MAIN LINE    | 7.987                            | 8.001      | 8.016      | 8.031      | 8.041      | 8.046      | 8.058      | 8.084      | 8.088      | 8.083      | 8.088      | 8.100      | 8.112      | 8.124      | 8.138      | 8.156      | 8.167      | 8.164      | 8.160      |
| HEIGHT OF BANKING(+) / DEPTH OF CUTTING(-) (PFL-GL)                      | +1.994                           | +1.870     | +1.790     | +1.457     | +1.466     | +1.499     | +2.021     | +2.346     | +2.327     | +2.136     | +2.038     | +2.037     | +1.463     | +1.523     | +1.181     | +1.753     | +1.835     | +1.771     | +1.816     |
| EXG GROUND LEVEL AT CENTER LINE OF DFC TRACK (GL)                        | -261.218                         | -261.341   | -261.420   | -261.752   | -261.743   | -261.709   | -261.186   | -260.860   | -260.878   | -261.068   | -261.165   | -261.165   | -261.738   | -261.677   | -262.019   | -261.446   | -261.363   | -261.426   | -261.360   |
| EXG GROUND LEVEL AT TOE LOCATION OF DFC TRACK                            | -259.105                         | -259.574   | -259.339   | -259.376   | -259.708   | -259.877   | -259.431   | -259.906   | -259.275   | -259.355   | -259.412   | -259.380   | -259.912   | -260.276   | -260.164   | -260.038   | -260.204   | -260.482   | -260.064   |
| DIFFERENCE BETWEEN DFC FORMATION LEVEL AND EXG.FORMATION LEVEL.(PFL-EFL) | 0.372                            | 0.364      | 0.359      | 0.357      | 0.364      | 0.376      | 0.373      | 0.341      | 0.326      | 0.318      | 0.313      | 0.311      | 0.309      | 0.309      | 0.300      | 0.274      | 0.249      | 0.217      | 0.189      |
| DFC FORMATION LEVEL (PFL)                                                | -263.212                         | -263.211   | -263.210   | -263.209   | -263.209   | -263.208   | -263.207   | -263.206   | -263.205   | -263.204   | -263.203   | -263.202   | -263.201   | -263.200   | -263.200   | -263.199   | -263.198   | -263.197   | -263.196   |
| EXG. FORMATION LEVEL OF EXG IR UP MAIN LINE (EFL)                        | -262.840                         | -262.847   | -262.852   | -262.853   | -262.845   | -262.831   | -262.834   | -262.865   | -262.879   | -262.886   | -262.890   | -262.891   | -262.892   | -262.892   | -262.899   | -262.925   | -262.949   | -262.980   | -263.007   |
| DIFFERENCE BETWEEN DFC RAIL LEVEL AND EXG. RAIL LEVEL (PRL - ERL)        | 0.413                            | 0.406      | 0.400      | 0.398      | 0.405      | 0.418      | 0.414      | 0.382      | 0.367      | 0.359      | 0.354      | 0.353      | 0.350      | 0.350      | 0.342      | 0.316      | 0.291      | 0.258      | 0.230      |
| DFC RAIL LEVEL (PRL)                                                     | -263.926                         | -263.925   | -263.924   | -263.923   | -263.922   | -263.921   | -263.920   | -263.919   | -263.918   | -263.917   | -263.917   | -263.916   | -263.915   | -263.914   | -263.913   | -263.912   | -263.911   | -263.910   | -263.909   |
| EXG.RAIL LEVEL OF NEAREST IR UP MAIN LINE(ERL)                           | -263.512                         | -263.519   | -263.524   | -263.525   | -263.517   | -263.503   | -263.506   | -263.537   | -263.551   | -263.558   | -263.562   | -263.563   | -263.564   | -263.564   | -263.571   | -263.597   | -263.621   | -263.652   | -263.679   |
| EQUIVALENT CHAINAGE ON DFC TRACK                                         | -1231387.3                       | -1231407.3 | -1231427.3 | -1231447.3 | -1231467.3 | -1231487.3 | -1231507.3 | -1231527.3 | -1231547.3 | -1231567.3 | -1231587.3 | -1231607.3 | -1231627.3 | -1231647.3 | -1231667.3 | -1231687.3 | -1231707.3 | -1231727.3 | -1231747.3 |
| EXISTING IR CHAINAGE                                                     | 340500.0                         | 340520.0   | 340540.0   | 340560.0   | 340580.0   | 340600.0   | 340620.0   | 340640.0   | 340660.0   | 340680.0   | 340700.0   | 340720.0   | 340740.0   | 340760.0   | 340780.0   | 340800.0   | 340820.0   | 340840.0   | 340860.0   |

L - SECTION

NOTE:-

- DFCC WORKS ARE SHOWN IN RED.
- IR NEW WORKS ARE SHOWN IN VIOLET.
- ALL DIMENSIONS ARE SHOWN IN METRES.
- THIS DRAWING IS PREPARED BASED ON LATEST SURVEY DATA HELD ON APRIL-2022. GTS BENCH MARK OF 261.850M CONSIDERED ON TOP OF CANAL BRIDGE ABUTMENT AT DORAHA VILLAGE ALONG THE NH1.
- DFC NEW CHAINAGE OF 1075.950M IS WITH REFERENCE TO THE IR KM OF 187.500KM END OF KM OF CP-303(SECTION P-3 PILKHANI END) AGAINST THE EXISTING DFC CHAINAGE. 116277.742M ISSUED VIDE LETTER NO. COM/DFCC/UM/SURVEY/2021-301-230116-011173 DT. 17.01.2023.
- BALLAST PROFILE HAS BEEN PROVIDED ACCORDING TO THE CLAUSE 1.11.3 OF STANDARD SCHEDULE OF DIMENSION(EASTERN CORRIDOR) & THE BALLAST CUSHION DIMENSION SHOWN IN 35CM ON GE-14 PARA 17. SPECIFICATIONS & RECOMMENDATIONS 2. TWO LAYER SYSTEM FIG.10.

REFERENCE DRAWINGS :-

- FOR KEY PLAN REFER DRAWING NO. 301-2/AL/0001
- FOR LEGEND AND ABBREVIATIONS REFER DRAWING NO. 301-2/AL/1000
- FOR TYPICAL SECTION OF BALLAST PROFILE (FL-RL) REFER DRG. NO. 301-2/TK/TFD/-004 (TR.1952)

LEGEND:

IR TRACK  
DFCC TRACK  
DFCC FUTURE PROPOSALS  
STRUCTURE / BUILDING  
DFCC TOE LINE  
DFCC FORMATION  
RETAINING WALL  
ROAD  
STREAM, DRAIN, NALA, CANAL.  
FENCE  
POWER LINES  
TBM  
ELECTRIC POLE/OHE MAST  
IR RAILWAY BOUNDARY  
DFCC BOUNDARY

SCALE

HOR - 1:1000  
VER - 1:100  
SHEET SIZE : A1

TYPICAL SECTION

| TRACK STRUCTURE                                                                            |                                             |       |
|--------------------------------------------------------------------------------------------|---------------------------------------------|-------|
| RAIL SECTION: 60Kg/m (UIC 60Kg/m)<br>DFC LINE: 60Kg/m (UIC 60Kg/m)<br>IR MAIN LINE: 52Kg/m | Difference between FL- RL (Below Rail Seat) |       |
|                                                                                            | IR Line                                     | DFC   |
|                                                                                            | 172mm                                       | 172mm |
| RUBBER PAD                                                                                 | 6mm                                         | 10mm  |
| SLEEPER DEPTH                                                                              | 210mm                                       | 210mm |
| BALLAST CUSHION                                                                            | 300mm                                       | 350mm |
| Total Depth (FL TO RL)                                                                     | 688mm                                       | 742mm |

OWNER

DEDICATED FREIGHT CORRIDOR CORPORATION OF INDIA LTD.  
(A GOVERNMENT OF INDIA ENTERPRISE)  
PROJECT OFFICE(AMBALA UNIT): OLD RAILWAY COLONY (NEAR ANAND MARKET),AMBALA CANTT-133001.  
CORPORATE IDENTITY NO. : U60232DL2006GGI155068

ENGINEER:

DB Engineering & Consulting GmbH  
Deutsche Bahn Engineering & Consulting GmbH

CONTRACTOR:

GIL - TPL JV  
GAR TATA

| GIL - TPL JV           |                                             |                   |           |
|------------------------|---------------------------------------------|-------------------|-----------|
| SUBMITTED BY           | DATED                                       | NAME              | SIGNATURE |
| PREPARED BY            | 03.10.2024                                  | VIJAY PRATAP      |           |
| CHECKED BY             | 03.10.2024                                  | PARASURAM KOTYADA |           |
| APPROVED BY            | DEUTSCHE BAHN ENGINEERING & CONSULTING GMBH |                   |           |
|                        | DATED                                       | NAME              | SIGNATURE |
| Sr. DE./CHIEF ENGINEER |                                             | SURESH K.YALANGI  |           |
| CHIEF TRACK ENGINEER   |                                             | RAJ PAL SINGH     |           |
| T.L.                   |                                             | H.D. VIDJAK       |           |

STAMP

A AS-BUILT DRAWING  
TR. Ref.:.....  
ENGINEER Sign.:.....

EMPLOYER (DFCCIL): DEDICATED FREIGHT CORRIDOR CORPORATION OF INDIA LTD.

AS BUILT DRAWING

|                                   |                           |             |
|-----------------------------------|---------------------------|-------------|
| TITLE                             | DFCC APPR. NO. -          | STATUS<br>A |
| AS-BUILT PLAN AND PROFILE         | ENG. APPR. NO. -          |             |
| FROM IR KM: 340.500 TO 341.000    | DRG. NO. :301-2/AL/A/1307 |             |
| FROM DFC KM: 1231.387 to 1231.877 | SHEET NO. : 1 OF 1        |             |
|                                   | DATE : 03.10.2024         |             |

TR.