




DEDICATED FREIGHT CORRIDOR CORPORATION OF INDIA LTD.
(A GOVERNMENT OF INDIA ENTERPRISE)

EASTERN DEDICATED FREIGHT CORRIDOR
SAHNEWAL TO PILKHANI SECTION
CONTRACT PACKAGE - 301

PLAN & PROFILE OF AS BUILT DRAWINGS FOR DFC MAIN LINE

IR CHAINAGE FROM 341.000 KM TO 350.000 KM
DFCC CHAINAGE FROM KM 1231.877 TO KM 1240.877

DESIGN CONSULTANT


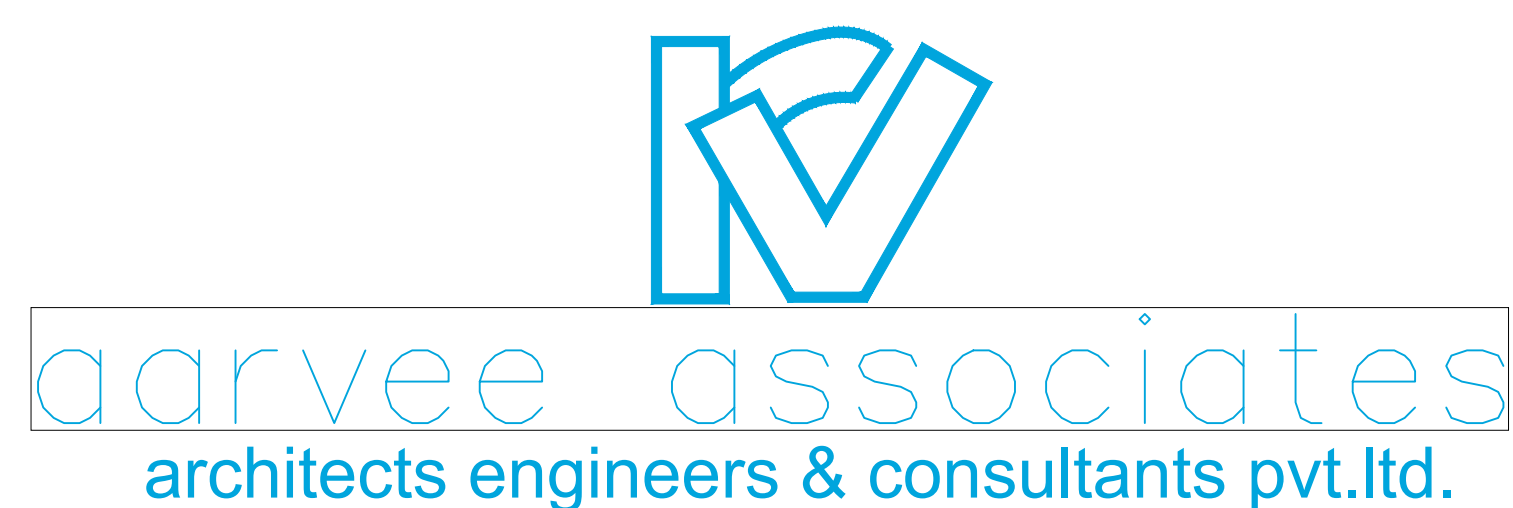


ENGINEER



CONTRACTOR CLIENT
GIL - TPL JV



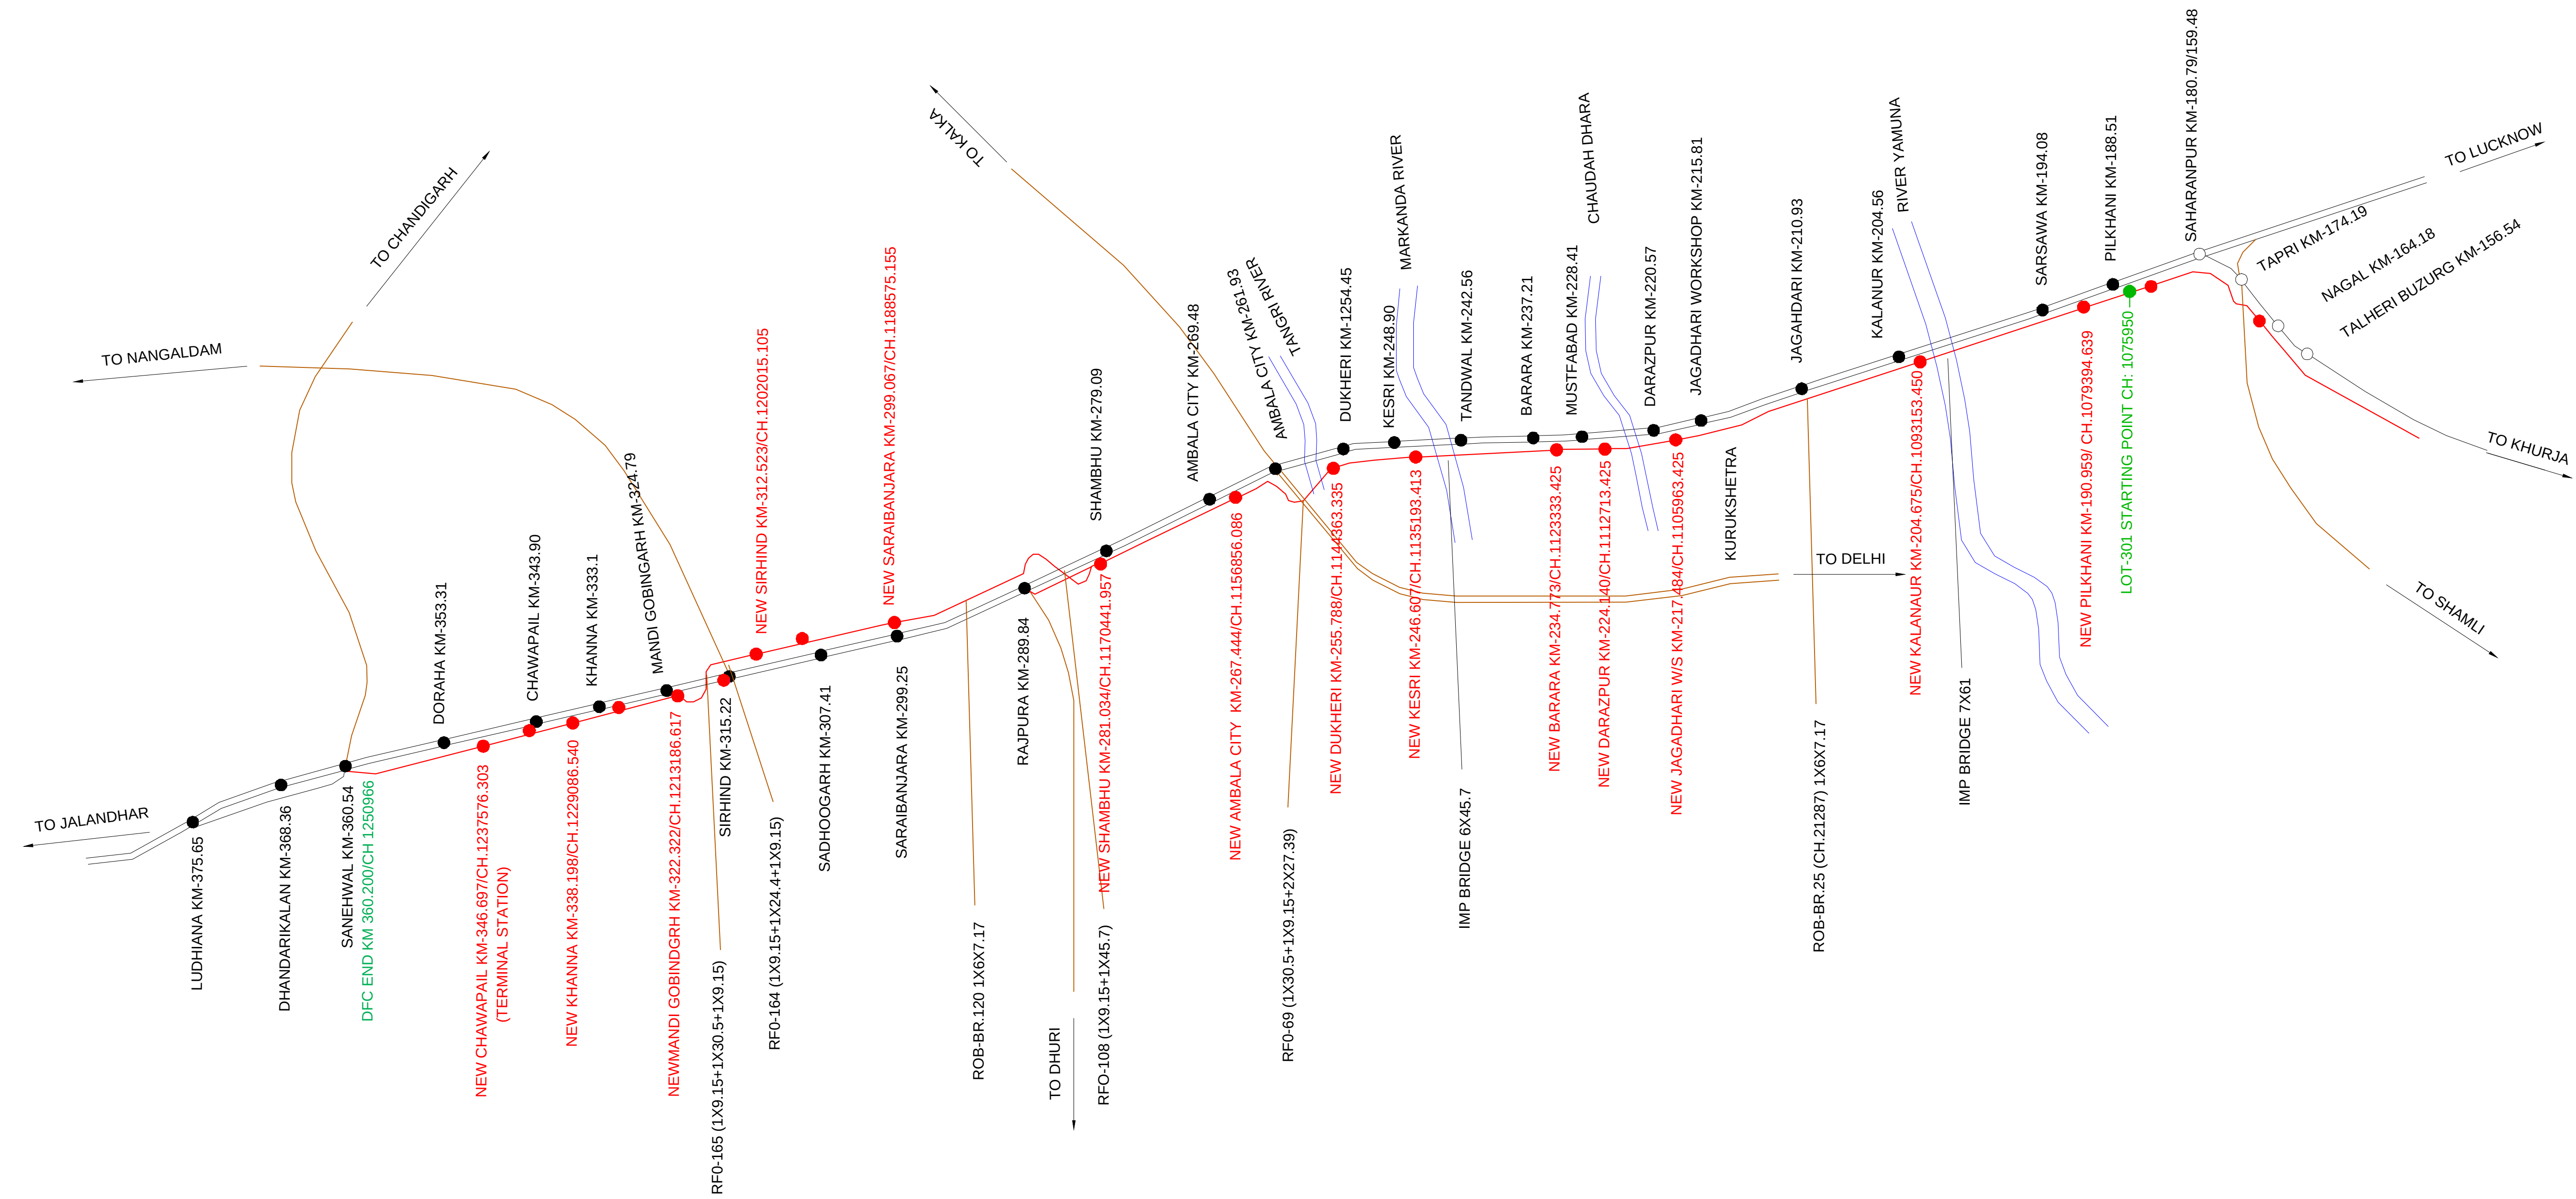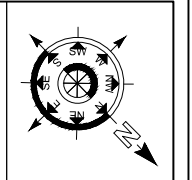

--	--	
DESIGN CONSULTANT

aarvee associates
architects engineers & consultants pvt.ltd.

CONTRACTOR

GIL - TPL JV

ENGINEER

DB Engineering & Consulting GmbH

OWNER

उत्तर प्रदेश रेलवे कोरपोरेशन लिमिटेड

DEDICATED FREIGHT CORRIDOR CORPORATION OF INDIA LTD.
(A GOVERNMENT OF INDIA ENTERPRISE)
PROJECT OFFICE(AMBALA UNIT): OLD RAILWAY COLONY (NEAR ANAND MARKET),AMBALA CANTT-133001.
CORPORATE IDENTITY NO. : U60232DL2006GOI155068

PROJECT
EASTERN DEDICATED FREIGHT CORRIDOR
SAHNEWAL TO PILKHANI
CONTRACT PACKAGE - 301



TITLE
ALIGNMENT DRAWINGS
KEY PLAN

DFCC APPR. NO. -
ENGG. APPR. NO. -
DRG. NO. - 301-2/AL/0001
SHEET NO. : 1 OF 1
DATE : 15-06-2024
REV. No. 0
STATUS A

LEGEND	
EXISTING IR TRACK	
DFC TRACK	
DFC FUTURE PROPOSALS	
IR PROPOSALS	
TOE LINE	
FORMATION CESS	
RETAINING WALL	
DRAIN CUM RETAINING WALL	
ROAD	
STREAM, DRAIN, NALA, CANAL.	
FENCE	
POWER LINES	
GPS POINTS	
ELECTRIC POLE/OHE MAST	
EXISTING RAILWAY BOUNDARY	
DFC BOUNDARY	
DISMANTLED WORKS	
IOCL PIPE LINE	
IOCL ROW	
SIGNALLING CABLE PIPE	

ABBREVIATIONS		
1.	BL	- BED LEVEL
2.	BVC	- BEGIN OF VERTICAL CURVE
3.	Ca	- APPLIED CANT
4.	CCL	- CIRCULAR CURVE LENGTH
5.	CTP1	- COMMON TANGENT POINT
6.	CTP2	- COMMON TANGENT POINT
7.	DEGREE	- DEGREE OF CURVE
8.	DE	- DEAD END
9.	ECL	- EXISTING CLEARANCE
10.	EFB	- EXISTING FREE BOARD
11.	EFL	- EXISTING FORMATION LEVEL
12.	ERL	- EXISTING RAIL LEVEL
13.	ESL	- EXISTING SOFFIT LEVEL
14.	EVC	- END OF VERTICAL CURVE
15.	EVCL	- EXISTING VERTICAL CLEARANCE
16.	F/CSB	- FROM CENTER LINE OF STN BLDG
17.	FM	- FOULING MARK
18.	FSL	- FULL SUPPLY LEVEL
19.	HFL	- HIGH FLOOD LEVEL
20.	L	- STRAIGHT LENGTH
21.	LH	- LEFT HANDED
22.	LHS	- LIMITED HEIGHT SUBWAY
23.	PCL	- PROPOSED CLEARANCE
24.	PFB	- PROPOSED FREE BOARD
25.	PFL	- PROPOSED FORMATION LEVEL
26.	PRL	- PROPOSED RAIL LEVEL
27.	PSL	- PROPOSED SOFFIT LEVEL
28.	PVCL	- PROPOSED VERTICAL CLEARANCE
29.	PVI	- POINT OF VERTICAL INTERSECTION
30.	R	- RADIUS
31.	REV.BL	- REVISED BED LEVEL
32.	RH	- RIGHT HANDED
33.	Rr	- RESULTANT RADIUS
34.	SE	- SUPER ELEVATION
35.	SRJ	- STOCK RAIL JOINT
36.	TS	- TRAP SWITCH
37.	TTL	- TOTAL TANGENT LENGTH
38.	TTP1	- TRANSITION TANGENT POINT
39.	TTP2	- TRANSITION TANGENT POINT
40.	TL	- TRANSITION LENGTH
41.	DELTA	- DEFLECTION ANGLE

				SCALE	DESIGN CONSULTANT	CONTRACTOR	ENGINEER	OWNER	PROJECT	TITLE	DFCC APPR. NO. -					
				NOT TO SCALE	 aarvee associates architects engineers & consultants pvt.ltd.	  GIL - TPL JV	 DB Engineering & Consulting GmbH	 मेडीकेटर फ्रेट कॉर्पोरेश	DEDICATED FREIGHT CORRIDOR CORPORATION OF INDIA LTD. (A GOVERNMENT OF INDIA ENTERPRISE) PROJECT OFFICE(AMBALA UNIT): OLD RAILWAY COLONY (NEAR ANAND MARKET),AMBALA CANTT-133001. CORPORATE IDENTITY NO. : U60232DL2006GOI155068	EASTERN DEDICATED FREIGHT CORRIDOR SAHNEWAL TO PILKHANI CONTRACT PACKAGE - 301	ALIGNMENT DRAWINGS LEGEND AND ABBREVIATIONS	ENG. APPR. NO. -				
																DRG. NO. - 301-2/AL/1000
REV.	DATE	REVISION DETAILS	PURPOSE OF ISSUE								SHEET NO. : 1 OF 1	REV. No.	STATUS			
											DATE : 15-06-2024	0	A			

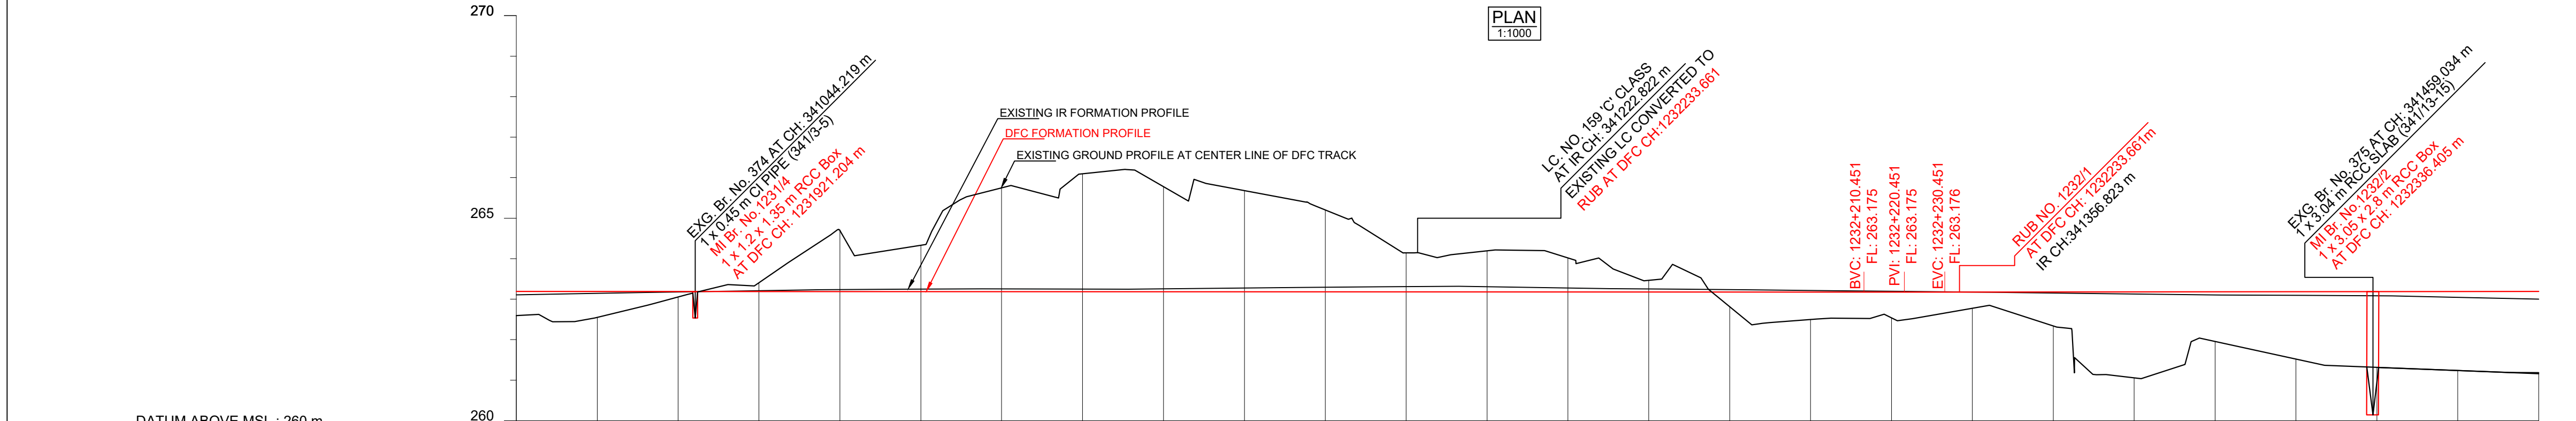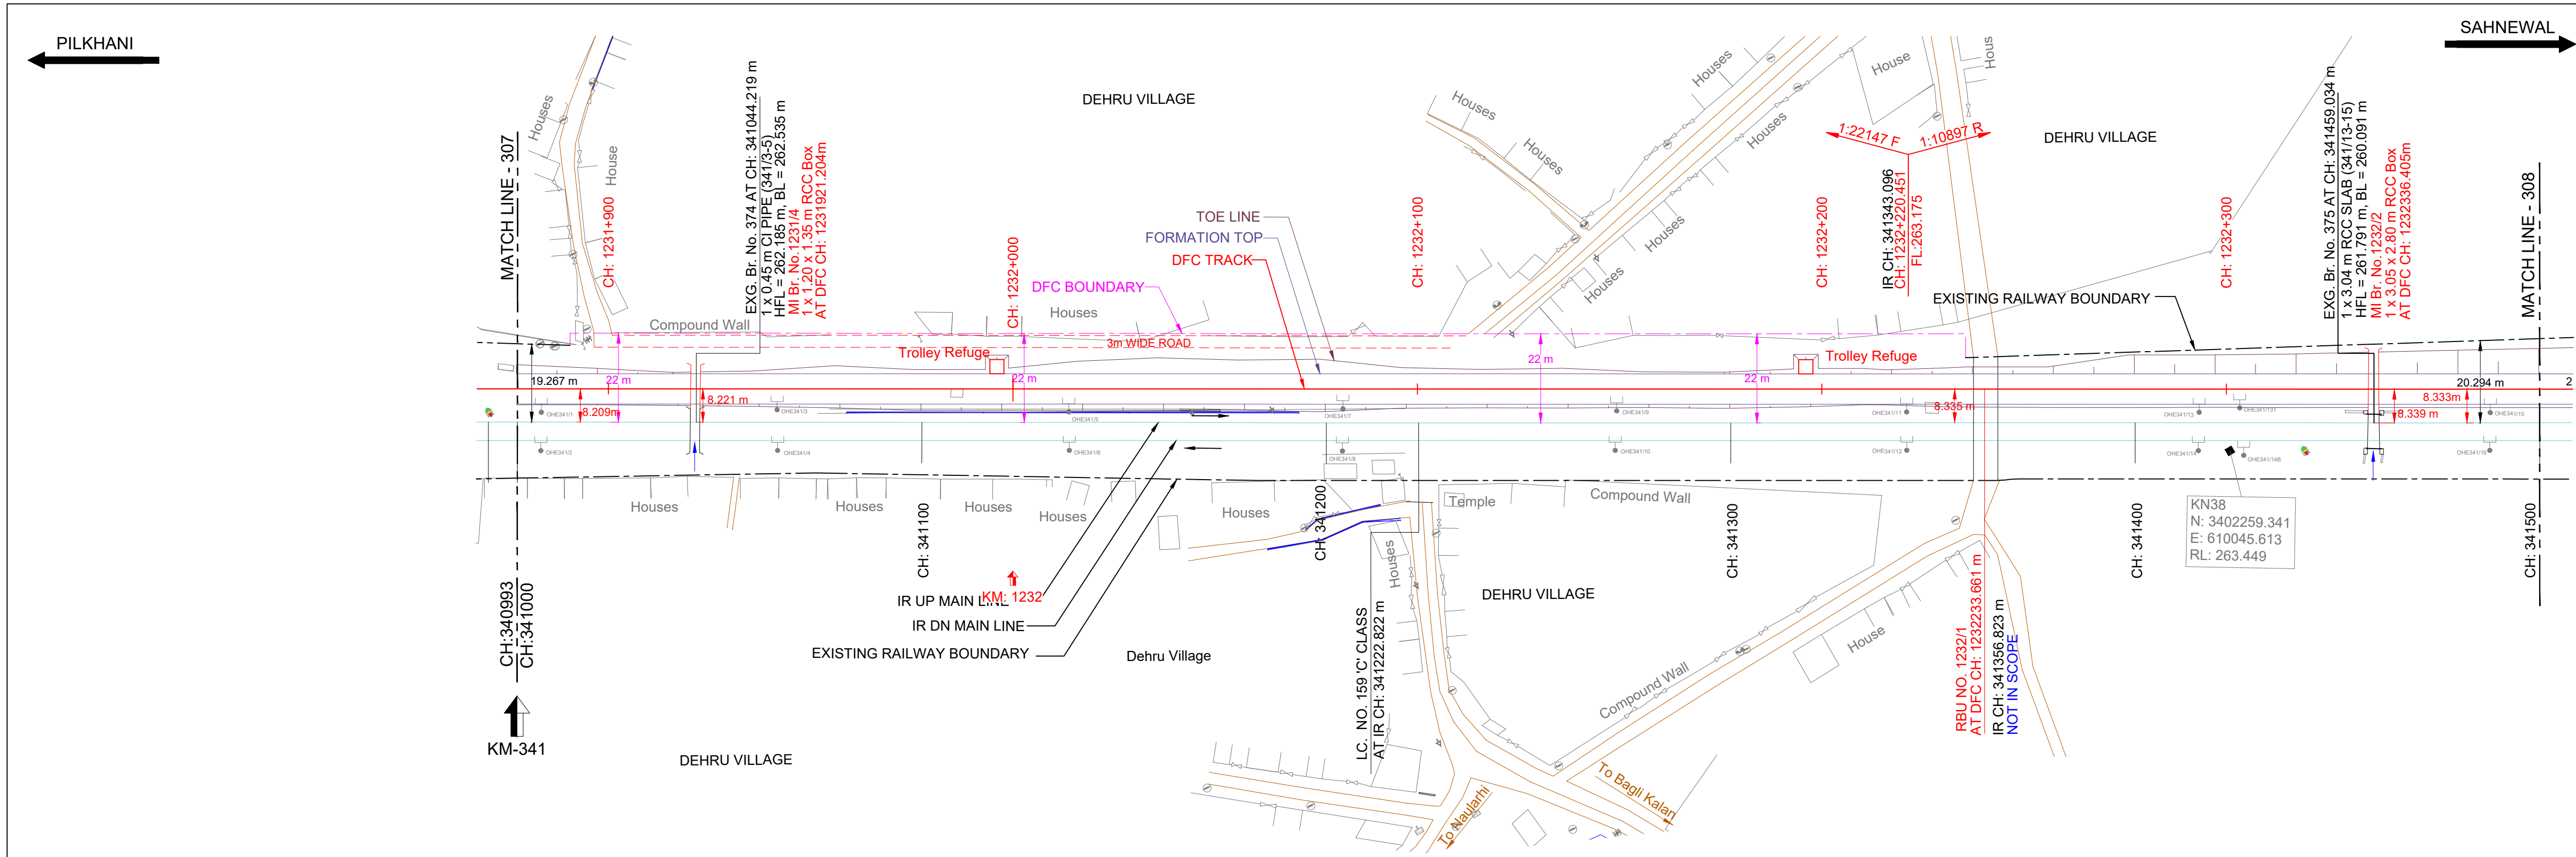

HORIZONTAL ALIGNMENT	L = 2129.106m																			
VERTICAL ALIGNMENT	L=1841.322 m 1 IN 22147.416 F																			
TRACK DISTANCE FROM EXISTING NEAREST IR UP MAIN LINE TO DFC MAIN LINE	8.199	8.212	8.221	8.223	8.235	8.281	8.305	8.261	8.269	8.345	8.391	8.379	8.370	8.367	8.365	8.364	8.355	8.344	8.333	8.322
HEIGHT OF BANKING(+) / DEPTH OF CUTTING(-) (PFL-GL)	+0.595	+0.639	+0.135	-0.217	-1.507	-1.143	-2.565	-2.912	-2.594	-2.498	-2.023	-0.962	-1.014	-0.840	-0.287	+0.365	+0.677	+0.637	+0.400	+0.841
EXG GROUND LEVEL AT CENTER LINE OF DFC TRACK (GL)	262.595	262.550	263.053	263.404	264.693	264.329	265.750	266.096	267.037	265.880	265.204	264.142	264.193	264.018	263.464	262.812	262.499	262.538	262.776	262.337
EXG GROUND LEVEL AT TOE LOCATION OF DFC TRACK	261.897	262.358	262.900	263.802	264.894	264.350	264.191	266.269	267.037	265.414	266.720	264.373	264.132	264.373	263.505	262.642	262.398	262.614	262.244	262.189
DIFFERENCE BETWEEN DFC FORMATION LEVEL AND EXG.FORMATION LEVEL (PFL-EFL)	0.083	0.045	0.010	-0.022	-0.050	-0.062	-0.070	-0.064	-0.070	-0.093	-0.113	-0.120	-0.129	-0.097	-0.073	-0.059	-0.040	-0.019	0.004	0.027
DFC FORMATION LEVEL (PFL)	263.191	263.190	263.169	263.188	263.187	263.186	263.185	263.184	263.183	263.182	263.181	263.180	263.179	263.178	263.177	263.176	263.176	263.175	263.176	263.178
EXG. FORMATION LEVEL OF EXG IR UP MAIN LINE (EFL)	263.107	263.144	263.178	263.210	263.236	263.247	263.254	263.248	263.253	263.275	263.295	263.309	263.308	263.275	263.250	263.238	263.216	263.193	263.172	263.151
DIFFERENCE BETWEEN DFC RAIL LEVEL AND EXG. RAIL LEVEL (PRL - ERL)	0.124	0.087	0.062	0.019	-0.009	-0.020	-0.028	-0.023	-0.029	-0.052	-0.072	-0.087	-0.087	-0.056	-0.032	-0.018	0.001	0.023	0.045	0.069
DFC RAIL LEVEL (PRL)	263.904	263.903	263.902	263.901	263.900	263.899	263.898	263.897	263.896	263.895	263.894	263.894	263.893	263.892	263.891	263.890	263.889	263.888	263.889	263.891
EXG.RAIL LEVEL OF NEAREST IR UP MAIN LINE(ERL)	263.779	263.816	263.850	263.882	263.908	263.919	263.926	263.920	263.925	263.947	263.967	263.981	263.980	263.947	263.922	263.908	263.888	263.865	263.844	263.823
EQUIVALENT CHAINAGE ON DFC TRACK	340985.5	341020.0	341040.0	341060.0	341080.0	341100.0	341120.0	341140.0	341160.0	341180.0	341200.0	341220.0	341240.0	341260.0	341280.0	341300.0	341320.0	341340.0	341360.0	341380.0
EXISTING IR CHAINAGE	341000.0	341020.0	341040.0	341060.0	341080.0	341100.0	341120.0	341140.0	341160.0	341180.0	341200.0	341220.0	341240.0	341260.0	341280.0	341300.0	341320.0	341340.0	341360.0	341380.0

L - SECTION

NOTE:-

- DFCC WORKS ARE SHOWN IN RED.
- IR NEW WORKS ARE SHOWN IN VIOLET.
- ALL DIMENSIONS ARE SHOWN IN METRES.
- THIS DRAWING IS PREPARED BASED ON LATEST SURVEY DATA HELD ON APRIL-2022. GTS BENCH MARK OF 261.85M CONSIDERED ON TOP OF CANAL BRIDGE ABUTMENT AT DORANA VILLAGE ALONG THE NH1.
- DFC NEW CHAINAGE OF 1075.950M IS WITH REFERENCE TO THE IR KM OF 187.500KM END OF KM OF CP-303(SECTION P-3 PILKHANI END) AGAINST THE EXISTING DFC CHAINAGE. 116277.742M ISSUED VIDE LETTER NO. GCM/DFCC/UM/SURVEY/2021-301-2301/6-011/173-DT. 17.01.2023.
- BALLAST PROFILE HAS BEEN PROVIDED ACCORDING TO THE CLAUSE 1.11.3 OF STANDARD SCHEDULE OF DIMENSION(EASTERN CORRIDOR) & THE BALLAST CUSHION DIMENSION SHOWN IN 35CM ON GE-14 PARA 17. SPECIFICATIONS & RECOMMENDATIONS 2. TWO LAYER SYSTEM FIG.10.

REFERENCE DRAWINGS :-

- FOR KEY PLAN REFER DRAWING NO. 301-2/AL/0001
- FOR LEGEND AND ABBREVIATIONS REFER DRAWING NO. 301-2/AL/1000
- FOR TYPICAL SECTION OF BALLAST PROFILE (FL-RL) REFER DRG. NO. 301-2/TK/TFD/004 (TR. 1952)

DRG NO. - 301-2/AL/A/1308

0	10.10.2024	SUBMISSION OF AS-BUILT DRAWING	FOR APPROVAL
REV.	DATE	REVISION DETAILS	PURPOSE OF ISSUE

LEGEND:

SCALE

HOR - 1:1000

VER - 1:100

SHEET SIZE : A1

TYPICAL SECTION

TRACK STRUCTURE

RAIL SECTION: 60Kg/m (UIC 60Kg/m)	
DFC LINE: 60Kg/m (UIC 60Kg/m)	IR MAIN LINE: 52Kg/m
RUBBER PAD	172mm
SLEEPER DEPTH	210mm
BALLAST CUSHION	300mm
Total Depth (FL TO RL)	688mm

OWNER

DEDICATED FREIGHT CORRIDOR CORPORATION OF INDIA LTD.

ENGINEER:

DB Engineering & Consulting GmbH

CONTRACTOR:

GIL - TPL JV

SUBMITTED BY	GIL - TPL JV		
	DATED	NAME	SIGNATURE
PREPARED BY	10.10.2024	VIJAY PRATAP	
CHECKED BY	10.10.2024	PARASURAM KOTYADA	
APPROVED BY	DEUTSCHE BAHN ENGINEERING & CONSULTING GMBH		
	DATED	NAME	SIGNATURE
Sr. DE./CHIEF ENGINEER		SURESH K.YALANGI	
CHIEF TRACK ENGINEER		RAJ PAL SINGH	
T.L.		H.D. VIDJAK	

STAMP

AS-BUILT DRAWING

TR. Ref.:.....

ENGINEER Sign.:.....

EMPLOYER (DFCCIL): DEDICATED FREIGHT CORRIDOR CORPORATION OF INDIA LTD.

AS BUILT DRAWING

TITLE

AS-BUILT PLAN AND PROFILE

FROM IR KM: 341.000 TO 341.500

FROM DFC KM: 1231.877 TO 1232.377

DFCC APPR. NO. -

ENGG. APPR. NO. -

DRG. NO. - 301-2/AL/A/1308



SHEET NO. : 1 OF 1

DATE : 10.10.2024

STATUS

A

TR.

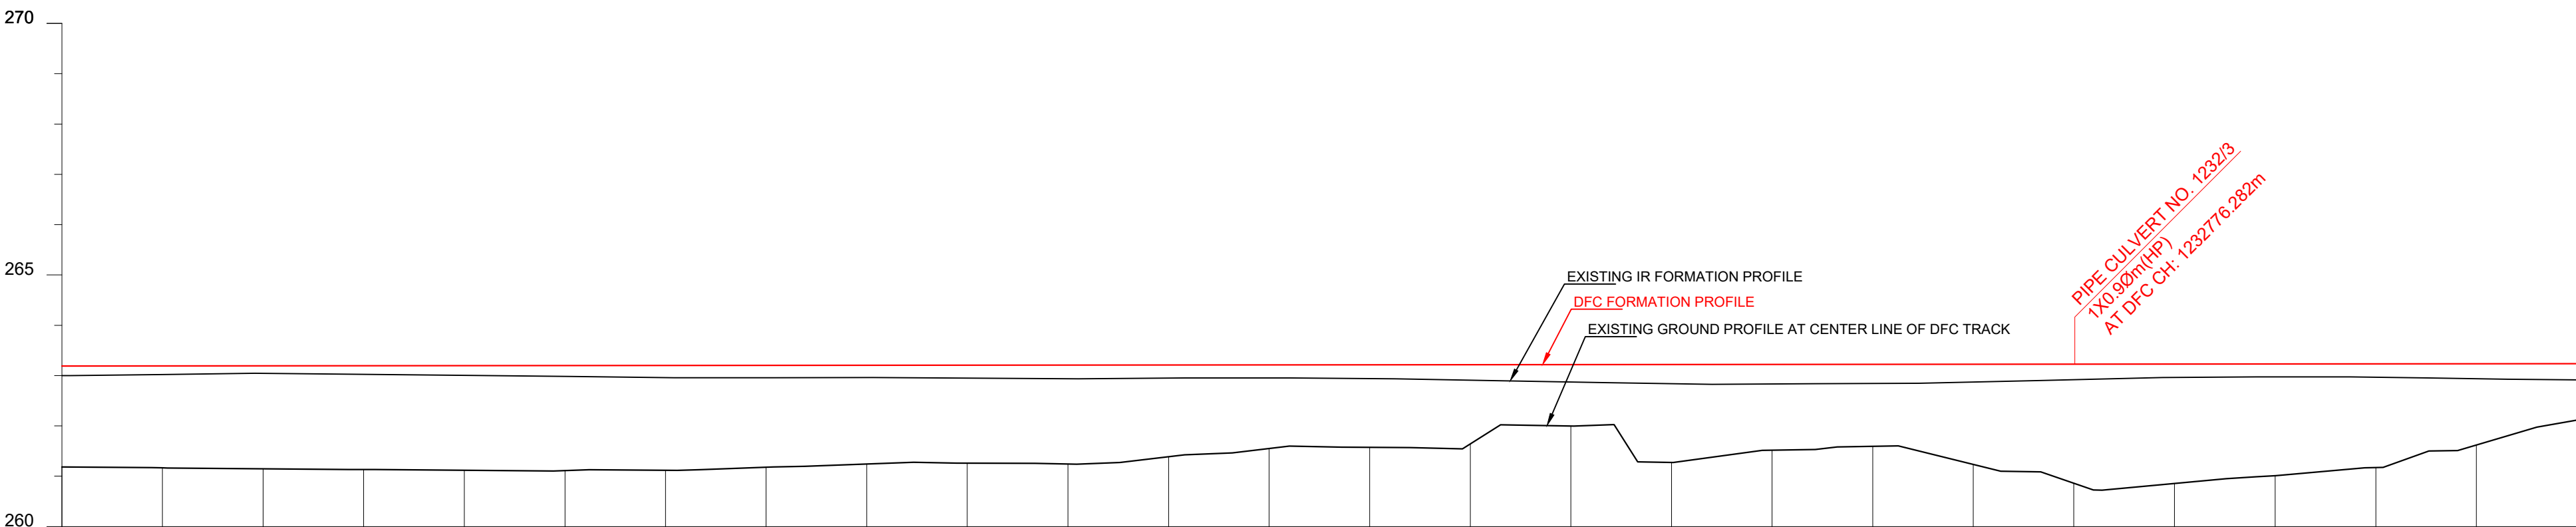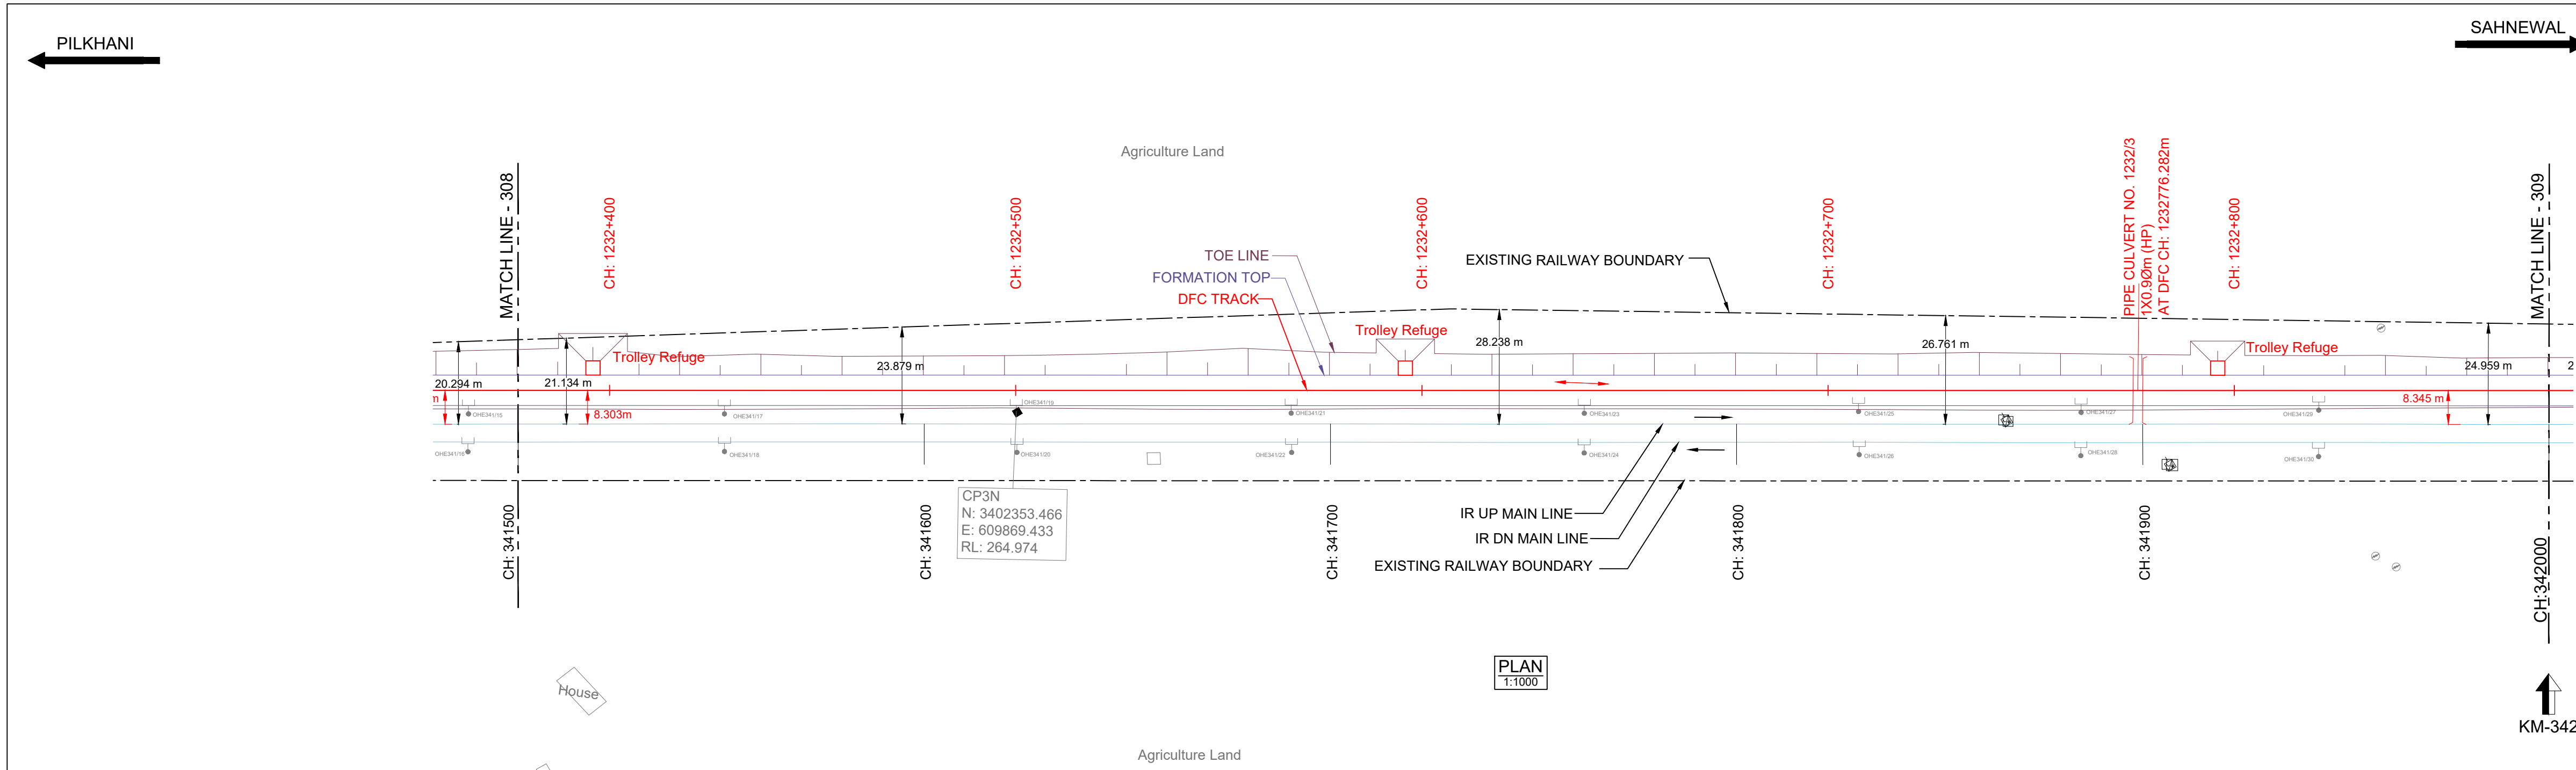

HORIZONTAL ALIGNMENT	L = 2129.106m																			
VERTICAL ALIGNMENT	L=1835.963 m 1 IN 10896.854 R																			
TRACK DISTANCE FROM EXISTING NEAREST IR UP MAIN LINE TO DFC MAIN LINE	8.327	8.294	8.260	8.242	8.223	8.248	8.275	8.268	8.259	8.254	8.251	8.280	8.312	8.301	8.277	8.273	8.277	8.293	8.319	8.318
HEIGHT OF BANKING(+) / DEPTH OF CUTTING(-) (PFL-GL)	+2.006	+2.025	+2.045	+2.061	+2.079	+2.088	+2.081	+2.024	+1.961	+1.947	+1.964	+1.821	+1.660	+1.641	+1.574	+1.221	+1.946	+1.702	+1.628	+1.989
EXG GROUND LEVEL AT CENTER LINE OF DFC TRACK (GL)	261.183	261.166	261.148	261.133	261.117	261.110	261.119	261.178	261.243	261.259	261.243	261.388	261.551	261.572	261.641	261.996	261.272	261.518	261.594	261.235
EXG GROUND LEVEL AT TOE LOCATION OF DFC TRACK	259.926	259.700	260.806	260.492	260.792	260.746	260.687	260.557	260.250	259.835	260.317	260.406	260.435	260.364	260.452	260.435	260.566	260.495	260.311	260.444
DIFFERENCE BETWEEN DFC FORMATION LEVEL AND EXG.FORMATION LEVEL (PFL-EFL)	0.188	0.169	0.150	0.171	0.193	0.215	0.242	0.243	0.241	0.255	0.269	0.260	0.260	0.275	0.345	0.308	0.379	0.388	0.379	0.351
DFC FORMATION LEVEL (PFL)	263.169	263.191	263.193	263.194	263.196	263.198	263.200	263.202	263.204	263.206	263.207	263.209	263.211	263.213	263.217	263.215	263.218	263.220	263.222	263.224
EXG. FORMATION LEVEL OF EXG IR UP MAIN LINE (EFL)	263.001	263.022	263.043	263.023	263.003	262.983	262.958	262.959	262.963	262.951	262.938	262.948	262.951	262.938	262.872	262.907	262.839	262.832	262.843	262.873
DIFFERENCE BETWEEN DFC RAIL LEVEL AND EXG. RAIL LEVEL (PRL - ERL)	0.229	0.210	0.191	0.212	0.235	0.256	0.283	0.285	0.282	0.296	0.311	0.302	0.302	0.316	0.385	0.349	0.421	0.429	0.420	0.392
DFC RAIL LEVEL (PRL)	263.302	263.304	263.306	263.308	263.310	263.312	263.313	263.315	263.317	263.319	263.321	263.323	263.324	263.326	263.330	263.328	263.332	263.334	263.335	263.337
EXG.RAIL LEVEL OF NEAREST IR UP MAIN LINE(ERL)	263.673	263.694	263.715	263.695	263.675	263.655	263.630	263.631	263.635	263.623	263.610	263.621	263.623	263.610	263.544	263.579	263.511	263.504	263.515	263.634
EQUIVALENT CHAINAGE ON DFC TRACK	1232376.8	1232396.8	1232416.8	1232436.8	1232456.8	1232476.9	1232496.8	1232516.8	1232536.8	1232556.8	1232576.8	1232596.8	1232616.9	1232636.8	1232656.8	1232676.8	1232696.8	1232716.9	1232736.9	1232756.8
EXISTING IR CHAINAGE	341500.0	341520.0	341540.0	341560.0	341580.0	341600.0	341620.0	341640.0	341660.0	341680.0	341700.0	341720.0	341740.0	341760.0	341780.0	341800.0	341820.0	341840.0	341860.0	341880.0

L - SECTION

NOTE:-

- DFCC WORKS ARE SHOWN IN RED.
- IR NEW WORKS ARE SHOWN IN VIOLET.
- ALL DIMENSIONS ARE SHOWN IN METRES.
- THIS DRAWING IS PREPARED BASED ON LATEST SURVEY DATA HELD ON APRIL-2022. GTS BENCH MARK OF 261.850M CONSIDERED ON TOP OF CANAL BRIDGE ABUTMENT AT DORAHA VILLAGE ALONG THE NH1.
- DFC NEW CHAINAGE OF 1075.950M IS WITH REFERENCE TO THE IR KM OF 187.500KM END OF KM OF CP-303(SECTION P-3 PILKHANI END) AGAINST THE EXISTING DFC CHAINAGE. 116277.742M ISSUED VIDE LETTER NO. GOMDFCC/UMBSURVEY/2021-301-230116-011173 DT. 17.01.2023.
- BALLAST PROFILE HAS BEEN PROVIDED ACCORDING TO THE CLAUSE 1.11.3 OF STANDARD SCHEDULE OF DIMENSION(EASTERN CORRIDOR) & THE BALLAST CUSHION DIMESION SHOWN IN 35CM ON GE-14 PARA 17. SPECIFICATIONS & RECOMMENDATIONS 2. TWO LAYER SYSTEM FIG.10.

REFERENCE DRAWINGS :-

- FOR KEY PLAN REFER DRAWING NO. 301-2/AL/0001
- FOR LEGEND AND ABBREVIATIONS REFER DRAWING NO. 301-2/AL/1000
- FOR TYPICAL SECTION OF BALLAST PROFILE (FL-RL) REFER DRG. NO. 301-2/TK/TFD-004 (TR.1952)

LEGEND:

IR TRACK
DFCC TRACK
DFCC FUTURE PROPOSALS
STRUCTURE / BUILDING
DFCC TOE LINE
DFCC FORMATION
RETAINING WALL
ROAD
STREAM, DRAIN, NALA, CANAL.
FENCE
POWER LINES
TBM
ELECTRIC POLE/OHE MAST
IR RAILWAY BOUNDARY
DFCC BOUNDARY

SCALE

HOR - 1:1000
VER - 1:100
SHEET SIZE : A1

TYPICAL SECTION

TRACK STRUCTURE		
RAIL SECTION: 60Kg/m (UIC 60Kg/m) DFC LINE: 60Kg/m (UIC 60Kg/m) IR MAIN LINE: 52Kg/m	Difference between FL- RL (Below Rail Seat)	
	IR Line	DFC
RUBBER PAD	172mm	172mm
SLEEPER DEPTH	6mm	10mm
SLEEPER DEPTH	210mm	210mm
BALLAST CUSHION	300mm	350mm
Total Depth (FL TO RL)	688mm	742mm

OWNER

DEDICATED FREIGHT CORRIDOR CORPORATION OF INDIA LTD.
(A GOVERNMENT OF INDIA ENTERPRISE)
PROJECT OFFICE(AMBALA UNIT): OLD RAILWAY COLONY (NEAR ANAND MARKET),AMBALA CANTT-133001.
CORPORATE IDENTITY NO : U60232DL2006GGI155068

ENGINEER:

DB Engineering & Consulting GmbH
Deutsche Bahn Engineering & Consulting GmbH

CONTRACTOR:

GIL - TPL JV
GAR TATA

SUBMITTED BY	GIL - TPL JV		
	DATED	NAME	SIGNATURE
PREPARED BY			
CHECKED BY	10.10.2024	VIJAY PRATAP	
APPROVED BY	10.10.2024	PARASURAM KOTYADA	

APPROVED BY

DEUTSCHE BAHN ENGINEERING & CONSULTING GMBH

	DATED	NAME	SIGNATURE
Sr. DE./CHIEF ENGINEER		SURESH K.YALANGI	
CHIEF TRACK ENGINEER		RAJ PAL SINGH	
T.L.		H.D. VIDJAK	

STAMP

A AS-BUILT DRAWING
TR. Ref.:.....
ENGINEER Sign.:.....

EMPLOYER (DFCCIL):

DEDICATED FREIGHT CORRIDOR CORPORATION OF INDIA LTD.

AS BUILT DRAWING

TITLE


AS-BUILT PLAN AND PROFILE

FROM IR KM: 341.500 TO 342.000
FROM DFC KM: 1232.377 to 1232.877

DFCC APPR. NO. -
ENGG. APPR. NO. -
DRG. NO. -301-2/AL/A/1309
SHEET NO. : 1 OF 1
DATE : 10.10.2024

STATUS
A

TR.

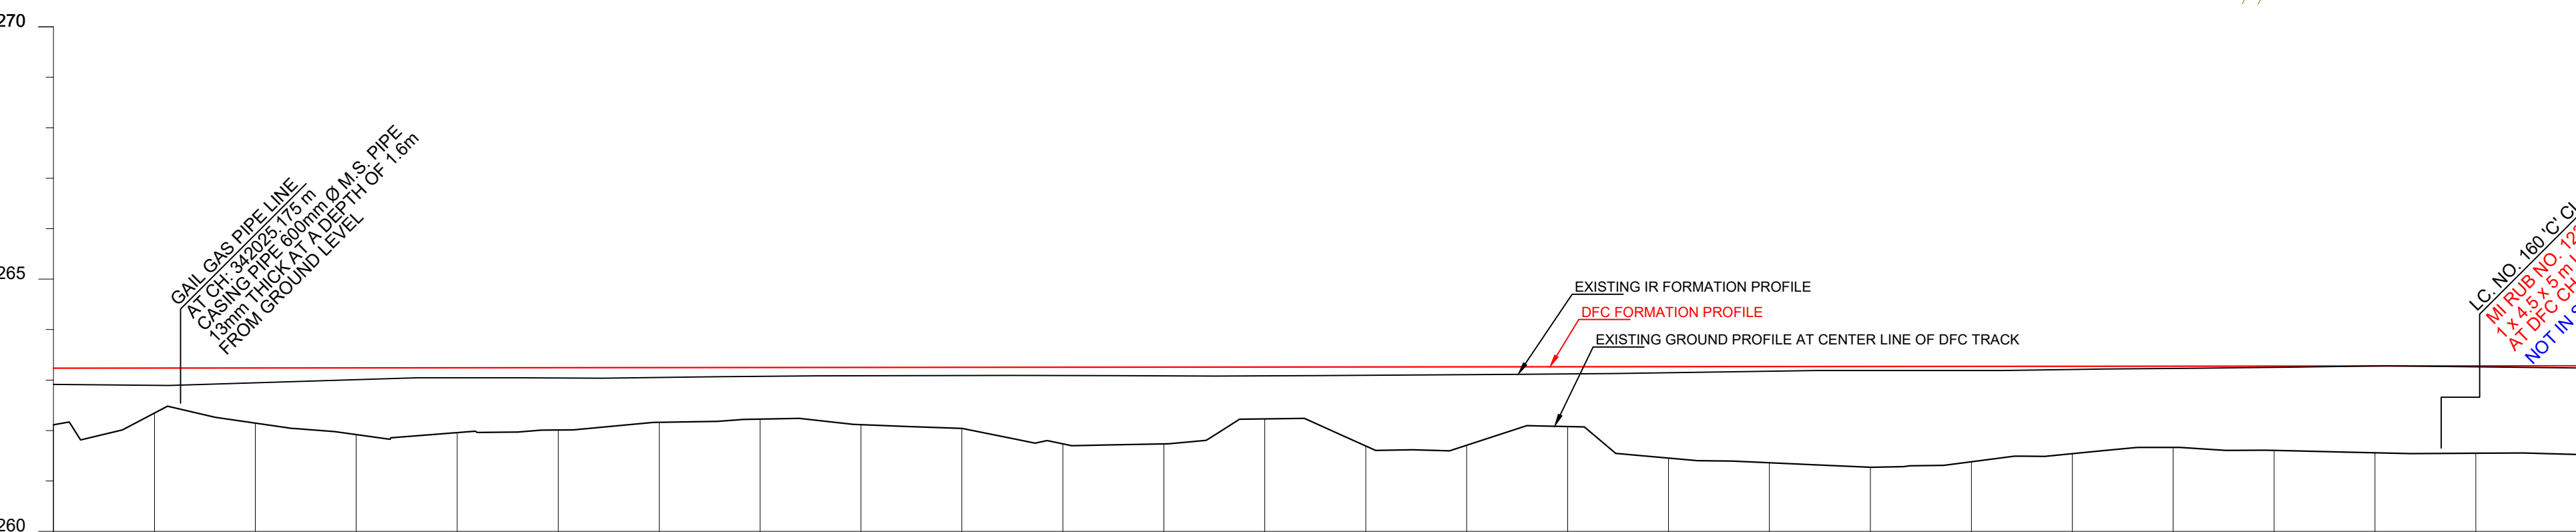[illegible]

L - SECTION


- | | |
|---|---------------------------|
| NOTE:- | DRG NO. - 301-2/AL/A/1310 |
| <p>1. DFFC WORKS ARE SHOWN IN RED.</p> <p>2. IR NEW WORKS ARE SHOWN IN VIOLET.</p> <p>3. ALL DIMENSIONS ARE SHOWN IN METRES.</p> <p>4. THIS DRAWING IS PREPARED BASED ON LATEST SURVEY DATA HELD ON APRIL 2022. GTS BENCH MARK OF 261.850M CONSIDERED ON TOP OF CANAL BRIDGE ABUTMENT AT DORAKA VILLAGE ALONG THE NH1.</p> <p>5. DFFC NEW CHANGING OF 1075.950M IS WITH REFERENCE TO THE IR KM OF 187.500M END OF KM OF CP-30/SECTION 3 (P.3) KHAM IND AGAINST THE EXISTING DFC CHANGING. 162727.742M ISSUED VIDE LETTER NO. GM/CMDCCO/UMB/SURVEY/2021-301-2031-06101173 DT. 17.01.2023</p> <p>6. BALLAST PROFILE HAS BEEN PROVIDED ACCORDING TO THE CLAUSE 111.3 OF STANDARD SCHEDULE OF SPECIFICATIONS FOR EASTERN CORRIDOR & THE BALLAST CUSHION DIMENSION SHOWN IN 35CM ON GE-14 PAR. 17. SPECIFICATIONS & RECOMMENDATIONS 2. TWO LAYER SYSTEM FGD.</p> | |

REFERENCE DRAWINGS :-


1. FOR KEY PLAN REFER DRAWING NO. 301-2/AL/0001
2. FOR LEGEND AND ABBREVIATIONS REFER DRAWING NO. 301-2/AL1000
3. FOR TYPICAL SECTION OF BALLAST PROFILE (FL-RL) REFFER DRG. NO. 301-2/TK/TFD/-004 (TR.1952)

0	10.10.2024	SUBMISSION OF AS-BUILT DRAWING	FOR APPROVAL
REV.	DATE	REVISION DETAILS	PURPOSE OF ISSUE

LEGEND:

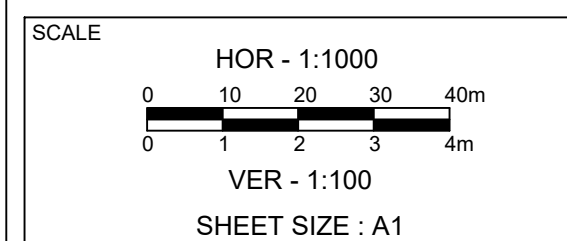

-
- IR TRACK
- DFCC TRACK
- DFCC FUTURE PROPOSALS
- STRUCTURE / BUILDING
- DFCC TOE LINE
- DFCC FORMATION
- RETAINING WALL
- ROAD
- STREAM, DRAIN, NALA, CANAL,
- FENCE
- POWER LINES
- TBM
- ELECTRIC POLE/OHE MAST
- IR RAILWAY BOUNDARY
- DFCC BOUNDARY

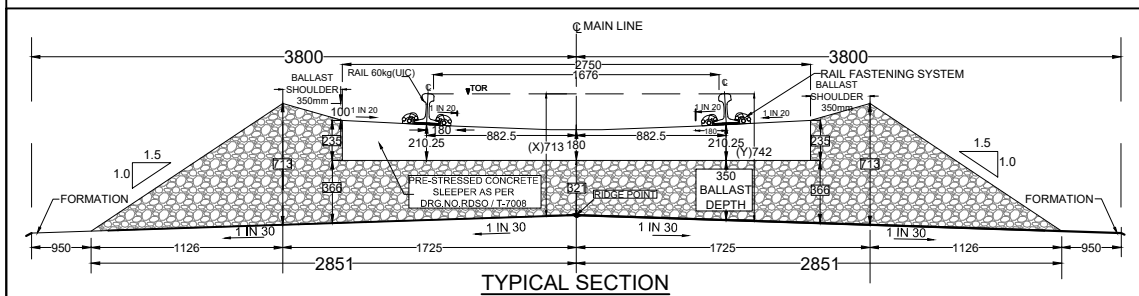

TRACK STRUCTURE		
RAIL SECTION: 60Kg/m (UIC 60Kg/m) DFC LINE: 60Kg/m (UIC 60Kg/m) IR MAIN LINE: 52Kg/m	Difference between FL- RL (Below Rail Seat)	
	IR Line	DFC
	172mm	172mm
RUBBER PAD	6mm	10mm
SLEEPER DEPTH	210mm	210mm
BALLAST CUSHION	300mm	350mm
Total Depth (FL TO RL)	688mm	742mm

OWNER



डेडीफ्रेट क्लोर क्लोर क्लोर

DEDICATED FREIGHT CORRIDOR CORPORATION OF INDIA LTD.
(A GOVERNMENT OF INDIA ENTERPRISE)
PROJECT OFFICE (AMBALA UNIT): OLD RAILWAY COLONY (NEAR
ANAND MARKET), AMBALA CANT-133001.
CORPORATE IDENTITY NO.: U60232DL2006GOI155068

ENGINEER:



DB Engineering & Consulting GmbH
Deutsche Bahn Engineering & Consulting GmbH

CONTRACTOR:	CH. TEL. IV.
-------------	--------------

CONTRACTOR:

GII - TPI - IV



SUBMITTED BY	GIL - TPL JV
--------------	--------------

	DATED	NAME	SIGNATURE
PREPARED BY			
CHECKED BY	10.10.2024	VIJAY PRATAP	
APPROVED BY	10.10.2024	PARASURAM KOTYADA	

APPROVED BY	DEUTSCHE BAHN ENGINEERING & CONSULTING GMBH
-------------	---

	DATED	NAME	SIGNATURE

Sr. DE./CHIEF ENGINEER		SURESH K.YALANGI	
CHIEF ENGINEER		RAJESH KUMAR	

CHIEF TRACK ENGINEER		RAJ PAL SINGH	
T.I.		H.D. VIDJAK	

1. Name			

[illegible]

STAMP	AS-BUILT DRAWING TR Ref
-------	--

STAMP TR. Ref.:
ENGINEER Sign.:

EMBL-OUT (DECOG)	

EMPLOYER (DFCCIL):	DEDICATED FREIGHT CORRIDOR CORPORATION OF INDIA LTD.		

--	--	--	--

--	--	--	--

--	--	--	--

--	--	--	--

AS BUILT DRAWING



AS BUILT DRAWING

TITLE	DFCC APPR. NO. -
AS-BUILT PLAN AND PROFILE	ENGG. APPR. NO. -

FROM IR KM: 342.000 TO 342.500


FROM DFC KM: 1232.877 to 1233.377	SHEET NO. : 1 OF 1	DATE : 10.10.2024	A

 TD |

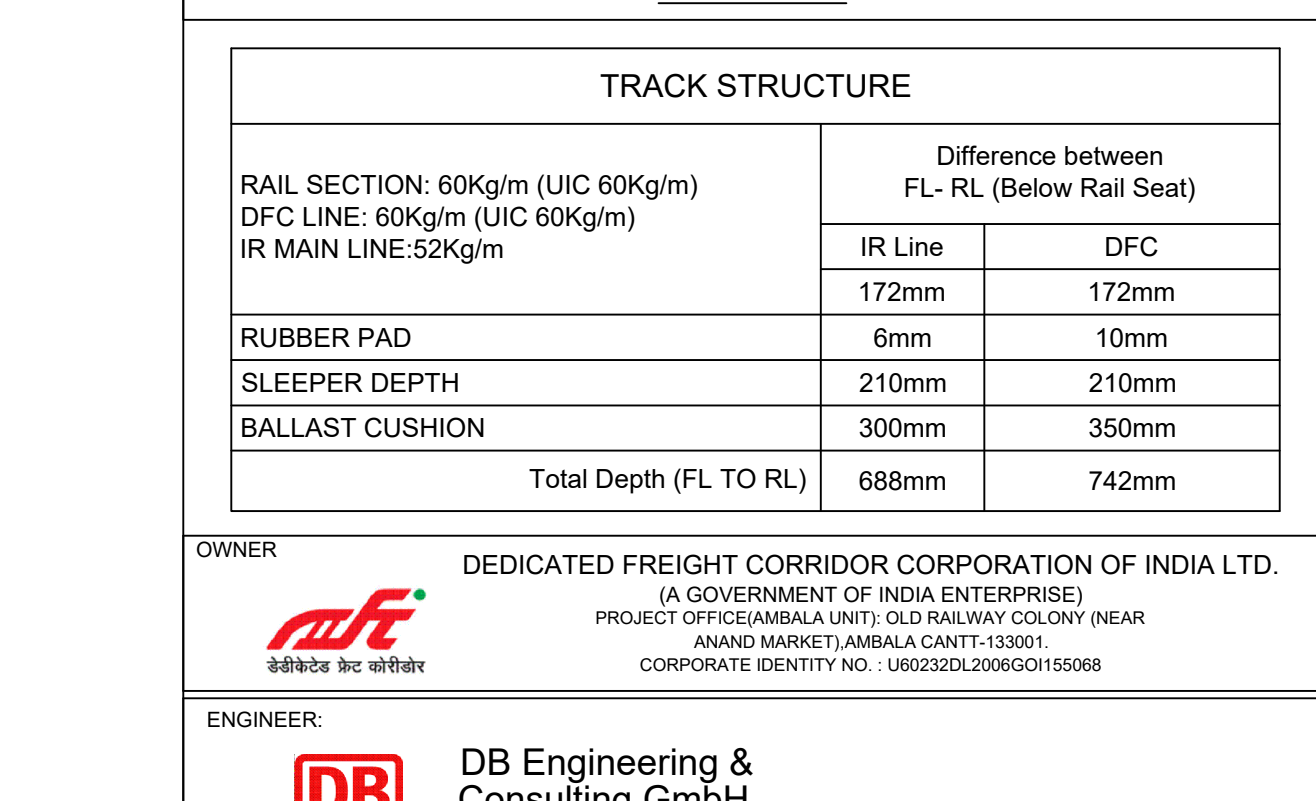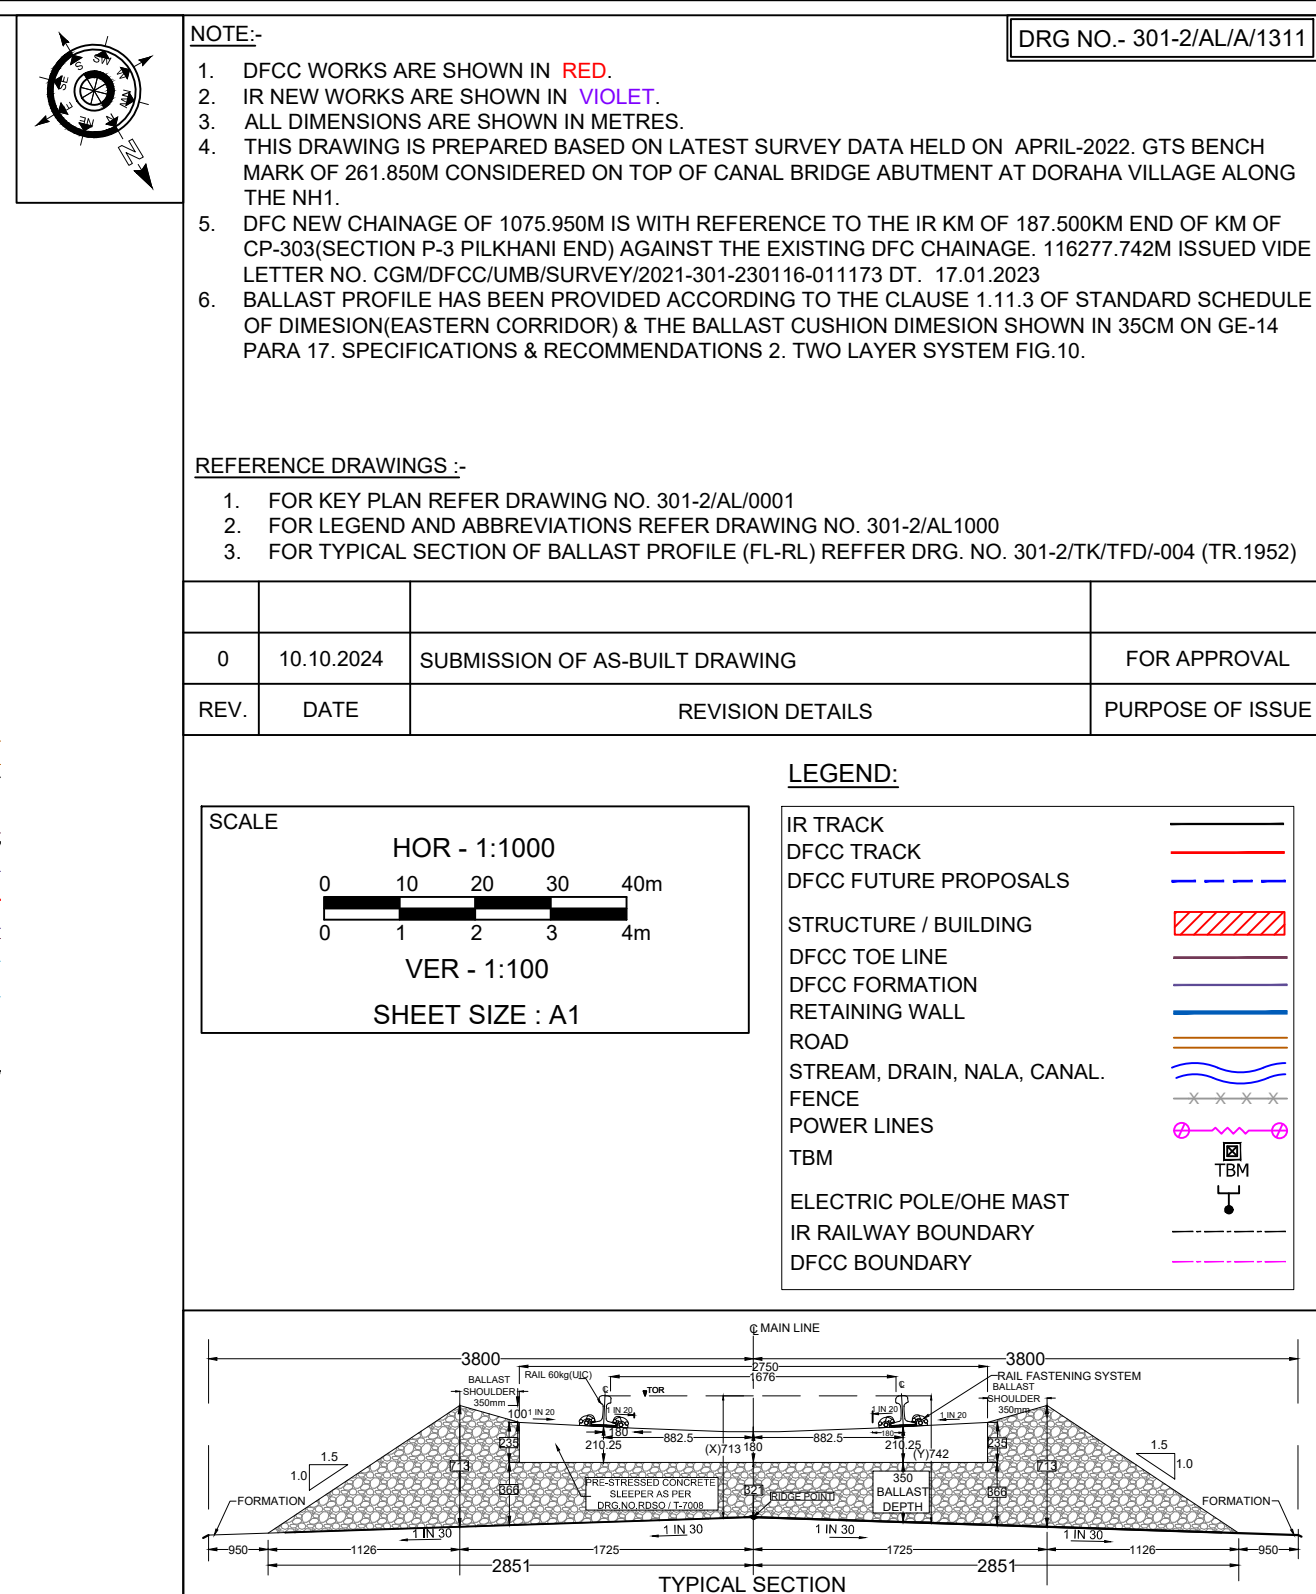

 			
CONTRACTOR: GIL - TPL JV  			
SUBMITTED BY		GIL - TPL JV	
	DATED	NAME	SIGNATURE
PREPARED BY			
CHECKED BY	10.10.2024	VIJAY PRATAP	
APPROVED BY	10.10.2024	PARASURAM KOTYADA	
APPROVED BY		DEUTSCHE BAHN ENGINEERING & CONSULTING GMBH	
	DATED	NAME	SIGNATURE
Sr. DE./CHIEF ENGINEER		SURESH K.YALANGI	
CHIEF TRACK ENGINEER		RAJ PAL SINGH	
T.L.		H.D. VIDJAK	
STAMP	A AS-BUILT DRAWING TR. Ref.:..... ENGINEER Sign.:		
EMPLOYER (DFCCIL):	DEDICATED FREIGHT CORRIDOR CORPORATION OF INDIA LTD.		
AS BUILT DRAWING			
TITLE	DFCC APPR. NO. - ENGG. APPR. NO. -		
AS-BUILT PLAN AND PROFILE			

FROM DFC RM. 1255.577 to 1255.577	DATE : 10.10.2024	A
-----------------------------------	-------------------	---

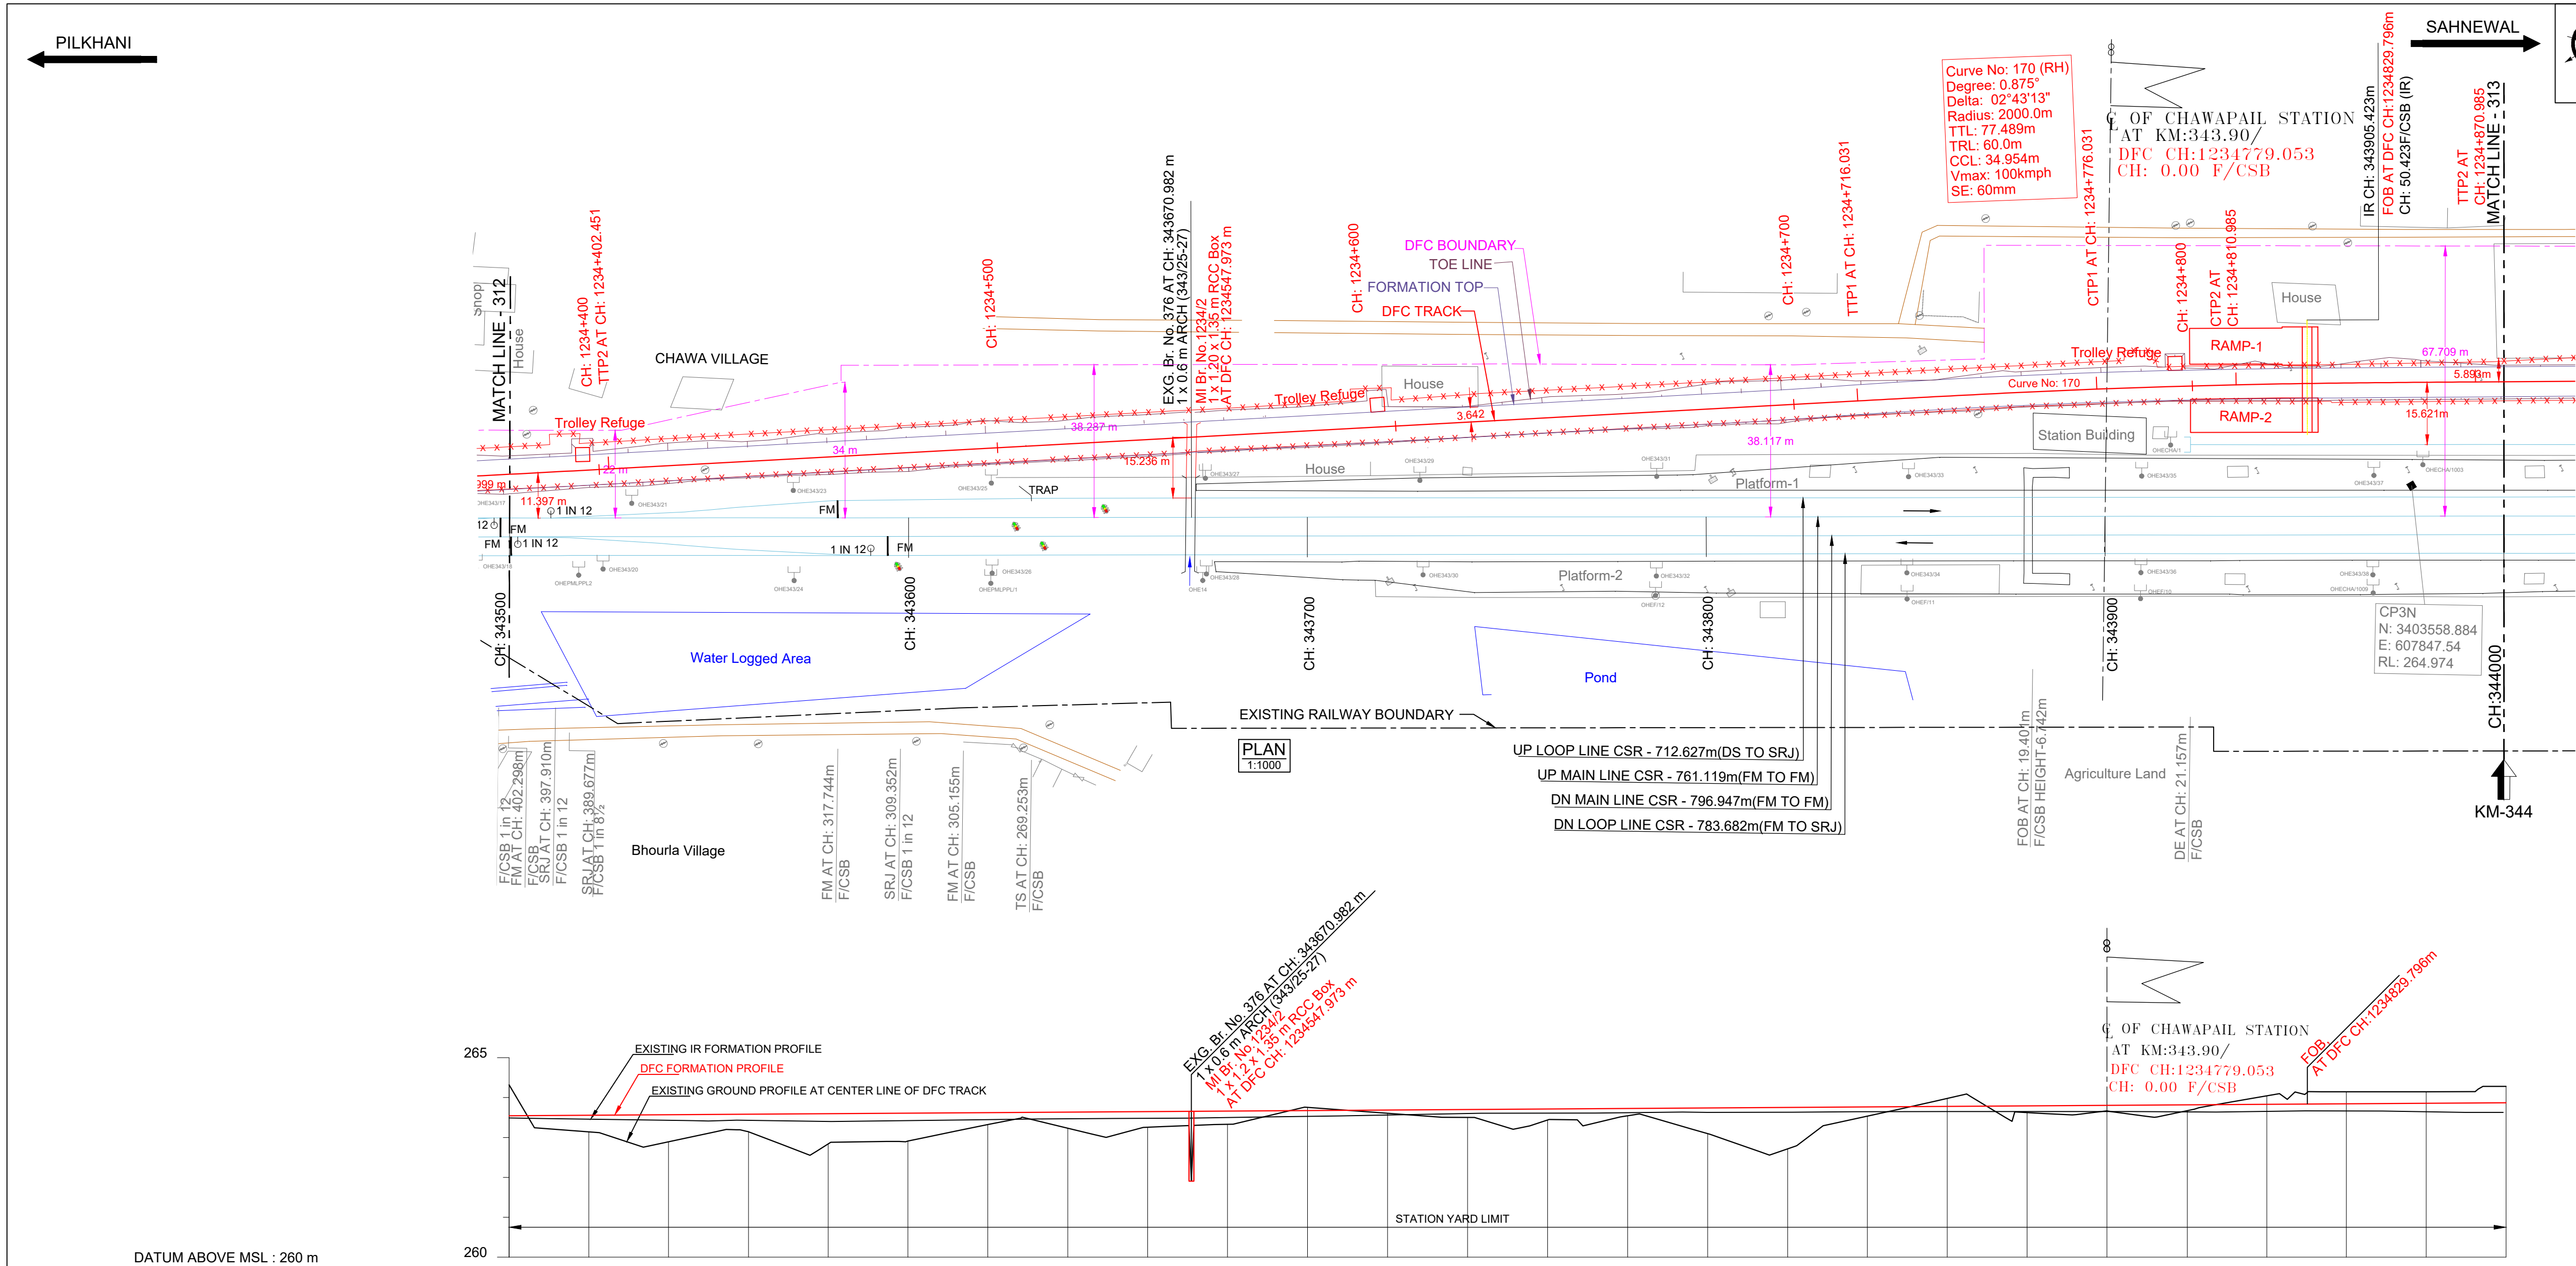

DATUM ABOVE MSL : 260 m

HORIZONTAL ALIGNMENT	TL=70mL=313.580mTL=60mR=2000mTL=60mL=367.588m																			
VERTICAL ALIGNMENT	L=1481.016 m 1 IN 1523.161 R																			
TRACK DISTANCE FROM EXISTING NEAREST IR UP MAIN LINE TO DFC MAIN LINE	-10.961	-12.043	-13.093	-14.167	-15.273	-16.329	-17.382	-18.444	-19.518	-20.579	-21.627	-22.686	-23.752	-24.824	-25.904	-26.993	-28.078	-29.140	-30.175	-31.127
HEIGHT OF BANKING(+) / DEPTH OF CUTTING(-) (PFL-GL)	-0.777	+0.414	+0.678	+0.441	+0.755	+0.699	+0.298	+0.400	+0.392	+0.330	-0.080	+0.080	+0.199	+0.273	+0.184	+0.644	+1.037	+0.231	-0.200	+0.169
EXG GROUND LEVEL AT CENTER LINE OF DFC TRACK (GL)	264.320	263.142	262.891	263.141	262.840	262.909	263.323	263.234	263.256	263.331	263.754	263.607	263.501	263.440	263.543	263.096	262.716	263.535	263.979	263.623
EXG GROUND LEVEL AT TOE LOCATION OF DFC TRACK	263.680	263.020	262.067	262.005	261.949	262.179	262.655	263.154	263.147	263.228	263.374	263.451	263.601	262.852	263.322	262.867	262.414	263.249	263.716	263.242
DIFFERENCE BETWEEN DFC FORMATION LEVEL AND EXG.FORMATION LEVEL (PFL-EFL)	0.052	0.098	0.138	0.152	0.193	0.184	0.173	0.165	0.166	0.160	0.144	0.123	0.099	0.104	0.107	0.112	0.120	0.119	0.127	0.141
DFC FORMATION LEVEL (PFL)	263.543	263.556	263.569	263.592	263.595	263.608	263.621	263.634	263.648	263.661	263.674	263.687	263.700	263.713	263.727	263.740	263.753	263.766	263.779	263.792
EXG. FORMATION LEVEL OF EXG IR UP MAIN LINE (EFL)	263.491	263.458	263.431	263.430	263.402	263.424	263.448	263.469	263.482	263.501	263.530	263.564	263.601	263.609	263.620	263.628	263.633	263.647	263.652	263.651
DIFFERENCE BETWEEN DFC RAIL LEVEL AND EXG. RAIL LEVEL (PRL - ERL)	0.093	0.138	0.179	0.193	0.234	0.225	0.214	0.207	0.207	0.201	0.185	0.164	0.140	0.145	0.148	0.152	0.160	0.160	0.168	0.182
DFC RAIL LEVEL (PRL)	264.255	264.268	264.282	264.295	264.308	264.321	264.334	264.347	264.360	264.374	264.387	264.400	264.413	264.426	264.439	264.453	264.466	264.479	264.492	264.505
EXG.RAIL LEVEL OF NEAREST IR UP MAIN LINE(ERL)	264.163	264.130	264.103	264.102	264.074	264.096	264.120	264.141	264.154	264.173	264.202	264.236	264.273	264.281	264.282	264.300	264.305	264.319	264.324	264.323
EQUIVALENT CHAINAGE ON DFC TRACK	-1234376.9	-1234386.9	-1234416.9	-1234437.0	-1234457.0	-1234477.0	-1234497.0	-1234517.1	-1234537.1	-1234557.1	-1234577.1	-1234597.2	-1234617.2	-1234637.3	-1234657.3	-1234677.3	-1234697.4	-1234717.3	-1234737.4	-1234757.4
EXISTING IR CHAINAGE	343500.0	343520.0	343540.0	343560.0	343580.0	343600.0	343620.0	343640.0	343660.0	343680.0	343700.0	343720.0	343740.0	343760.0	343780.0	343800.0	343820.0	343840.0	343860.0	343880.0

L - SECTION

- NOTE:-
- DFCC WORKS ARE SHOWN IN RED.
 - IR NEW WORKS ARE SHOWN IN VIOLET.
 - ALL DIMENSIONS ARE SHOWN IN METRES.
 - THIS DRAWING IS PREPARED BASED ON LATEST SURVEY DATA HELD ON APRIL-2022. GTS BENCH MARK OF 261.85M CONSIDERED ON TOP OF CANAL BRIDGE ABUTMENT AT DORANA VILLAGE ALONG THE NH1.
 - DFC NEW CHAINAGE OF 1075.950M IS WITH REFERENCE TO THE IR KM OF 187.500KM END OF KM OF CP-303(SECTION P-3 PILKHANI END) AGAINST THE EXISTING DFC CHAINAGE. 116277.742M ISSUED VIDE LETTER NO. GCM/DFCC/COMB/SURVEY/2021-301-2301/16-01/173 DT. 17.01.2023.
 - BALLAST PROFILE HAS BEEN PROVIDED ACCORDING TO THE CLAUSE 1.11.3 OF STANDARD SCHEDULE OF DIMENSION(EASTERN CORRIDOR) & THE BALLAST CUSHION DIMENSION SHOWN IN 35CM ON GE-14 PARA 17. SPECIFICATIONS & RECOMMENDATIONS 2. TWO LAYER SYSTEM FIG.10.

- REFERENCE DRAWINGS :-
- FOR KEY PLAN REFER DRAWING NO. 301-2/AL/0001
 - FOR LEGEND AND ABBREVIATIONS REFER DRAWING NO. 301-2/AL/1000
 - FOR TYPICAL SECTION OF BALLAST PROFILE (FL-RL) REFFER DRG. NO. 301-2/TK/TFD-004 (TR.1952)

REV.	DATE	REVISION DETAILS	PURPOSE OF ISSUE
0	10.10.2024	SUBMISSION OF AS-BUILT DRAWING	FOR APPROVAL

LEGEND:


SCALE

HOR - 1:1000

VER - 1:100

SHEET SIZE : A1

IR TRACK
DFCC TRACK
DFCC FUTURE PROPOSALS
STRUCTURE / BUILDING
DFCC TOE LINE
DFCC FORMATION
RETAINING WALL
ROAD
STREAM, DRAIN, NALA, CANAL.
FENCE
POWER LINES
TBM
ELECTRIC POLE/OHE MAST
IR RAILWAY BOUNDARY
DFCC BOUNDARY

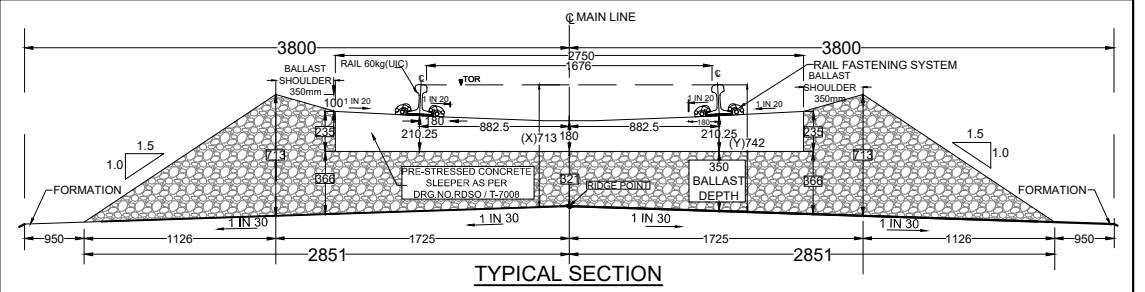

TRACK STRUCTURE		
RAIL SECTION: 60Kg/m (UIC 60Kg/m) DFC LINE: 60Kg/m (UIC 60Kg/m) IR MAIN LINE: 52Kg/m	Difference between FL- RL (Below Rail Seat)	
	IR Line	DFC
RUBBER PAD	172mm	172mm
SLEEPER DEPTH	6mm	10mm
BALLAST CUSHION	210mm	210mm
	300mm	350mm
Total Depth (FL TO RL)	688mm	742mm

OWNER: DEDICATED FREIGHT CORRIDOR CORPORATION OF INDIA LTD. (A GOVERNMENT OF INDIA ENTERPRISE)
PROJECT OFFICE(AMBALA UNIT): OLD RAILWAY COLONY (NEAR ANAND MARKET),AMBALA CANTT-133001.
CORPORATE IDENTITY NO : U60232DL20060G01150068

ENGINEER: DB Engineering & Consulting GmbH
Deutsche Bahn Engineering & Consulting GmbH

CONTRACTOR: GIL - TPL JV
GAR TATA

SUBMITTED BY	GIL - TPL JV		
	DATED	NAME	SIGNATURE
PREPARED BY			
CHECKED BY	10.10.2024	VIJAY PRATAP	
APPROVED BY	10.10.2024	PARASURAM KOTYADA	

APPROVED BY	DEUTSCHE BAHN ENGINEERING & CONSULTING GMBH		
	DATED	NAME	SIGNATURE
Sr. DE./CHIEF ENGINEER		SURESH K.YALANGI	
CHIEF TRACK ENGINEER		RAJ PAL SINGH	
T.L.		H.D. VIDJAK	

STAMP



A AS-BUILT DRAWING
TR. Ref:.....
ENGINEER Sign.:

EMPLOYER (DFCCIL): DEDICATED FREIGHT CORRIDOR CORPORATION OF INDIA LTD.

--	--	--

AS BUILT DRAWING		
TITLE	AS-BUILT PLAN AND PROFILE	DFCC APPR. NO. -
	FROM IR KM: 343.500 TO 344.000	ENGG. APPR. NO. -
	FROM DFC KM: 1234.377 TO 1234.877	DRG. NO. -301-2/AL/A/1313
		SHEET NO. : 1 OF 1
		DATE : 10.10.2024
		STATUS
		A

TR.

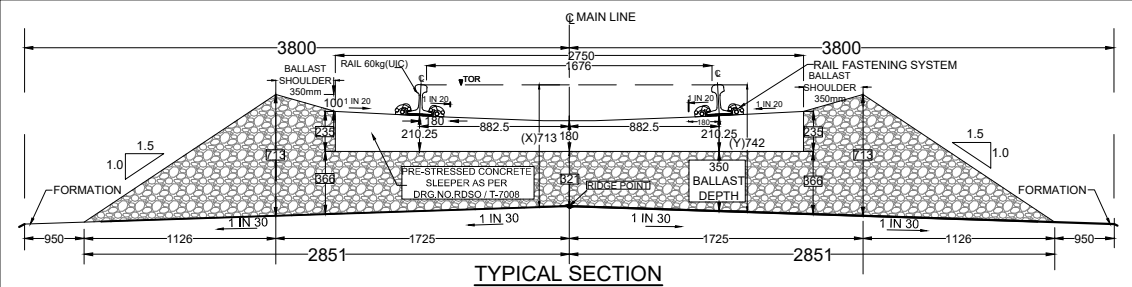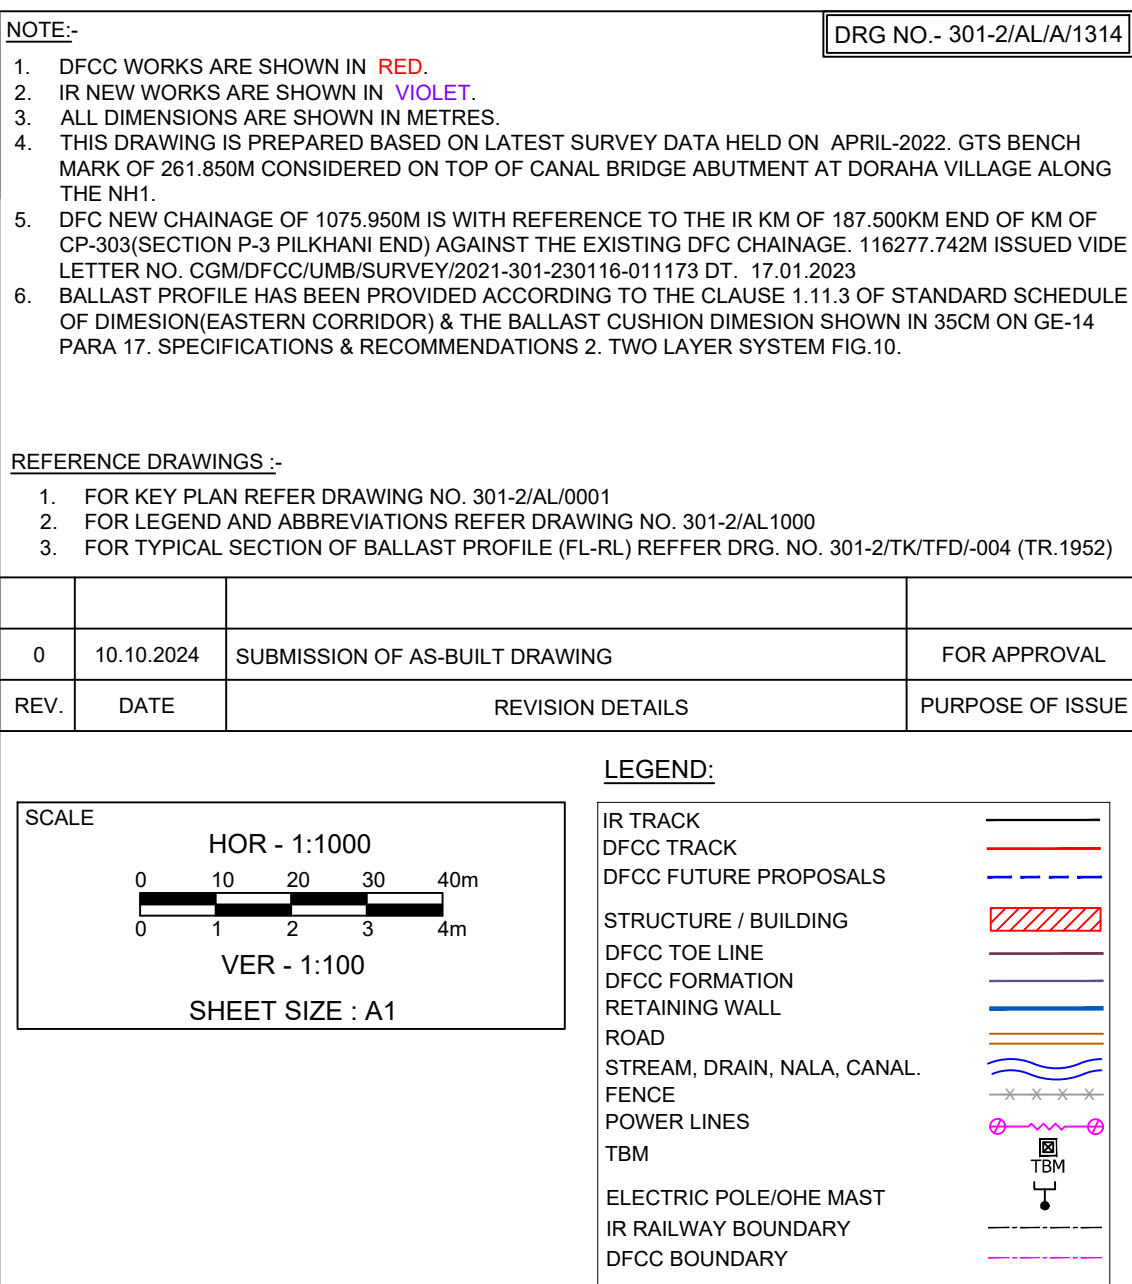

TRACK STRUCTURE		
RAIL SECTION: 60Kg/m (UIC 60Kg/m) DFC LINE: 60kg/m (UIC 60Kg/m) IR MAIN LINE: 52Kg/m	Difference between FL- RL (Below Rail Seat)	
	IR Line	DFC
	172mm	172mm
RUBBER PAD	6mm	10mm
SLEEPER DEPTH	210mm	210mm
BALLAST CUSHION	300mm	350mm
Total Depth (FL TO RL)	688mm	742mm

OWNER



डेडीफ्रेट क्लोर कॉरपोरेशन ऑफ इंडिया लिमिटेड

DEDICATED FREIGHT CORRIDOR CORPORATION OF INDIA LTD.
(A GOVERNMENT OF INDIA ENTERPRISE)
PROJECT OFFICE (AMBALA UNIT): OLD RAILWAY COLONY (NEAR
ANAND MARKET), AMBALA CANTT - 133001.
CORPORATE IDENTITY NO. : U60232DL2006GOI155068

ENGINEER:

 DB Engineering &
Consulting GmbH
Deutsche Bahn Engineering & Consulting GmbH

CONTRACTOR: GIL - TPL JV

SUBMITTED BY	GIL - TPL JV		
	DATED	NAME	SIGNATURE
PREPARED BY			
CHECKED BY	10.10.2024	VJAY PRATAP	
APPROVED BY	10.10.2024	PARASURAM KOTYADA	

APPROVED BY	DEUTSCHE BAHN ENGINEERING & CONSULTING GMBH		
	DATED	NAME	SIGNATURE
Sr. DE./CHIEF ENGINEER		SURESH K.YALANGI	
CHIEF TRACK ENGINEER		RAJ PAL SINGH	
T.L.		H.D. VIDJAK	

AS BUILT DRAWING

STAMP

A

AS-BUILT DRAWING
TR. Ref.....
ENGINEER Sign.:



EMPLOYER (DFCCIL): DEDICATED FREIGHT CORRIDOR CORPORATION OF INDIA LTD.

--	--	--	--

AS BUILT DRAWING

TITLE AS-BUILT PLAN AND PROFILE FROM IR KM: 344.000 TO 344.500 FROM DFC KM: 1234.877 to 1235.378	DFCC APPR. NO. -	STATUS A
	ENGG. APPR. NO. -	
	DRG. NO. -301.2/AL/A/1314	
	SHEET NO. 1 OF 1	
DATE : 10.10.2024		

TR

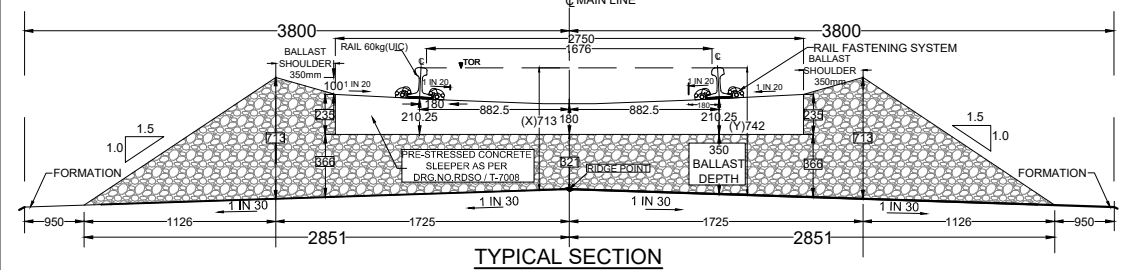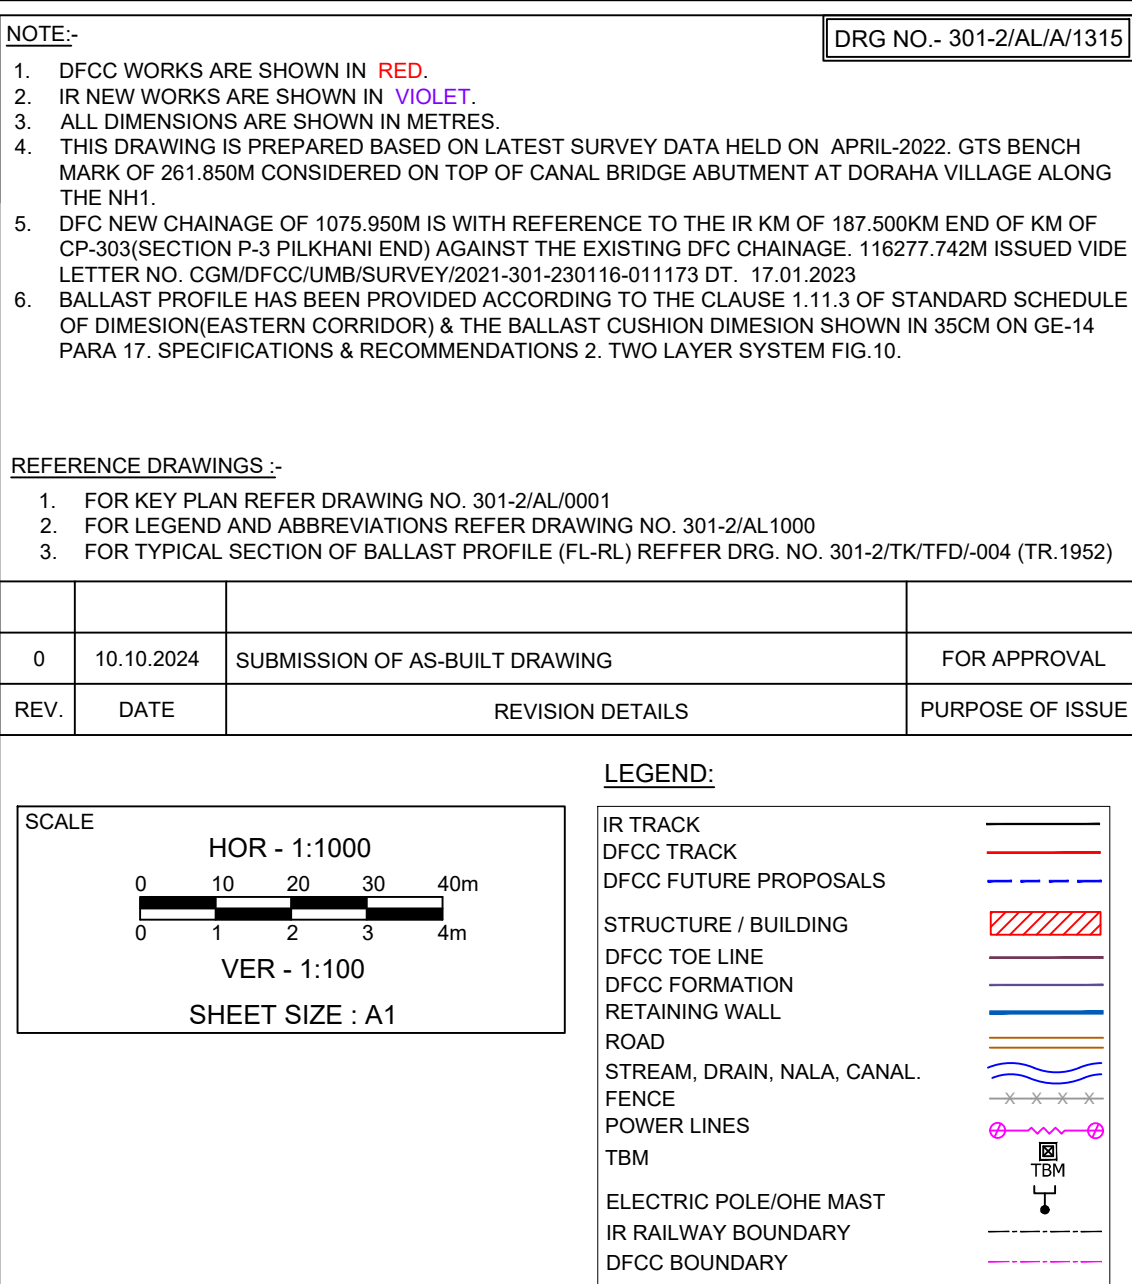

TRACK STRUCTURE		
RAIL SECTION: 60Kg/m (UIC 60Kg/m) DFC LINE: 60Kg/m (UIC 60Kg/m) IR MAIN LINE: 52Kg/m	Difference between FL- RL (Below Rail Seat)	
	IR Line	DFC
	172mm	172mm
RUBBER PAD	6mm	10mm
SLEEPER DEPTH	210mm	210mm
BALLAST CUSHION	300mm	350mm
Total Depth (FL TO RL)	688mm	742mm

OWNER



DEDICATED FREIGHT CORRIDOR CORPORATION OF INDIA LTD.
(A GOVERNMENT OF INDIA ENTERPRISE)
PROJECT OFFICE (AMBALA UNIT): OLD RAILWAY COLONY (NEAR
ANAND MARKET), AMBALA CANTT-133001.
CORPORATE IDENTITY NO. : U60232DL2006GOI155068

ENGINEER:

 DB Engineering & Consulting GmbH
Deutsche Bahn Engineering & Consulting GmbH

CONTRACTOR: GIL - TPL JV


 

SUBMITTED BY	GIL - TPL JV		
	DATED	NAME	SIGNATURE
PREPARED BY			
CHECKED BY	10.10.2024	VJAY PRATAP	
APPROVED BY	10.10.2024	PARASURAM KOTYADA	

APPROVED BY	DEUTSCHE BAHN ENGINEERING & CONSULTING GMBH		
	DATED	NAME	SIGNATURE
Sr. DE./CHIEF ENGINEER		SURESH K.YALANGI	
CHIEF TRACK ENGINEER		RAJ PAL SINGH	
T.L.		H.D. VIDJAK	



STAMP	A AS-BUILT DRAWING TR. Ref..... ENGINEER Sign.:		
EMPLOYER (DFCCIL):	DEDICATED FREIGHT CORRIDOR CORPORATION OF INDIA LTD.		

AS BUILT DRAWING	
TITLE AS-BUILT PLAN AND PROFILE FROM IR KM: 344.500 TO 345.000 FROM DFC KM: 1235.378 TO 1235.878	DFCC APPR. NO. -
	ENGG. APPR. NO. -
	DRG. NO. -301-2/AL/A/1315
	SHEET NO. : 1 OF 1
DATE : 10.10.2024	STATUS A

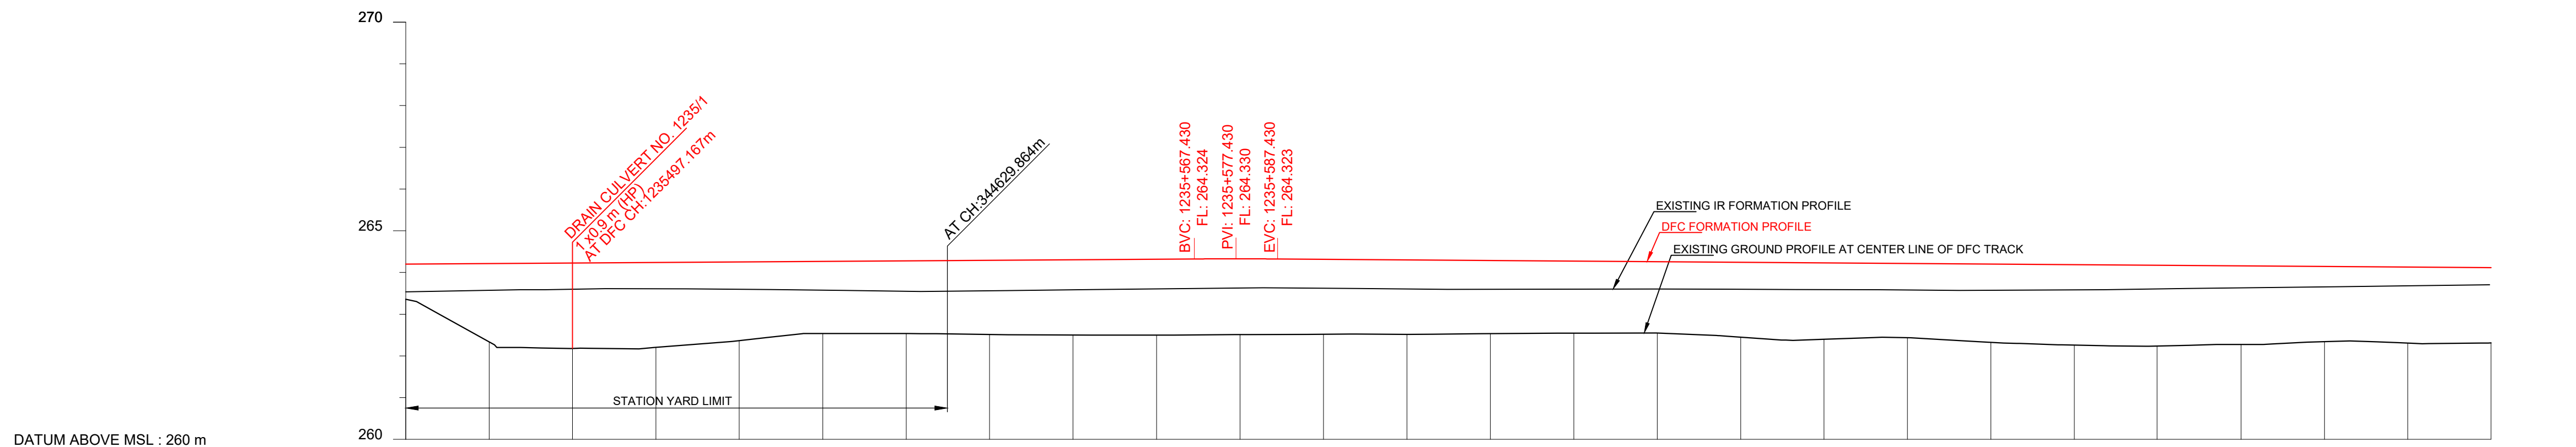

HORIZONTAL ALIGNMENT										
VERTICAL ALIGNMENT										
TRACK DISTANCE FROM EXISTING NEAREST IR UP MAIN LINE TO DFC MAIN LINE	34.045									
HEIGHT OF BANKING(+) / DEPTH OF CUTTING(-) (PFL-GL)	+0.842									
EXG GROUND LEVEL AT CENTER LINE OF DFC TRACK (GL)	263.358									
EXG GROUND LEVEL AT TOE LOCATION OF DFC TRACK	262.885									
DIFFERENCE BETWEEN DFC FORMATION LEVEL AND EXG.FORMATION LEVEL.(PFL-EFL)	0.664									
DFC FORMATION LEVEL (PFL)	264.200									
EXG. FORMATION LEVEL OF EXG IR UP MAIN LINE (EFL)	263.536									
DIFFERENCE BETWEEN DFC RAIL LEVEL AND EXG. RAIL LEVEL (PRL - ERL)	-0.704									
DFC RAIL LEVEL (PRL)	264.912									
EXG.RAIL LEVEL OF NEAREST IR UP MAIN LINE(ERL)	264.208									
EQUIVALENT CHAINEGE ON DFC TRACK	-1235377.6									
EXISTING IR CHAINEGE	-1235500.0									


L - SECTION

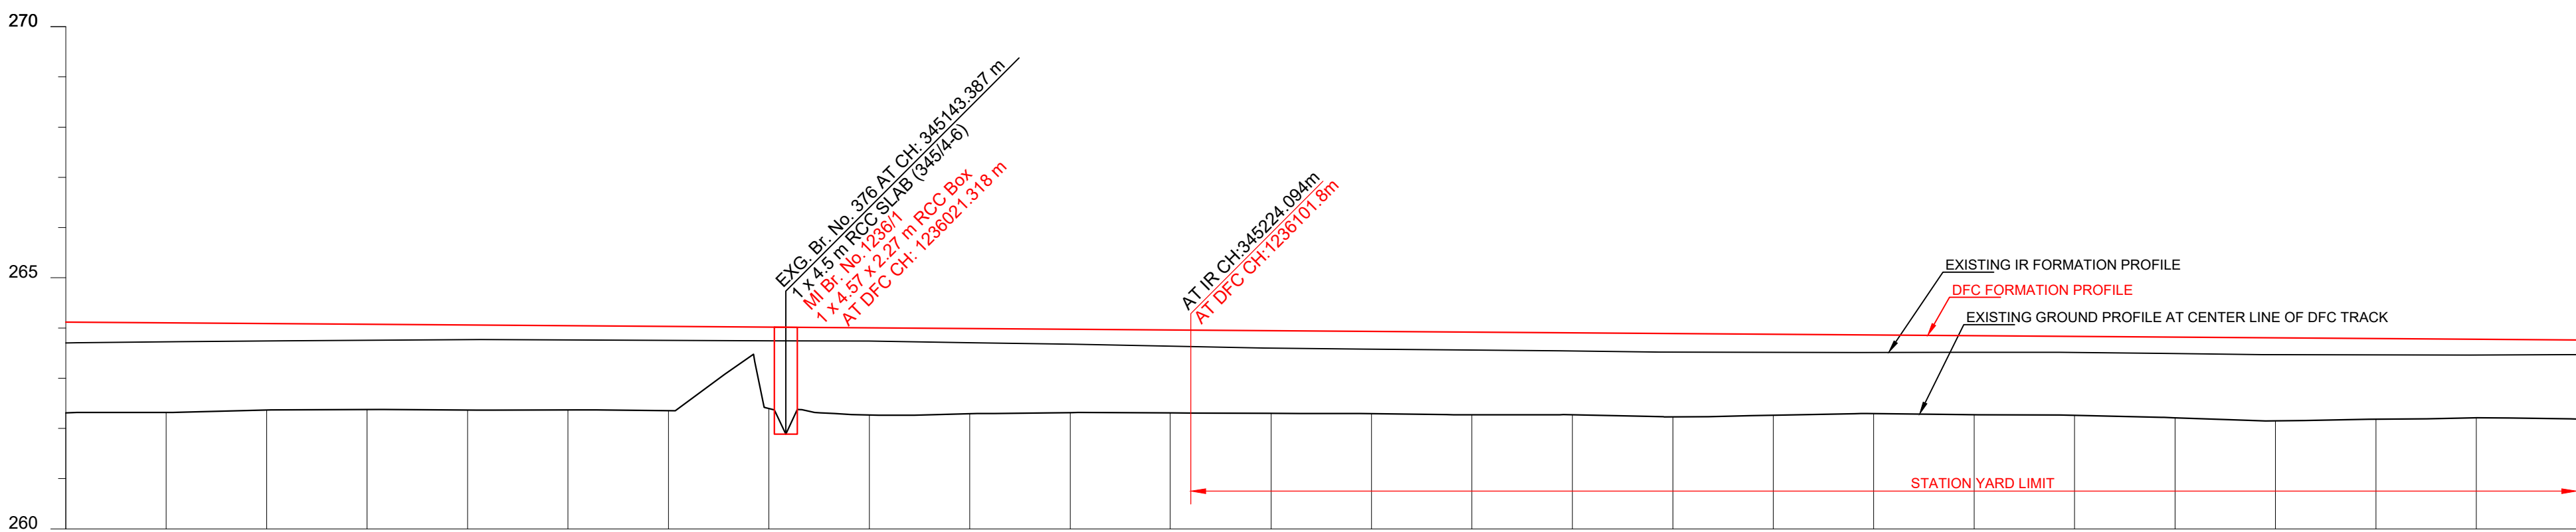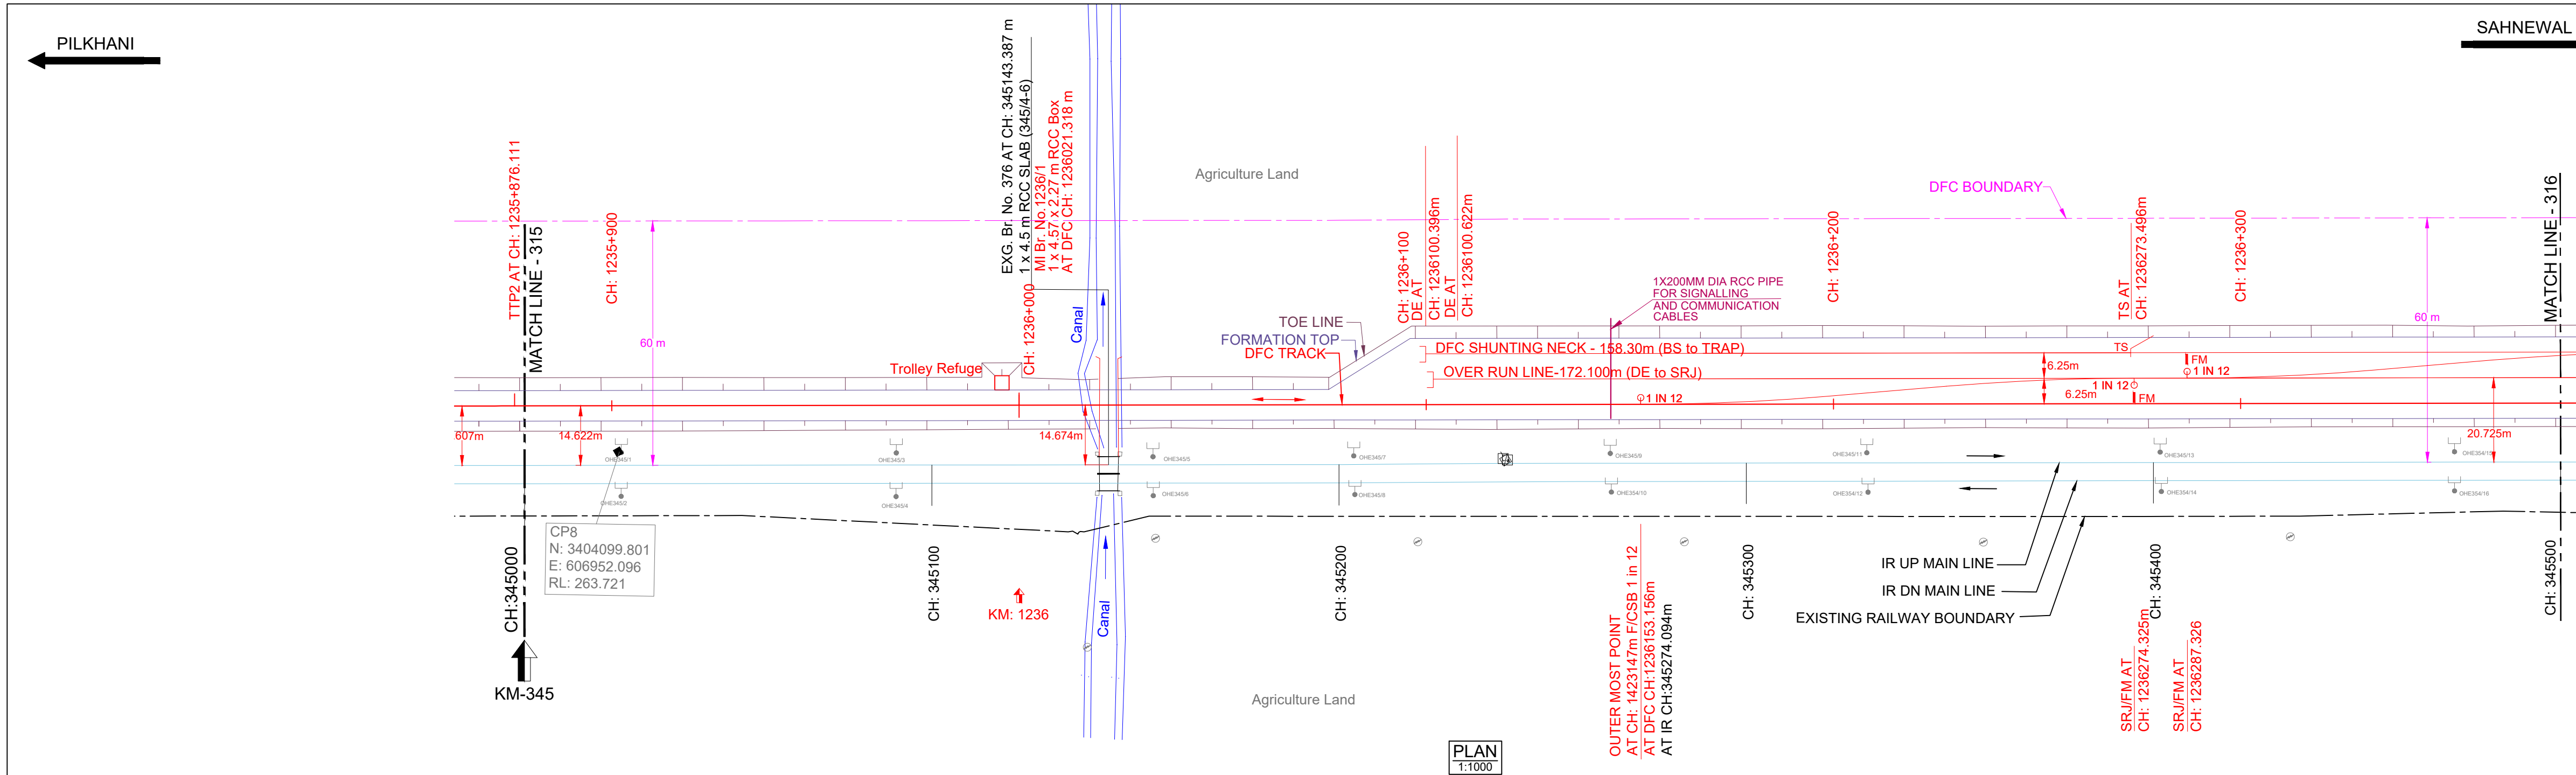

HORIZONTAL ALIGNMENT	L = 3014.655m																			
VERTICAL ALIGNMENT	L = 1480.196 m 1 IN 1405.152 F																			
TRACK DISTANCE FROM EXISTING NEAREST IR UP MAIN LINE TO DFC MAIN LINE	14.614																			
HEIGHT OF BANKING(+) / DEPTH OF CUTTING(-) (PFL-GL)	+1.805	-14.626	+1.722	+1.697	+1.694	+1.675	+1.677	+1.621	+1.734	+1.695	+1.651	+1.645	+1.633	+1.658	+1.610	+1.566	+1.573	+1.571	+1.474	+1.478
EXG GROUND LEVEL AT CENTER LINE OF DFC TRACK (GL)	262.311	262.317	262.366	262.376	262.365	262.370	262.354	262.395	262.268	262.320	262.293	262.376	262.304	262.270	262.301	262.294	262.273	262.260	262.212	262.189
EXG GROUND LEVEL AT TOE LOCATION OF DFC TRACK	262.430	262.407	262.395	262.414	262.414	262.389	262.394	262.612	262.299	262.320	262.323	262.376	262.304	262.273	262.301	262.337	262.308	262.298	262.280	262.237
DIFFERENCE BETWEEN DFC FORMATION LEVEL AND EXG.FORMATION LEVEL (PFL-EFL)	0.413	0.379	0.346	0.318	0.291	0.283	0.278	0.269	0.263	0.279	0.322	0.347	0.362	0.369	0.357	0.346	0.328	0.318	0.326	0.291
DFC FORMATION LEVEL (PFL)	263.703	263.723	263.742	263.755	263.766	263.762	263.753	263.747	263.739	263.709	263.638	263.598	263.541	263.519	263.517	263.514	263.518	263.513	263.491	263.468
EXG. FORMATION LEVEL OF EXG IR UP MAIN LINE (EFL)	263.703	263.723	263.742	263.755	263.766	263.762	263.753	263.747	263.739	263.709	263.638	263.598	263.541	263.519	263.517	263.514	263.518	263.513	263.491	263.468
DIFFERENCE BETWEEN DFC RAIL LEVEL AND EXG. RAIL LEVEL (PRL - ERL)	0.454	0.420	0.387	0.380	0.332	0.324	0.319	0.311	0.304	0.320	0.363	0.388	0.403	0.410	0.398	0.386	0.369	0.359	0.367	0.332
DFC RAIL LEVEL (PRL)	264.829	264.815	264.801	264.786	264.772	264.758	264.744	264.73	264.715	264.701	264.673	264.658	264.616	264.601	264.587	264.573	264.559	264.544	264.530	264.473
EXG.RAIL LEVEL OF NEAREST IR UP MAIN LINE(ERL)	264.375	264.395	264.414	264.427	264.440	264.434	264.425	264.419	264.411	264.381	264.310	264.235	264.213	264.191	264.189	264.186	264.190	264.185	264.142	264.135
EQUIVALENT CHAINAGE ON DFC TRACK	345000.0	345020.0	345040.0	345060.0	345080.0	345100.0	345120.0	345140.0	345160.0	345180.0	345200.0	345220.0	345240.0	345260.0	345280.0	345300.0	345320.0	345340.0	345360.0	345380.0
EXISTING IR CHAINAGE	345000.0	345020.0	345040.0	345060.0	345080.0	345100.0	345120.0	345140.0	345160.0	345180.0	345200.0	345220.0	345240.0	345260.0	345280.0	345300.0	345320.0	345340.0	345360.0	345380.0

L - SECTION

SAHNEWAL

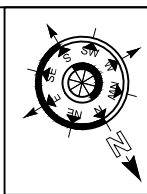

- NOTE:-
1. DFC WORKS ARE SHOWN IN RED.
 2. IR NEW WORKS ARE SHOWN IN VIOLET.
 3. ALL DIMENSIONS ARE SHOWN IN METRES.
 4. THIS DRAWING IS PREPARED BASED ON LATEST SURVEY DATA HELD ON APRIL-2022. GTS BENCH MARK OF 261.859M CONSIDERED ON TOP OF CANAL BRIDGE ABUTMENT AT DORANA VILLAGE ALONG THE NH1.
 5. DFC NEW CHAINAGE OF 1075.950M IS WITH REFERENCE TO THE IR KM OF 187.500KM END OF KM OF CP-303(SECTION P-3 PILKHANI END) AGAINST THE EXISTING DFC CHAINAGE. 116277.742M ISSUED VIDE LETTER NO. GOMDFO/CUMBSURVEY/2021-301-2301/6-011/73 DT. 17.01.2023.
 6. BALLAST PROFILE HAS BEEN PROVIDED ACCORDING TO THE CLAUSE 1.11.3 OF STANDARD SCHEDULE OF DIMENSION(EASTERN CORRIDOR) & THE BALLAST CUSHION DIMENSION SHOWN IN 35CM ON GE-14 PARA 17. SPECIFICATIONS & RECOMMENDATIONS 2. TWO LAYER SYSTEM FIG.10.

- REFERENCE DRAWINGS :-
1. FOR KEY PLAN REFER DRAWING NO. 301-2/AL/0001
 2. FOR LEGEND AND ABBREVIATIONS REFER DRAWING NO. 301-2/AL/1000
 3. FOR TYPICAL SECTION OF BALLAST PROFILE (FL-RL) REFER DRG. NO. 301-2/TK/TFD/004 (TR.1952)

REV.	DATE	REVISION DETAILS	PURPOSE OF ISSUE
0	10.10.2024	SUBMISSION OF AS-BUILT DRAWING	FOR APPROVAL

LEGEND:


SCALE

HOR - 1:1000

VER - 1:100

SHEET SIZE : A1

IR TRACK
DFCC TRACK
DFCC FUTURE PROPOSALS
STRUCTURE / BUILDING
DFCC TOE LINE
DFCC FORMATION
RETAINING WALL
ROAD
STREAM, DRAIN, NALA, CANAL.
FENCE
POWER LINES
TBM
ELECTRIC POLE/OHE MAST
IR RAILWAY BOUNDARY
DFCC BOUNDARY

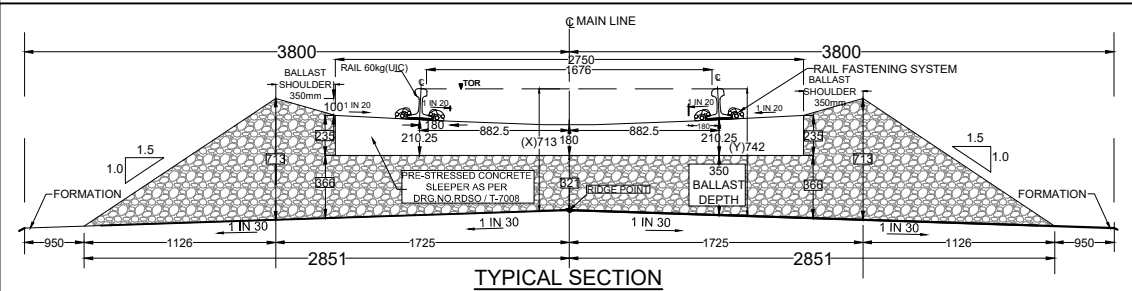

TRACK STRUCTURE		
RAIL SECTION: 60Kg/m (UIC 60Kg/m) DFC LINE: 60Kg/m (UIC 60Kg/m) IR MAIN LINE: 52Kg/m	Difference between FL- RL (Below Rail Seat)	
	IR Line	DFC
RUBBER PAD	172mm	172mm
SLEEPER DEPTH	6mm	10mm
BALLAST CUSHION	210mm	210mm
	300mm	350mm
Total Depth (FL TO RL)	688mm	742mm

OWNER

DEDICATED FREIGHT CORRIDOR CORPORATION OF INDIA LTD.

(A GOVERNMENT OF INDIA ENTERPRISE)

PROJECT OFFICE(AMBALA UNIT): OLD RAILWAY COLONY (NEAR ANAND MARKET),AMBALA CANTT-133001.

CORPORATE IDENTITY NO. : U60232DL2006001150068

ENGINEER:

DB Engineering & Consulting GmbH

Deutsche Bahn Engineering & Consulting GmbH

CONTRACTOR:

GIL - TPL JV

GAR TATA



SUBMITTED BY	GIL - TPL JV		
	DATED	NAME	SIGNATURE
PREPARED BY			
CHECKED BY	10.10.2024	VIJAY PRATAP	
APPROVED BY	10.10.2024	PARASURAM KOTYADA	

APPROVED BY	DEUTSCHE BAHN ENGINEERING & CONSULTING GMBH		
	DATED	NAME	SIGNATURE
Sr. DE./CHIEF ENGINEER		SURESH K.YALANGI	
CHIEF TRACK ENGINEER		RAJ PAL SINGH	
T.L.		H.D. VIDJAK	

STAMP	A AS-BUILT DRAWING TR. Ref:..... ENGINEER Sign.:		
EMPLOYER (DFCCIL):	DEDICATED FREIGHT CORRIDOR CORPORATION OF INDIA LTD.		

AS BUILT DRAWING			
TITLE	AS-BUILT PLAN AND PROFILE		
	FROM IR KM: 345.000 TO 345.500		
	FROM DFC KM: 1235.878 TO 1236.378		
	DATE : 10.10.2024		
DFCC APPR. NO. -		STATUS	
ENGG. APPR. NO. -		A	
DRG. NO. -301-2/AL/A/1316			
SHEET NO. : 1 OF 1			
DATE : 10.10.2024			

TR.

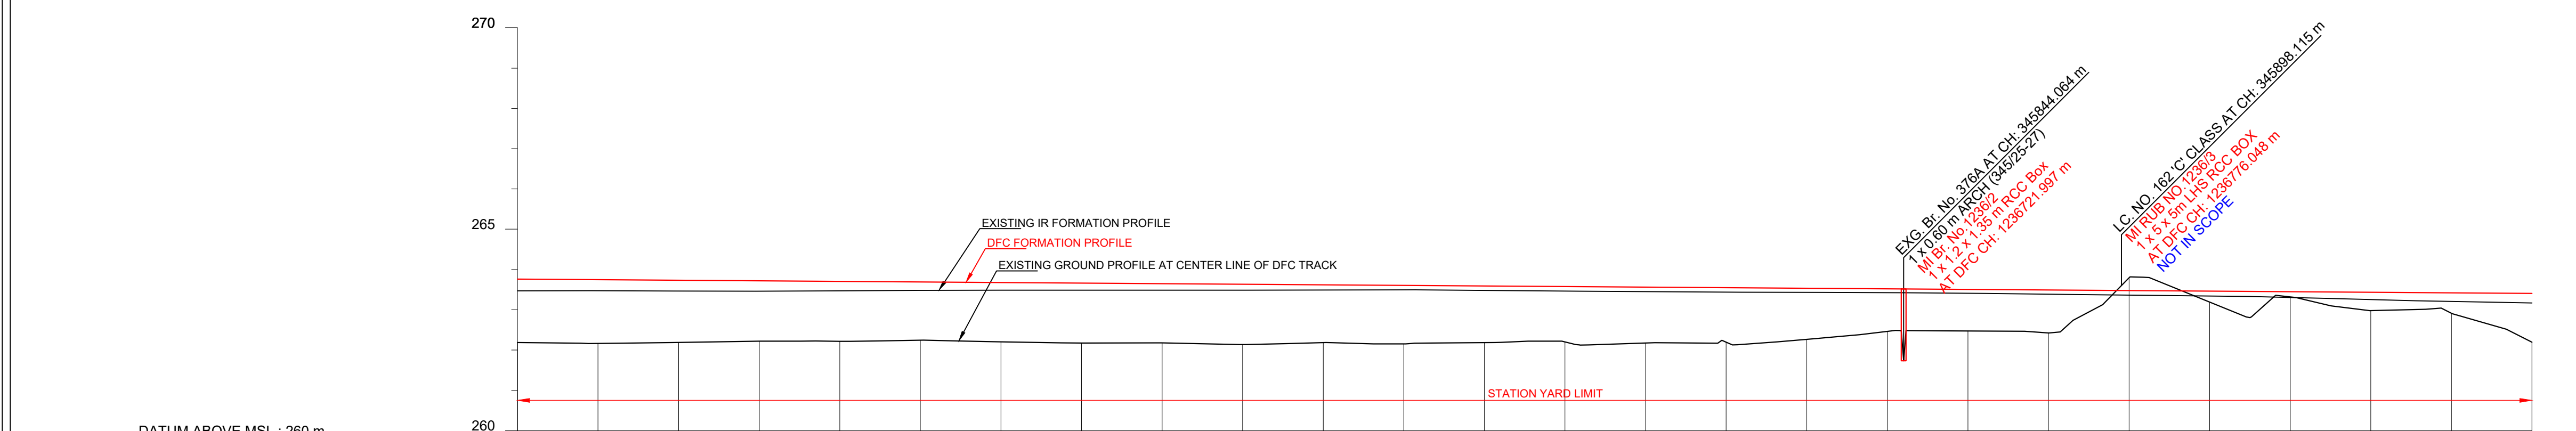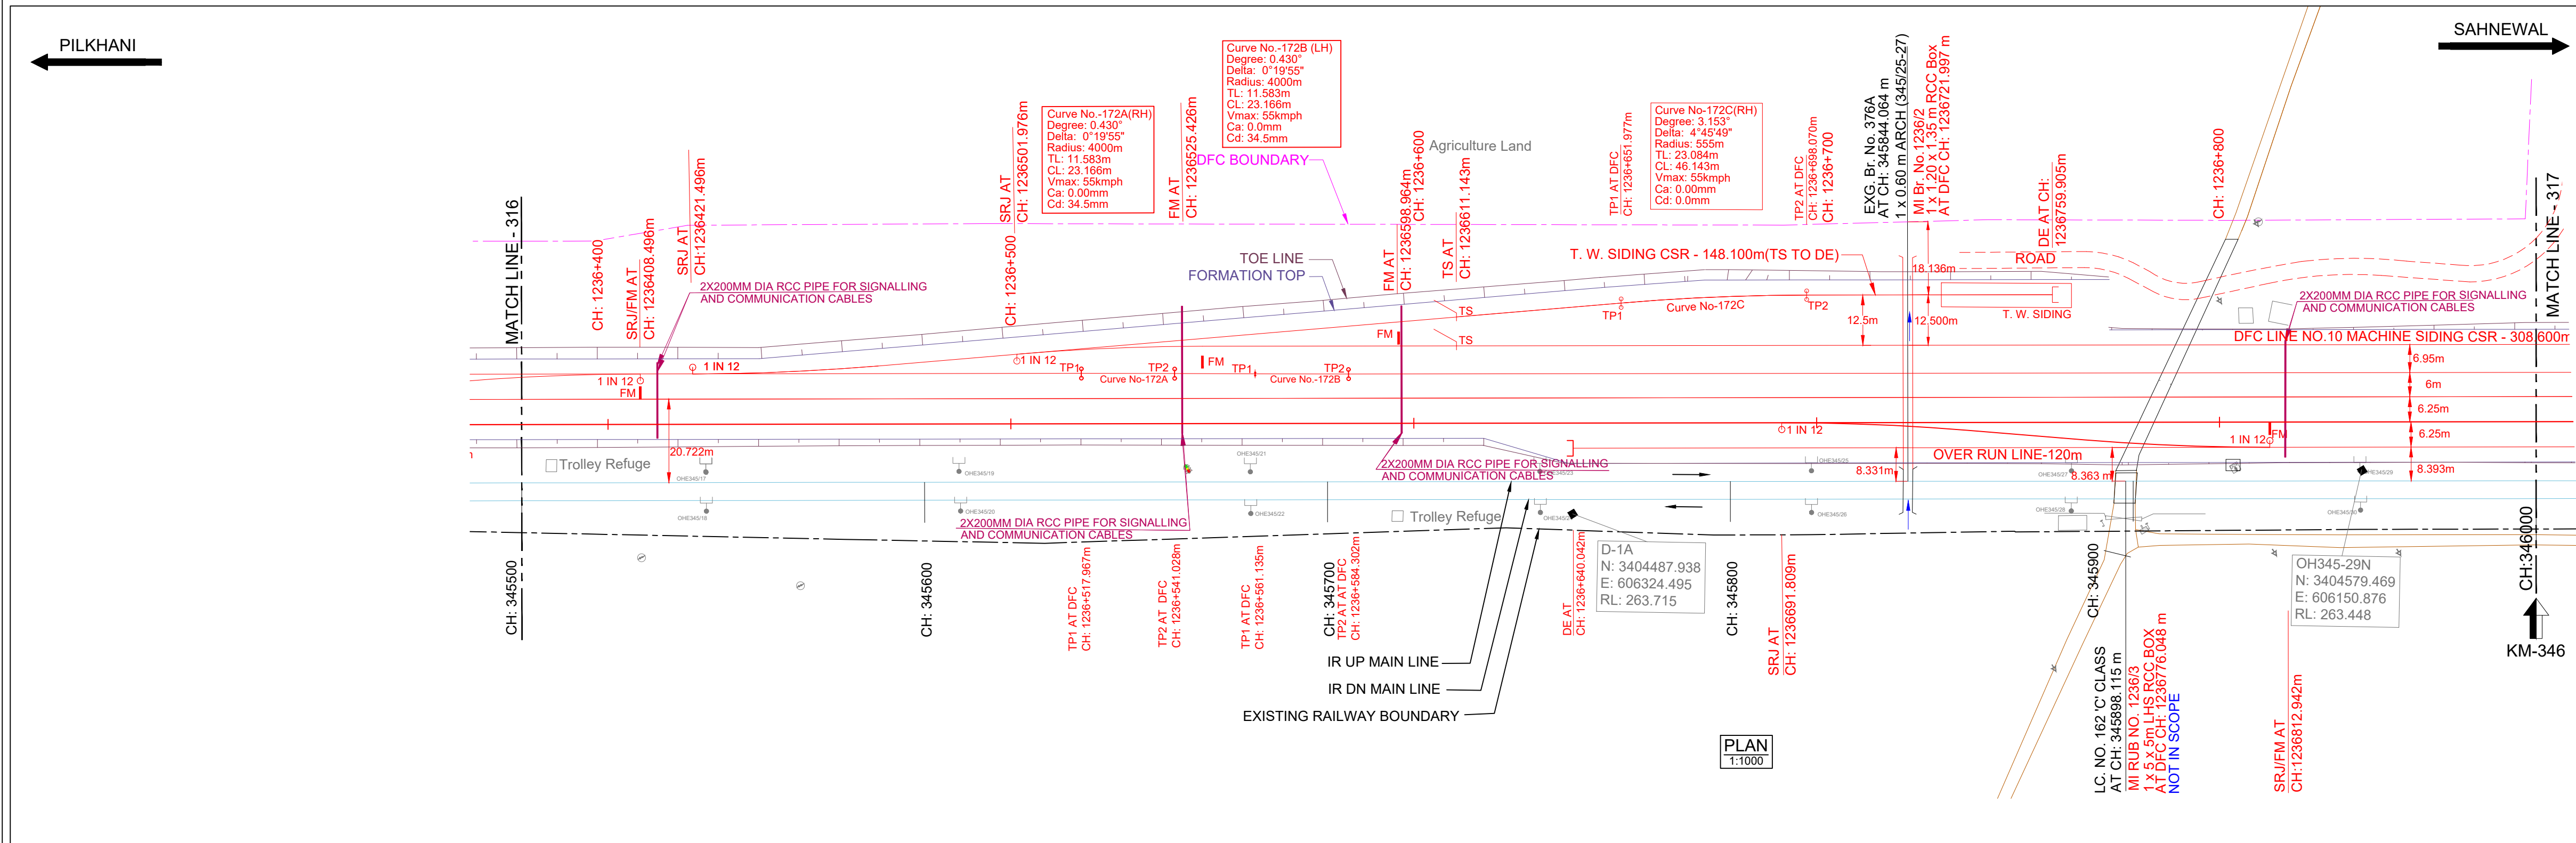

HORIZONTAL ALIGNMENT		L = 3014.655m																			
VERTICAL ALIGNMENT		L = 1480.196 m 1 IN 1405.152 F																			
TRACK DISTANCE FROM EXISTING NEAREST IR UP MAIN LINE TO DFC MAIN LINE		14.478	14.478	14.478	14.478	14.478	14.478	14.478	14.478	14.478	14.478	14.478	14.478	14.478	14.478	14.478	14.478	14.478	14.478	14.478	14.478
HEIGHT OF BANKING(+) / DEPTH OF CUTTING(-) (PFL-GL)		+1.571	+1.571	+1.571	+1.571	+1.571	+1.571	+1.571	+1.571	+1.571	+1.571	+1.571	+1.571	+1.571	+1.571	+1.571	+1.571	+1.571	+1.571	+1.571	+1.571
EXG GROUND LEVEL AT CENTER LINE OF DFC TRACK (GL)		262.189	262.189	262.189	262.189	262.189	262.189	262.189	262.189	262.189	262.189	262.189	262.189	262.189	262.189	262.189	262.189	262.189	262.189	262.189	262.189
EXG GROUND LEVEL AT TOE LOCATION OF DFC TRACK		262.237	262.237	262.237	262.237	262.237	262.237	262.237	262.237	262.237	262.237	262.237	262.237	262.237	262.237	262.237	262.237	262.237	262.237	262.237	262.237
DIFFERENCE BETWEEN DFC FORMATION LEVEL AND EXG.FORMATION LEVEL (PFL-EFL)		0.291	0.291	0.291	0.291	0.291	0.291	0.291	0.291	0.291	0.291	0.291	0.291	0.291	0.291	0.291	0.291	0.291	0.291	0.291	0.291
DFC FORMATION LEVEL (PFL)		263.700	263.700	263.700	263.700	263.700	263.700	263.700	263.700	263.700	263.700	263.700	263.700	263.700	263.700	263.700	263.700	263.700	263.700	263.700	263.700
EXG. FORMATION LEVEL OF EXG IR UP MAIN LINE (EFL)		263.469	263.469	263.469	263.469	263.469	263.469	263.469	263.469	263.469	263.469	263.469	263.469	263.469	263.469	263.469	263.469	263.469	263.469	263.469	263.469
DIFFERENCE BETWEEN DFC RAIL LEVEL AND EXG. RAIL LEVEL (PRL - ERL)		0.332	0.332	0.332	0.332	0.332	0.332	0.332	0.332	0.332	0.332	0.332	0.332	0.332	0.332	0.332	0.332	0.332	0.332	0.332	0.332
DFC RAIL LEVEL (PRL)		264.473	264.473	264.473	264.473	264.473	264.473	264.473	264.473	264.473	264.473	264.473	264.473	264.473	264.473	264.473	264.473	264.473	264.473	264.473	264.473
EXG.RAIL LEVEL OF NEAREST IR UP MAIN LINE(ERL)		264.141	264.141	264.141	264.141	264.141	264.141	264.141	264.141	264.141	264.141	264.141	264.141	264.141	264.141	264.141	264.141	264.141	264.141	264.141	264.141
EQUIVALENT CHAINAGE ON DFC TRACK		1236377.9	1236377.9	1236377.9	1236377.9	1236377.9	1236377.9	1236377.9	1236377.9	1236377.9	1236377.9	1236377.9	1236377.9	1236377.9	1236377.9	1236377.9	1236377.9	1236377.9	1236377.9	1236377.9	1236377.9
EXISTING IR CHAINAGE		345500.0	345500.0	345500.0	345500.0	345500.0	345500.0	345500.0	345500.0	345500.0	345500.0	345500.0	345500.0	345500.0	345500.0	345500.0	345500.0	345500.0	345500.0	345500.0	345500.0

NOTE:-

- DFCC WORKS ARE SHOWN IN RED.
- IR NEW WORKS ARE SHOWN IN VIOLET.
- ALL DIMENSIONS ARE SHOWN IN METRES.
- THIS DRAWING IS PREPARED BASED ON LATEST SURVEY DATA HELD ON APRIL-2022. GTS BENCH MARK OF 261.850M CONSIDERED ON TOP OF CANAL BRIDGE ABUTMENT AT DORAH VILLAGE ALONG THE NH1.
- DFC NEW CHAINAGE OF 1075.950M IS WITH REFERENCE TO THE IR KM OF 187.500KM END OF KM OF CP-303(SECTION P-3 PILKHANI END) AGAINST THE EXISTING DFC CHAINAGE. 116277.742M ISSUED VIDE LETTER NO. GCM/DFC/CUMBSURVEY/2021-301-201/16-011173 DT. 17.01.2023.
- BALLAST PROFILE HAS BEEN PROVIDED ACCORDING TO THE CLAUSE 1.11.3 OF STANDARD SCHEDULE OF DIMENSION(EASTERN CORRIDOR) & THE BALLAST CUSHION DIMENSION SHOWN IN 35CM ON GE-14 PARA 17. SPECIFICATIONS & RECOMMENDATIONS 2. TWO LAYER SYSTEM FIG.10.

REFERENCE DRAWINGS :-

- FOR KEY PLAN REFER DRAWING NO. 301-2/AL/0001
- FOR LEGEND AND ABBREVIATIONS REFER DRAWING NO. 301-2/AL/1000
- FOR TYPICAL SECTION OF BALLAST PROFILE (FL-RL) REFER DRG. NO. 301-2/TK/TFD/-004 (TR. 1952)

REVISION

REV.	DATE	REVISION DETAILS	PURPOSE OF ISSUE
0	10.10.2024	SUBMISSION OF AS-BUILT DRAWING	FOR APPROVAL

LEGEND:

SCALE	IR TRACK	DFCC TRACK	DFCC FUTURE PROPOSALS	STRUCTURE / BUILDING	DFCC TOE LINE	DFCC FORMATION	RETAINING WALL	ROAD	STREAM, DRAIN, NALA, CANAL.	FENCE	POWER LINES	TBM	ELECTRIC POLE/OHE MAST	IR RAILWAY BOUNDARY	DFCC BOUNDARY
HOR - 1:1000 VER - 1:100 SHEET SIZE : A1															

TYPICAL SECTION

TRACK STRUCTURE

RAIL SECTION: 60Kg/m (UIC 60Kg/m) DFC LINE: 60Kg/m (UIC 60Kg/m) IR MAIN LINE: 52Kg/m	Difference between FL- RL (Below Rail Seat)	
	IR Line	DFC
RUBBER PAD	172mm	172mm
SLEEPER DEPTH	6mm	10mm
BALLAST CUSHION	210mm	210mm
Total Depth (FL TO RL)	300mm	350mm

OWNER

DEDICATED FREIGHT CORRIDOR CORPORATION OF INDIA LTD.
(A GOVERNMENT OF INDIA ENTERPRISE)
PROJECT OFFICE:AMBALA UNIT: OLD RAILWAY COLONY (NEAR ANAND MARKET),AMBALA CANTT-133001.
CORPORATE IDENTITY NO : U60323DL2006GGI155068

ENGINEER:

DB Engineering & Consulting GmbH
Deutsche Bahn Engineering & Consulting GmbH

CONTRACTOR:

GIL - TPL JV
GAR TATA

SUBMITTED BY

GIL - TPL JV

PREPARED BY

DATED

NAME

SIGNATURE

CHECKED BY

10.10.2024

VIJAY PRATAP

APPROVED BY

10.10.2024

PARASURAM KOTYADA

APPROVED BY

DEUTSCHE BAHN ENGINEERING & CONSULTING GMBH

Sr. DE./CHIEF ENGINEER

SURESH K.YALANGI

CHIEF TRACK ENGINEER

RAJ PAL SINGH

T.L.

H.D. VIDJAK

STAMP

A AS-BUILT DRAWING
TR. Ref.:.....
ENGINEER Sign.:.....

EMPLOYER (DFCCIL):

DEDICATED FREIGHT CORRIDOR CORPORATION OF INDIA LTD.

AS BUILT DRAWING

TITLE

AS-BUILT PLAN AND PROFILE


FROM IR KM: 345.500 TO 346.000
FROM DFC KM: 1236.378 TO 1236.878

DFCC APPR. NO. -
ENGG. APPR. NO. -
DRG. NO. -301-2/AL/A/1317
SHEET NO. : 1 OF 1
DATE : 10.10.2024

STATUS

A

TR.

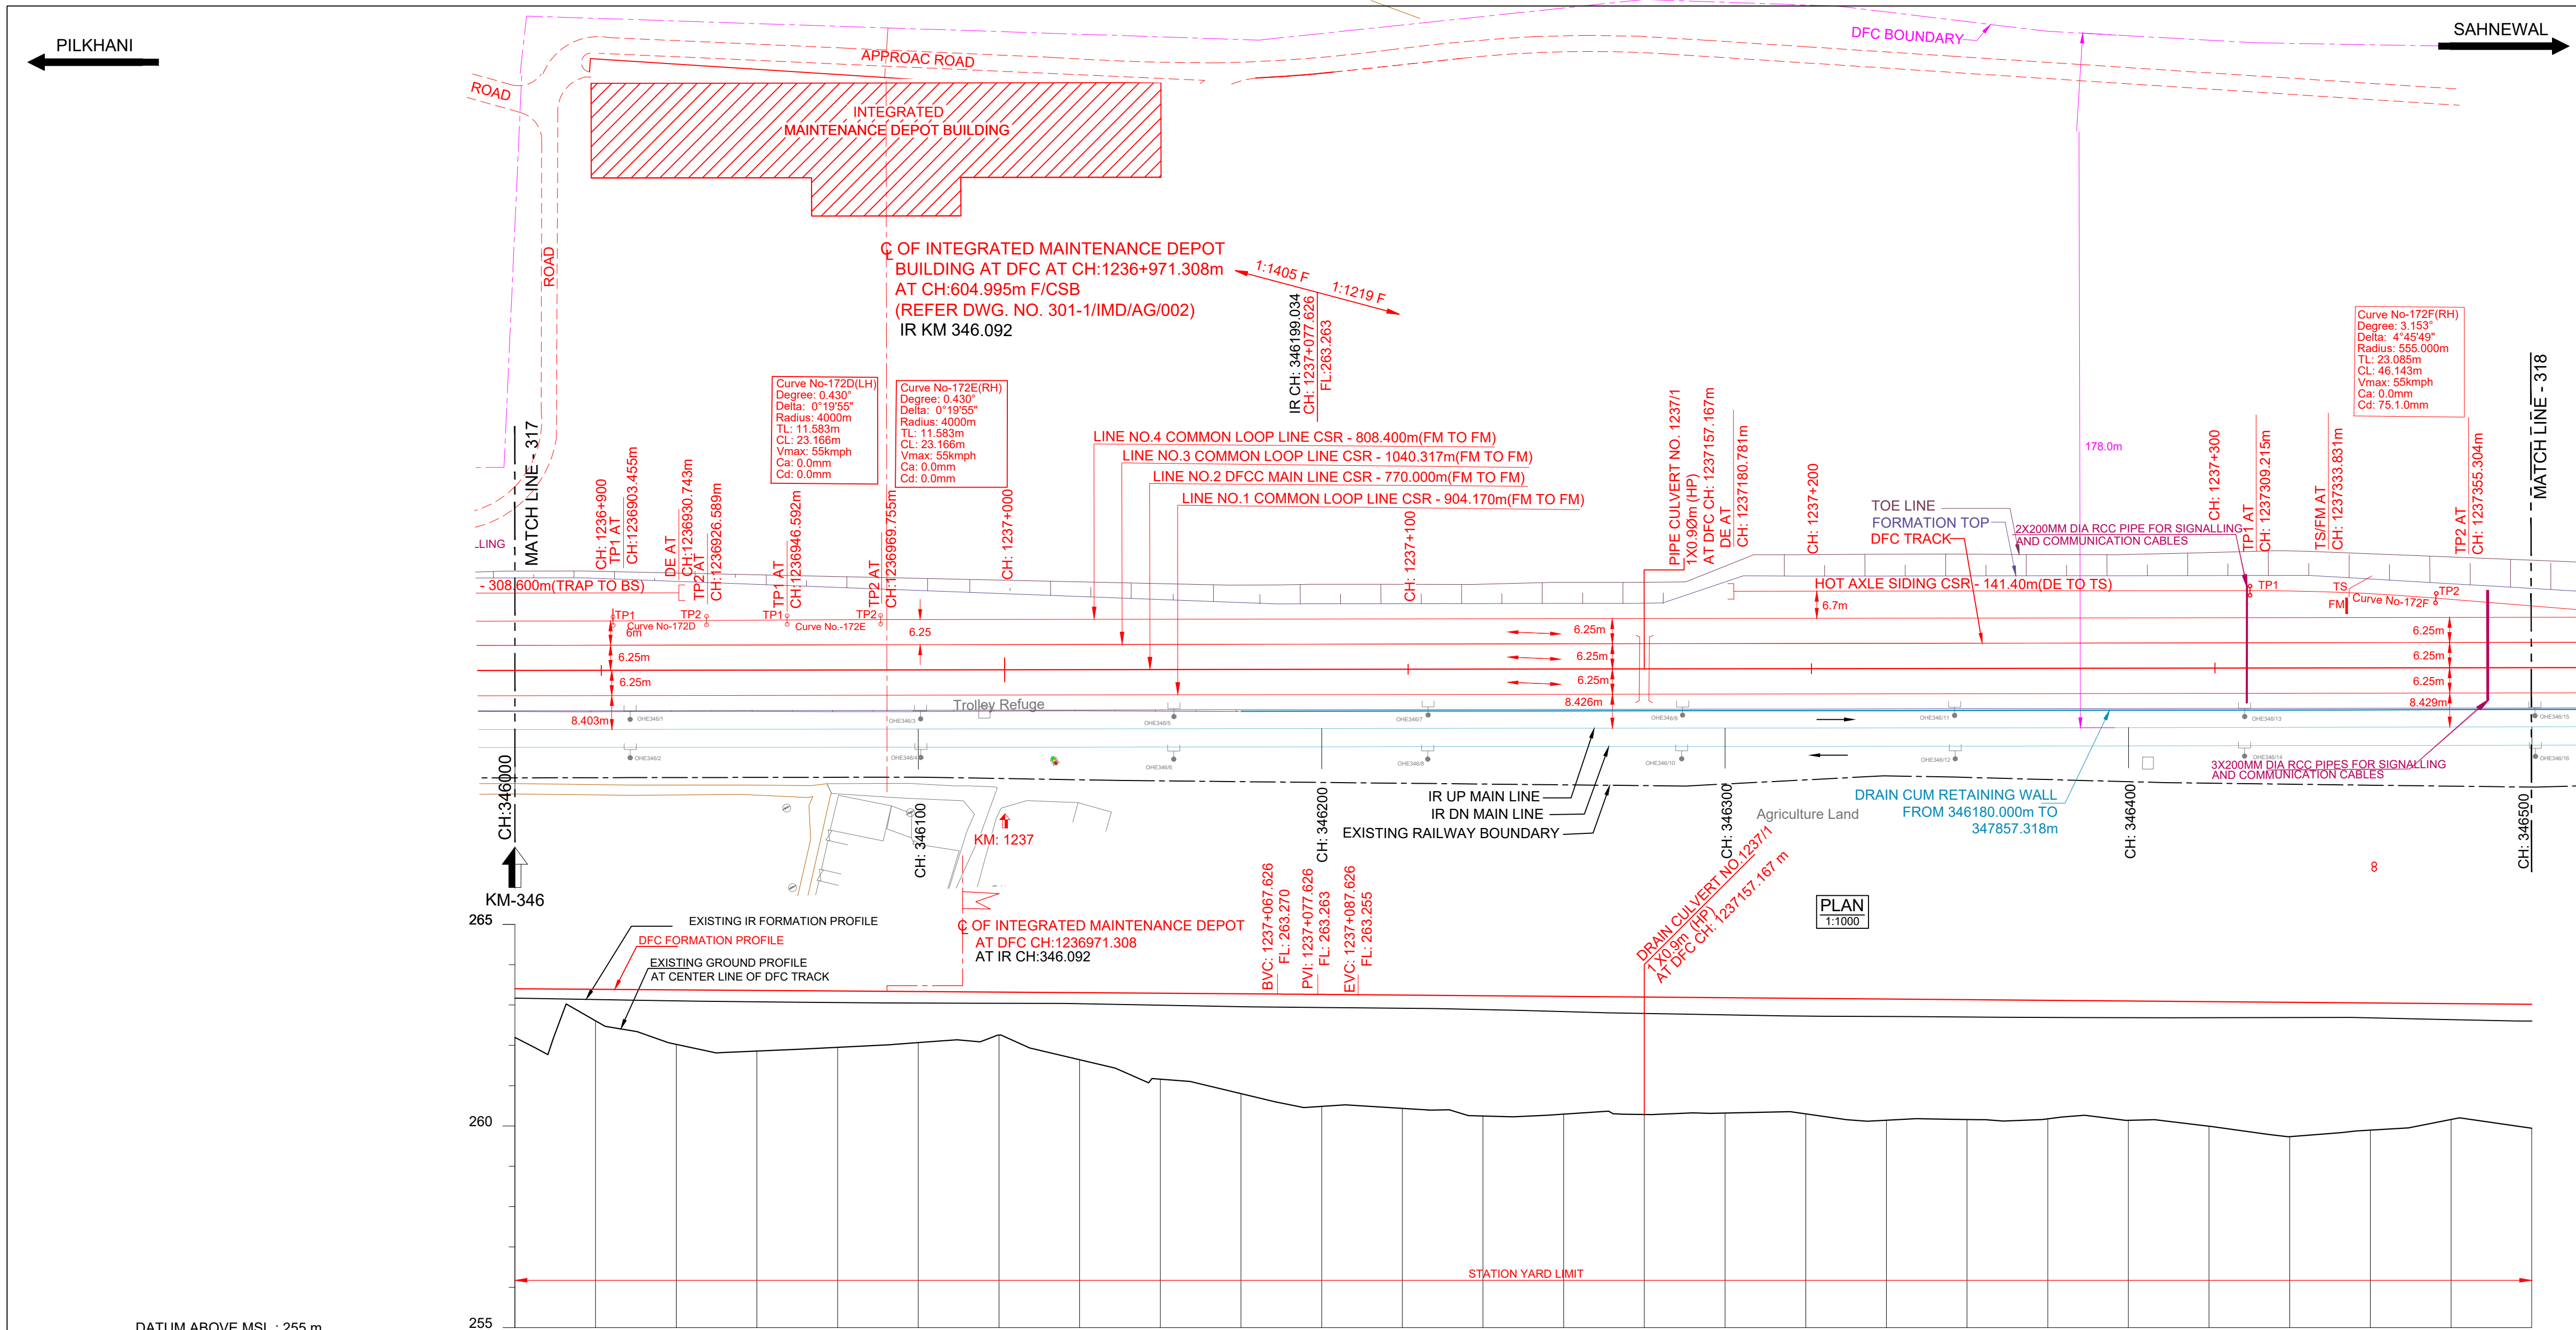

HORIZONTAL ALIGNMENT	L = 3014.655m																			
VERTICAL ALIGNMENT	L=1480.196 m 1 IN 1405.152 F										L=20.0 m R=184307 m									
TRACK DISTANCE FROM EXISTING NEAREST IR UP MAIN LINE TO DFC MAIN LINE	-14.653	-14.653	-14.654	-14.651	-14.651	-14.652	-14.655	-14.655	-14.659	-14.662	-14.660	-14.659	-14.671	-14.675	-14.676	-14.676	-14.686	-14.715	-14.730	-14.733
HEIGHT OF BANKING(+) / DEPTH OF CUTTING(-) (PFL-GL)	+1.209	+0.783	+1.352	+1.505	+1.398	+1.267	+1.067	+1.662	+2.133	+2.476	+2.777	+2.811	+2.980	+2.859	+2.865	+3.005	+2.958	+3.089	+3.330	+3.072
EXG GROUND LEVEL AT CENTER LINE OF DFC TRACK (GL)	262.195	262.607	262.024	261.857	261.949	262.066	262.252	261.843	261.158	260.800	260.485	260.435	260.249	260.321	260.298	260.142	260.140	260.993	260.735	260.944
EXG GROUND LEVEL AT TOE LOCATION OF DFC TRACK	262.462	262.386	262.068	261.990	261.917	261.960	261.822	261.308	260.873	260.848	260.735	260.743	260.760	260.414	260.348	260.340	260.388	260.136	260.853	260.146
DIFFERENCE BETWEEN DFC FORMATION LEVEL AND EXG.FORMATION LEVEL (PFL-EFL)	0.234	0.255	0.274	0.283	0.286	0.285	0.276	0.273	0.296	0.317	0.324	0.327	0.342	0.425	0.440	0.434	0.413	0.398	0.378	0.414
DFC FORMATION LEVEL (PFL)	263.404	263.390	263.376	263.362	263.347	263.333	263.319	263.305	263.291	263.276	263.262	263.246	263.196	263.180	263.163	263.147	263.098	263.092	263.065	263.016
EXG. FORMATION LEVEL OF EXG IR UP MAIN LINE (EFL)	263.170	263.135	263.102	263.079	263.061	263.048	263.043	263.032	262.995	262.959	262.938	262.910	262.790	262.755	262.723	262.713	262.685	262.684	262.687	262.602
DIFFERENCE BETWEEN DFC RAIL LEVEL AND EXG. RAIL LEVEL (PRL - ERL)	0.276	0.296	0.315	0.324	0.328	0.328	0.317	0.314	0.336	0.359	0.366	0.368	0.384	0.467	0.482	0.476	0.455	0.440	0.420	0.455
DFC RAIL LEVEL (PRL)	264.117	264.103	264.089	264.075	264.061	264.046	264.032	264.018	264.004	263.989	263.976	263.959	263.910	263.894	263.877	263.861	263.812	263.795	263.779	263.730
EXG.RAIL LEVEL OF NEAREST IR UP MAIN LINE(ERL)	263.842	263.807	263.774	263.751	263.733	263.720	263.715	263.704	263.667	263.631	263.610	263.591	263.462	263.427	263.395	263.385	263.357	263.356	263.359	263.274
EQUIVALENT CHAINAGE ON DFC TRACK	-1236878	-1236897.9	-1236917.9	-1236937.9	-1236957.9	-1236977.9	-1236997.9	-1237017.9	-1237037.9	-1237057.9	-1237077.9	-1237097.9	-1237117.9	-1237137.9	-1237157.9	-1237177.9	-1237197.9	-1237217.9	-1237237.9	-1237257.9
EXISTING IR CHAINAGE	346000.0	346020.0	346040.0	346060.0	346080.0	346100.0	346120.0	346140.0	346160.0	346180.0	346200.0	346220.0	346240.0	346260.0	346280.0	346300.0	346320.0	346340.0	346360.0	346380.0

L - SECTION

NOTE:

- DFCC WORKS ARE SHOWN IN RED.
- IR NEW WORKS ARE SHOWN IN VIOLET.
- ALL DIMENSIONS ARE SHOWN IN METRES.
- THIS DRAWING IS PREPARED BASED ON LATEST SURVEY DATA HELD ON APRIL-2022. GTS BENCH MARK OF 261.850M CONSIDERED ON TOP OF CANAL BRIDGE ABUTMENT AT DORANA VILLAGE ALONG THE NH1.
- DFC NEW CHAINAGE OF 1075.950M IS WITH REFERENCE TO THE IR KM OF 187.500KM END OF KM OF CP-303(SECTION P-3 PILKHANI END) AGAINST THE EXISTING DFC CHAINAGE. 116277.742M ISSUED VIDE LETTER NO. GOMDFCC/MB/SURVEY/2021-301-20016-011173 DT. 17.01.2023.
- BALLAST PROFILE HAS BEEN PROVIDED ACCORDING TO THE CLAUSE 1.11.3 OF STANDARD SCHEDULE OF DIMENSION(EASTERN CORRIDOR) & THE BALLAST CUSHION DIMENSION SHOWN IN 35CM ON GE-14 PARA 17. SPECIFICATIONS & RECOMMENDATIONS 2. TWO LAYER SYSTEM FIG.10.

REFERENCE DRAWINGS :-

- FOR KEY PLAN REFER DRAWING NO. 301-2/AL/0001
- FOR LEGEND AND ABBREVIATIONS REFER DRAWING NO. 301-2/AL/1000
- FOR TYPICAL SECTION OF BALLAST PROFILE (FL-RL) REFER DRG. NO. 301-2/TK/TFD/-004 (TR. 1952)

REVISIONS

REV.	DATE	REVISION DETAILS	PURPOSE OF ISSUE
0	10.10.2024	SUBMISSION OF AS-BUILT DRAWING	FOR APPROVAL

SCALE
HOR - 1:1000
VER - 1:100
SHEET SIZE : A1

LEGEND:

- IR TRACK
- DFCC TRACK
- DFCC FUTURE PROPOSALS
- STRUCTURE / BUILDING
- DFCC TOE LINE
- DFCC FORMATION
- RETAINING WALL
- ROAD
- STREAM, DRAIN, NALA, CANAL.
- FENCE
- POWER LINES
- TBM
- ELECTRIC POLE/OHE MAST
- IR RAILWAY BOUNDARY
- DFCC BOUNDARY

TYPICAL SECTION

TRACK STRUCTURE		
RAIL SECTION: 60Kg/m (UIC 60Kg/m)	Difference between FL- RL (Below Rail Seat)	
DFC LINE: 60Kg/m (UIC 60Kg/m)	IR Line	DFC
IR MAIN LINE: 52Kg/m	172mm	172mm
RUBBER PAD	6mm	10mm
SLEEPER DEPTH	210mm	210mm
BALLAST CUSHION	300mm	350mm
Total Depth (FL TO RL)	688mm	742mm

OWNER
DEDICATED FREIGHT CORRIDOR CORPORATION OF INDIA LTD.
(A GOVERNMENT OF INDIA ENTERPRISE)
PROJECT OFFICE(AMBALA UNIT): OLD RAILWAY COLONY (NEAR ANAND MARKET),AMBALA CANTT-133001.
CORPORATE IDENTITY NO. : U60233DL2006GGI150068

ENGINEER:
DB Engineering & Consulting GmbH
Deutsche Bahn Engineering & Consulting GmbH

CONTRACTOR:
GIL - TPL JV

SUBMITTED BY	GIL - TPL JV		
	DATED	NAME	SIGNATURE
PREPARED BY	10.10.2024	VIJAY PRATAP	
CHECKED BY	10.10.2024	PARASURAM KOTYADA	
APPROVED BY	DEUTSCHE BAHN ENGINEERING & CONSULTING GMBH		
	DATED	NAME	SIGNATURE
Sr. DE./CHIEF ENGINEER		SURESH K.YALANGI	
CHIEF TRACK ENGINEER		RAJ PAL SINGH	
T.L.		H.D. VIDJAK	


STAMP
A
AS-BUILT DRAWING
TR. Ref.:.....
ENGINEER Sign.:.....

EMPLOYER (DFCCIL): DEDICATED FREIGHT CORRIDOR CORPORATION OF INDIA LTD.

AS BUILT DRAWING

TITLE AS-BUILT PLAN AND PROFILE FROM IR KM: 346.000 TO 346.500 FROM DFC KM: 1236.878 TO 1237.378	DFCC APPR. NO. - ENGG. APPR. NO. - DRG. NO. :301-2/AL/A/1318 SHEET NO. : 1 OF 1 DATE : 10.10.2024	STATUS A
---	---	-------------

TR.

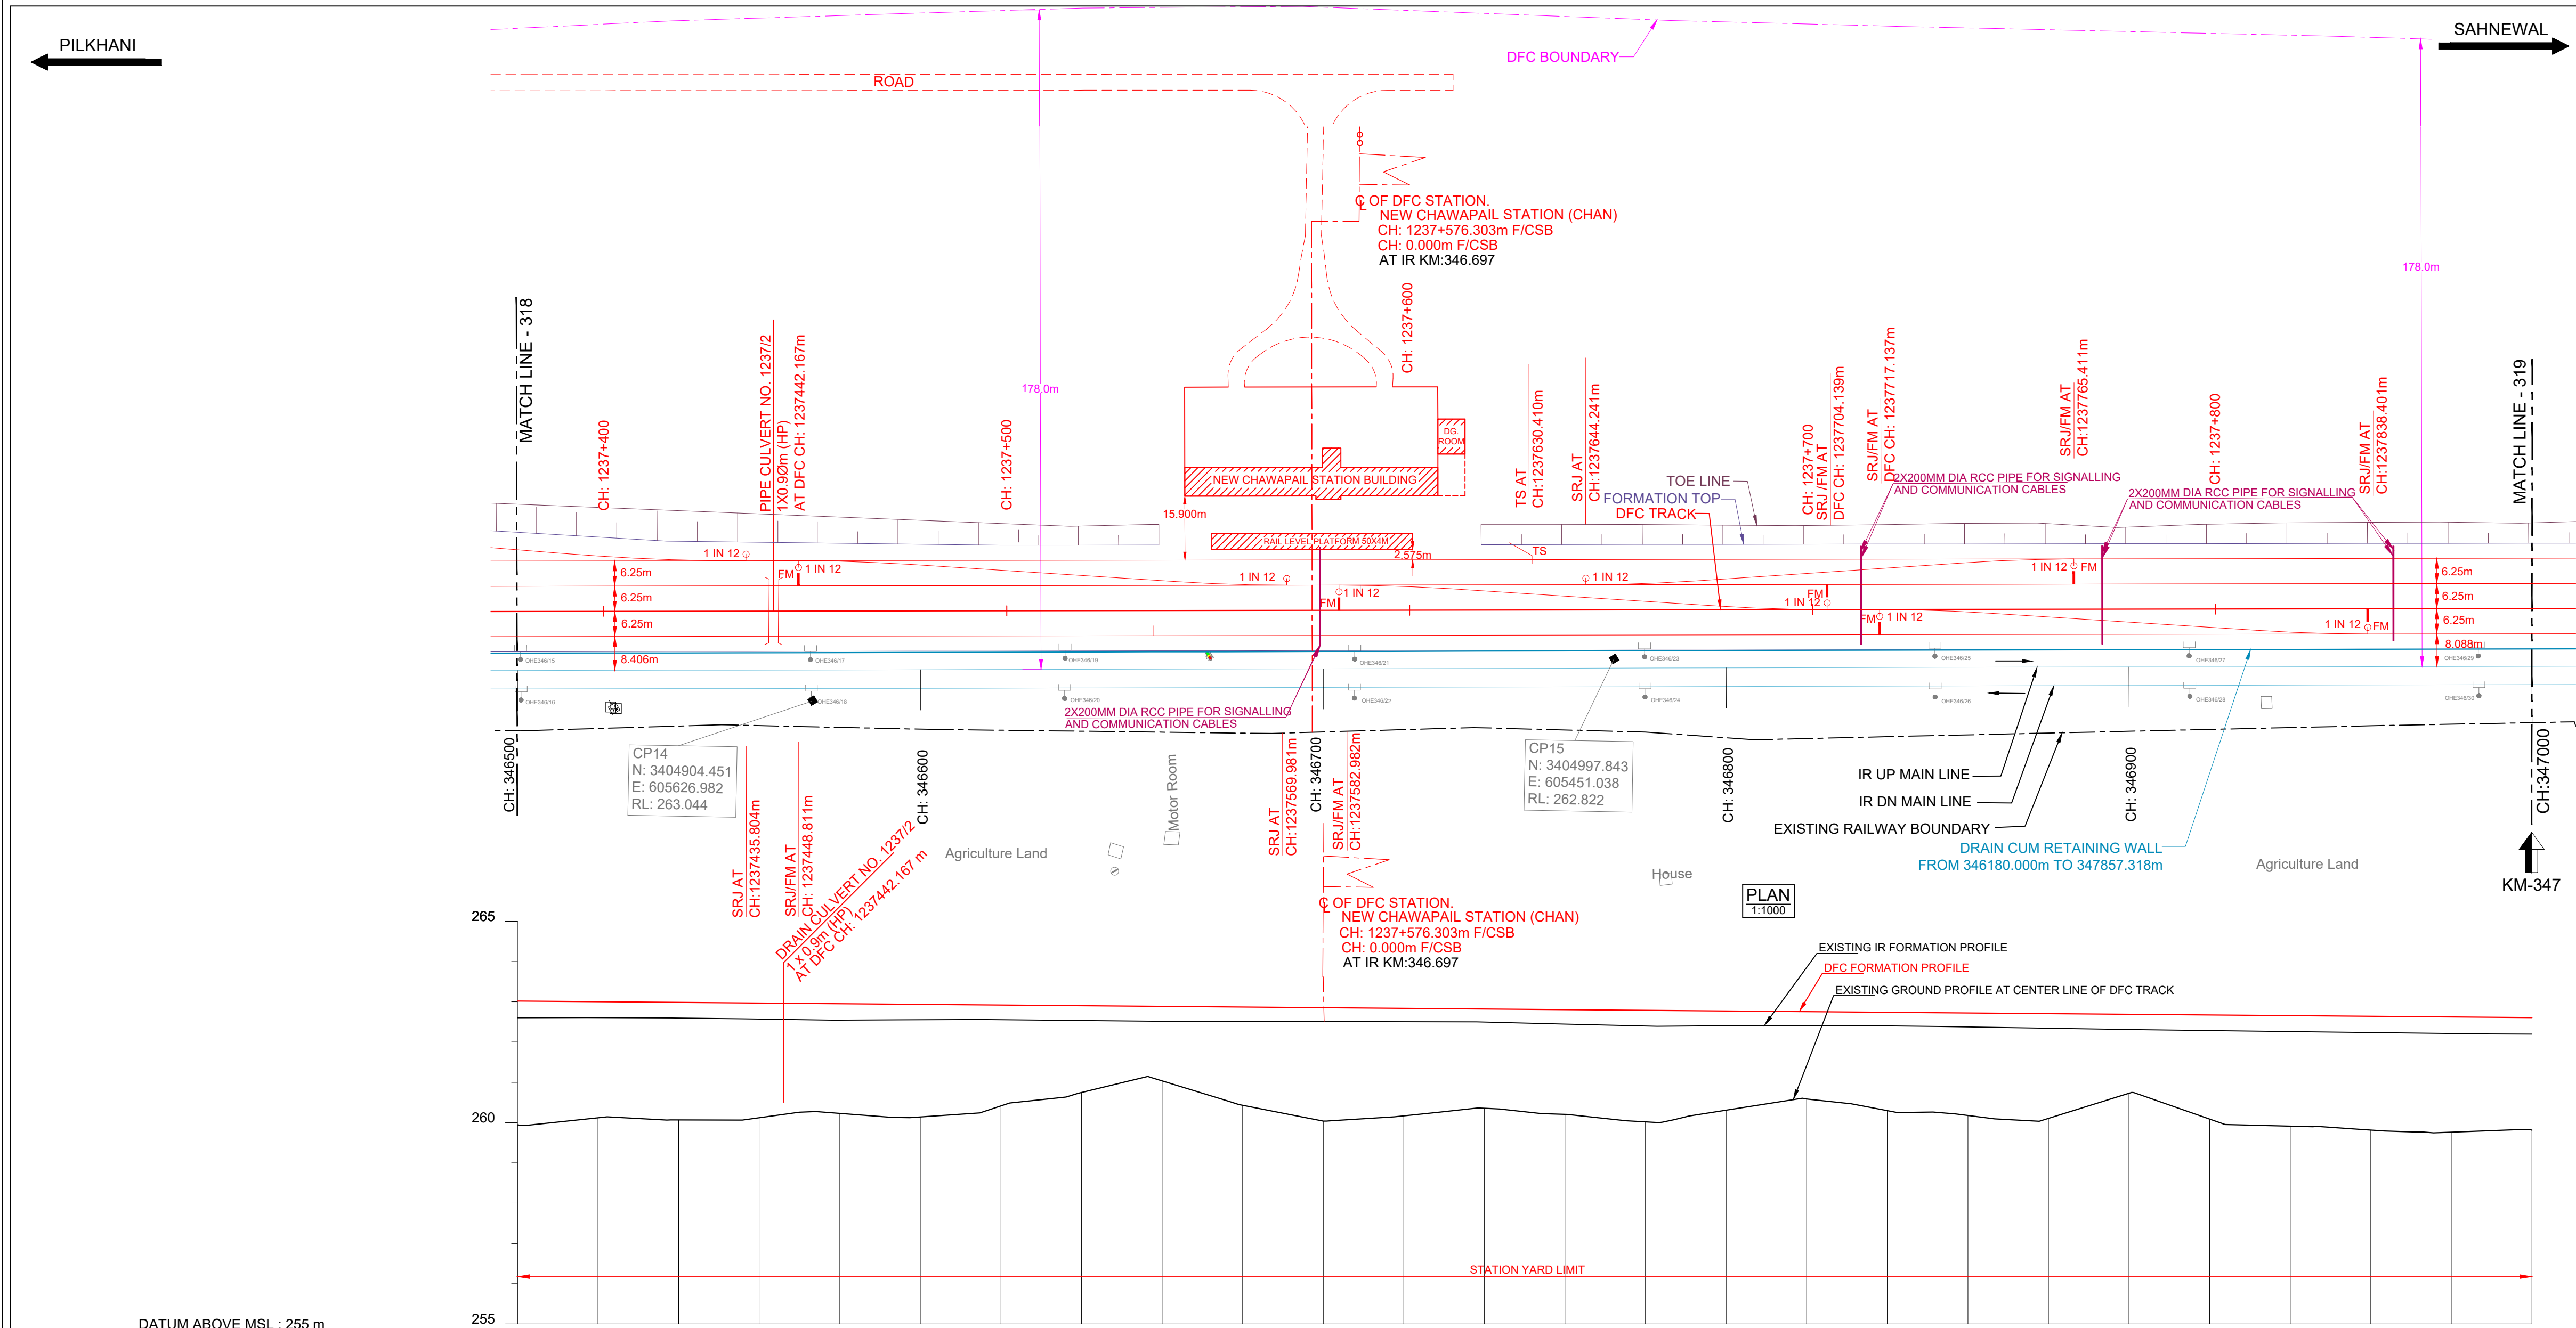

HORIZONTAL ALIGNMENT	L = 3014.655m																			
VERTICAL ALIGNMENT	L=2484.775 m 1 IN 1219.242 F																			
TRACK DISTANCE FROM EXISTING NEAREST IR UP MAIN LINE TO DFC MAIN LINE	14.658	14.658	14.656	14.654	14.650	14.644	14.618	14.593	14.574	14.557	14.543	14.530	14.515	14.497	14.488	14.439	14.423	14.406	14.388	14.375
HEIGHT OF BANKING(+) / DEPTH OF CUTTING(-) (PFL-GL)	+3.072	+2.880	+2.916	+2.847	+2.721	+2.793	+2.503	+2.156	+1.850	+2.439	+2.814	+2.668	+2.463	+2.598	+2.166	+2.441	+2.544	+2.801	+2.585	+2.825
EXG GROUND LEVEL AT CENTER LINE OF DFC TRACK (GL)	-259.944	-260.119	-260.067	-260.120	-260.229	-260.141	-260.414	-260.745	-261.035	-260.429	-260.204	-260.038	-260.167	-260.356	-260.205	-260.016	-260.295	-260.103	-260.086	-259.913
EXG GROUND LEVEL AT TOE LOCATION OF DFC TRACK	-260.146	-260.241	-260.214	-260.174	-260.293	-260.235	-260.330	-260.421	-260.203	-260.204	-260.262	-260.282	-260.322	-260.213	-260.210	-260.181	-260.295	-260.094	-260.106	-259.916
DIFFERENCE BETWEEN DFC FORMATION LEVEL AND EXG.FORMATION LEVEL (PFL-EFL)	0.414	0.395	0.386	0.395	0.406	0.381	0.363	0.364	0.366	0.353	0.342	0.330	0.330	0.324	0.360	0.390	0.364	0.362	0.385	0.394
DFC FORMATION LEVEL (PFL)	-263.016	-262.999	-262.983	-262.967	-262.950	-262.934	-262.917	-262.901	-262.885	-262.868	-262.852	-262.835	-262.819	-262.803	-262.770	-262.753	-262.737	-262.721	-262.671	-262.655
EXG. FORMATION LEVEL OF EXG IR UP MAIN LINE (EFL)	-262.602	-262.604	-262.597	-262.572	-262.544	-262.553	-262.554	-262.537	-262.519	-262.515	-262.510	-262.505	-262.495	-262.443	-262.406	-262.412	-262.401	-262.375	-262.286	-262.261
DIFFERENCE BETWEEN DFC RAIL LEVEL AND EXG. RAIL LEVEL (PRL - ERL)	0.455	0.437	0.428	0.436	0.448	0.423	0.405	0.406	0.407	0.396	0.384	0.372	0.366	0.378	0.388	0.404	0.420	0.435	0.428	0.443
DFC RAIL LEVEL (PRL)	-263.730	-263.713	-263.697	-263.680	-263.664	-263.648	-263.633	-263.615	-263.598	-263.582	-263.566	-263.549	-263.533	-263.516	-263.484	-263.467	-263.451	-263.402	-263.385	-263.369
EXG.RAIL LEVEL OF NEAREST IR UP MAIN LINE(ERL)	-263.274	-263.276	-263.269	-263.244	-263.216	-263.225	-263.226	-263.209	-263.191	-263.187	-263.182	-263.177	-263.167	-263.115	-263.078	-263.084	-263.073	-263.047	-262.958	-262.933
EQUIVALENT CHAINAGE ON DFC TRACK	-1237377.9	-1237387.9	-1237417.9	-1237437.9	-1237457.9	-1237477.9	-1237497.9	-1237517.9	-1237537.9	-1237557.9	-1237577.9	-1237597.9	-1237617.9	-1237637.9	-1237657.9	-1237677.9	-1237697.9	-1237717.9	-1237737.9	-1237757.9
EXISTING IR CHAINAGE	346500.0	346520.0	346540.0	346560.0	346580.0	346600.0	346620.0	346640.0	346660.0	346680.0	346700.0	346720.0	346740.0	346760.0	346780.0	346800.0	346820.0	346840.0	346860.0	346880.0

L - SECTION

NOTE:-

- DFCC WORKS ARE SHOWN IN RED.
- IR NEW WORKS ARE SHOWN IN VIOLET.
- ALL DIMENSIONS ARE SHOWN IN METRES.
- THIS DRAWING IS PREPARED BASED ON LATEST SURVEY DATA HELD ON APRIL-2022. GTS BENCH MARK OF 261.850M CONSIDERED ON TOP OF CANAL BRIDGE ABUTMENT AT DORAHA VILLAGE ALONG THE NH1.
- DFC NEW CHAINAGE OF 1075.950M IS WITH REFERENCE TO THE IR KM OF 187.500KM END OF KM OF CP-303(SECTION P-3 PILKHANI END) AGAINST THE EXISTING DFC CHAINAGE. 116277.742M ISSUED VIDE LETTER NO. GOMDFCC/UMBSURVEY/2021-301-230116-011173 DT. 17.01.2023.
- BALLAST PROFILE HAS BEEN PROVIDED ACCORDING TO THE CLAUSE 1.11.3 OF STANDARD SCHEDULE OF DIMENSION(EASTERN CORRIDOR) & THE BALLAST CUSHION DIMESION SHOWN IN 35CM ON GE-14 PARA 17. SPECIFICATIONS & RECOMMENDATIONS 2. TWO LAYER SYSTEM FIG.10.

REFERENCE DRAWINGS :-

- FOR KEY PLAN REFER DRAWING NO. 301-2/AL/0001
- FOR LEGEND AND ABBREVIATIONS REFER DRAWING NO. 301-2/AL/1000
- FOR TYPICAL SECTION OF BALLAST PROFILE (FL-RL) REFFER DRG. NO. 301-2/TK/TFD/-004 (TR.1952)

0	10.10.2024	SUBMISSION OF AS-BUILT DRAWING	FOR APPROVAL
REV.	DATE	REVISION DETAILS	PURPOSE OF ISSUE

LEGEND:

IR TRACK
DFCC TRACK
DFCC FUTURE PROPOSALS
STRUCTURE / BUILDING
DFCC TOE LINE
DFCC FORMATION
RETAINING WALL
ROAD
STREAM, DRAIN, NALA, CANAL.
FENCE
POWER LINES
TBM
ELECTRIC POLE/OHE MAST
IR RAILWAY BOUNDARY
DFCC BOUNDARY

SCALE

HOR - 1:1000
VER - 1:100
SHEET SIZE : A1

TYPICAL SECTION

TRACK STRUCTURE		
RAIL SECTION: 60Kg/m (UIC 60Kg/m) DFC LINE: 60Kg/m (UIC 60Kg/m) IR MAIN LINE: 52Kg/m	Difference between FL- RL (Below Rail Seat)	
	IR Line	DFC
RUBBER PAD	172mm	172mm
SLEEPER DEPTH	6mm	10mm
BALLAST CUSHION	210mm	210mm
	300mm	350mm
Total Depth (FL TO RL)	688mm	742mm

OWNER

DEDICATED FREIGHT CORRIDOR CORPORATION OF INDIA LTD.
(A GOVERNMENT OF INDIA ENTERPRISE)
PROJECT OFFICE(AMBALA UNIT): OLD RAILWAY COLONY (NEAR ANAND MARKET),AMBALA CANTT-133001.
CORPORATE IDENTITY NO. : U60233DL2006GGI150068

ENGINEER:

DB Engineering & Consulting GmbH
Deutsche Bahn Engineering & Consulting GmbH

CONTRACTOR:

GIL - TPL JV

SUBMITTED BY	GIL - TPL JV		
	DATED	NAME	SIGNATURE
PREPARED BY	10.10.2024	VIJAY PRATAP	
CHECKED BY	10.10.2024	PARASURAM KOTYADA	
APPROVED BY	DEUTSCHE BAHN ENGINEERING & CONSULTING GMBH		
	DATED	NAME	SIGNATURE
Sr. DE./CHIEF ENGINEER		SURESH K.YALANGI	
CHIEF TRACK ENGINEER		RAJ PAL SINGH	
T.L.		H.D. VIDJAK	

STAMP



AS-BUILT DRAWING
TR. Ref:.....
ENGINEER Sign.:..

EMPLOYER (DFCCIL): DEDICATED FREIGHT CORRIDOR CORPORATION OF INDIA LTD.

AS BUILT DRAWING

TITLE	DFCC APPR. NO. -
AS-BUILT PLAN AND PROFILE	ENGG. APPR. NO. -
FROM IR KM: 346.500 TO 347.000	DRG. NO. -301-2/AL/A/1319
FROM DFC KM: 1237.378 TO 1237.878	SHEET NO. : 1 OF 1
	DATE : 10.10.2024
	STATUS
	A

TR.

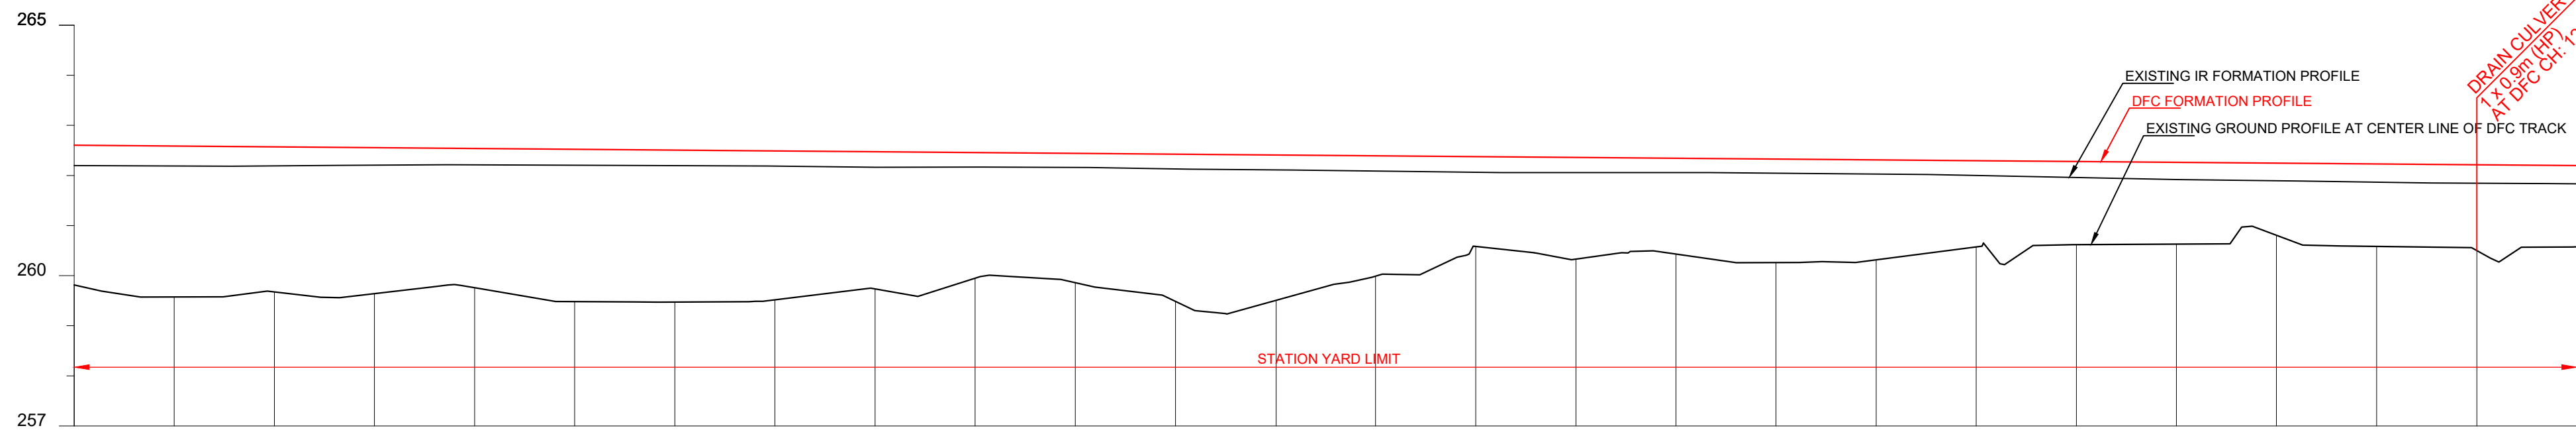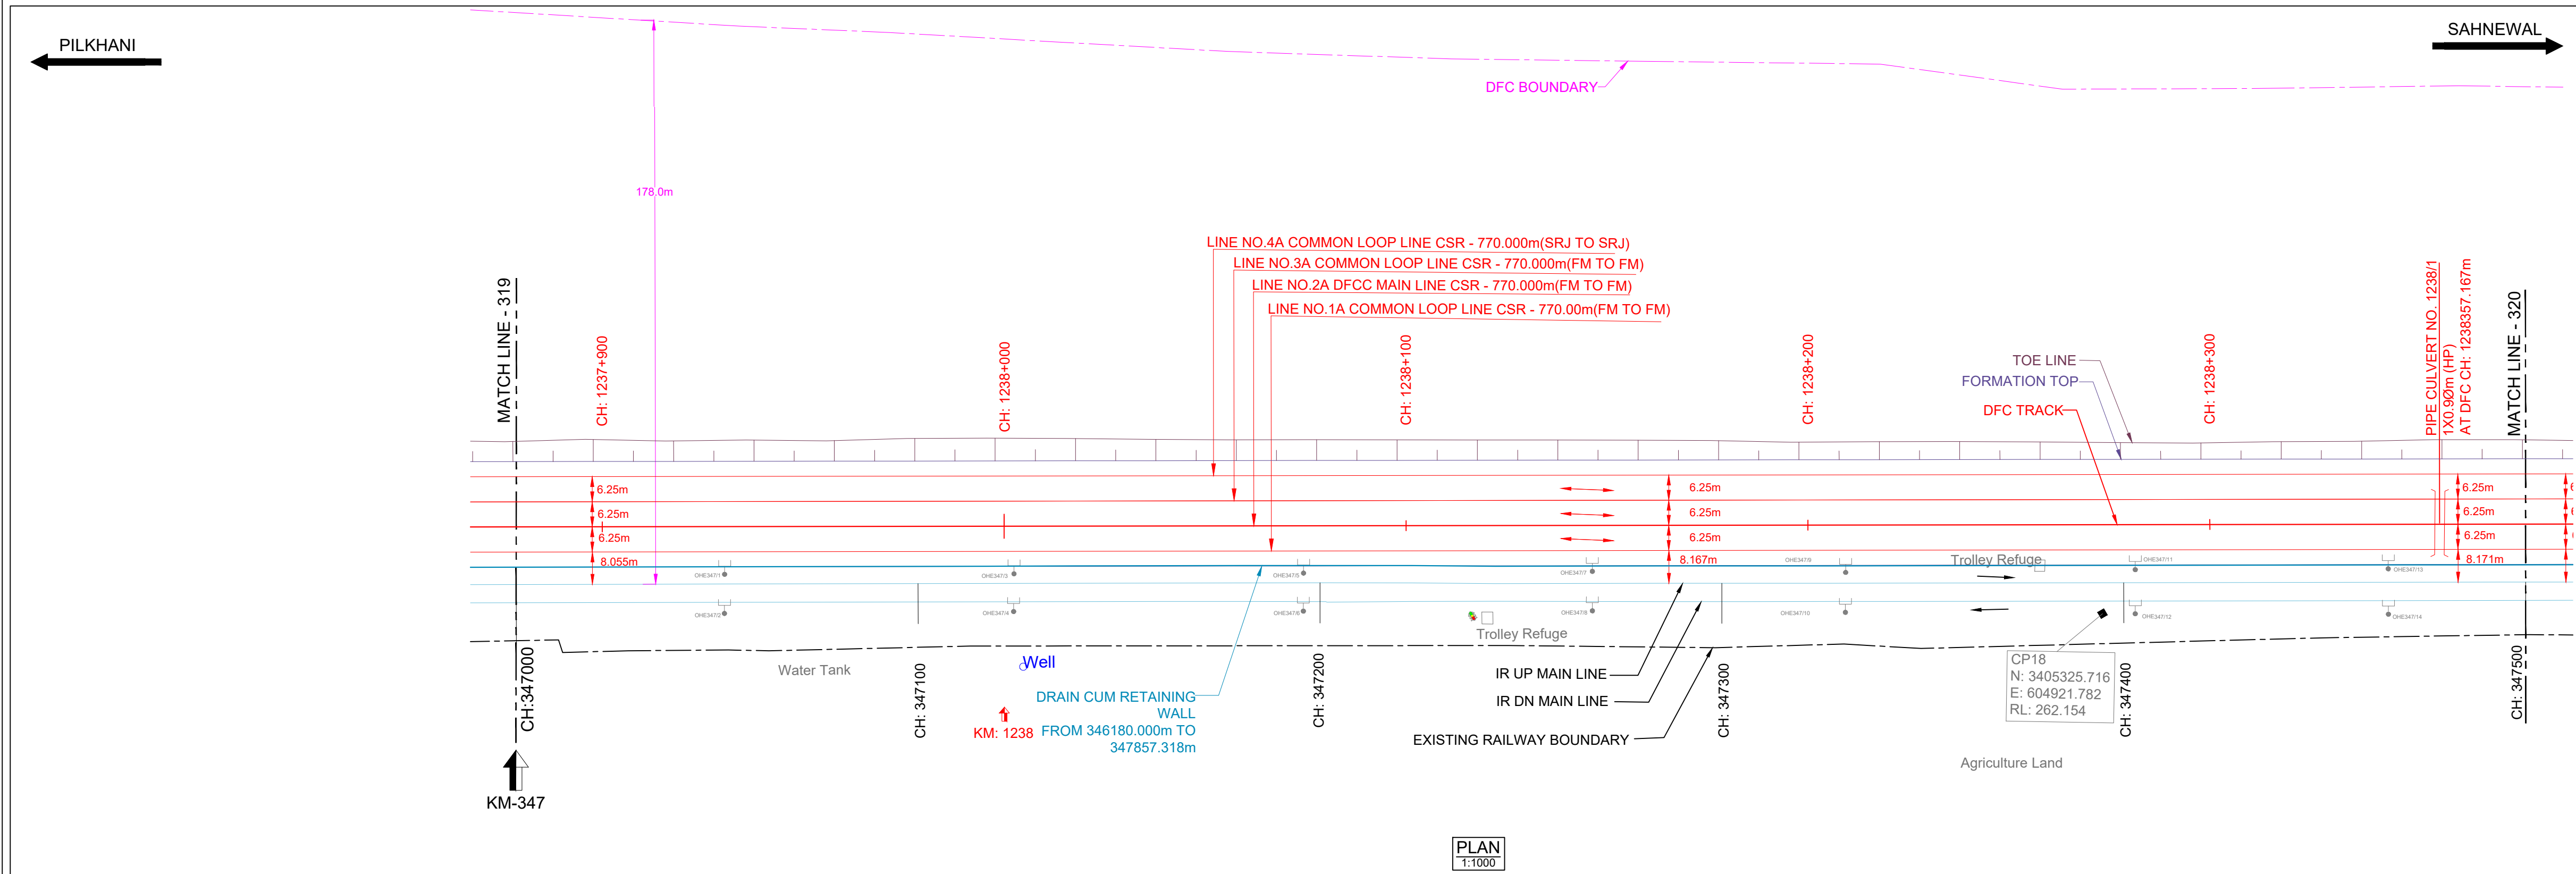

DATUM ABOVE MSL : 257 m

HORIZONTAL ALIGNMENT	L = 3014.655m																			
VERTICAL ALIGNMENT	L=2484.775 m 1 IN 1219.242 F																			
TRACK DISTANCE FROM EXISTING NEAREST IR UP MAIN LINE TO DFC MAIN LINE	14.320	14.304	14.289	14.277	14.264	14.248	14.232	14.212	14.193	14.189	14.184	14.238	14.401	14.426	14.430	14.451	14.453	14.449	14.445	14.440
HEIGHT OF BANKING(+) / DEPTH OF CUTTING(-) (PFL-GL)	+2.792	+3.014	+2.899	+2.914	+2.792	+3.042	+3.033	+2.974	+2.740	+2.507	+2.562	+2.939	+2.902	+2.403	+2.028	+1.911	+2.065	+1.995	+1.719	+1.660
EXG GROUND LEVEL AT CENTER LINE OF DFC TRACK (GL)	259.614	259.575	259.674	259.643	259.756	259.482	259.474	259.517	259.735	259.951	259.960	259.486	259.507	260.592	260.332	260.432	260.262	260.316	260.575	260.618
EXG GROUND LEVEL AT TOE LOCATION OF DFC TRACK	259.950	259.761	259.915	259.834	259.861	259.605	259.577	259.609	259.714	259.792	259.753	259.765	259.781	259.954	259.854	260.053	259.953	260.004	259.997	260.102
DIFFERENCE BETWEEN DFC FORMATION LEVEL AND EXG.FORMATION LEVEL(PFL-EFL)	0.409	0.399	0.381	0.353	0.329	0.320	0.311	0.302	0.311	0.289	0.280	0.295	0.297	0.304	0.302	0.285	0.281	0.282	0.294	0.318
DFC FORMATION LEVEL (PFL)	262.606	262.589	262.573	262.557	262.540	262.524	262.196	262.491	262.475	262.458	262.442	262.425	262.409	262.393	262.360	262.343	262.327	262.311	262.294	262.278
EXG. FORMATION LEVEL OF EXG IR UP MAIN LINE (EFL)	262.197	262.190	262.192	262.204	262.211	262.204	262.166	262.189	262.164	262.169	262.162	262.130	262.112	262.089	262.065	262.058	262.046	262.029	262.000	261.960
DIFFERENCE BETWEEN DFC RAIL LEVEL AND EXG. RAIL LEVEL (PRL - ERL)	0.451	0.441	0.423	0.394	0.371	0.362	0.353	0.344	0.352	0.331	0.322	0.337	0.339	0.345	0.343	0.327	0.323	0.324	0.336	0.360
DFC RAIL LEVEL (PRL)	263.320	263.303	263.287	263.270	263.254	263.238	263.221	263.205	263.188	263.172	263.156	263.139	263.123	263.106	263.074	263.057	263.041	263.024	263.008	262.992
EXG.RAIL LEVEL OF NEAREST IR UP MAIN LINE(ERL)	262.869	262.862	262.864	262.876	262.883	262.876	262.868	262.861	262.836	262.841	262.834	262.802	262.784	262.761	262.730	262.730	262.718	262.701	262.672	262.632
EQUIVALENT CHAINAGE ON DFC TRACK	1237876.0	1237897.9	1237917.9	1237937.9	1237957.9	1237977.9	1238000.0	1238017.9	1238037.9	1238057.9	1238077.9	1238096.0	1238116.1	1238137.9	1238157.9	1238177.9	1238197.9	1238217.9	1238237.9	1238257.9
EXISTING IR CHAINAGE	347000.0	347020.0	347040.0	347060.0	347080.0	347100.0	347120.0	347140.0	347160.0	347180.0	347200.0	347220.0	347240.0	347260.0	347280.0	347300.0	347320.0	347340.0	347360.0	347380.0


L - SECTION

- NOTE:-
- DFCC WORKS ARE SHOWN IN RED.
 - IR NEW WORKS ARE SHOWN IN VIOLET.
 - ALL DIMENSIONS ARE SHOWN IN METRES.
 - THIS DRAWING IS PREPARED BASED ON LATEST SURVEY DATA HELD ON APRIL-2022. GTS BENCH MARK OF 261.85M CONSIDERED ON TOP OF CANAL BRIDGE ABUTMENT AT DORANA VILLAGE ALONG THE NH1.
 - DFC NEW CHAINAGE OF 1075.950M IS WITH REFERENCE TO THE IR KM OF 187.500KM END OF KM OF CP-303(SECTION P-3 PILKHANI END) AGAINST THE EXISTING DFC CHAINAGE. 116277.742M ISSUED VIDE LETTER NO. GCM/DFCC/COMB/SURVEY/2021-301-2301/6-011173 DT. 17.01.2023.
 - BALLAST PROFILE HAS BEEN PROVIDED ACCORDING TO THE CLAUSE 1.11.3 OF STANDARD SCHEDULE OF DIMENSION(EASTERN CORRIDOR) & THE BALLAST CUSHION DIMENSION SHOWN IN 35CM ON GE-14 PARA 17. SPECIFICATIONS & RECOMMENDATIONS 2. TWO LAYER SYSTEM FIG.10.

- REFERENCE DRAWINGS :-
- FOR KEY PLAN REFER DRAWING NO. 301-2/AL/0001
 - FOR LEGEND AND ABBREVIATIONS REFER DRAWING NO. 301-2/AL/1000
 - FOR TYPICAL SECTION OF BALLAST PROFILE (FL-RL) REFFER DRG. NO. 301-2/TK/TFD/-004 (TR. 1952)

REV.	DATE	REVISION DETAILS	PURPOSE OF ISSUE
0	10.10.2024	SUBMISSION OF AS-BUILT DRAWING	FOR APPROVAL

SCALE	LEGEND:
HOR - 1:1000 0 10 20 30 40m 0 1 2 3 4m VER - 1:100 SHEET SIZE : A1	IR TRACK DFCC TRACK DFCC FUTURE PROPOSALS STRUCTURE / BUILDING DFCC TOE LINE DFCC FORMATION RETAINING WALL ROAD STREAM, DRAIN, NALA, CANAL. FENCE POWER LINES TBM ELECTRIC POLE/OHE MAST IR RAILWAY BOUNDARY DFCC BOUNDARY

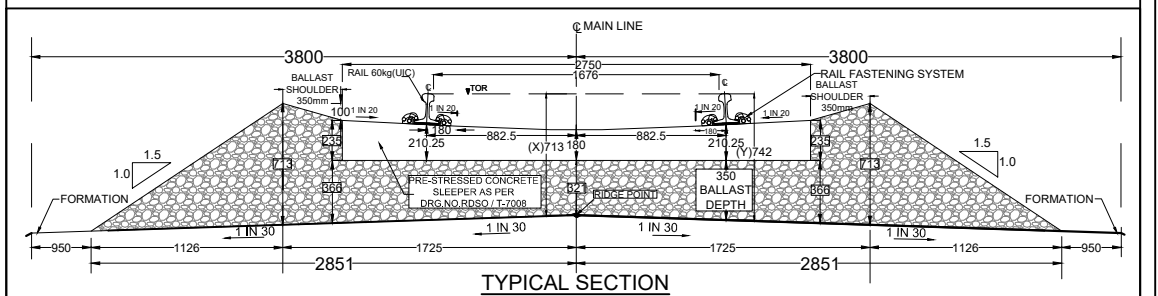

TRACK STRUCTURE		
RAIL SECTION: 60Kg/m (UIC 60Kg/m) DFC LINE: 60Kg/m (UIC 60Kg/m) IR MAIN LINE: 52Kg/m	Difference between FL- RL (Below Rail Seat)	
	IR Line	DFC
RUBBER PAD	172mm	172mm
SLEEPER DEPTH	6mm	10mm
BALLAST CUSHION	210mm	210mm
	300mm	350mm
Total Depth (FL TO RL)	688mm	742mm

OWNER
DEDICATED FREIGHT CORRIDOR CORPORATION OF INDIA LTD.
(A GOVERNMENT OF INDIA ENTERPRISE)
PROJECT OFFICE(AMBALA UNIT): OLD RAILWAY COLONY (NEAR ANAND MARKET),AMBALA CANTT-133001.
CORPORATE IDENTITY NO. : U60232DL2006001150068

ENGINEER:
DB Engineering & Consulting GmbH
Deutsche Bahn Engineering & Consulting GmbH

CONTRACTOR:
GIL - TPL JV
GAR TATA

SUBMITTED BY	GIL - TPL JV		
	DATED	NAME	SIGNATURE
PREPARED BY	10.10.2024	VIJAY PRATAP	
CHECKED BY	10.10.2024	PARASURAM KOTYADA	
APPROVED BY	DEUTSCHE BAHN ENGINEERING & CONSULTING GMBH		
	DATED	NAME	SIGNATURE
Sr. DE./CHIEF ENGINEER		SURESH K.YALANGI	
CHIEF TRACK ENGINEER		RAJ PAL SINGH	
T.L.		H.D. VIDJAK	


STAMP	A AS-BUILT DRAWING TR. Ref:..... ENGINEER Sign.:.....
EMPLOYER (DFCCIL):	DEDICATED FREIGHT CORRIDOR CORPORATION OF INDIA LTD.

AS BUILT DRAWING		
TITLE AS-BUILT PLAN AND PROFILE FROM IR KM: 347.000 TO 347.500 FROM DFC KM: 1237.878 TO 1238.378	DFCC APPR. NO. - ENGG. APPR. NO. - DRG. NO. -301-2/AL/A/1320 SHEET NO. : 1 OF 1 DATE : 10.10.2024	STATUS A

TR.

PILKHANI

SAHNEWAL

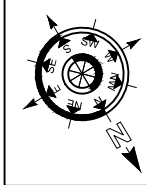

DRG NO. - 301-2/AL/A/1322

NOTE:-

- DFCC WORKS ARE SHOWN IN RED.
- IR NEW WORKS ARE SHOWN IN VIOLET.
- ALL DIMENSIONS ARE SHOWN IN METRES.
- THIS DRAWING IS PREPARED BASED ON LATEST SURVEY DATA HELD ON APRIL-2022. GTS BENCH MARK OF 261.850M CONSIDERED ON TOP OF CANAL BRIDGE ABUTMENT AT DORANA VILLAGE ALONG THE NH1.
- DFC NEW CHAINAGE OF 1075.950M IS WITH REFERENCE TO THE IR KM OF 187.500KM END OF KM OF CP-303(SECTION P-3 PILKHANI END) AGAINST THE EXISTING DFC CHAINAGE. 116277.742M ISSUED VIDE LETTER NO. GOMDFCC/UMBSURVEY/2021-301-230116-011173 DT. 17.01.2023.
- BALLAST PROFILE HAS BEEN PROVIDED ACCORDING TO THE CLAUSE 1.11.3 OF STANDARD SCHEDULE OF DIMENSION(EASTERN CORRIDOR) & THE BALLAST CUSHION DIMENSION SHOWN IN 35CM ON GE-14 PARA 17. SPECIFICATIONS & RECOMMENDATIONS 2. TWO LAYER SYSTEM FIG.10.

REFERENCE DRAWINGS :-

- FOR KEY PLAN REFER DRAWING NO. 301-2/AL/0001
- FOR LEGEND AND ABBREVIATIONS REFER DRAWING NO. 301-2/AL/1000
- FOR TYPICAL SECTION OF BALLAST PROFILE (FL-RL) REFFER DRG. NO. 301-2/TK/TFD/-004 (TR. 1952)

REV.	DATE	REVISION DETAILS	PURPOSE OF ISSUE
0	10.10.2024	SUBMISSION OF AS-BUILT DRAWING	FOR APPROVAL

SCALE

HOR - 1:1000

VER - 1:100

SHEET SIZE : A1

LEGEND:

IR TRACK

DFCC TRACK

DFCC FUTURE PROPOSALS

STRUCTURE / BUILDING

DFCC TOE LINE

DFCC FORMATION

RETAINING WALL

ROAD

STREAM, DRAIN, NALA, CANAL.

FENCE


POWER LINES

TBM

ELECTRIC POLE/OHE MAST

IR RAILWAY BOUNDARY

DFCC BOUNDARY

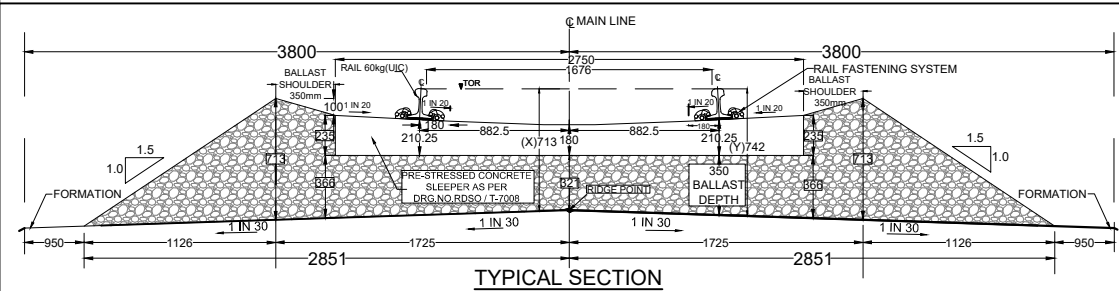

TRACK STRUCTURE		
RAIL SECTION: 60Kg/m (UIC 60Kg/m) DFC LINE: 60Kg/m (UIC 60Kg/m) IR MAIN LINE: 52Kg/m	Difference between FL - RL (Below Rail Seat)	
	IR Line	DFC
RUBBER PAD	172mm	172mm
SLEEPER DEPTH	210mm	210mm
BALLAST CUSHION	300mm	350mm
Total Depth (FL TO RL)	688mm	742mm

OWNER

DEDICATED FREIGHT CORRIDOR CORPORATION OF INDIA LTD.

(A GOVERNMENT OF INDIA ENTERPRISE)

PROJECT OFFICE(AMBALA UNIT): OLD RAILWAY COLONY (NEAR ANAND MARKET), AMBALA CANTT-133001.

CORPORATE IDENTITY NO. : U60232DL2006GGI155068

ENGINEER:

DB Engineering & Consulting GmbH

Deutsche Bahn Engineering & Consulting GmbH

CONTRACTOR:

GIL - TPL JV

GAR TATA

SUBMITTED BY	GIL - TPL JV		
	DATED	NAME	SIGNATURE
PREPARED BY			
CHECKED BY	10.10.2024	VIJAY PRATAP	
APPROVED BY	10.10.2024	PARASURAM KOTYADA	

APPROVED BY	DEUTSCHE BAHN ENGINEERING & CONSULTING GMBH		
	DATED	NAME	SIGNATURE
Sr. DE./CHIEF ENGINEER		SURESH K.YALANGI	
CHIEF TRACK ENGINEER		RAJ PAL SINGH	
T.L.		H.D. VIDJAK	

STAMP

A AS-BUILT DRAWING
TR. Ref.:.....
ENGINEER Sign.:.....



EMPLOYER (DFCCIL):

DEDICATED FREIGHT CORRIDOR CORPORATION OF INDIA LTD.

AS BUILT DRAWING


TITLE	DFCC APPR. NO. -	STATUS A
AS-BUILT PLAN AND PROFILE	ENGG. APPR. NO. -	
FROM IR KM: 348.000 TO 348.500	DRG. NO. -301-2/AL/A/1322	
FROM DFC KM: 1238.852 TO 1239.352	SHEET NO. : 1 OF 1	
	DATE : 10.10.2024	

TR.

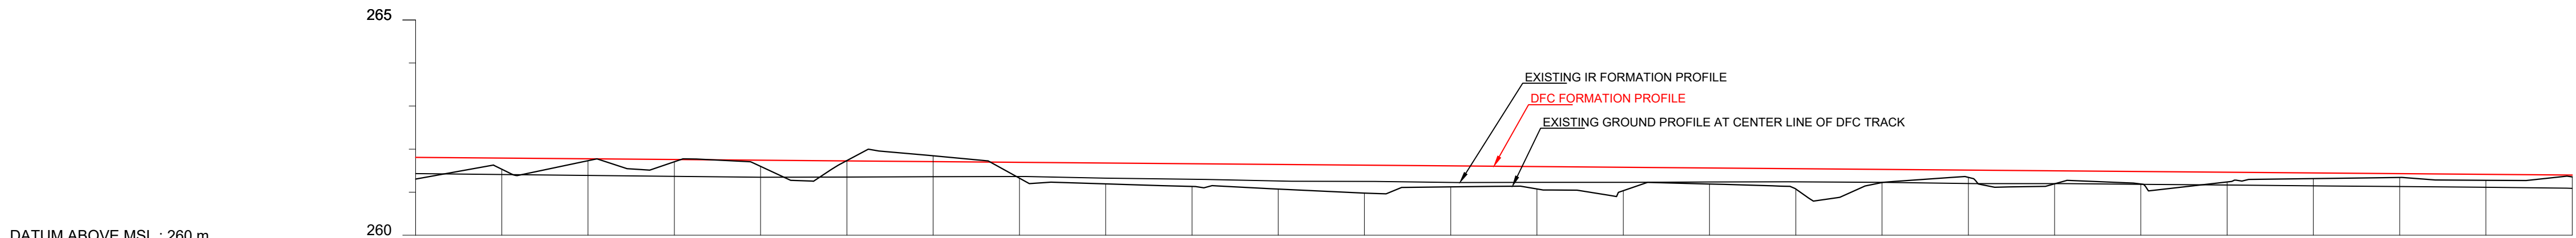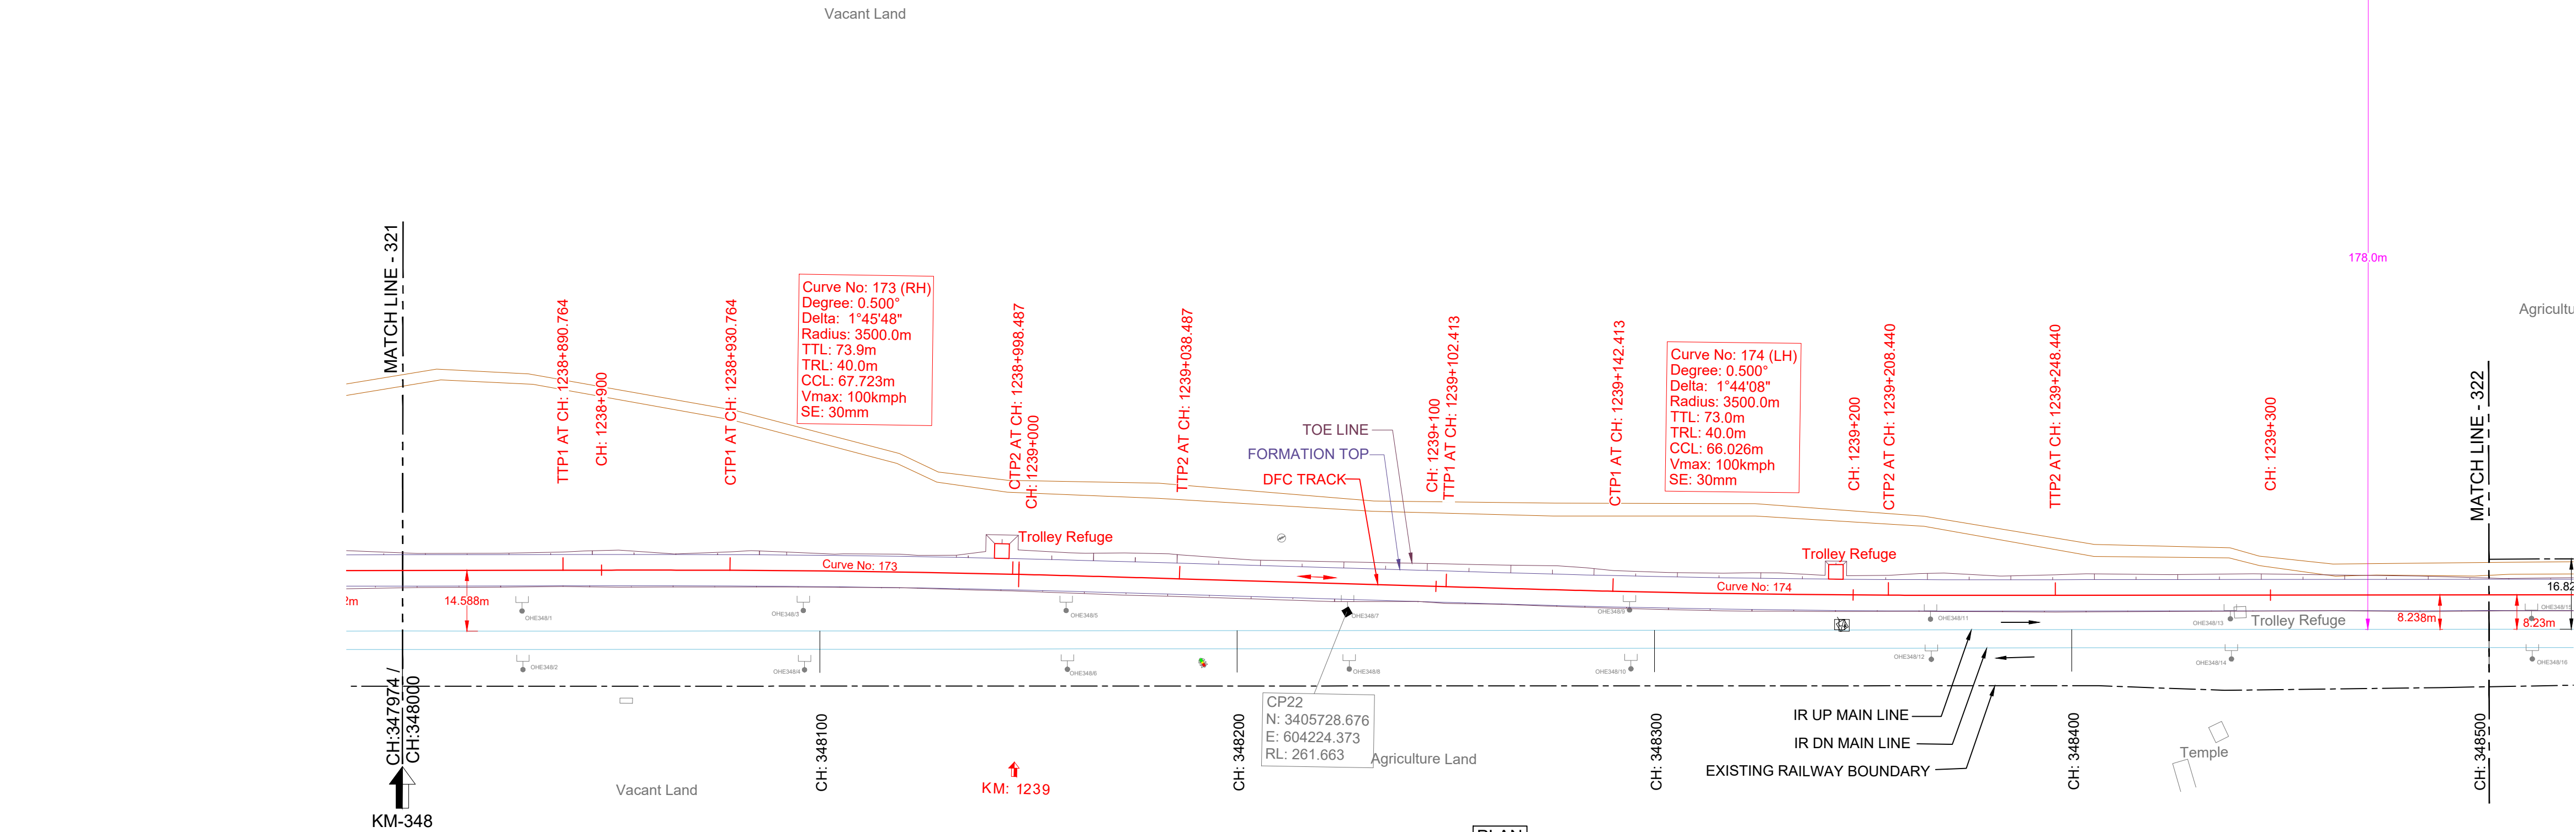

HORIZONTAL ALIGNMENT	L = 3014.655m TL= 40m R =3500m TL= 40m L = 63.925m TL= 40m R =-3500m TL= 40m L = 4280.337m																									
VERTICAL ALIGNMENT	L=2484.775 m 1 IN 1219.242 F																									
TRACK DISTANCE FROM EXISTING NEAREST IR UP MAIN LINE TO DFC MAIN LINE	14.535	14.593	14.612	14.618	14.554	14.399	14.131	13.721	13.199	12.617	12.019	11.409	10.798	10.195	9.622	9.127	8.744	8.469	8.311	8.247	8.231	8.221	8.211	8.224	8.242	8.233
HEIGHT OF BANKING(+)/ DEPTH OF CUTTING(-) (PFL-GL)	+0.506	+0.254	+0.045	+0.056	+0.139	-0.006	-0.136	+0.364	+0.484	+0.528	+0.573	+0.649	+0.488	+0.519	+0.542	+0.372	+0.473	+0.304	+0.167	+0.302	+0.290	+0.227	+0.133	+0.088	+0.137	+0.044
EXG GROUND LEVEL AT CENTER LINE OF DFC TRACK (GL)	261.301	261.537	261.729	261.702	261.603	261.731	261.845	261.328	261.192	261.132	261.070	260.978	261.122	261.075	261.035	261.189	261.072	261.224	261.345	261.193	261.189	261.236	261.313	261.342	261.276	261.353
EXG GROUND LEVEL AT TOE LOCATION OF DFC TRACK	261.300	261.526	261.778	261.849	261.793	261.735	261.697	261.443	261.234	261.098	261.035	260.902	261.122	261.041	260.620	260.996	261.006	261.072	260.788	260.866	260.746	260.757	260.634	260.753	260.884	261.137
DIFFERENCE BETWEEN DFC FORMATION LEVEL AND EXG.FORMATION LEVEL.(PFL-EFL)	0.376	0.381	0.385	0.390	0.394	0.373	0.352	0.330	0.353	0.360	0.385	0.378	0.383	0.367	0.349	0.326	0.304	0.302	0.314	0.299	0.295	0.296	0.299	0.298	0.299	0.308
DFC FORMATION LEVEL (PFL)	261.807	261.791	261.774	261.758	261.741	261.725	261.709	261.692	261.676	261.659	261.643	261.627	261.610	261.594	261.577	261.561	261.545	261.528	261.512	261.495	261.479	261.463	261.446	261.430	261.413	261.397
EXG. FORMATION LEVEL OF EXG IR UP MAIN LINE (EFL)	261.431	261.410	261.389	261.368	261.347	261.352	261.357	261.362	261.323	261.299	261.258	261.249	261.227	261.227	261.228	261.235	261.241	261.226	261.198	261.196	261.184	261.167	261.147	261.132	261.114	261.089
DIFFERENCE BETWEEN DFC RAIL LEVEL AND EXG. RAIL LEVEL (PRL - ERL)	0.418	0.422	0.427	0.432	0.436	0.415	0.393	0.372	0.395	0.402	0.427	0.420	0.425	0.408	0.391	0.367	0.345	0.344	0.355	0.341	0.337	0.338	0.341	0.339	0.341	0.350
DFC RAIL LEVEL (PRL)	262.521	262.505	262.488	262.472	262.455	262.439	262.423	262.406	262.390	262.373	262.357	262.341	262.324	262.308	262.291	262.275	262.258	262.242	262.226	262.209	262.193	262.176	262.160	262.144	262.127	262.111
EXG.RAIL LEVEL OF NEAREST IR UP MAIN LINE(ERL)	262.103	262.082	262.061	262.040	262.019	262.024	262.029	262.034	261.995	261.971	261.930	261.921	261.889	261.889	261.900	261.907	261.913	261.898	261.870	261.868	261.856	261.839	261.819	261.804	261.786	261.761
EQUIVALENT CHAINAGE ON DFC TRACK	1238851.7	1238871.7	1238891.7	1238911.7	1238931.7	1238951.7	1238971.7	1238991.7	1239011.7	1239031.7	1239051.7	1239071.7	1239091.7	1239111.7	1239131.7	1239151.7	1239171.7	1239191.7	1239211.7	1239231.7	1239251.7	1239271.7	1239291.7	1239311.7	1239331.7	1239351.7
EXISTING IR CHAINAGE	348000.0	348020.0	348040.0	348060.0	348080.0	348100.0	348120.0	348140.0	348160.0	348180.0	348200.0	348220.0	348240.0	348260.0	348280.0	348300.0	348320.0	348340.0	348360.0	348380.0	348400.0	348420.0	348440.0	348460.0	348480.0	348500.0

L - SECTION

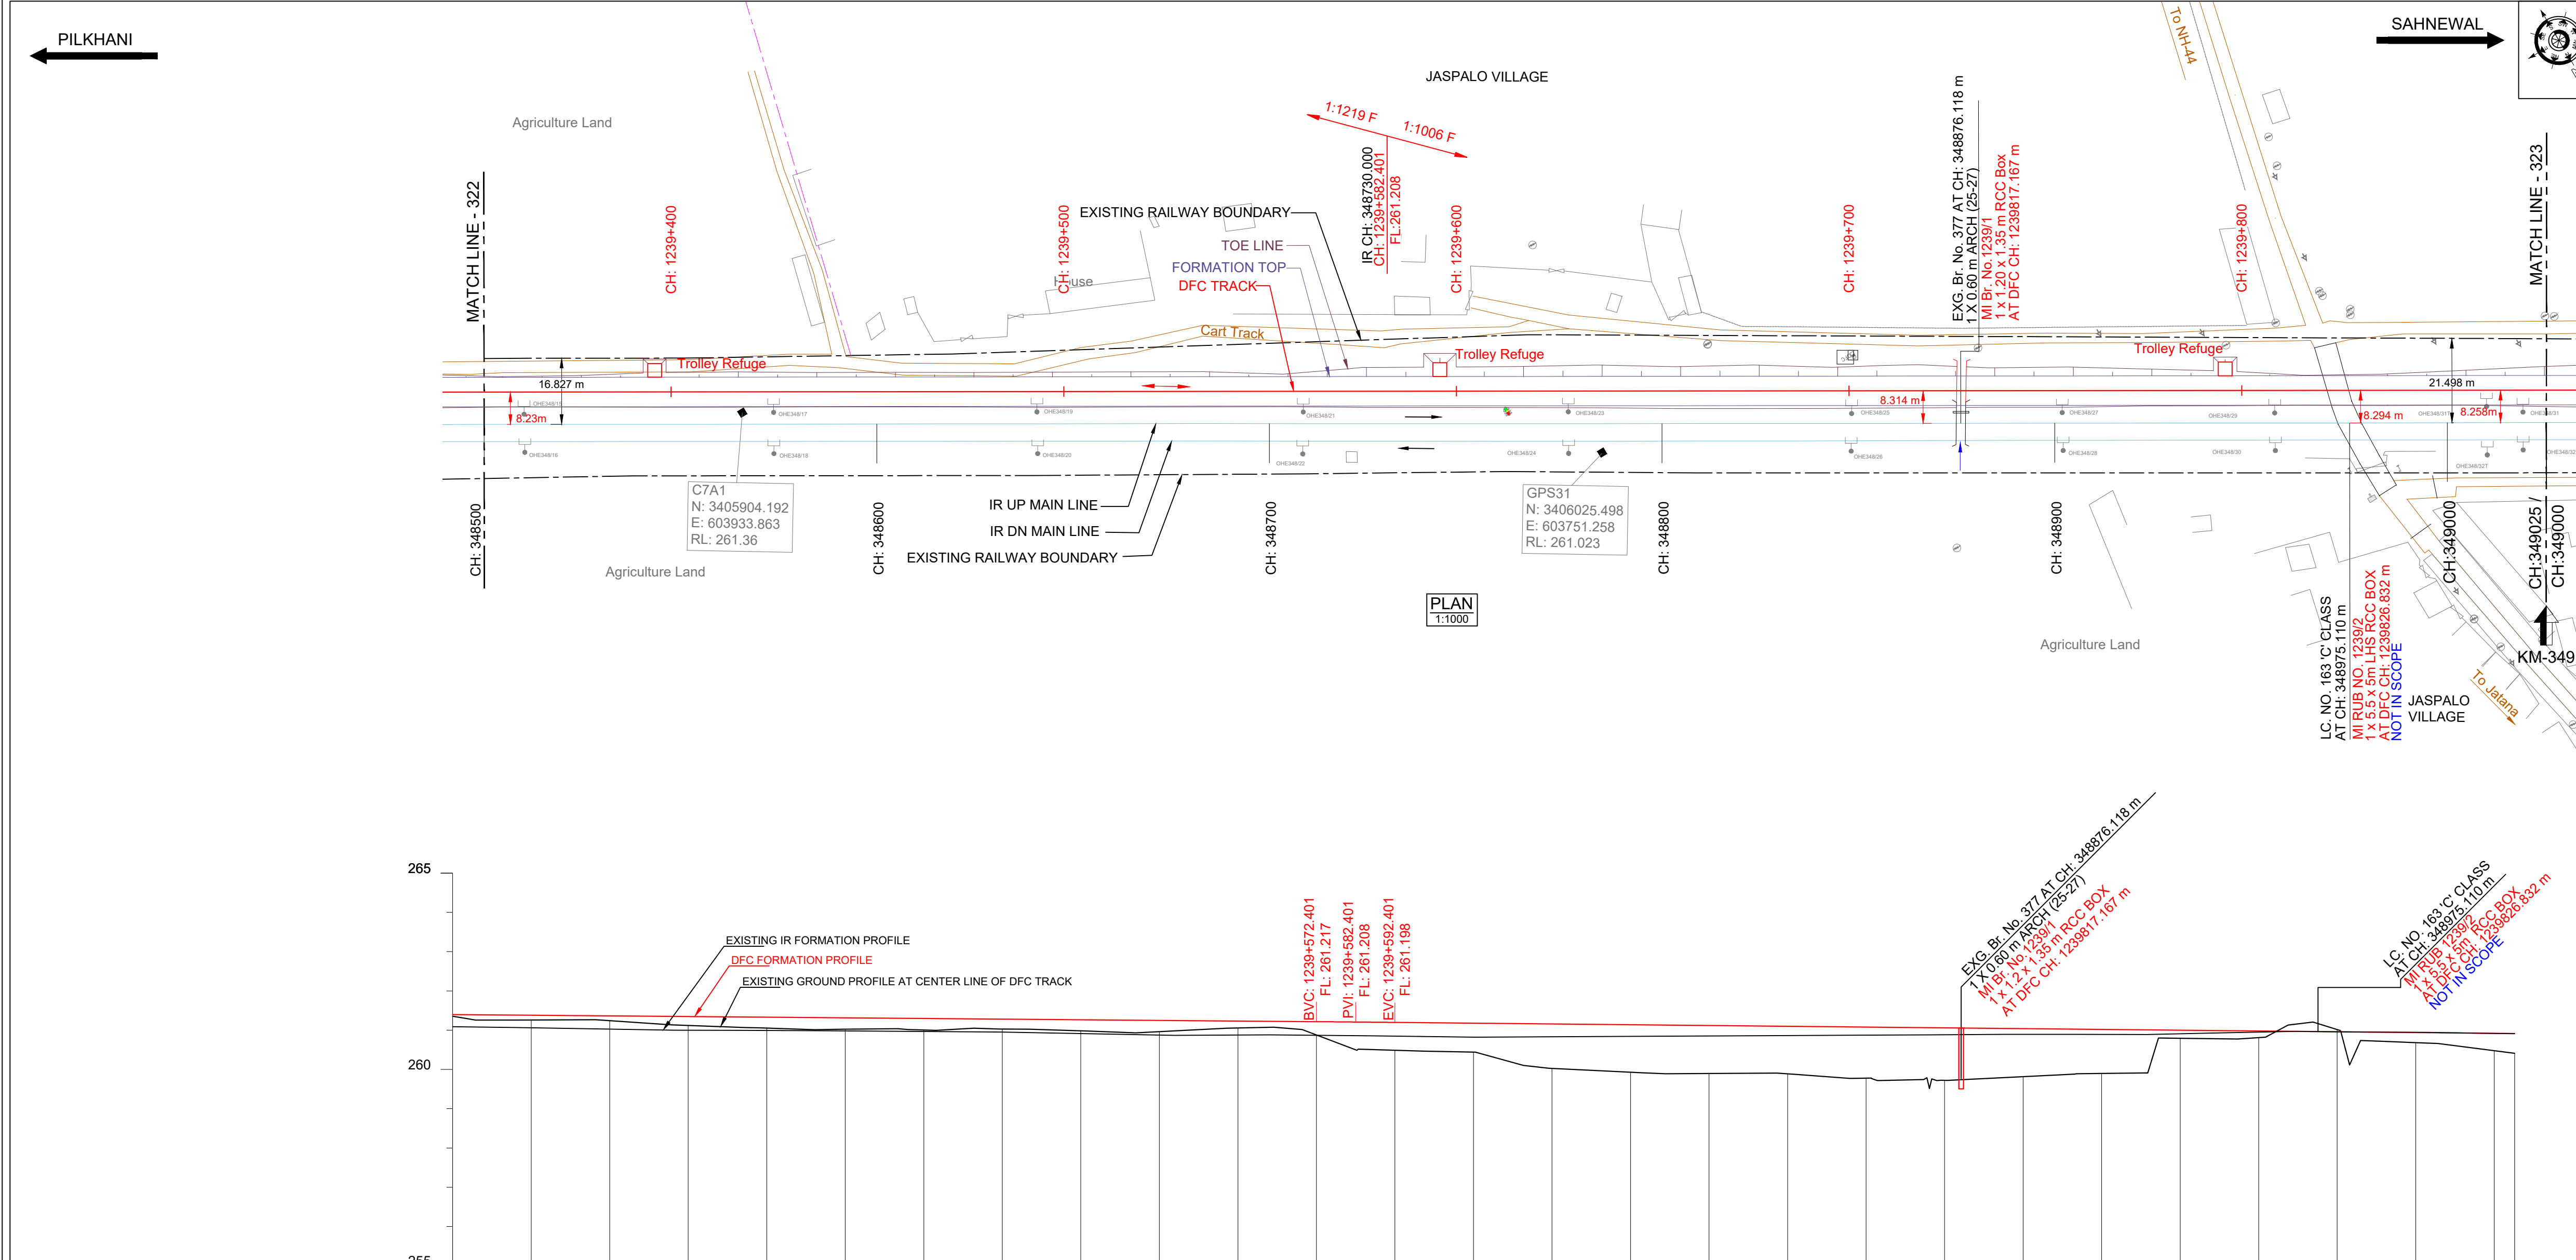

HORIZONTAL ALIGNMENT	L = 4280.337m																			
VERTICAL ALIGNMENT	L=2484.775 m 1 IN 1219.242 F L=20.0 m R=115033m L=1612.829 m 1 IN 1005.990 F																			
TRACK DISTANCE FROM EXISTING NEAREST IR UP MAIN LINE TO DFC MAIN LINE	8.233	8.227	8.242	8.249	8.235	8.224	8.214	8.204	8.196	8.188	8.221	8.250	8.269	8.288	8.297	8.306	8.315	8.324	8.329	8.307
HEIGHT OF BANKING(+) / DEPTH OF CUTTING(-) (PFL-GL)	+0.044	+0.123	+0.122	+0.228	+0.278	+0.288	+0.293	+0.255	+0.283	+0.287	+0.176	+0.340	+0.710	+0.738	+1.131	+1.210	+1.222	+1.210	+1.301	+1.338
EXG GROUND LEVEL AT CENTER LINE OF DFC TRACK (GL)	-261.353	-261.258	-261.242	-261.120	-261.053	-261.027	-261.006	-261.027	-260.983	-260.982	-261.057	-260.877	-260.488	-260.441	-260.028	-259.929	-259.897	-259.886	-260.795	-260.811
EXG GROUND LEVEL AT TOE LOCATION OF DFC TRACK	-261.137	-261.107	-260.744	-260.565	-260.638	-260.604	-260.629	-260.584	-260.554	-260.441	-260.801	-260.132	-259.916	-259.783	-259.552	-259.801	-259.315	-259.862	-260.179	-260.773
DIFFERENCE BETWEEN DFC FORMATION LEVEL AND EXG.FORMATION LEVEL (PFL-EFL)	0.308	0.320	0.336	0.351	0.339	0.333	0.333	0.331	0.352	0.373	0.356	0.349	0.352	0.359	0.329	0.298	0.268	0.237	0.092	0.030
DFC FORMATION LEVEL (PFL)	-261.397	-261.381	-261.364	-261.348	-261.331	-261.315	-261.299	-261.282	-261.266	-261.249	-261.233	-261.217	-261.198	-261.179	-261.159	-261.139	-261.119	-261.099	-261.020	-260.980
EXG. FORMATION LEVEL OF EXG IR UP MAIN LINE (EFL)	-261.089	-261.061	-261.028	-260.997	-260.992	-260.982	-260.966	-260.951	-260.914	-260.876	-260.877	-260.868	-260.846	-260.820	-260.830	-260.841	-260.851	-260.862	-260.908	-260.950
DIFFERENCE BETWEEN DFC RAIL LEVEL AND EXG. RAIL LEVEL (PRL - ERL)	0.350	0.362	0.378	0.392	0.382	0.375	0.374	0.373	0.394	0.415	0.398	0.390	0.393	0.400	0.370	0.339	0.309	0.278	0.133	0.071
DFC RAIL LEVEL (PRL)	-262.111	-262.094	-262.078	-262.062	-262.045	-262.029	-262.012	-261.996	-261.980	-261.963	-261.947	-261.930	-261.912	-261.892	-261.872	-261.852	-261.832	-261.812	-261.713	-261.683
EXG.RAIL LEVEL OF NEAREST IR UP MAIN LINE(ERL)	-261.761	-261.733	-261.700	-261.689	-261.684	-261.654	-261.638	-261.623	-261.586	-261.548	-261.549	-261.540	-261.518	-261.492	-261.502	-261.513	-261.523	-261.534	-261.580	-261.630
EQUIVALENT CHAINAGE ON DFC TRACK	-1239351.7	-1239371.7	-1239391.7	-1239411.7	-1239431.7	-1239451.7	-1239471.7	-1239491.7	-1239511.7	-1239531.7	-1239551.7	-1239571.7	-1239591.7	-1239611.7	-1239631.7	-1239651.7	-1239671.7	-1239691.7	-1239711.7	-1239731.7
EXISTING IR CHAINAGE	348500.0	348520.0	348540.0	348560.0	348580.0	348600.0	348620.0	348640.0	348660.0	348680.0	348700.0	348720.0	348740.0	348760.0	348780.0	348800.0	348820.0	348840.0	348860.0	348880.0

L - SECTION

NOTE:-
1. DFCC WORKS ARE SHOWN IN RED.
2. IR NEW WORKS ARE SHOWN IN VIOLET.
3. ALL DIMENSIONS ARE SHOWN IN METRES.
4. THIS DRAWING IS PREPARED BASED ON LATEST SURVEY DATA HELD ON APRIL-2022. GTS BENCH MARK OF 261.850M CONSIDERED ON TOP OF CANAL BRIDGE ABUTMENT AT DORAHA VILLAGE ALONG THE NH1.
5. DFC NEW CHAINAGE OF 1075.950M IS WITH REFERENCE TO THE IR KM OF 187.500KM END OF KM OF CP-303(SECTION P-3 PILKHANI END) AGAINST THE EXISTING DFC CHAINAGE. 116277.742M ISSUED VIDE LETTER NO. GCM/DFCC/UMBS/SURVEY/2021-301-230116-011173 DT. 17.01.2023.
6. BALLAST PROFILE HAS BEEN PROVIDED ACCORDING TO THE CLAUSE 1.11.3 OF STANDARD SCHEDULE OF DIMENSION(EASTERN CORRIDOR) & THE BALLAST CUSHION DIMENSION SHOWN IN 35CM ON GE-14 PARA 17. SPECIFICATIONS & RECOMMENDATIONS 2. TWO LAYER SYSTEM FIG.10.


REFERENCE DRAWINGS :-
1. FOR KEY PLAN REFER DRAWING NO. 301-2/AL/0001
2. FOR LEGEND AND ABBREVIATIONS REFER DRAWING NO. 301-2/AL/1000
3. FOR TYPICAL SECTION OF BALLAST PROFILE (FL-RL) REFER DRG. NO. 301-2/TK/TFD/-004 (TR.1952)

010.10.2024SUBMISSION OF AS-BUILT DRAWINGFOR APPROVAL

REV. DATE REVISION DETAILS PURPOSE OF ISSUE

SCALE
HOR - 1:1000
VER - 1:100
SHEET SIZE : A1

LEGEND:
IR TRACK
DFCC TRACK
DFCC FUTURE PROPOSALS
STRUCTURE / BUILDING
DFCC TOE LINE
DFCC FORMATION
RETAINING WALL
ROAD
STREAM, DRAIN, NALA, CANAL.
FENCE
POWER LINES
TBM
ELECTRIC POLE/OHE MAST
IR RAILWAY BOUNDARY
DFCC BOUNDARY

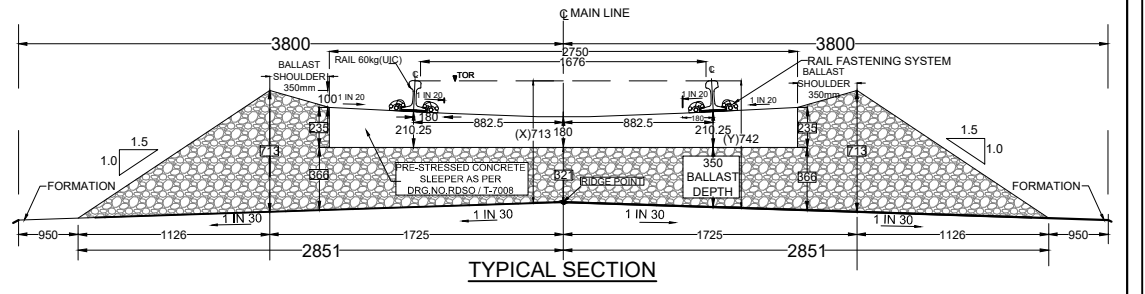

TRACK STRUCTURE		
RAIL SECTION: 60Kg/m (UIC 60Kg/m) DFC LINE: 60Kg/m (UIC 60Kg/m) IR MAIN LINE: 52Kg/m	Difference between FL- RL (Below Rail Seat)	
	IR Line	DFC
RUBBER PAD	172mm	172mm
SLEEPER DEPTH	6mm	10mm
BALLAST CUSHION	210mm	210mm
	300mm	350mm
Total Depth (FL TO RL)	688mm	742mm

OWNER
DEDICATED FREIGHT CORRIDOR CORPORATION OF INDIA LTD.
(A GOVERNMENT OF INDIA ENTERPRISE)
PROJECT OFFICE(AMBALA UNIT): OLD RAILWAY COLONY (NEAR ANAND MARKET),AMBALA CANTT-133001.
CORPORATE IDENTITY NO : U60232DL2006001150068

ENGINEER:
DB Engineering & Consulting GmbH
Deutsche Bahn Engineering & Consulting GmbH

CONTRACTOR:
GIL - TPL JV
GAR TATA

SUBMITTED BY	GIL - TPL JV		
	DATED	NAME	SIGNATURE
PREPARED BY	10.10.2024	VIJAY PRATAP	
CHECKED BY	10.10.2024	PARASURAM KOTYADA	
APPROVED BY	10.10.2024	PARASURAM KOTYADA	

APPROVED BY	DEUTSCHE BAHN ENGINEERING & CONSULTING GMBH		
	DATED	NAME	SIGNATURE
Sr. DE./CHIEF ENGINEER		SURESH K.YALANGI	
CHIEF TRACK ENGINEER		RAJ PAL SINGH	
T.L.		H.D. VIDJAK	



STAMP

A

AS-BUILT DRAWING
TR. Ref.:.....
ENGINEER Sign.:.....

EMPLOYER (DFCCIL): DEDICATED FREIGHT CORRIDOR CORPORATION OF INDIA LTD.

AS BUILT DRAWING		
TITLE	AS-BUILT PLAN AND PROFILE	DFCC APPR. NO. -
	FROM IR KM: 348.500 TO 349.000	ENGG. APPR. NO. -
	FROM DFC KM: 1239.352 TO 1239.877	DRG. NO. : 301-2/AL/A/1323
		SHEET NO. : 1 OF 1
		DATE : 10.10.2024
		STATUS
		A

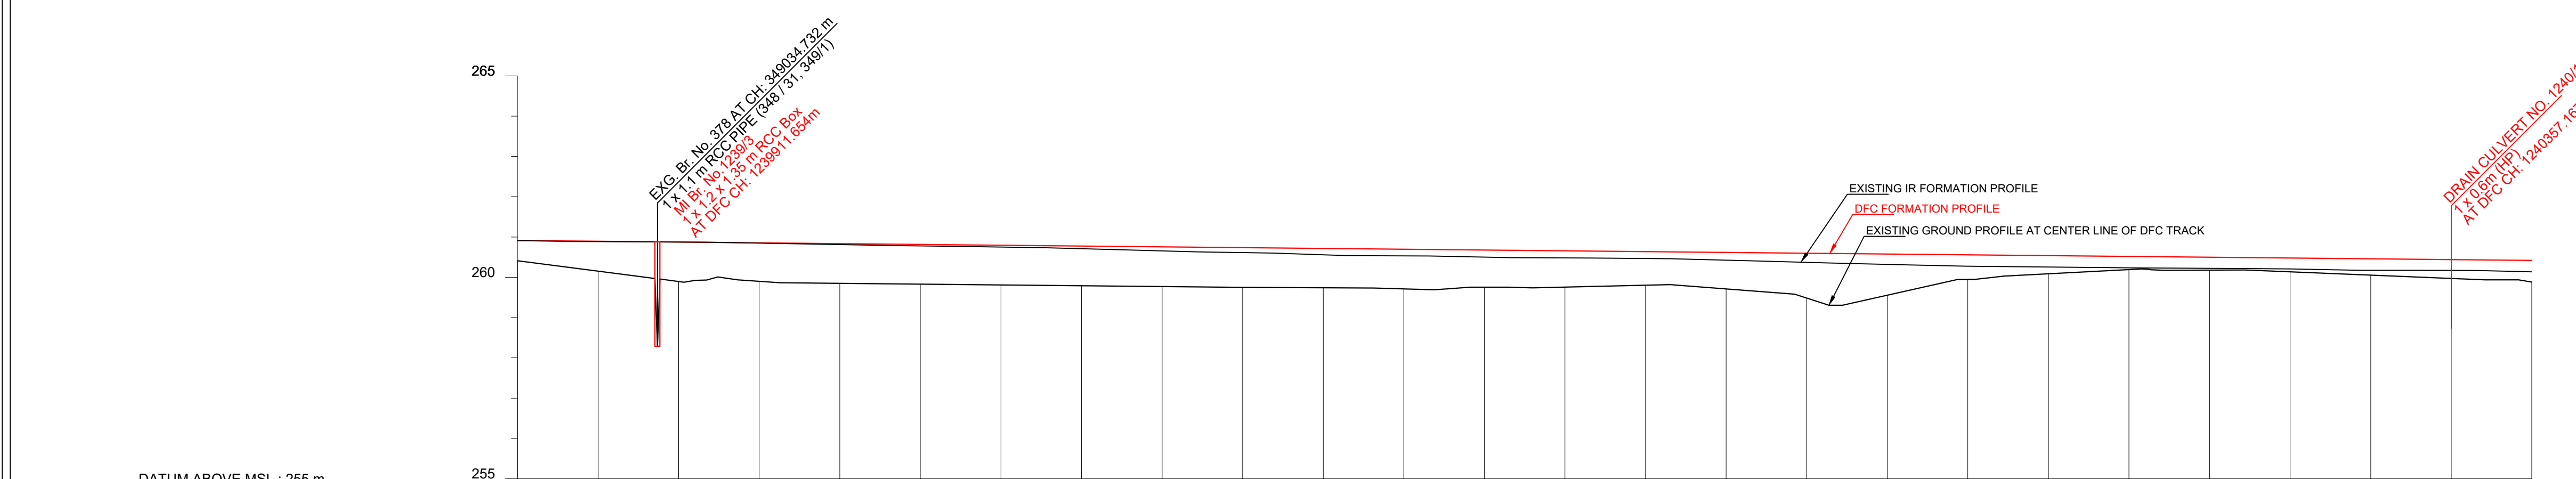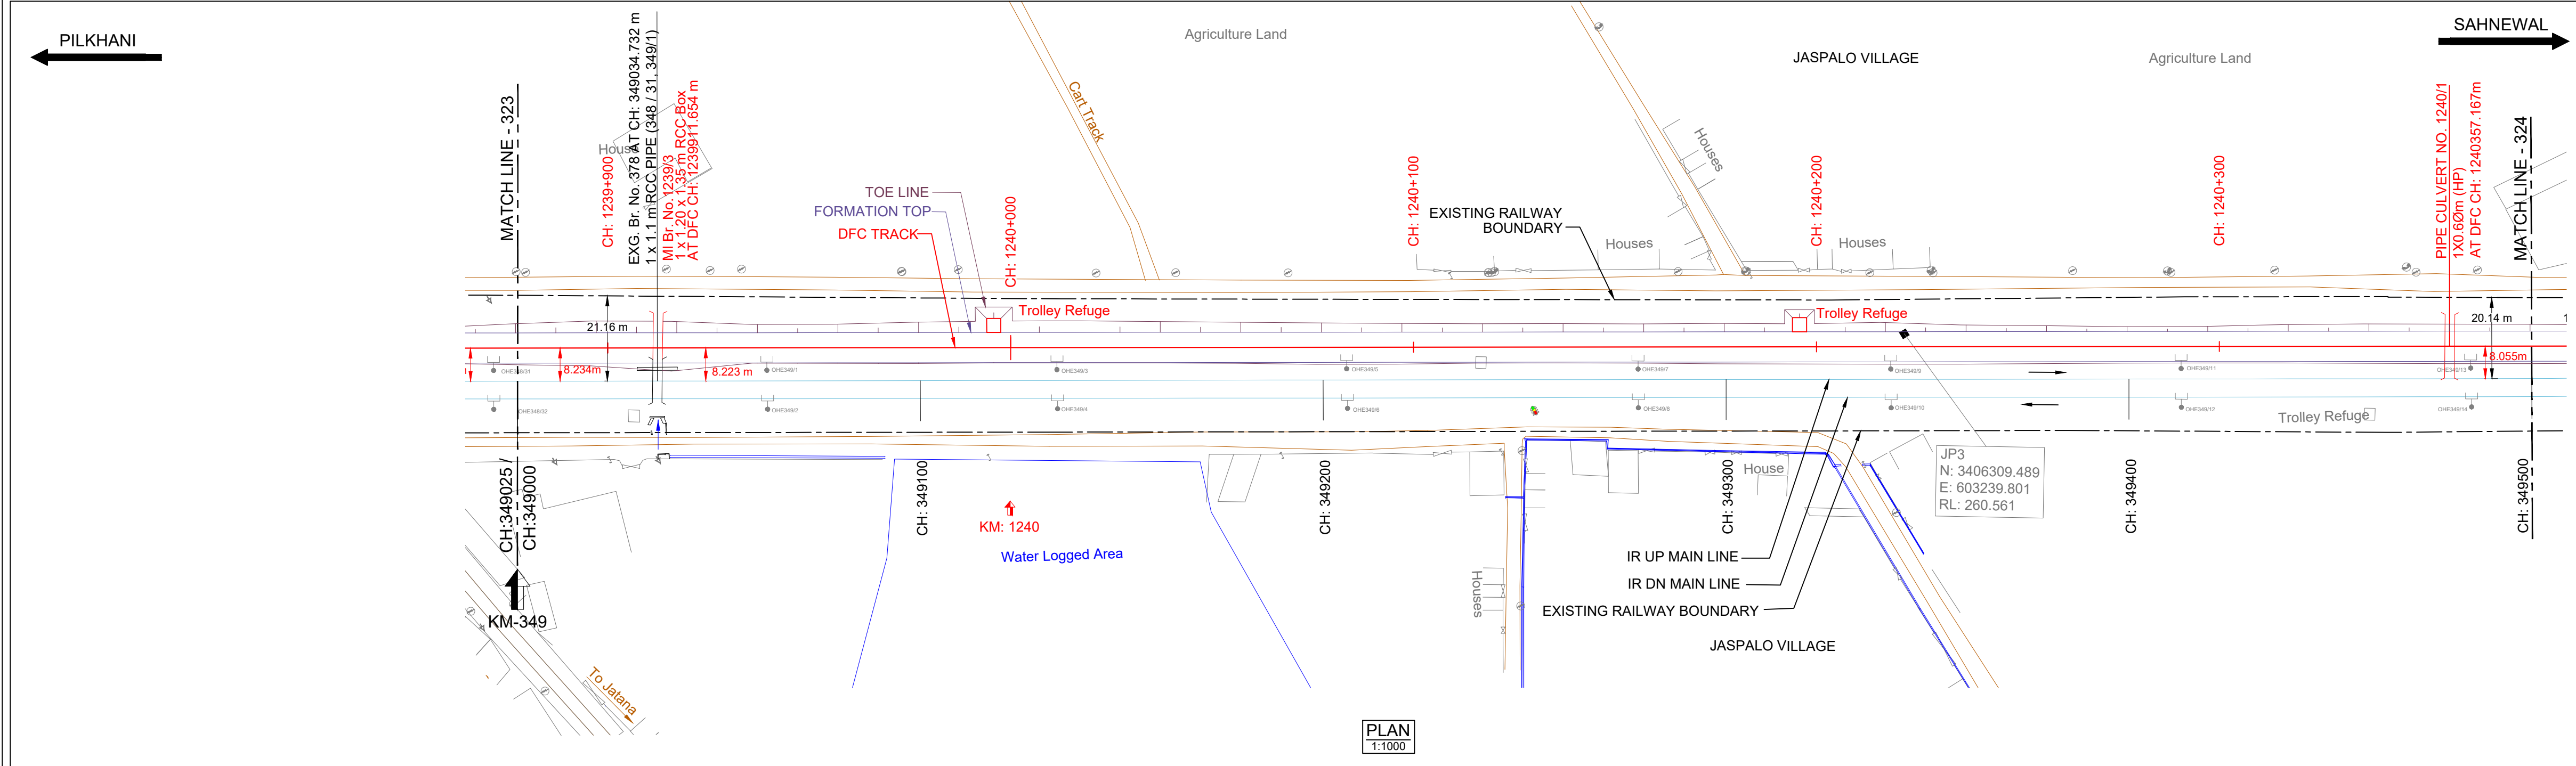

HORIZONTAL ALIGNMENT	L = 4280.337m																			
VERTICAL ALIGNMENT	L=1612.829 m 1 IN 1005.990 F																			
TRACK DISTANCE FROM EXISTING NEAREST IR UP MAIN LINE TO DFC MAIN LINE	8.246	8.228	8.225	8.217	8.208	8.196	8.180	8.160	8.133	8.119	8.112	8.108	8.102	8.099	8.098	8.097	8.096	8.095	8.094	8.023
HEIGHT OF BANKING(+) / DEPTH OF CUTTING(-) (PFL-GL)	+0.505	+0.742	+0.979	+0.956	+0.986	+0.987	+0.986	+0.986	+0.986	+0.985	+0.976	+0.985	+0.921	+0.899	+0.894	+0.905	+0.325	+0.319	+0.467	+0.538
EXG GROUND LEVEL AT CENTER LINE OF DFC TRACK (GL)	260.410	260.153	259.896	259.899	259.849	259.829	259.810	259.790	259.770	259.751	259.740	259.711	259.755	259.757	259.803	259.712	259.834	260.192	260.053	259.971
EXG GROUND LEVEL AT TOE LOCATION OF DFC TRACK	259.658	259.316	259.361	259.786	259.674	259.413	259.267	259.230	259.318	259.389	259.460	259.525	259.539	259.513	259.537	259.482	259.630	259.769	259.535	259.462
DIFFERENCE BETWEEN DFC FORMATION LEVEL AND EXG.FORMATION LEVEL (PFL-EFL)	0.007	0.008	-0.001	0.007	0.022	0.037	0.046	0.065	0.100	0.123	0.158	0.165	0.177	0.175	0.170	0.193	0.282	0.276	0.270	0.267
DFC FORMATION LEVEL (PFL)	260.915	260.895	260.875	260.855	260.835	260.816	260.796	260.776	260.756	260.736	260.716	260.696	260.676	260.656	260.637	260.617	260.597	260.577	260.557	260.418
EXG. FORMATION LEVEL OF EXG IR UP MAIN LINE (EFL)	260.908	260.887	260.876	260.848	260.813	260.779	260.750	260.711	260.656	260.613	260.558	260.531	260.499	260.481	260.467	260.424	260.371	260.321	260.273	260.135
DIFFERENCE BETWEEN DFC RAIL LEVEL AND EXG. RAIL LEVEL (PRL - ERL)	0.048	0.049	0.040	0.048	0.064	0.078	0.087	0.106	0.141	0.165	0.199	0.206	0.218	0.217	0.211	0.234	0.267	0.297	0.325	0.324
DFC RAIL LEVEL (PRL)	261.528	261.608	261.588	261.569	261.549	261.529	261.509	261.489	261.469	261.449	261.429	261.410	261.390	261.370	261.350	261.330	261.310	261.290	261.270	261.131
EXG.RAIL LEVEL OF NEAREST IR UP MAIN LINE(ERL)	261.580	261.559	261.548	261.520	261.485	261.451	261.422	261.383	261.328	261.285	261.230	261.203	261.171	261.153	261.139	261.096	261.043	260.993	260.945	260.807
EQUIVALENT CHAINAGE ON DFC TRACK	349000.0	349020.0	349040.0	349060.0	349080.0	349100.0	349120.0	349140.0	349160.0	349180.0	349200.0	349220.0	349240.0	349260.0	349280.0	349300.0	349320.0	349340.0	349360.0	349380.0
EXISTING IR CHAINAGE	349000.0	349020.0	349040.0	349060.0	349080.0	349100.0	349120.0	349140.0	349160.0	349180.0	349200.0	349220.0	349240.0	349260.0	349280.0	349300.0	349320.0	349340.0	349360.0	349380.0

L - SECTION

NOTE:-

- DFCC WORKS ARE SHOWN IN RED.
- IR NEW WORKS ARE SHOWN IN VIOLET.
- ALL DIMENSIONS ARE SHOWN IN METRES.
- THIS DRAWING IS PREPARED BASED ON LATEST SURVEY DATA HELD ON APRIL-2022. GTS BENCH MARK OF 261.850M CONSIDERED ON TOP OF CANAL BRIDGE ABUTMENT AT DORAH VILLAGE ALONG THE NH1.
- DFC NEW CHAINAGE OF 1075.950M IS WITH REFERENCE TO THE IR KM OF 187.500KM END OF KM OF CP-303(SECTION P-3 PILKHANI END) AGAINST THE EXISTING DFC CHAINAGE. 116277.742M ISSUED VIDE LETTER NO. GCM/DFCC/UM/SURVEY/2021-301-20116-011173 DT. 17.01.2023.
- BALLAST PROFILE HAS BEEN PROVIDED ACCORDING TO THE CLAUSE 1.11.3 OF STANDARD SCHEDULE OF DIMENSION(EASTERN CORRIDOR) & THE BALLAST CUSHION DIMENSION SHOWN IN 35CM ON GE-14 PARA 17. SPECIFICATIONS & RECOMMENDATIONS 2. TWO LAYER SYSTEM FIG.10.

REFERENCE DRAWINGS :-

- FOR KEY PLAN REFER DRAWING NO. 301-2/AL/0001
- FOR LEGEND AND ABBREVIATIONS REFER DRAWING NO. 301-2/AL/1000
- FOR TYPICAL SECTION OF BALLAST PROFILE (FL-RL) REFER DRG. NO. 301-2/TK/TFD/-004 (TR.1952)

010.10.2024SUBMISSION OF AS-BUILT DRAWINGFOR APPROVAL

REV. DATE REVISION DETAILS PURPOSE OF ISSUE

SCALE
HOR - 1:1000
VER - 1:100
SHEET SIZE : A1

LEGEND:

- IR TRACK
- DFCC TRACK
- DFCC FUTURE PROPOSALS
- STRUCTURE / BUILDING
- DFCC TOE LINE
- DFCC FORMATION
- RETAINING WALL
- ROAD
- STREAM, DRAIN, NALA, CANAL.
- POWER LINES
- TBM
- ELECTRIC POLE/OHE MAST
- IR RAILWAY BOUNDARY
- DFCC BOUNDARY

TYPICAL SECTION

TRACK STRUCTURE

RAIL SECTION: 60Kg/m (UIC 60Kg/m) DFC LINE: 60Kg/m (UIC 60Kg/m) IR MAIN LINE: 52Kg/m	Difference between FL- RL (Below Rail Seat)	
	IR Line	DFC
RUBBER PAD	172mm	172mm
SLEEPER DEPTH	6mm	10mm
BALLAST CUSHION	210mm	210mm
	300mm	350mm
Total Depth (FL TO RL)	688mm	742mm

OWNER



DEDICATED FREIGHT CORRIDOR CORPORATION OF INDIA LTD.
(A GOVERNMENT OF INDIA ENTERPRISE)
PROJECT OFFICE (AMBALA UNIT): OLD RAILWAY COLONY (NEAR ANAND MARKET), AMBALA CANTT-133001.
CORPORATE IDENTITY NO. : U60232DL2006GG1155068

ENGINEER:



DB Engineering &
Consulting GmbH
Deutsche Bahn Engineering & Consulting GmbH

CONTRACTOR:



GIL - TPL JV


SUBMITTED BY	GIL - TPL JV		
	DATED	NAME	SIGNATURE
PREPARED BY			
CHECKED BY	10.10.2024	VIJAY PRATAP	
APPROVED BY	10.10.2024	PARASURAM KOTYADA	

APPROVED BY

DEUTSCHE BAHN ENGINEERING & CONSULTING GMBH

	DATED	NAME	SIGNATURE
Sr. DE./CHIEF ENGINEER		SURESH K.YALANGI	
CHIEF TRACK ENGINEER		RAJ PAL SINGH	
T.L.		H.D. VIDJAK	

STAMP

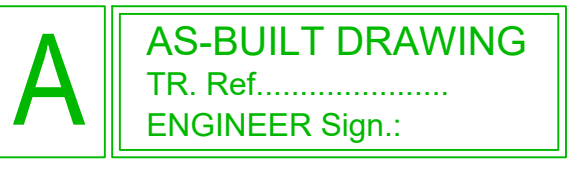

AS-BUILT DRAWING
TR. Ref.:.....
ENGINEER Sign.:.....

EMPLOYER (DFCCIL):

DEDICATED FREIGHT CORRIDOR CORPORATION OF INDIA LTD.

AS BUILT DRAWING

TITLE

AS-BUILT PLAN AND PROFILE

FROM IR KM: 349.000 TO 349.500
FROM DFC KM: 1239.877 to 1240.377

DFCC APPR. NO. -

ENGG. APPR. NO. -

DRG. NO. -301-2/AL/A/1324

SHEET NO. : 1 OF 1

DATE : 10.10.2024


STATUS

A

TR.

PILKHANI

SAHNEWAL

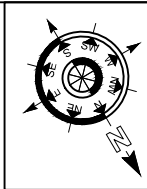

DRG NO. - 301-2/AL/A/1325

NOTE:-

- DFCC WORKS ARE SHOWN IN **RED**.
- IR NEW WORKS ARE SHOWN IN **VIOLET**.
- ALL DIMENSIONS ARE SHOWN IN METRES.
- THIS DRAWING IS PREPARED BASED ON LATEST SURVEY DATA HELD ON APRIL-2022. GTS BENCH MARK OF 261.859M CONSIDERED ON TOP OF CANAL BRIDGE ABUTMENT AT DORANA VILLAGE ALONG THE NH1.
- DFC NEW CHAINAGE OF 1075.950M IS WITH REFERENCE TO THE IR KM OF 187.500KM END OF KM OF CP-303(SECTION P-3 PILKHANI END) AGAINST THE EXISTING DFC CHAINAGE. 116277.742M ISSUED VIDE LETTER NO. GOMDFCC/COMB/SURVEY/2021-301-2301/6-011173 DT. 17.01.2023.
- BALLAST PROFILE HAS BEEN PROVIDED ACCORDING TO THE CLAUSE 1.11.3 OF STANDARD SCHEDULE OF DIMENSION(EASTERN CORRIDOR) & THE BALLAST CUSHION DIMESION SHOWN IN 35CM ON GE-14 PARA 17. SPECIFICATIONS & RECOMMENDATIONS 2. TWO LAYER SYSTEM FIG.10.

REFERENCE DRAWINGS :-

- FOR KEY PLAN REFER DRAWING NO. 301-2/AL/0001
- FOR LEGEND AND ABBREVIATIONS REFER DRAWING NO. 301-2/AL/1000
- FOR TYPICAL SECTION OF BALLAST PROFILE (FL-RL) REFFER DRG. NO. 301-2/TK/TFD/-004 (TR.1952)

REV.	DATE	REVISION DETAILS	PURPOSE OF ISSUE
0	10.10.2024	SUBMISSION OF AS-BUILT DRAWING	FOR APPROVAL

SCALE


HOR - 1:1000

VER - 1:100

SHEET SIZE : A1

LEGEND:

- IR TRACK
- DFCC TRACK
- DFCC FUTURE PROPOSALS
- STRUCTURE / BUILDING
- DFCC TOE LINE
- DFCC FORMATION
- RETAINING WALL
- ROAD
- STREAM, DRAIN, NALA, CANAL.
- FENCE
- POWER LINES
- TBM
- ELECTRIC POLE/OHE MAST
- IR RAILWAY BOUNDARY
- DFCC BOUNDARY

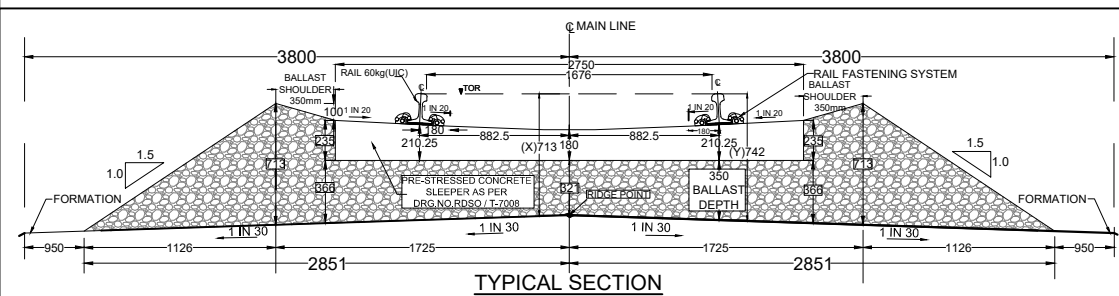

TRACK STRUCTURE		
RAIL SECTION: 60Kg/m (UIC 60Kg/m) DFC LINE: 60Kg/m (UIC 60Kg/m) IR MAIN LINE: 52Kg/m	Difference between FL- RL (Below Rail Seat)	
	IR Line	DFC
RUBBER PAD	172mm	172mm
SLEEPER DEPTH	210mm	210mm
BALLAST CUSHION	300mm	350mm
Total Depth (FL TO RL)	688mm	742mm

OWNER

DEDICATED FREIGHT CORRIDOR CORPORATION OF INDIA LTD.
(A GOVERNMENT OF INDIA ENTERPRISE)
PROJECT OFFICE(AMBALA UNIT): OLD RAILWAY COLONY (NEAR ANAND MARKET),AMBALA CANTT-133001.
CORPORATE IDENTITY NO. : U60233DL2006GGI155068

ENGINEER:

DB Engineering & Consulting GmbH
Deutsche Bahn Engineering & Consulting GmbH

CONTRACTOR:

GIL - TPL JV
GAR TATA

SUBMITTED BY	GIL - TPL JV		
	DATED	NAME	SIGNATURE
PREPARED BY			
CHECKED BY	10.10.2024	VIJAY PRATAP	
APPROVED BY	10.10.2024	PARASURAM KOTYADA	

APPROVED BY	DEUTSCHE BAHN ENGINEERING & CONSULTING GMBH		
	DATED	NAME	SIGNATURE
Sr. DE./CHIEF ENGINEER		SURESH K.YALANGI	
CHIEF TRACK ENGINEER		RAJ PAL SINGH	
T.L.		H.D. VIDJAK	

STAMP	A AS-BUILT DRAWING TR. Ref.:..... ENGINEER Sign.:.....		
	EMPLOYER (DFCCIL):	DEDICATED FREIGHT CORRIDOR CORPORATION OF INDIA LTD.	

AS BUILT DRAWING

TITLE	DFCC APPR. NO. -	STATUS A
AS-BUILT PLAN AND PROFILE	ENGG. APPR. NO. -	
FROM IR KM: 349.500 TO 350.000	DRG. NO. -301-2/AL/A/1325	
FROM DFC KM: 1240.377 TO 1240.877	SHEET NO. : 1 OF 1	
	DATE : 10.10.2024	

TR.

DATUM ABOVE MSL : 255 m

HORIZONTAL ALIGNMENT	L = 4280.337m																								
VERTICAL ALIGNMENT	L=1612.829 m 1 IN 1005.990 F																								
TRACK DISTANCE FROM EXISTING NEAREST IR UP MAIN LINE TO DFC MAIN LINE	8.023																								
HEIGHT OF BANKING(+)/ DEPTH OF CUTTING(-) (PFL-GL)	+0.538																								
EXG GROUND LEVEL AT CENTER LINE OF DFC TRACK (GL)	259.880																								
EXG GROUND LEVEL AT TOE LOCATION OF DFC TRACK	259.481																								
DIFFERENCE BETWEEN DFC FORMATION LEVEL AND EXG.FORMATION LEVEL (PFL-EFL)	0.283																								
DFC FORMATION LEVEL (PFL)	260.418																								
EXG. FORMATION LEVEL OF EXG IR UP MAIN LINE (EFL)	260.135																								
DIFFERENCE BETWEEN DFC RAIL LEVEL AND EXG. RAIL LEVEL (PRL - ERL)	0.324																								
DFC RAIL LEVEL (PRL)	261.131																								
EXG.RAIL LEVEL OF NEAREST IR UP MAIN LINE(ERL)	260.807																								
EQUIVALENT CHAINAGE ON DFC TRACK	1240376.9																								
EXISTING IR CHAINAGE	349500.0																								

L - SECTION