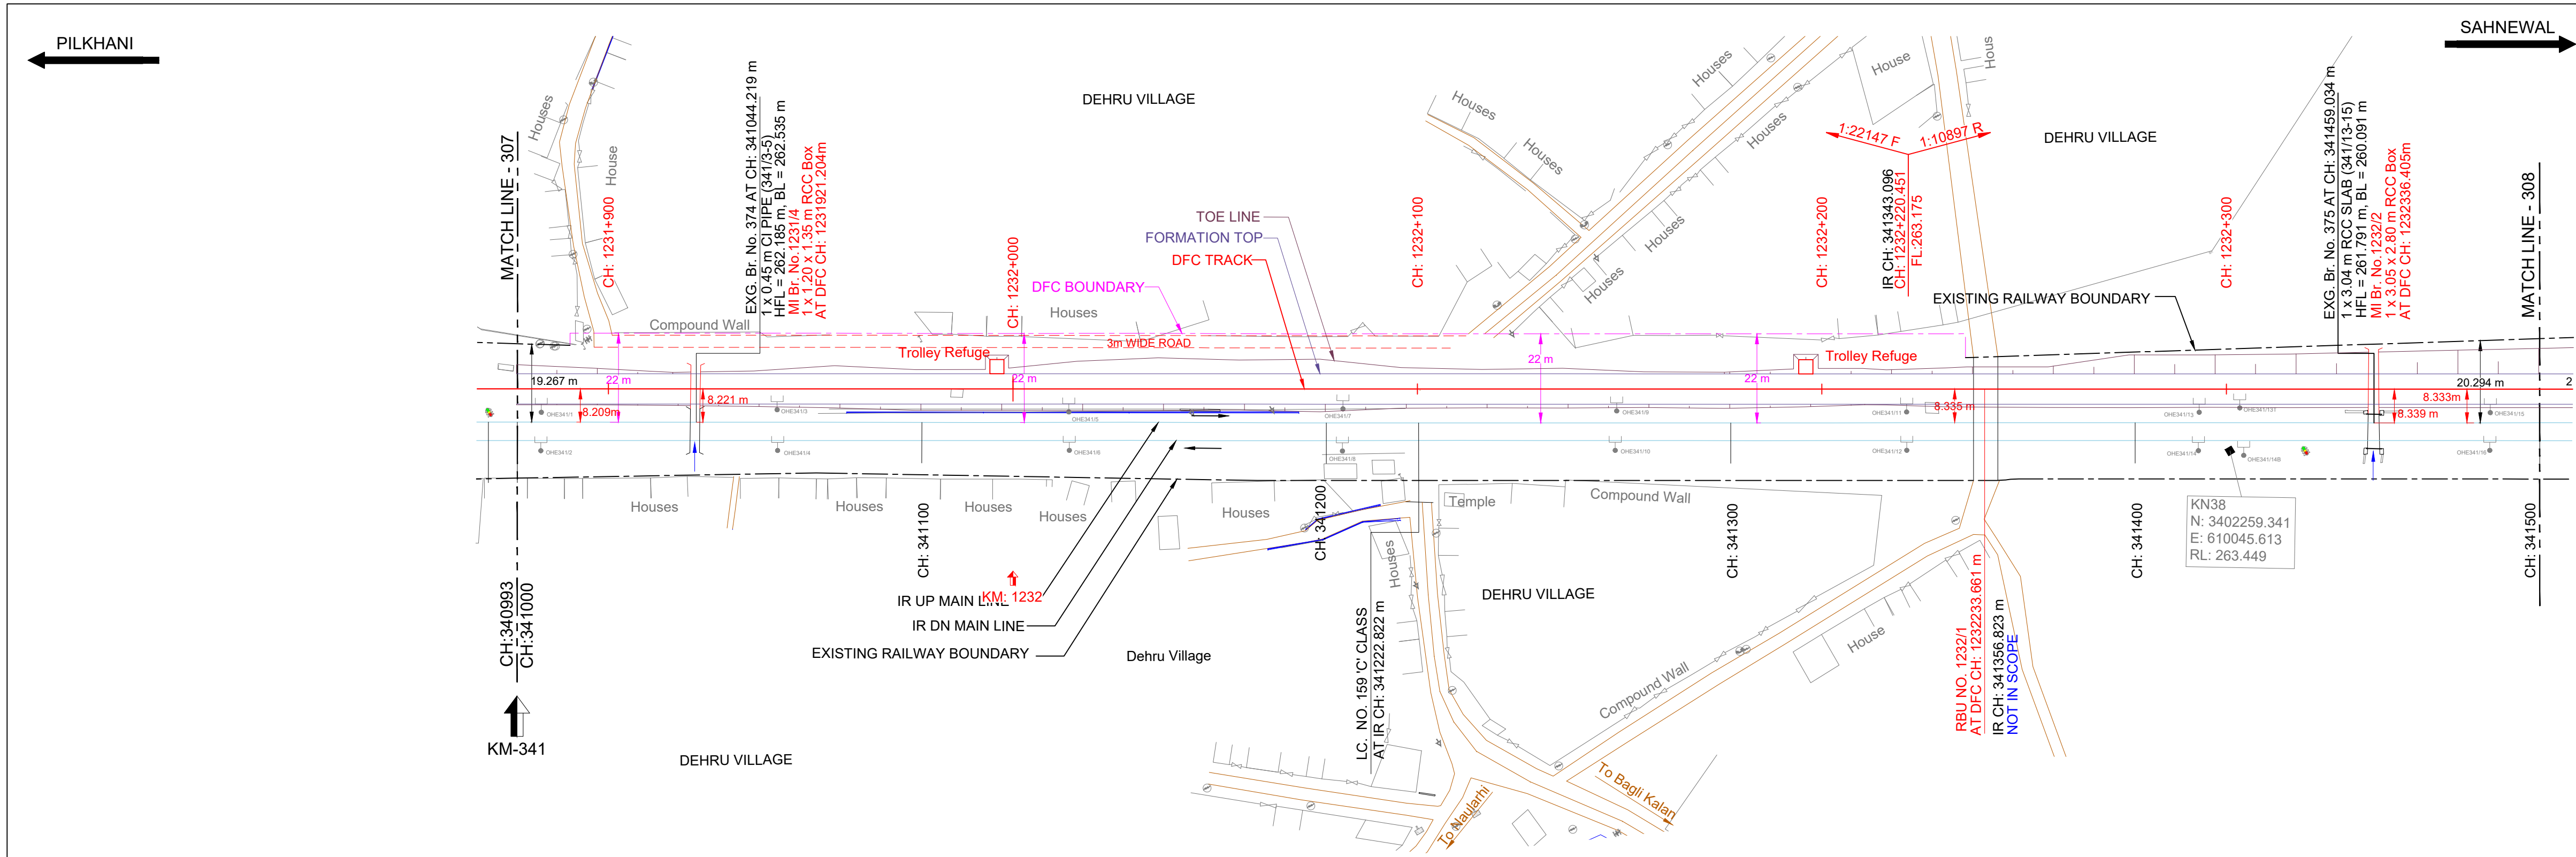


HORIZONTAL ALIGNMENT	L = 2129.106m																			
VERTICAL ALIGNMENT	L=1841.322 m 1 IN 22147.416 F																			
TRACK DISTANCE FROM EXISTING NEAREST IR UP MAIN LINE TO DFC MAIN LINE	8.199	8.212	8.221	8.223	8.235	8.281	8.305	8.261	8.269	8.345	8.391	8.379	8.370	8.367	8.365	8.364	8.355	8.344	8.333	8.322
HEIGHT OF BANKING(+) / DEPTH OF CUTTING(-) (PFL-GL)	+0.595	+0.639	+0.135	-0.217	-1.507	-1.143	-2.565	-2.912	-2.594	-2.498	-2.023	-0.962	-1.014	-0.840	-0.287	+0.365	+0.677	+0.637	+0.400	+0.841
EXG GROUND LEVEL AT CENTER LINE OF DFC TRACK (GL)	262.595	262.550	263.053	263.404	264.693	264.329	265.750	266.096	267.037	268.680	269.204	268.142	264.193	264.018	263.464	262.812	262.499	262.538	262.776	262.337
EXG GROUND LEVEL AT TOE LOCATION OF DFC TRACK	261.897	262.358	262.900	263.802	264.894	264.350	264.191	266.269	267.037	268.614	267.720	264.373	264.132	264.373	263.505	262.642	262.398	262.614	262.244	262.189
DIFFERENCE BETWEEN DFC FORMATION LEVEL AND EXG.FORMATION LEVEL (PFL-EFL)	0.083	0.045	0.010	-0.022	-0.050	-0.062	-0.070	-0.064	-0.070	-0.093	-0.113	-0.120	-0.129	-0.097	-0.073	-0.059	-0.040	-0.019	0.004	0.027
DFC FORMATION LEVEL (PFL)	263.191	263.190	263.169	263.188	263.187	263.186	263.185	263.184	263.183	263.182	263.181	263.180	263.179	263.178	263.177	263.176	263.176	263.175	263.176	263.178
EXG. FORMATION LEVEL OF EXG IR UP MAIN LINE (EFL)	263.107	263.144	263.178	263.210	263.236	263.247	263.254	263.248	263.253	263.275	263.295	263.309	263.308	263.275	263.250	263.238	263.216	263.193	263.172	263.151
DIFFERENCE BETWEEN DFC RAIL LEVEL AND EXG. RAIL LEVEL (PRL - ERL)	0.124	0.087	0.062	0.019	-0.009	-0.020	-0.028	-0.023	-0.029	-0.052	-0.072	-0.087	-0.087	-0.056	-0.032	-0.018	0.001	0.023	0.045	0.069
DFC RAIL LEVEL (PRL)	263.904	263.903	263.902	263.901	263.900	263.899	263.898	263.897	263.896	263.895	263.894	263.894	263.893	263.892	263.891	263.890	263.889	263.888	263.889	263.891
EXG.RAIL LEVEL OF NEAREST IR UP MAIN LINE(ERL)	263.779	263.816	263.850	263.882	263.908	263.919	263.926	263.920	263.925	263.947	263.967	263.981	263.980	263.947	263.922	263.908	263.888	263.865	263.844	263.823
EQUIVALENT CHAINAGE ON DFC TRACK	340985.5	341020.0	341040.0	341060.0	341080.0	341100.0	341120.0	341140.0	341160.0	341180.0	341200.0	341220.0	341240.0	341260.0	341280.0	341300.0	341320.0	341340.0	341360.0	341380.0
EXISTING IR CHAINAGE	340985.5	341000.0	341020.0	341040.0	341060.0	341080.0	341100.0	341120.0	341140.0	341160.0	341180.0	341200.0	341220.0	341240.0	341260.0	341280.0	341300.0	341320.0	341340.0	341360.0

L - SECTION

NOTE:-

- DFCC WORKS ARE SHOWN IN RED.
- IR NEW WORKS ARE SHOWN IN VIOLET.
- ALL DIMENSIONS ARE SHOWN IN METRES.
- THIS DRAWING IS PREPARED BASED ON LATEST SURVEY DATA HELD ON APRIL-2022. GTS BENCH MARK OF 261.85M CONSIDERED ON TOP OF CANAL BRIDGE ABUTMENT AT DORANA VILLAGE ALONG THE NH1.
- DFC NEW CHAINAGE OF 1075.950M IS WITH REFERENCE TO THE IR KM OF 187.500KM END OF KM OF CP-303(SECTION P-3 PILKHANI END) AGAINST THE EXISTING DFC CHAINAGE. 116277.742M ISSUED VIDE LETTER NO. GCM/DFCC/UM/SURVEY/2021-301-230116-011173-DT. 17.01.2023.
- BALLAST PROFILE HAS BEEN PROVIDED ACCORDING TO THE CLAUSE 1.11.3 OF STANDARD SCHEDULE OF DIMENSION(EASTERN CORRIDOR) & THE BALLAST CUSHION DIMENSION SHOWN IN 35CM ON GE-14 PARA 17. SPECIFICATIONS & RECOMMENDATIONS 2. TWO LAYER SYSTEM FIG.10.

REFERENCE DRAWINGS :-

- FOR KEY PLAN REFER DRAWING NO. 301-2/AL/0001
- FOR LEGEND AND ABBREVIATIONS REFER DRAWING NO. 301-2/AL/1000
- FOR TYPICAL SECTION OF BALLAST PROFILE (FL-RL) REFER DRG. NO. 301-2/TK/TFD/004 (TR.1952)

DRG NO. - 301-2/AL/A/1308

0	10.10.2024	SUBMISSION OF AS-BUILT DRAWING	FOR APPROVAL
REV.	DATE	REVISION DETAILS	PURPOSE OF ISSUE

SCALE

HOR - 1:1000

VER - 1:100

SHEET SIZE : A1

LEGEND:

IR TRACK

DFCC TRACK

DFCC FUTURE PROPOSALS

STRUCTURE / BUILDING

DFCC TOE LINE

DFCC FORMATION

RETAINING WALL

ROAD

STREAM, DRAIN, NALA, CANAL.

FENCE

POWER LINES

TBM

ELECTRIC POLE/OHE MAST

IR RAILWAY BOUNDARY

DFCC BOUNDARY

TYPICAL SECTION

TRACK STRUCTURE

RAIL SECTION: 60Kg/m (UIC 60Kg/m)	Difference between FL - RL (Below Rail Seat)	
DFC LINE: 60Kg/m (UIC 60Kg/m)	IR Line	DFC
IR MAIN LINE: 52Kg/m	172mm	172mm
RUBBER PAD	6mm	10mm
SLEEPER DEPTH	210mm	210mm
BALLAST CUSHION	300mm	350mm
Total Depth (FL TO RL)	688mm	742mm

OWNER

DEDICATED FREIGHT CORRIDOR CORPORATION OF INDIA LTD.

(A GOVERNMENT OF INDIA ENTERPRISE)

PROJECT OFFICE(AMBALA UNIT): OLD RAILWAY COLONY (NEAR ANAND MARKET),AMBALA CANTT-133001.

CORPORATE IDENTITY NO. : U60232DL2006GG1150068

ENGINEER:

DB Engineering & Consulting GmbH

Deutsche Bahn Engineering & Consulting GmbH

CONTRACTOR:

GIL - TPL JV

GAR TATA

SUBMITTED BY	GIL - TPL JV		
	DATED	NAME	SIGNATURE
PREPARED BY			
CHECKED BY	10.10.2024	VIJAY PRATAP	
APPROVED BY	10.10.2024	PARASURAM KOTYADA	

APPROVED BY

DEUTSCHE BAHN ENGINEERING & CONSULTING GMBH

DATED	NAME	SIGNATURE
Sr. DE./CHIEF ENGINEER	SURESH K.YALANGI	
CHIEF TRACK ENGINEER	RAJ PAL SINGH	
T.L.	H.D. VIDJAK	

STAMP

A AS-BUILT DRAWING TR. Ref.:..... ENGINEER Sign.:.

EMPLOYER (DFCCIL):

DEDICATED FREIGHT CORRIDOR CORPORATION OF INDIA LTD.

AS BUILT DRAWING

TITLE

AS-BUILT PLAN AND PROFILE

FROM IR KM: 341.000 TO 341.500

FROM DFC KM: 1231.877 TO 1232.377

DFCC APPR. NO. -

ENGG. APPR. NO. -

DRG. NO. -301-2/AL/A/1308

SHEET NO. : 1 OF 1

DATE : 10.10.2024

STATUS

A

TR.