
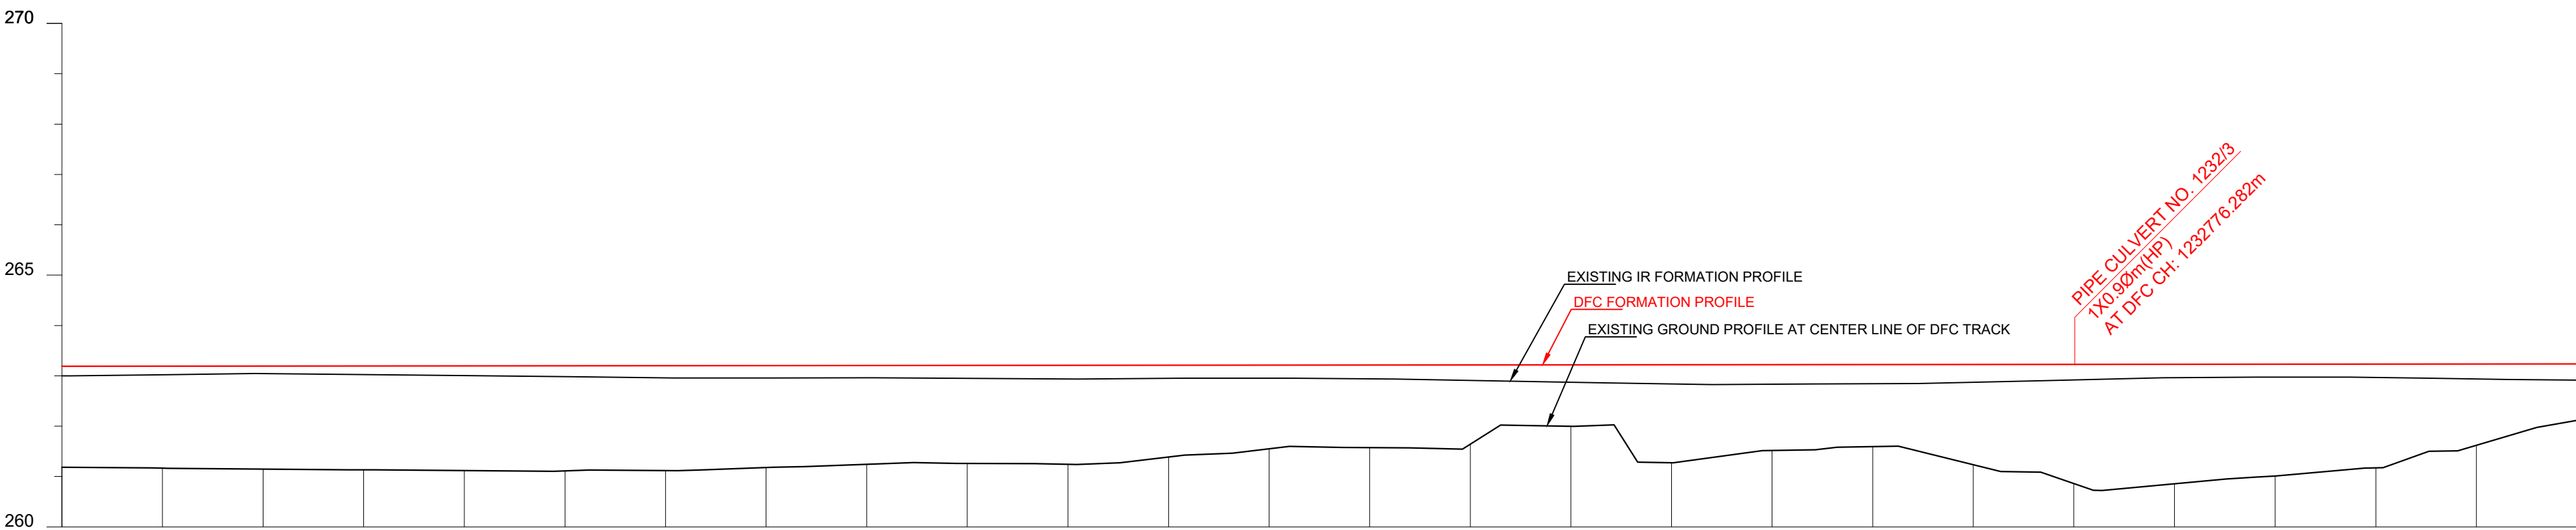


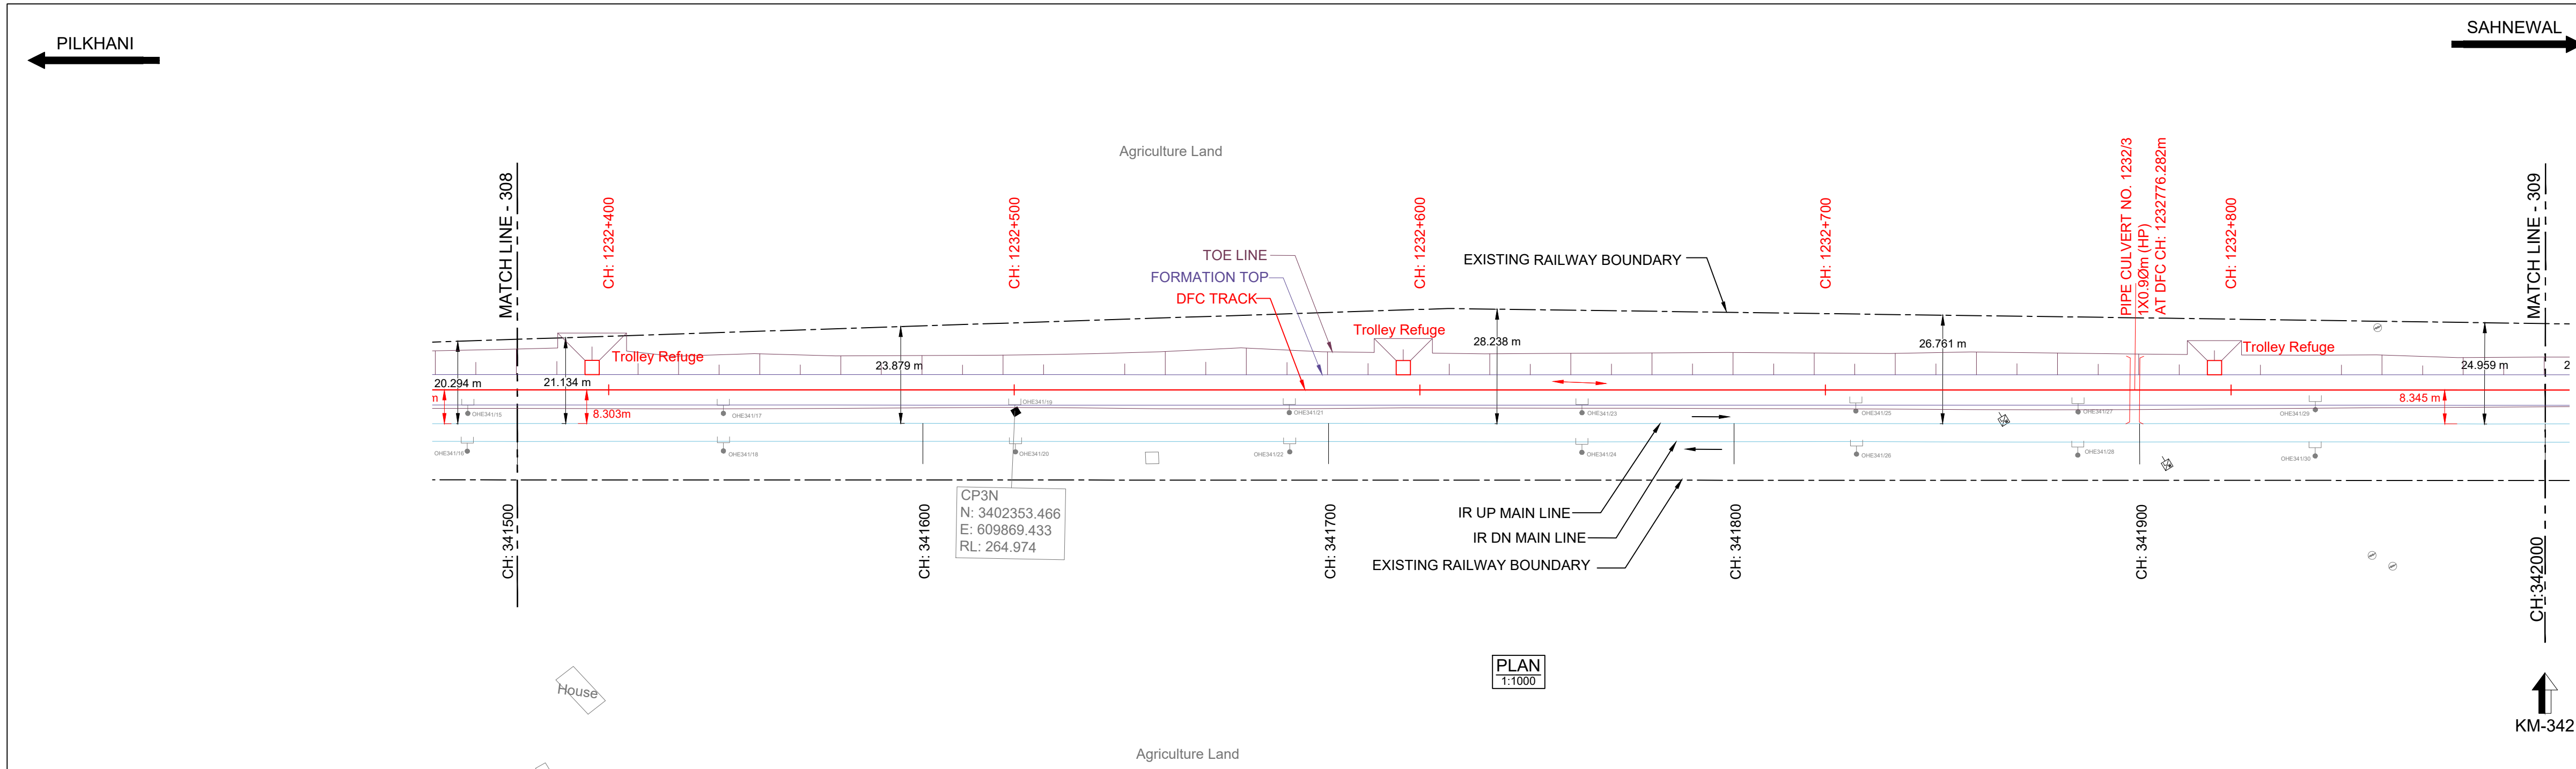

HORIZONTAL ALIGNMENT	L = 2129.106m																			
VERTICAL ALIGNMENT	L=1835.963 m 1 IN 10896.854 R																			
TRACK DISTANCE FROM EXISTING NEAREST IR UP MAIN LINE TO DFC MAIN LINE	8.327	8.294	8.260	8.242	8.223	8.248	8.275	8.268	8.259	8.254	8.251	8.280	8.312	8.301	8.277	8.273	8.277	8.293	8.319	8.318
HEIGHT OF BANKING(+) / DEPTH OF CUTTING(-) (PFL-GL)	+2.006	+2.025	+2.045	+2.061	+2.079	+2.088	+2.081	+2.024	+1.961	+1.947	+1.964	+1.821	+1.660	+1.641	+1.574	+1.221	+1.946	+1.702	+1.628	+1.989
EXG GROUND LEVEL AT CENTER LINE OF DFC TRACK (GL)	261.183	261.166	261.148	261.133	261.117	261.110	261.119	261.178	261.243	261.259	261.243	261.388	261.551	261.572	261.641	261.996	261.272	261.518	261.594	261.235
EXG GROUND LEVEL AT TOE LOCATION OF DFC TRACK	259.926	259.700	260.806	260.492	260.792	260.746	260.687	260.557	260.250	259.835	260.317	260.406	260.548	260.465	260.364	260.435	260.452	260.495	260.311	260.444
DIFFERENCE BETWEEN DFC FORMATION LEVEL AND EXG.FORMATION LEVEL (PFL-EFL)	0.188	0.169	0.150	0.171	0.193	0.215	0.242	0.243	0.241	0.255	0.269	0.260	0.260	0.275	0.345	0.308	0.379	0.388	0.379	0.351
DFC FORMATION LEVEL (PFL)	263.169	263.191	263.193	263.194	263.196	263.198	263.200	263.202	263.204	263.206	263.207	263.209	263.211	263.213	263.217	263.215	263.218	263.220	263.222	263.224
EXG. FORMATION LEVEL OF EXG IR UP MAIN LINE (EFL)	263.001	263.022	263.043	263.023	263.003	262.983	262.958	262.959	262.963	262.951	262.938	262.948	262.951	262.938	262.872	262.907	262.839	262.832	262.843	262.873
DIFFERENCE BETWEEN DFC RAIL LEVEL AND EXG. RAIL LEVEL (PRL - ERL)	0.229	0.210	0.191	0.212	0.235	0.256	0.283	0.285	0.282	0.296	0.311	0.302	0.302	0.316	0.385	0.349	0.421	0.429	0.420	0.392
DFC RAIL LEVEL (PRL)	263.302	263.304	263.306	263.308	263.310	263.312	263.313	263.315	263.317	263.319	263.321	263.323	263.324	263.326	263.330	263.328	263.332	263.334	263.335	263.337
EXG.RAIL LEVEL OF NEAREST IR UP MAIN LINE(ERL)	263.673	263.694	263.715	263.695	263.675	263.655	263.630	263.631	263.635	263.623	263.610	263.621	263.623	263.610	263.544	263.579	263.511	263.504	263.515	263.634
EQUIVALENT CHAINAGE ON DFC TRACK	1232376.8	1232396.8	1232416.8	1232436.8	1232456.8	1232476.9	1232496.8	1232516.8	1232536.8	1232556.8	1232576.8	1232596.8	1232616.9	1232636.8	1232656.8	1232676.8	1232696.8	1232716.9	1232736.9	1232756.8
EXISTING IR CHAINAGE	341500.0	341520.0	341540.0	341560.0	341580.0	341600.0	341620.0	341640.0	341660.0	341680.0	341700.0	341720.0	341740.0	341760.0	341780.0	341800.0	341820.0	341840.0	341860.0	341880.0

L - SECTION

NOTE:-

1. DFC WORKS ARE SHOWN IN RED.
2. IR NEW WORKS ARE SHOWN IN VIOLET.
3. ALL DIMENSIONS ARE SHOWN IN METRES.
4. THIS DRAWING IS PREPARED BASED ON LATEST SURVEY DATA HELD ON APRIL-2022. GTS BENCH MARK OF 261.850M CONSIDERED ON TOP OF CANAL BRIDGE ABUTMENT AT DORAHA VILLAGE ALONG THE NH1.
5. DFC NEW CHAINAGE OF 1075.950M IS WITH REFERENCE TO THE IR KM OF 187.500KM END OF KM OF CP-303(SECTION P-3 PILKHANI END) AGAINST THE EXISTING DFC CHAINAGE. 116277.742M ISSUED VIDE LETTER NO. GOMDFO/CUMBSURVEY/2021-301-2301/6-011173 DT. 17.01.2023.
6. BALLAST PROFILE HAS BEEN PROVIDED ACCORDING TO THE CLAUSE 1.11.3 OF STANDARD SCHEDULE OF DIMENSION(EASTERN CORRIDOR) & THE BALLAST CUSHION DIMESION SHOWN IN 35CM ON GE-14 PARA 17. SPECIFICATIONS & RECOMMENDATIONS 2. TWO LAYER SYSTEM FIG.10.

REFERENCE DRAWINGS :-

1. FOR KEY PLAN REFER DRAWING NO. 301-2/AL/0001
2. FOR LEGEND AND ABBREVIATIONS REFER DRAWING NO. 301-2/AL/1000
3. FOR TYPICAL SECTION OF BALLAST PROFILE (FL-RL) REFER DRG. NO. 301-2/TK/TFD-004 (TR.1952)

REV.	DATE	REVISION DETAILS	PURPOSE OF ISSUE
0	10.10.2024	SUBMISSION OF AS-BUILT DRAWING	FOR APPROVAL

LEGEND:

SCALE

HOR - 1:1000

VER - 1:100

SHEET SIZE : A1

IR TRACK

DFCC TRACK

DFCC FUTURE PROPOSALS

STRUCTURE / BUILDING

DFCC TOE LINE

DFCC FORMATION

RETAINING WALL

ROAD

STREAM, DRAIN, NALA, CANAL.

FENCE


POWER LINES

TBM

ELECTRIC POLE/OHE MAST

IR RAILWAY BOUNDARY

DFCC BOUNDARY

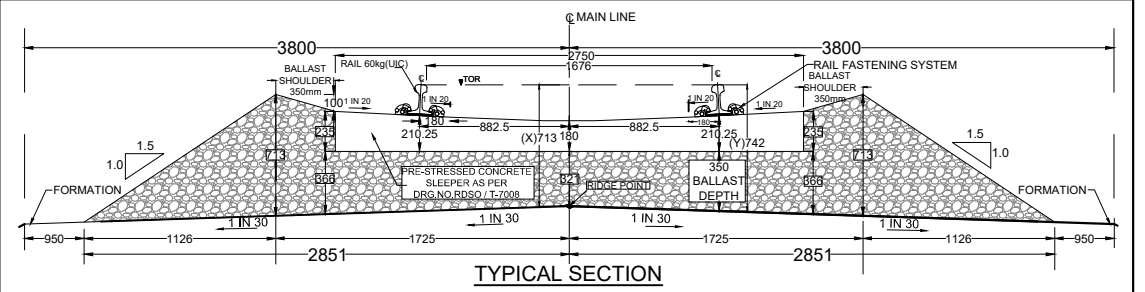

TRACK STRUCTURE		
RAIL SECTION: 60Kg/m (UIC 60Kg/m) DFC LINE: 60Kg/m (UIC 60Kg/m) IR MAIN LINE: 52Kg/m	Difference between FL- RL (Below Rail Seat)	
	IR Line	DFC
RUBBER PAD	172mm	172mm
SLEEPER DEPTH	6mm	10mm
SLEEPER DEPTH	210mm	210mm
BALLAST CUSHION	300mm	350mm
Total Depth (FL TO RL)	688mm	742mm

OWNER

DEDICATED FREIGHT CORRIDOR CORPORATION OF INDIA LTD.

(A GOVERNMENT OF INDIA ENTERPRISE)

PROJECT OFFICE(AMBALA UNIT): OLD RAILWAY COLONY (NEAR ANAND MARKET),AMBALA CANTT-133001.

CORPORATE IDENTITY NO. : U60232DL2006GGI155068

ENGINEER:

DB Engineering & Consulting GmbH

Deutsche Bahn Engineering & Consulting GmbH

CONTRACTOR:

GIL - TPL JV

GAR TATA

SUBMITTED BY	GIL - TPL JV		
	DATED	NAME	SIGNATURE
PREPARED BY			
CHECKED BY	10.10.2024	VIJAY PRATAP	
APPROVED BY	10.10.2024	PARASURAM KOTYADA	

APPROVED BY	DEUTSCHE BAHN ENGINEERING & CONSULTING GMBH		
	DATED	NAME	SIGNATURE
Sr. DE./CHIEF ENGINEER		SURESH K.YALANGI	
CHIEF TRACK ENGINEER		RAJ PAL SINGH	
T.L.		H.D. VIDJAK	

STAMP	A AS-BUILT DRAWING TR. Ref.:..... ENGINEER Sign.:.....		
EMPLOYER (DFCCIL):	DEDICATED FREIGHT CORRIDOR CORPORATION OF INDIA LTD.		

AS BUILT DRAWING			
TITLE	AS-BUILT PLAN AND PROFILE		
	FROM IR KM: 341.500 TO 342.000		
	FROM DFC KM: 1232.377 TO 1232.877		
	DATE : 10.10.2024		
DFCC APPR. NO. -		STATUS	
ENGG. APPR. NO. -		A	
DRG. NO. -301-2/AL/A/1309			
SHEET NO. : 1 OF 1			
DATE : 10.10.2024			