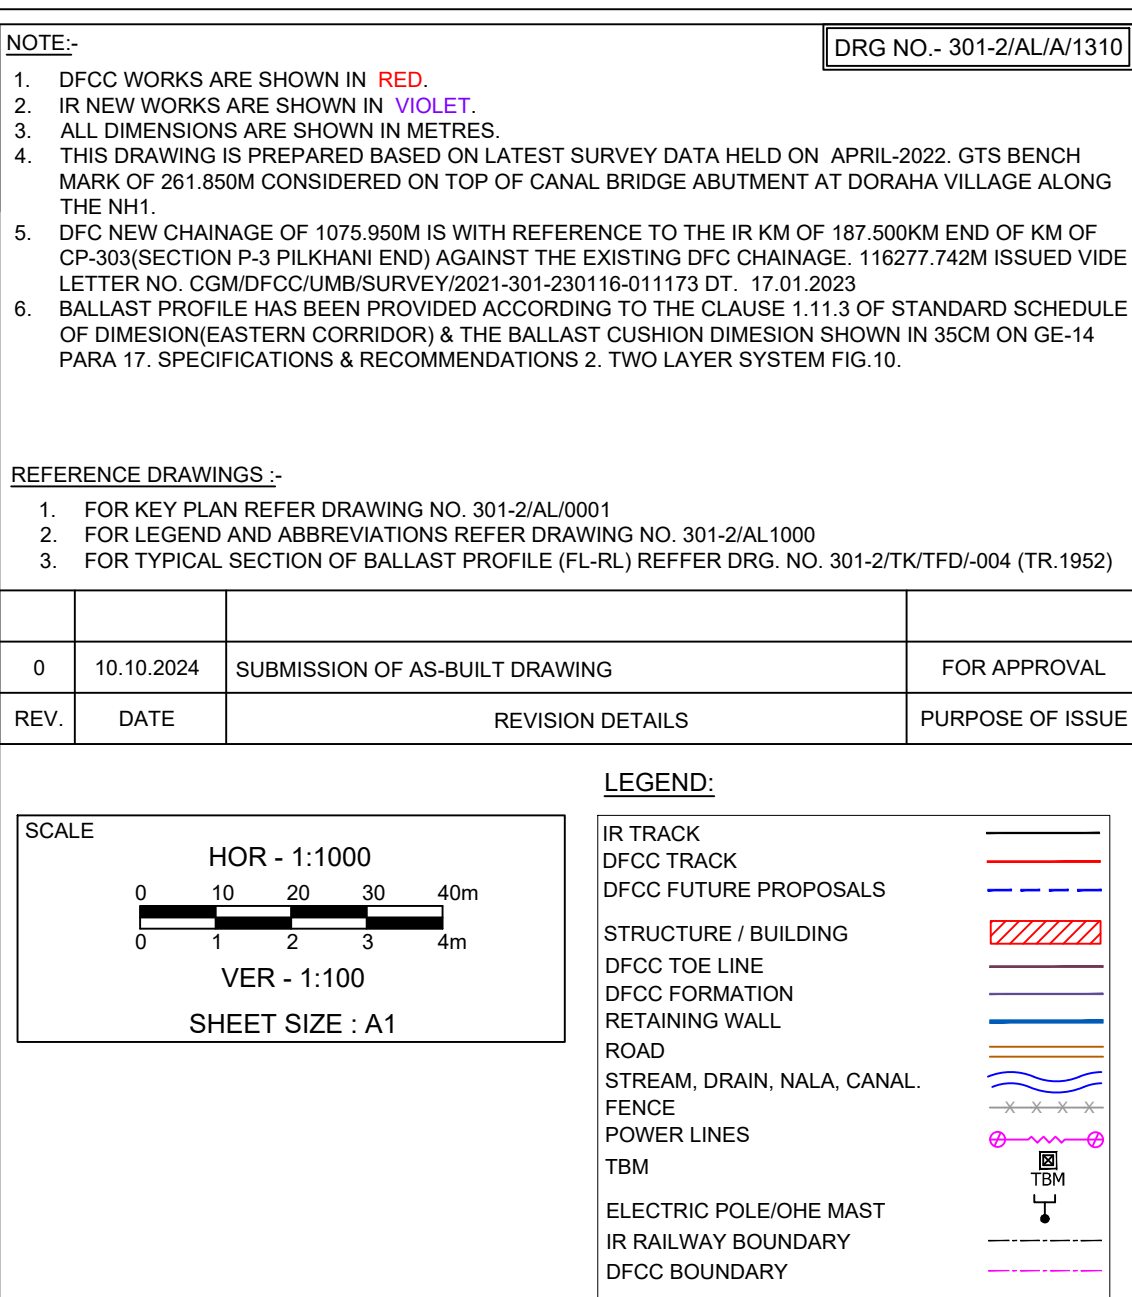


TRACK STRUCTURE		
RAIL SECTION: 60Kg/m (UIC 60Kg/m) DFC LINE: 60Kg/m (UIC 60Kg/m) IR MAIN LINE: 52Kg/m	Difference between FL- RL (Below Rail Seat)	
	IR Line	DFC
	172mm	172mm
RUBBER PAD	6mm	10mm
SLEEPER DEPTH	210mm	210mm
BALLAST CUSHION	300mm	350mm
Total Depth (FL TO RL)	688mm	742mm

OWNER	DEDICATED FREIGHT CORRIDOR CORPORATION OF INDIA LTD. (A GOVERNMENT OF INDIA ENTERPRISE) PROJECT OFFICE(AMBALA UNIT): OLD RAILWAY COLONY (NEAR ANAND MARKET) AMBALA CANTT-133001. CORPORATE IDENTITY NO. : U60232DL2006GOI155068
-------	---

ENGINEER:

 DB Engineering & Consulting GmbH
Deutsche Bahn Engineering & Consulting GmbH

CONTRACTOR: GIL - TPL JV

SUBMITTED BY	GIL - TPL JV		
	DATED	NAME	SIGNATURE
PREPARED BY			
CHECKED BY	10.10.2024	VIJAY PRATAP	
APPROVED BY	10.10.2024	PARASURAM KOTYADA	

APPROVED BY		DEUTSCHE BAHN ENGINEERING & CONSULTING GMBH	
	DATED	NAME	SIGNATURE
Sr. DE./CHIEF ENGINEER		SURESH K.YALANGI	
CHIEF TRACK ENGINEER		RAJ PAL SINGH	
T.L.		H.D. VIDJAK	

STAMP	A AS-BUILT DRAWING TR. Ref..... ENGINEER Sign.:		
EMPLOYER (DFCCIL):	DEDICATED FREIGHT CORRIDOR CORPORATION OF INDIA LTD.		

AS BUILT DRAWING	
TITLE AS-BUILT PLAN AND PROFILE FROM IR KM: 342.000 TO 342.500 FROM DFC KM: 1232.877 TO 1233.377	DFCC APPR. NO. -
	ENGG. APPR. NO. -
	DRG. NO. -301-2/AL/A/1310
	SHEET NO. :1 OF 1
	DATE : 10.10.2024
	STATUS A