
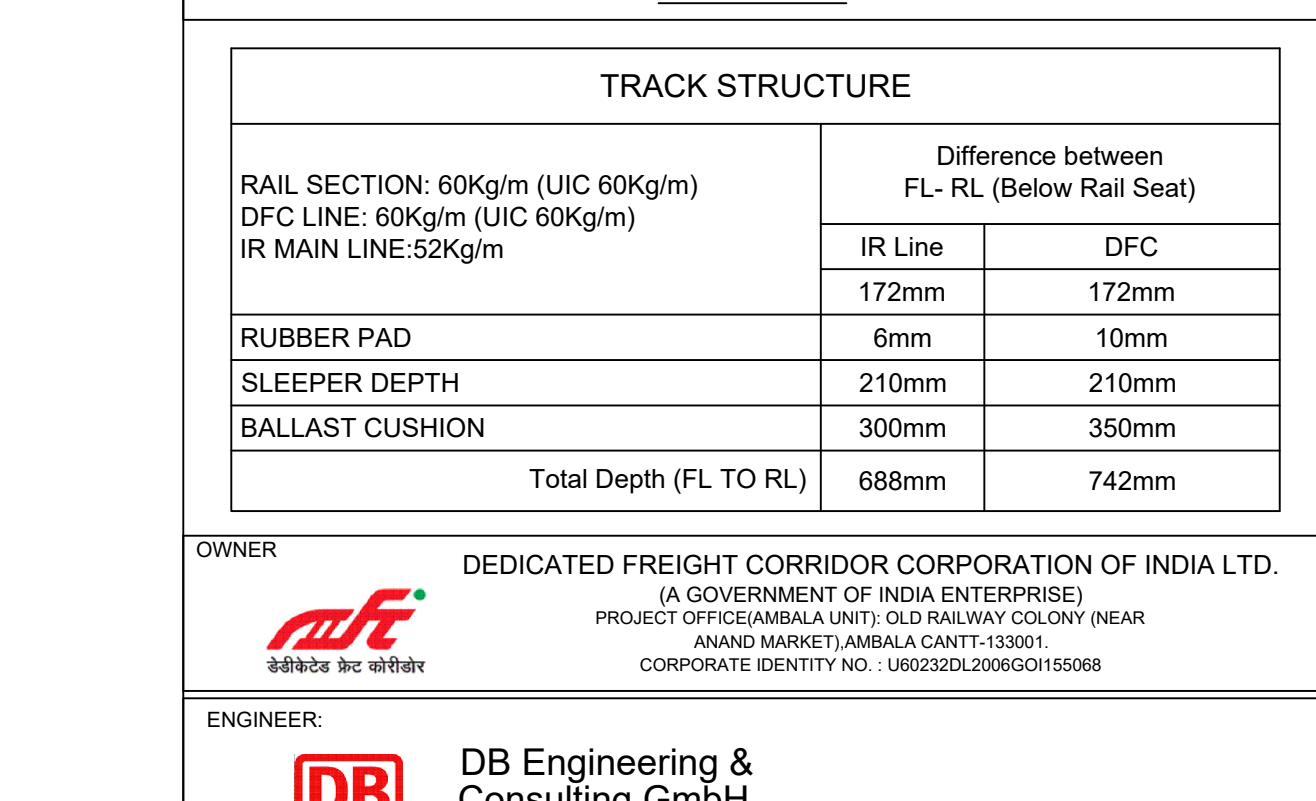


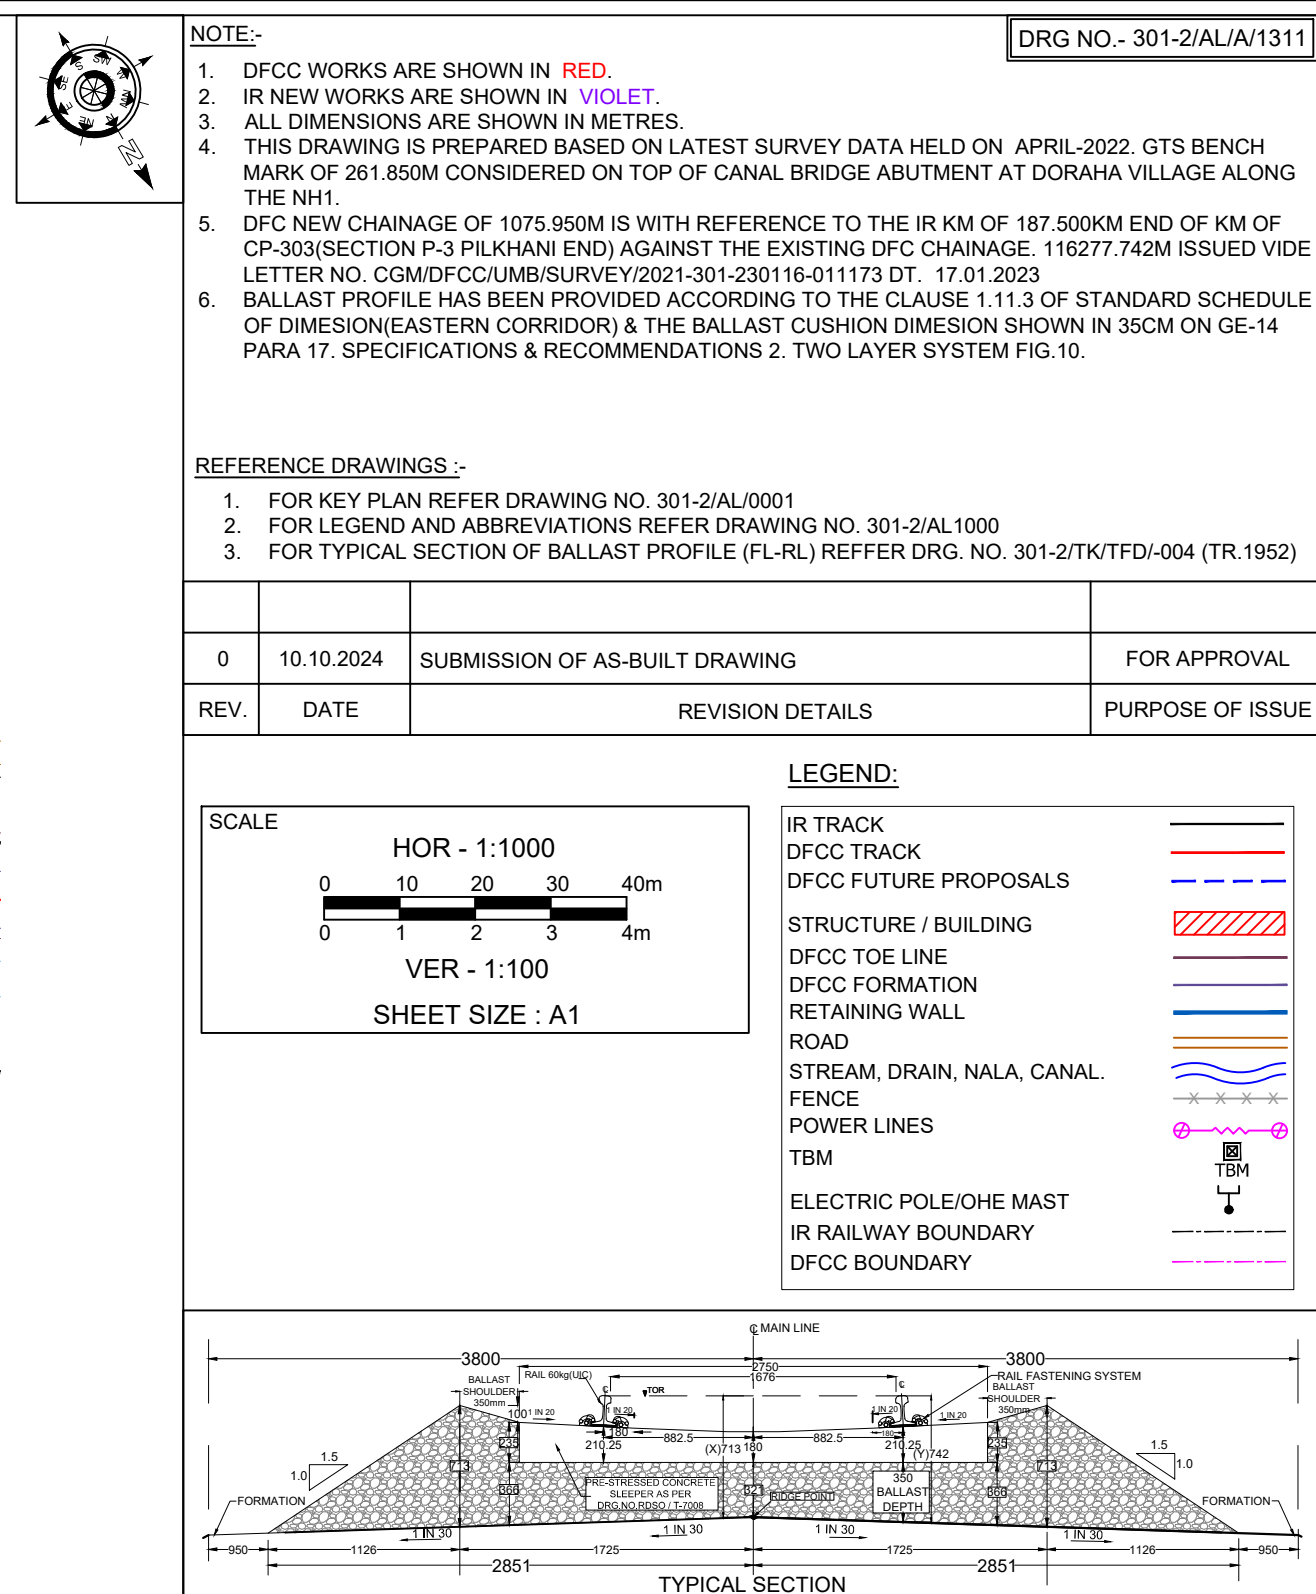

 			
CONTRACTOR: GIL - TPL JV  			
SUBMITTED BY		GIL - TPL JV	
	DATED	NAME	SIGNATURE
PREPARED BY			
CHECKED BY	10.10.2024	VIJAY PRATAP	
APPROVED BY	10.10.2024	PARASURAM KOTYADA	
APPROVED BY		DEUTSCHE BAHN ENGINEERING & CONSULTING GMBH	
	DATED	NAME	SIGNATURE
Sr. DE./CHIEF ENGINEER		SURESH K.YALANGI	
CHIEF TRACK ENGINEER		RAJ PAL SINGH	
T.L.		H.D. VIDJAK	
STAMP	A AS-BUILT DRAWING TR. Ref..... ENGINEER Sign.:		
EMPLOYER (DFCCIL):	DEDICATED FREIGHT CORRIDOR CORPORATION OF INDIA LTD.		
AS BUILT DRAWING			
TITLE		DFCC APPR. NO. -	
AS-BUILT PLAN AND PROFILE		ENGG. APPR. NO. -	

FROM DFC KM. 1233.377 TO 1233.877	SHEET NO. 1 OF 1	A
	DATE : 10.10.2024	