




 
OWNER

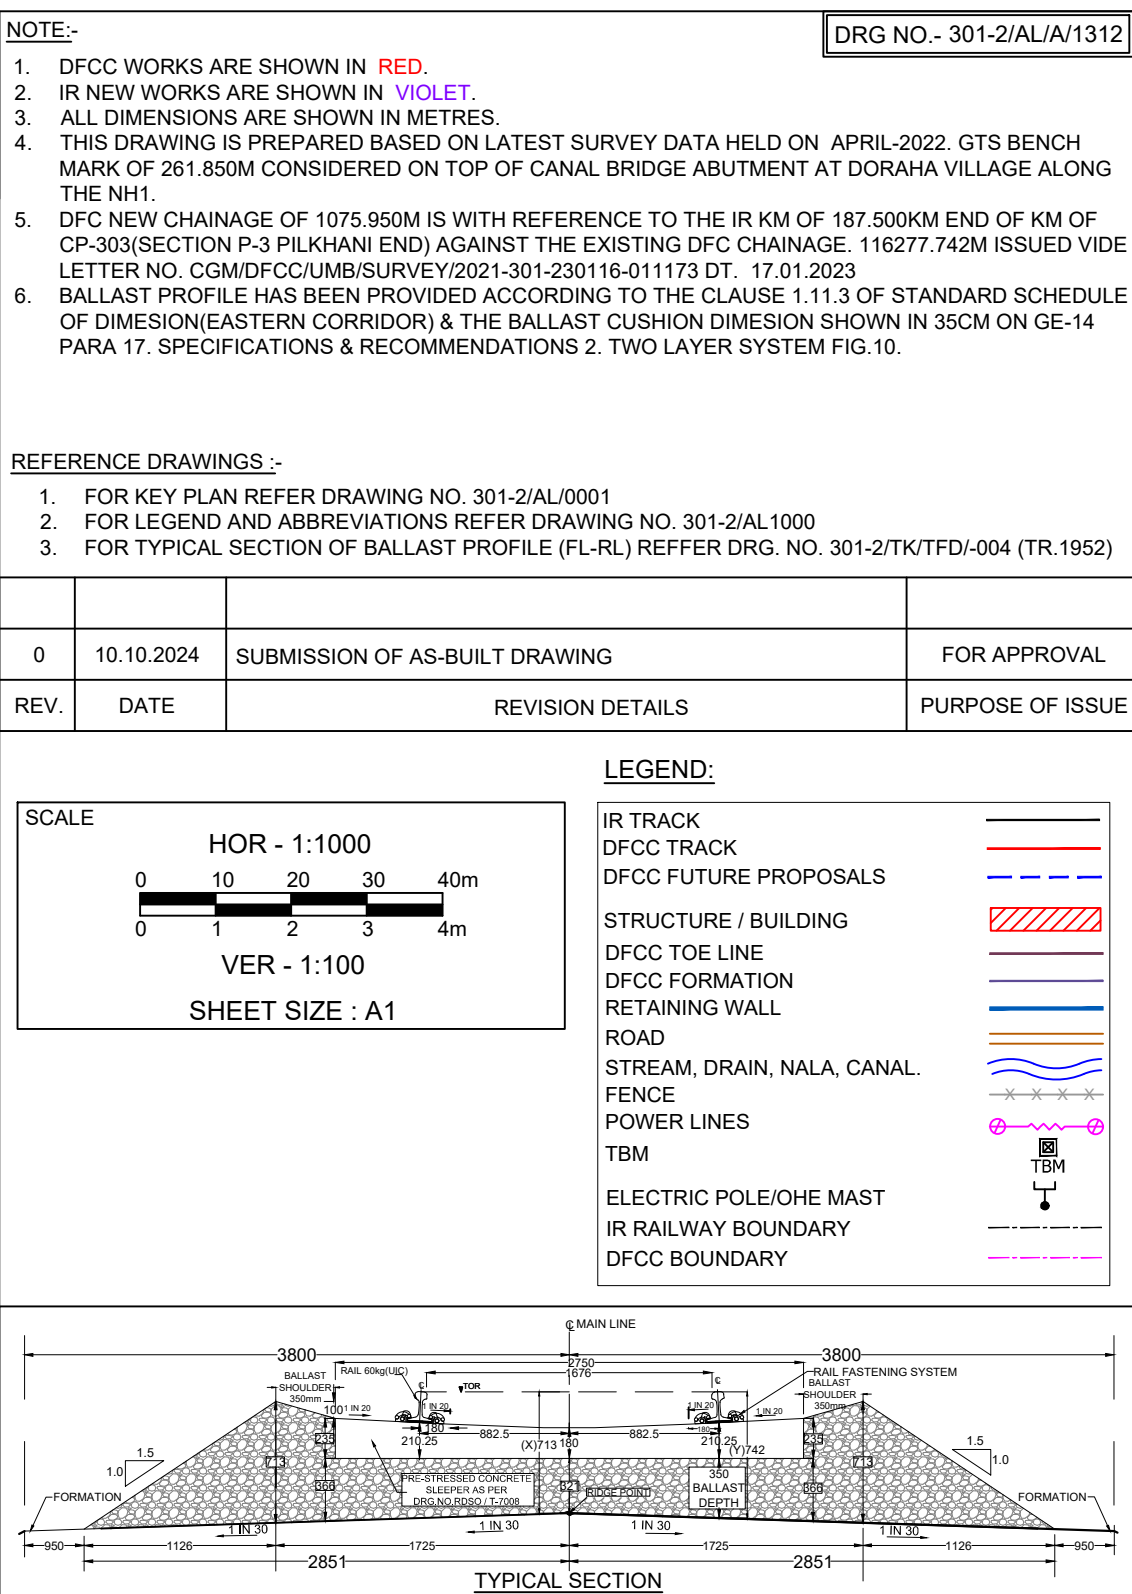

डेडीकेटेड फ्रीट कोरिडोर

DEDICATED FREIGHT CORRIDOR CORPORATION OF INDIA LTD.
(A GOVERNMENT OF INDIA ENTERPRISE)
PROJECT OFFICE(AMBALA UNIT): OLD RAILWAY COLONY (NEAR
ANAND MARKET), AMBALA CANTT-133001.
CORPORATE IDENTITY NO.: U60232DL2006GOI155068

CONTRACTOR: GIL - TPL JV

APPROVED BY	DEUTSCHE BAHN ENGINEERING & CONSULTING GMBH		
	DATED	NAME	SIGNATURE
Sr. DE./CHIEF ENGINEER		SURESH K.YALANGI	
CHIEF TRACK ENGINEER		RAJ PAL SINGH	
T.L.		H.D. VIDJAK	

EMPLOYER (DFCCIL): DEDICATED FREIGHT CORRIDOR CORPORATION OF INDIA LTD.

--	--	--	--

TITLE AS-BUILT PLAN AND PROFILE FROM IR KM: 343.000 TO 343.500 FROM DFC KM: 1233.877 TO 1234.377	DFCC APPR. NO. -	STATUS A
	ENGG. APPR. NO. -	
	DRG. NO. -301-2/AL/A/1312	
	SHEET NO. : 1 OF 1	
	DATE : 10.10.2024	