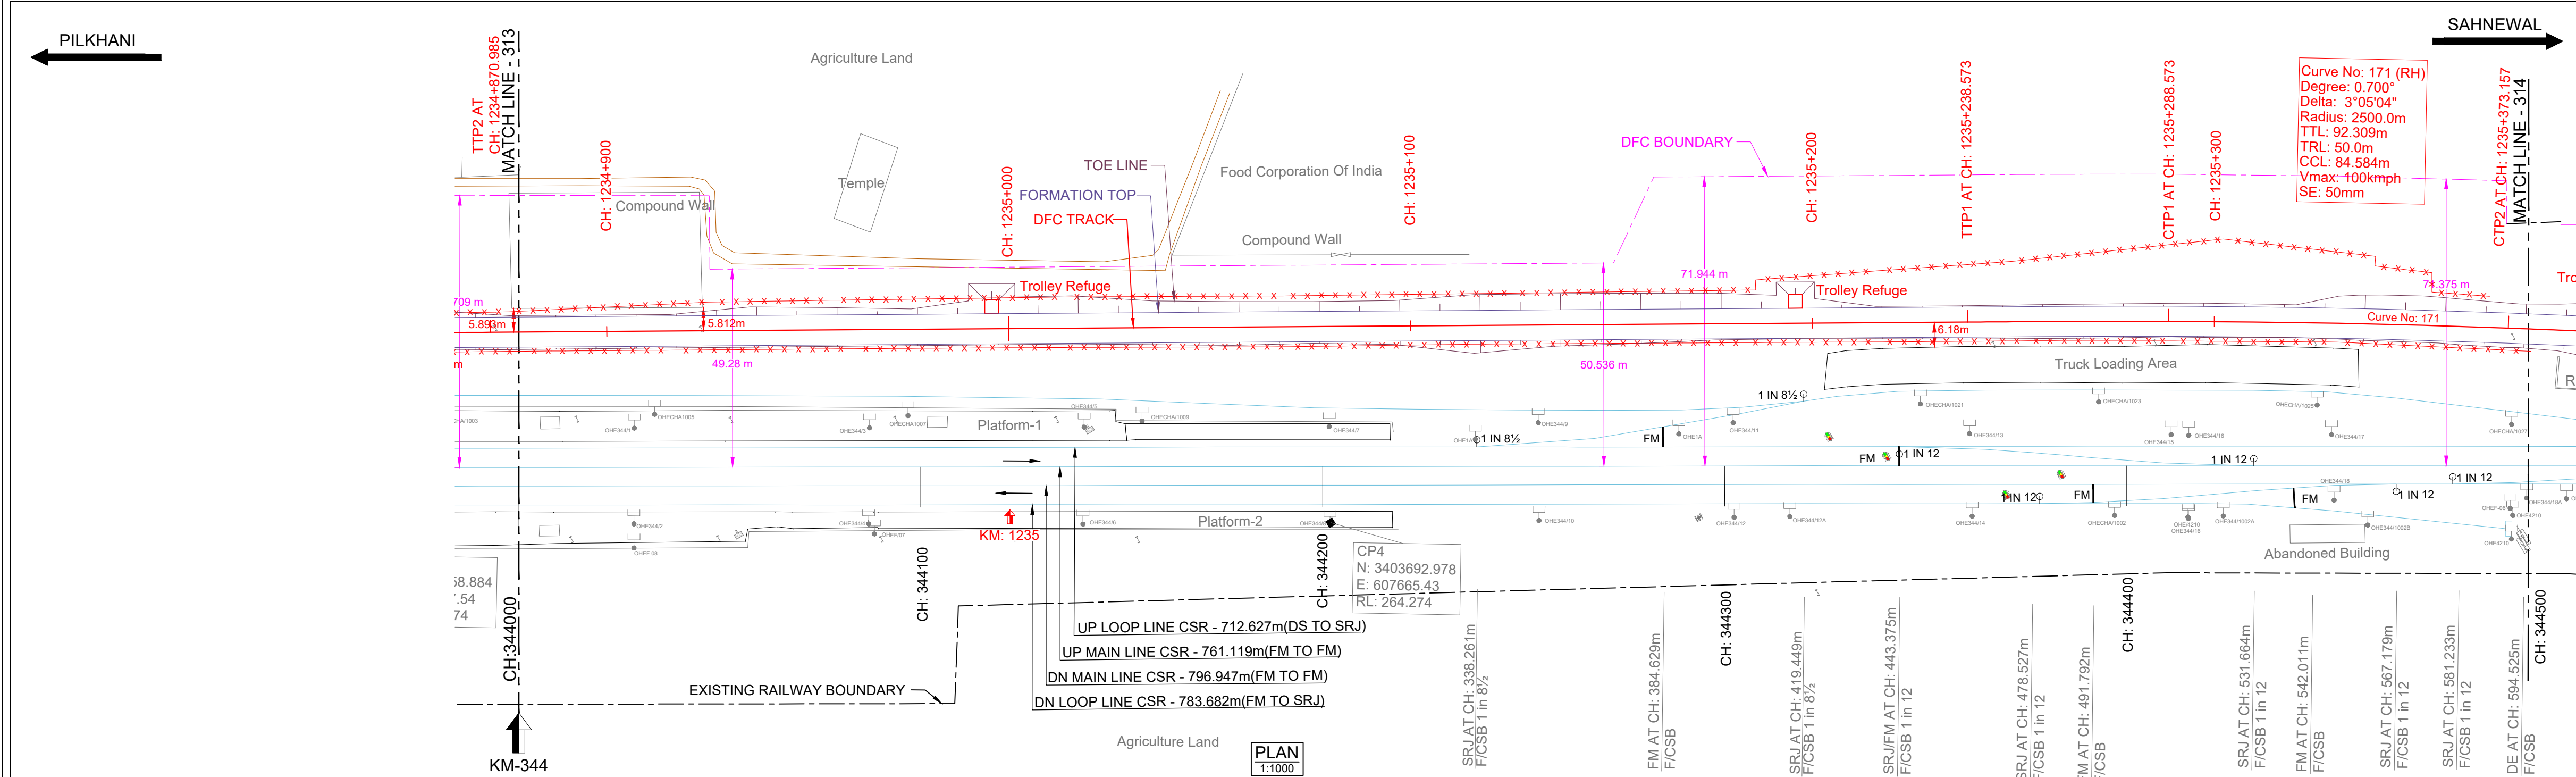


DATUM ABOVE MSL : 200 m																													
HORIZONTAL ALIGNMENT		L = 367.588m TL= 50m R =2500m TL= 50m																											
VERTICAL ALIGNMENT		L=1481.016 m 1 IN 1523.161 R																											
TRACK DISTANCE FROM EXISTING NEAREST IR UP MAIN LINE TO DFC MAIN LINE		33.676	-0.411	-33.794	-33.900	-34.014	-34.125	-34.246	-34.360	-34.471	-34.593	-34.714	-34.842	-34.962	-35.049	-35.177	-35.278	-35.371	-35.463	-35.616	-35.743	-35.869	-35.941	-35.890	-35.663	-35.282	-34.744	-34.045	
HEIGHT OF BANKING(+) / DEPTH OF CUTTING(-) (PFL-GL)				-0.400	-0.387	+0.121	+0.332	+0.760	+1.053	+1.380	+1.465	+1.371	+1.395	+1.418	+2.307	+1.509	+1.274	+1.028	+0.188	+0.140		+0.179	+0.165	+0.172	+0.367	+0.318	+0.475	+1.250	+0.842
EXG GROUND LEVEL AT CENTER LINE OF DFC TRACK (GL)		264.133	264.282	264.284	264.285	263.790	263.592	263.177	262.897	262.583	262.511	262.618	262.608	262.598	261.722	262.533	262.781	263.040	263.893	263.965	263.955	263.929	263.956	263.962	263.780	263.842	263.698	262.936	263.358
EXG GROUND LEVEL AT TOE LOCATION OF DFC TRACK		264.133	264.136	263.979	263.979	262.774	262.951	263.018	261.821	261.785	262.438	262.594	262.662	262.550	261.964	261.929	261.969	262.068	262.625	263.836	263.836	263.840	263.787	263.724	263.650	263.721	262.357	262.468	262.886
DIFFERENCE BETWEEN DFC FORMATION LEVEL AND EXG.FORMATION LEVEL (PFL-EFL)		0.242	0.256	0.274	0.273	0.258	0.258	0.266	0.284	0.324	0.356	0.366	0.370	0.404	0.431	0.447	0.471	0.500	0.529	0.558	0.568	0.589	0.624	0.652	0.665	0.677	0.675	0.664	
DFC FORMATION LEVEL (PFL)		263.871	263.884	263.898	263.911	263.924	263.924	263.937	263.950	263.963	263.976	263.989	264.003	264.016	264.029	264.042	264.055	264.068	264.081	264.095	264.108	264.121	264.134	264.147	264.160	264.173	264.186	264.200	
EXG. FORMATION LEVEL OF EXG IR UP MAIN LINE (EFL)		263.629	263.628	263.624	263.638	263.666	263.666	263.671	263.686	263.693	263.720	263.623	263.633	263.612	263.598	263.595	263.584	263.568	263.552	263.537	263.540	263.532	263.510	263.495	263.495	263.496	263.511	263.538	
DIFFERENCE BETWEEN DFC RAIL LEVEL AND EXG. RAIL LEVEL (PRL - ERL)		0.283	0.297	0.314	0.313	0.298	0.298	0.307	0.325	0.364	0.397	0.407	0.411	0.444	0.472	0.487	0.512	0.541	0.570	0.599	0.608	0.629	0.665	0.693	0.705	0.718	0.717	0.704	
DFC RAIL LEVEL (PRL)		264.584	264.597	264.610	264.623	264.636	264.636	264.650	264.663	264.676	264.689	264.702	264.715	264.728	264.741	264.755	264.768	264.781	264.794	264.807	264.820	264.833	264.847	264.860	264.873	264.886	264.899	264.912	
EXG.RAIL LEVEL OF NEAREST IR UP MAIN LINE(ERL)		264.301	264.300	264.296	264.310	264.338	264.338	264.343	264.338	264.311	264.292	264.295	264.305	264.284	264.270	264.267	264.256	264.240	264.224	264.209	264.212	264.204	264.182	264.167	264.168	264.183	264.208		
EQUIVALENT CHAINAGE ON DFC TRACK		1234877.5	1234897.4	1234917.5	1234937.4	1234957.5	1234977.5	1234997.4	1235017.5	1235037.5	1235057.5	1235077.5	1235097.4	1235117.5	1235137.5	1235157.4	1235177.4	1235197.4	1235217.5	1235237.5	1235257.5	1235276.6	1235297.5	1235317.5	1235337.5	1235357.5	1235377.6		
EXISTING IR CHAINAGE		344000.0	344020.0	344040.0	344060.0	344080.0	344100.0	344120.0	344140.0	344160.0	344180.0	344200.0	344220.0	344240.0	344260.0	344280.0	344300.0	344320.0	344340.0	344360.0	344380.0	344400.0	344420.0	344440.0	344460.0	344480.0	344500.0		
L - SECTION																													

L - SECTION

NOTE:-

- DFCC WORKS ARE SHOWN IN RED.
- IR NEW WORKS ARE SHOWN IN VIOLET.
- ALL DIMENSIONS ARE SHOWN IN METRES.
- THIS DRAWING IS PREPARED BASED ON LATEST SURVEY DATA HELD ON APRIL-2022. GTS BENCH MARK OF 261.85M CONSIDERED ON TOP OF CANAL BRIDGE ABUTMENT AT DORANA VILLAGE ALONG THE NH1.
- DFC NEW CHAINAGE OF 1075.950M IS WITH REFERENCE TO THE IR KM OF 187.500KM END OF KM OF CP-303(SECTION P-3 PILKHANI END) AGAINST THE EXISTING DFC CHAINAGE. 116277.742M ISSUED VIDE LETTER NO. GCM/DFCC/COMB/SURVEY/2021-301-2301/6-011173 DT. 17.01.2023.
- BALLAST PROFILE HAS BEEN PROVIDED ACCORDING TO THE CLAUSE 1.11.3 OF STANDARD SCHEDULE OF DIMENSION(EASTERN CORRIDOR) & THE BALLAST CUSHION DIMENSION SHOWN IN 35CM ON GE-14 PARA 17. SPECIFICATIONS & RECOMMENDATIONS 2. TWO LAYER SYSTEM FIG.10.

REFERENCE DRAWINGS :-

- FOR KEY PLAN REFER DRAWING NO. 301-2/AL/0001
- FOR LEGEND AND ABBREVIATIONS REFER DRAWING NO. 301-2/AL/1000
- FOR TYPICAL SECTION OF BALLAST PROFILE (FL-RL) REFER DRG. NO. 301-2/TK/TFD/-004 (TR.1952)

DRG NO. - 301-2/AL/A/1314

0 10.10.2024 SUBMISSION OF AS-BUILT DRAWING FOR APPROVAL

REV.	DATE	REVISION DETAILS	PURPOSE OF ISSUE
1	10.10.2024	SUBMISSION OF AS-BUILT DRAWING	FOR APPROVAL

LEGEND:

SCALE

HOR - 1:1000

VER - 1:100

SHEET SIZE : A1

TYPICAL SECTION

TRACK STRUCTURE	
RAIL SECTION: 60Kg/m (UIC 60Kg/m)	
DFC LINE: 60Kg/m (UIC 60Kg/m)	
IR MAIN LINE: 52Kg/m	
Difference between FL- RL (Below Rail Seat)	
IR Line	DFC
172mm	172mm
RUBBER PAD	6mm
SLEEPER DEPTH	210mm
BALLAST CUSHION	300mm
Total Depth (FL TO RL)	688mm
	742mm

OWNER

DEDICATED FREIGHT CORRIDOR CORPORATION OF INDIA LTD.

(A GOVERNMENT OF INDIA ENTERPRISE)

PROJECT OFFICE(AMBALA UNIT): OLD RAILWAY COLONY (NEAR ANAND MARKET),AMBALA CANTT-133001.

CORPORATE IDENTITY NO. : U60232DL2006001155068

ENGINEER:

DB Engineering & Consulting GmbH

Deutsche Bahn Engineering & Consulting GmbH

CONTRACTOR:

GIL - TPL JV

GAR TATA

SUBMITTED BY	GIL - TPL JV		
	DATED	NAME	SIGNATURE
PREPARED BY			
CHECKED BY	10.10.2024	VIJAY PRATAP	
APPROVED BY	10.10.2024	PARASURAM KOTYADA	

APPROVED BY

DEUTSCHE BAHN ENGINEERING & CONSULTING GMBH

	DATED	NAME	SIGNATURE
Sr. DE./CHIEF ENGINEER		SURESH K.YALANGI	
CHIEF TRACK ENGINEER		RAJ PAL SINGH	
T.L.		H.D. VIDJAK	

STAMP

AS-BUILT DRAWING

TR. Ref.:.....

ENGINEER Sign.:.....

EMPLOYER (DFCCIL): DEDICATED FREIGHT CORRIDOR CORPORATION OF INDIA LTD.

AS BUILT DRAWING	
TITLE	
AS-BUILT PLAN AND PROFILE	
FROM IR KM: 344.000 TO 344.500	
FROM DFC KM: 1234.877 to 1235.378	
DFCC APPR. NO. -	STATUS
ENGG. APPR. NO. -	A
DRG. NO. -301-2/AL/A/1314	
SHEET NO. : 1 OF 1	
DATE : 10.10.2024	

TR.