

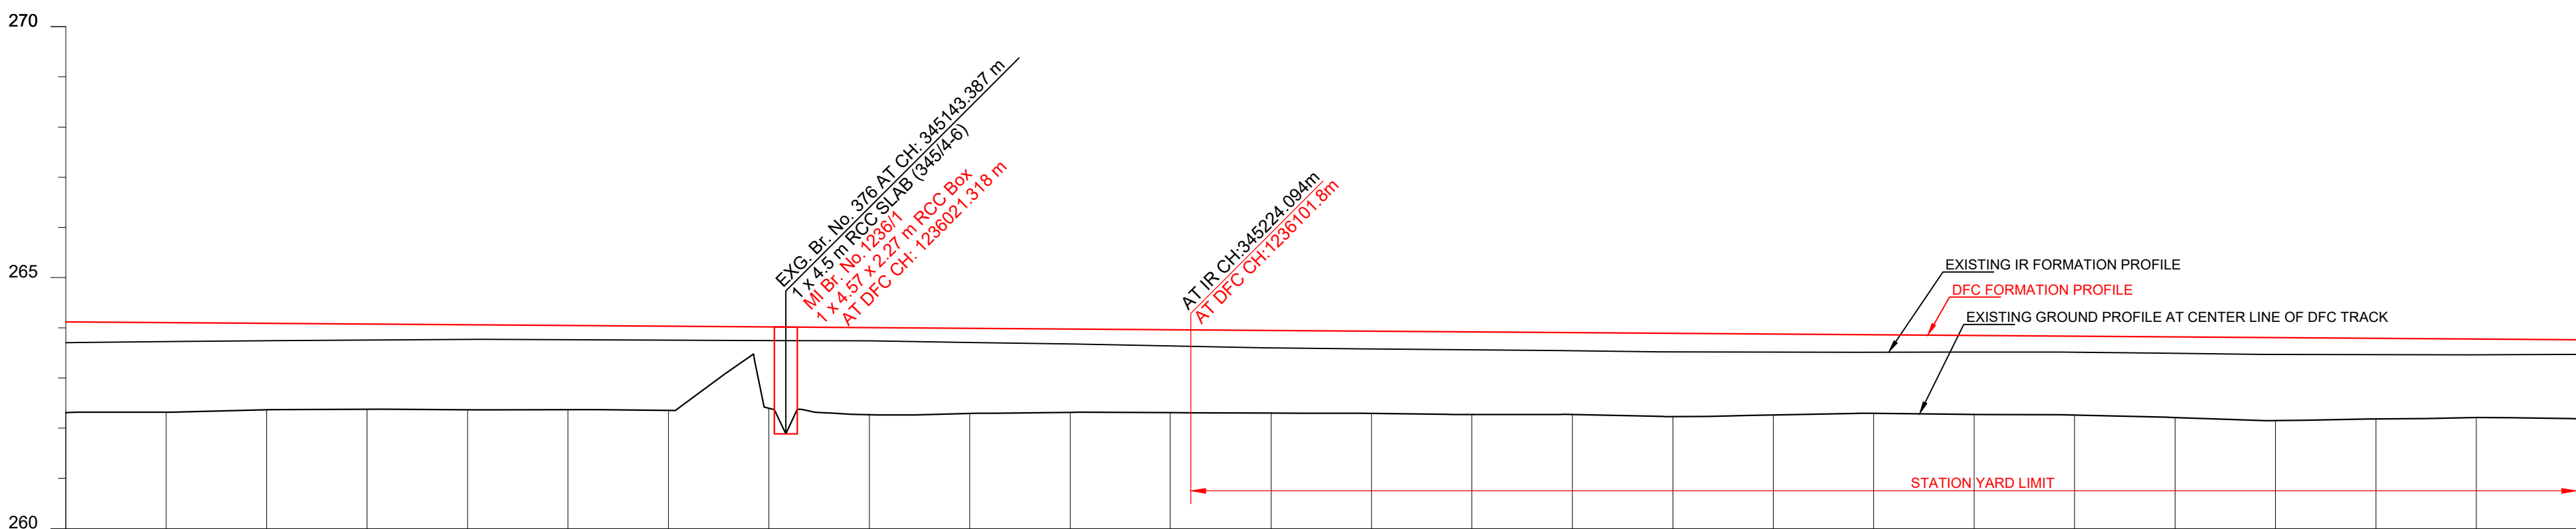


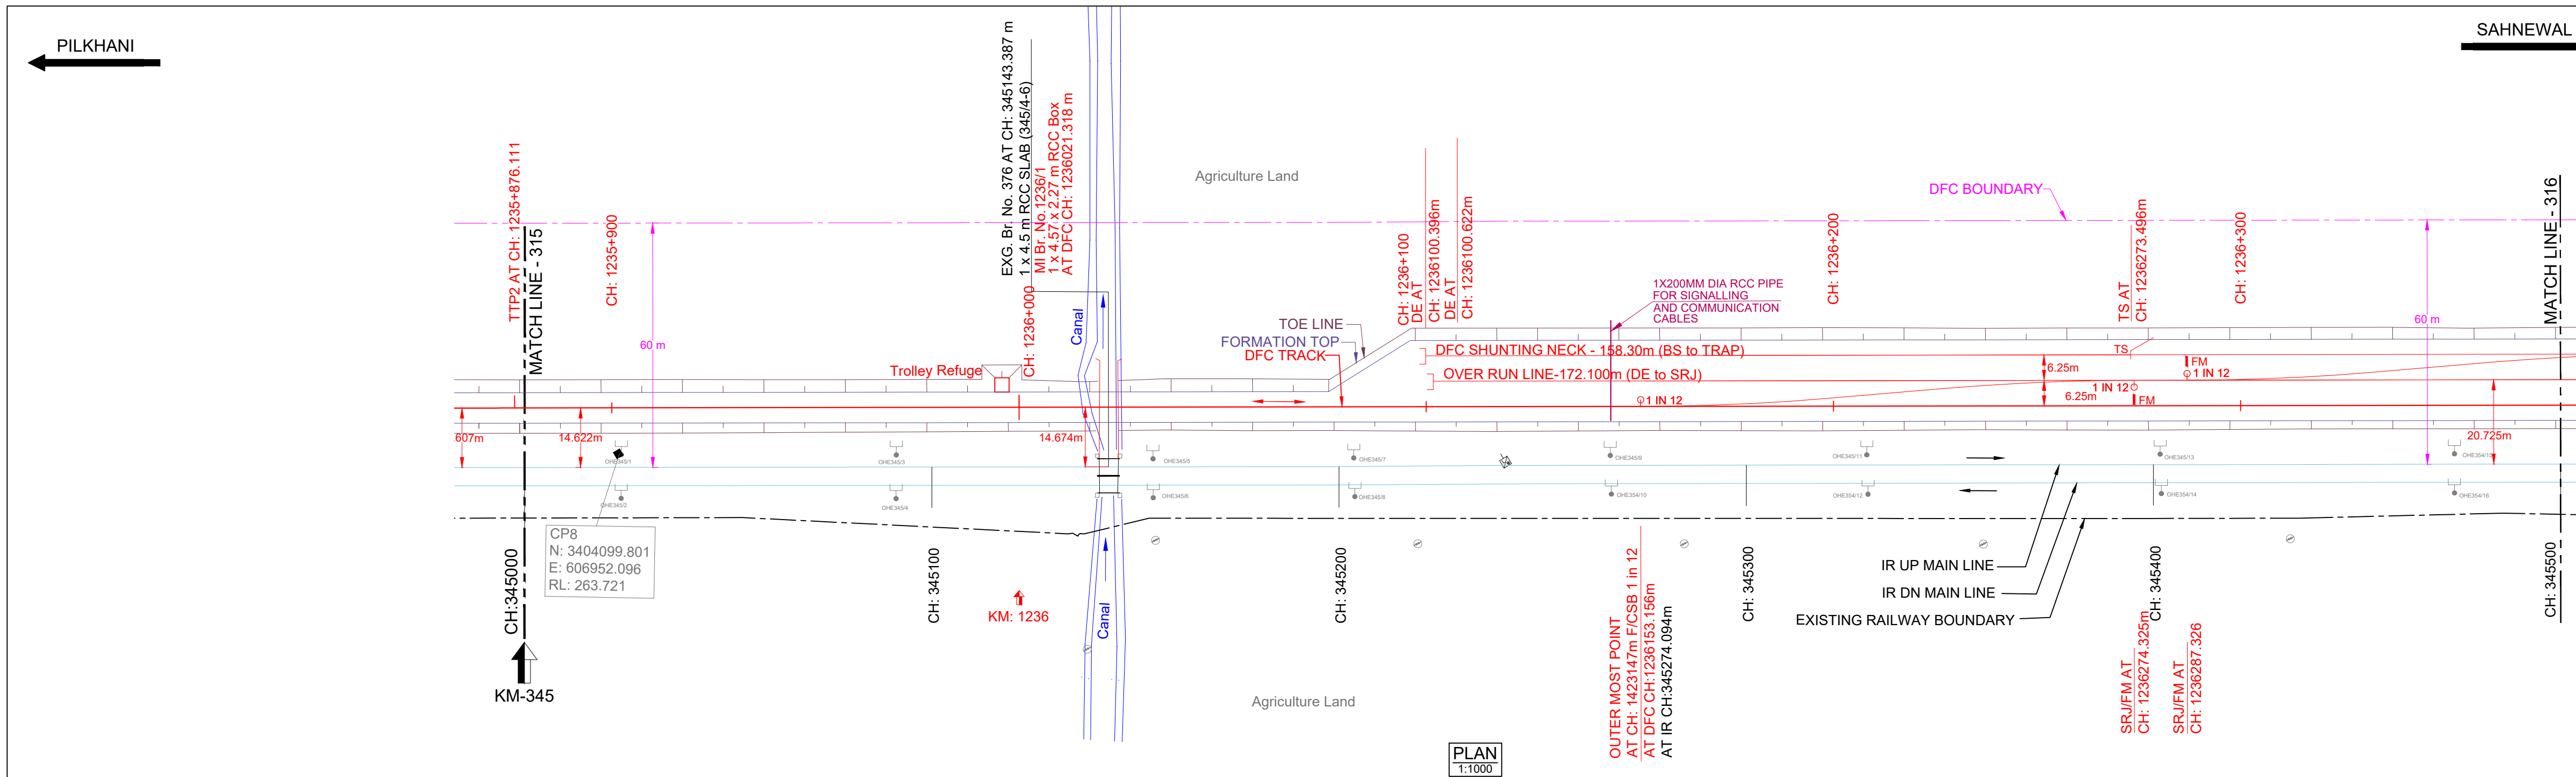

HORIZONTAL ALIGNMENT	L = 3014.655m																			
VERTICAL ALIGNMENT	L = 1480.196 m 1 IN 1405.152 F																			
TRACK DISTANCE FROM EXISTING NEAREST IR UP MAIN LINE TO DFC MAIN LINE	14.614																			
HEIGHT OF BANKING(+) / DEPTH OF CUTTING(-) (PFL-GL)	+1.805	-14.626	+1.722	+1.697	+1.694	+1.675	+1.677	+1.621	+1.734	+1.695	+1.651	+1.645	+1.633	+1.658	+1.610	+1.566	+1.573	+1.571	+1.474	+1.477
EXG GROUND LEVEL AT CENTER LINE OF DFC TRACK (GL)	262.311	262.317	262.366	262.376	262.365	262.370	262.354	262.395	262.268	262.320	262.293	262.376	262.304	262.270	262.301	262.264	262.337	262.273	262.260	262.212
EXG GROUND LEVEL AT TOE LOCATION OF DFC TRACK	262.430	262.407	262.395	262.414	262.414	262.389	262.394	262.612	262.299	262.320	262.323	262.376	262.304	262.273	262.301	262.298	262.337	262.308	262.298	262.280
DIFFERENCE BETWEEN DFC FORMATION LEVEL AND EXG.FORMATION LEVEL (PFL-EFL)	0.413	0.379	0.346	0.318	0.291	0.283	0.278	0.269	0.263	0.279	0.322	0.347	0.362	0.369	0.357	0.346	0.328	0.318	0.326	0.333
DFC FORMATION LEVEL (PFL)	263.116	263.102	263.108	263.107	263.105	263.104	263.103	263.106	263.100	263.109	263.115	263.117	263.120	263.127	263.131	263.137	263.140	263.146	263.151	263.155
EXG. FORMATION LEVEL OF EXG IR UP MAIN LINE (EFL)	263.703	263.723	263.742	263.755	263.766	263.762	263.753	263.747	263.739	263.709	263.678	263.638	263.598	263.541	263.517	263.474	263.418	263.358	263.298	263.237
DIFFERENCE BETWEEN DFC RAIL LEVEL AND EXG. RAIL LEVEL (PRL - ERL)	0.454	0.420	0.387	0.360	0.332	0.324	0.319	0.311	0.304	0.320	0.337	0.363	0.388	0.403	0.398	0.386	0.369	0.359	0.374	0.383
DFC RAIL LEVEL (PRL)	264.829	264.815	264.801	264.768	264.772	264.758	264.744	264.73	264.715	264.701	264.687	264.673	264.658	264.616	264.587	264.573	264.559	264.544	264.544	264.516
EXG.RAIL LEVEL OF NEAREST IR UP MAIN LINE(ERL)	264.375	264.395	264.414	264.427	264.440	264.434	264.425	264.419	264.411	264.381	264.350	264.310	264.270	264.213	264.189	264.186	264.163	264.138	264.135	264.141
EQUIVALENT CHAINAGE ON DFC TRACK	345000.0	345020.0	345040.0	345060.0	345080.0	345100.0	345120.0	345140.0	345160.0	345180.0	345200.0	345220.0	345240.0	345260.0	345280.0	345300.0	345320.0	345340.0	345360.0	345380.0
EXISTING IR CHAINAGE	345000.0	345020.0	345040.0	345060.0	345080.0	345100.0	345120.0	345140.0	345160.0	345180.0	345200.0	345220.0	345240.0	345260.0	345280.0	345300.0	345320.0	345340.0	345360.0	345380.0

L - SECTION

SAHNEWAL

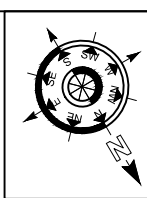

- NOTE:-
1. DFC WORKS ARE SHOWN IN RED.
 2. IR NEW WORKS ARE SHOWN IN VIOLET.
 3. ALL DIMENSIONS ARE SHOWN IN METRES.
 4. THIS DRAWING IS PREPARED BASED ON LATEST SURVEY DATA HELD ON APRIL-2022. GTS BENCH MARK OF 261.859M CONSIDERED ON TOP OF CANAL BRIDGE ABUTMENT AT DORANA VILLAGE ALONG THE NH1.
 5. DFC NEW CHAINAGE OF 1075.950M IS WITH REFERENCE TO THE IR KM OF 187.500KM END OF KM OF CP-303(SECTION P-3 PILKHANI END) AGAINST THE EXISTING DFC CHAINAGE. 116277.742M ISSUED VIDE LETTER NO. GOMDFO/CUMBSURVEY/2021-301-2301/16-011173 DT. 17.01.2023.
 6. BALLAST PROFILE HAS BEEN PROVIDED ACCORDING TO THE CLAUSE 1.11.3 OF STANDARD SCHEDULE OF DIMENSION(EASTERN CORRIDOR) & THE BALLAST CUSHION DIMENSION SHOWN IN 35CM ON GE-14 PARA 17. SPECIFICATIONS & RECOMMENDATIONS 2. TWO LAYER SYSTEM FIG.10.

REFERENCE DRAWINGS :-

1. FOR KEY PLAN REFER DRAWING NO. 301-2/AL/0001
2. FOR LEGEND AND ABBREVIATIONS REFER DRAWING NO. 301-2/AL/1000
3. FOR TYPICAL SECTION OF BALLAST PROFILE (FL-RL) REFER DRG. NO. 301-2/TK/TFD-004 (TR.1952)

REV.	DATE	REVISION DETAILS	PURPOSE OF ISSUE
0	10.10.2024	SUBMISSION OF AS-BUILT DRAWING	FOR APPROVAL

LEGEND:


SCALE

HOR - 1:1000

VER - 1:100

SHEET SIZE : A1

IR TRACK
DFCC TRACK
DFCC FUTURE PROPOSALS
STRUCTURE / BUILDING
DFCC TOE LINE
DFCC FORMATION
RETAINING WALL
ROAD
STREAM, DRAIN, NALA, CANAL.
FENCE
POWER LINES
TBM
ELECTRIC POLE/OHE MAST
IR RAILWAY BOUNDARY
DFCC BOUNDARY

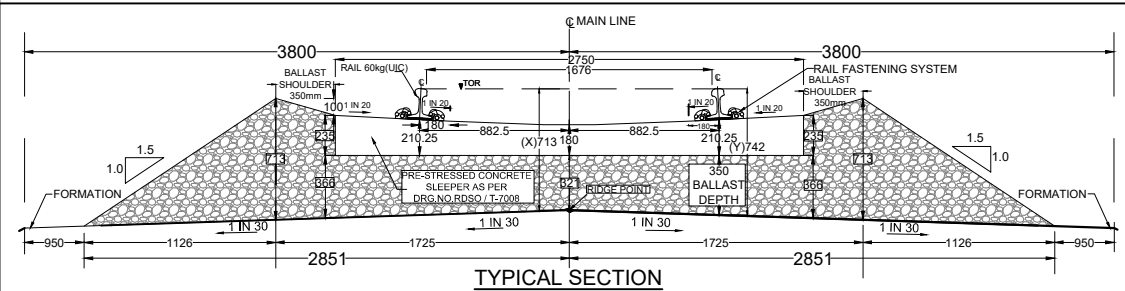

TRACK STRUCTURE		
RAIL SECTION: 60Kg/m (UIC 60Kg/m) DFC LINE: 60Kg/m (UIC 60Kg/m) IR MAIN LINE: 52Kg/m	Difference between FL- RL (Below Rail Seat)	
	IR Line	DFC
RUBBER PAD	172mm	172mm
SLEEPER DEPTH	6mm	10mm
BALLAST CUSHION	210mm	210mm
	300mm	350mm
Total Depth (FL TO RL)	688mm	742mm

OWNER

DEDICATED FREIGHT CORRIDOR CORPORATION OF INDIA LTD.

(A GOVERNMENT OF INDIA ENTERPRISE)

PROJECT OFFICE(AMBALA UNIT): OLD RAILWAY COLONY (NEAR ANAND MARKET),AMBALA CANTT-133001.

CORPORATE IDENTITY NO. : U60232DL2006001150068

ENGINEER:

DB Engineering & Consulting GmbH

Deutsche Bahn Engineering & Consulting GmbH

CONTRACTOR:

GIL - TPL JV

GAR TATA

SUBMITTED BY	GIL - TPL JV		
PREPARED BY	DATED	NAME	SIGNATURE
CHECKED BY	10.10.2024	VIJAY PRATAP	
APPROVED BY	10.10.2024	PARASURAM KOTYADA	

APPROVED BY	DEUTSCHE BAHN ENGINEERING & CONSULTING GMBH		
	DATED	NAME	SIGNATURE
Sr. DE./CHIEF ENGINEER		SURESH K.YALANGI	
CHIEF TRACK ENGINEER		RAJ PAL SINGH	
T.L.		H.D. VIDJAK	

STAMP	A AS-BUILT DRAWING TR. Ref:..... ENGINEER Sign.:.....		
EMPLOYER (DFCCIL):	DEDICATED FREIGHT CORRIDOR CORPORATION OF INDIA LTD.		

AS BUILT DRAWING			
TITLE		DFCC APPR. NO. -	
AS-BUILT PLAN AND PROFILE		ENGG. APPR. NO. -	
FROM IR KM: 345.000 TO 345.500		DRG. NO. -301-2/AL/A/1316	
FROM DFC KM: 1235.878 TO 1236.378		SHEET NO. : 1 OF 1	
		DATE : 10.10.2024	
		STATUS	
		A	

TR.