


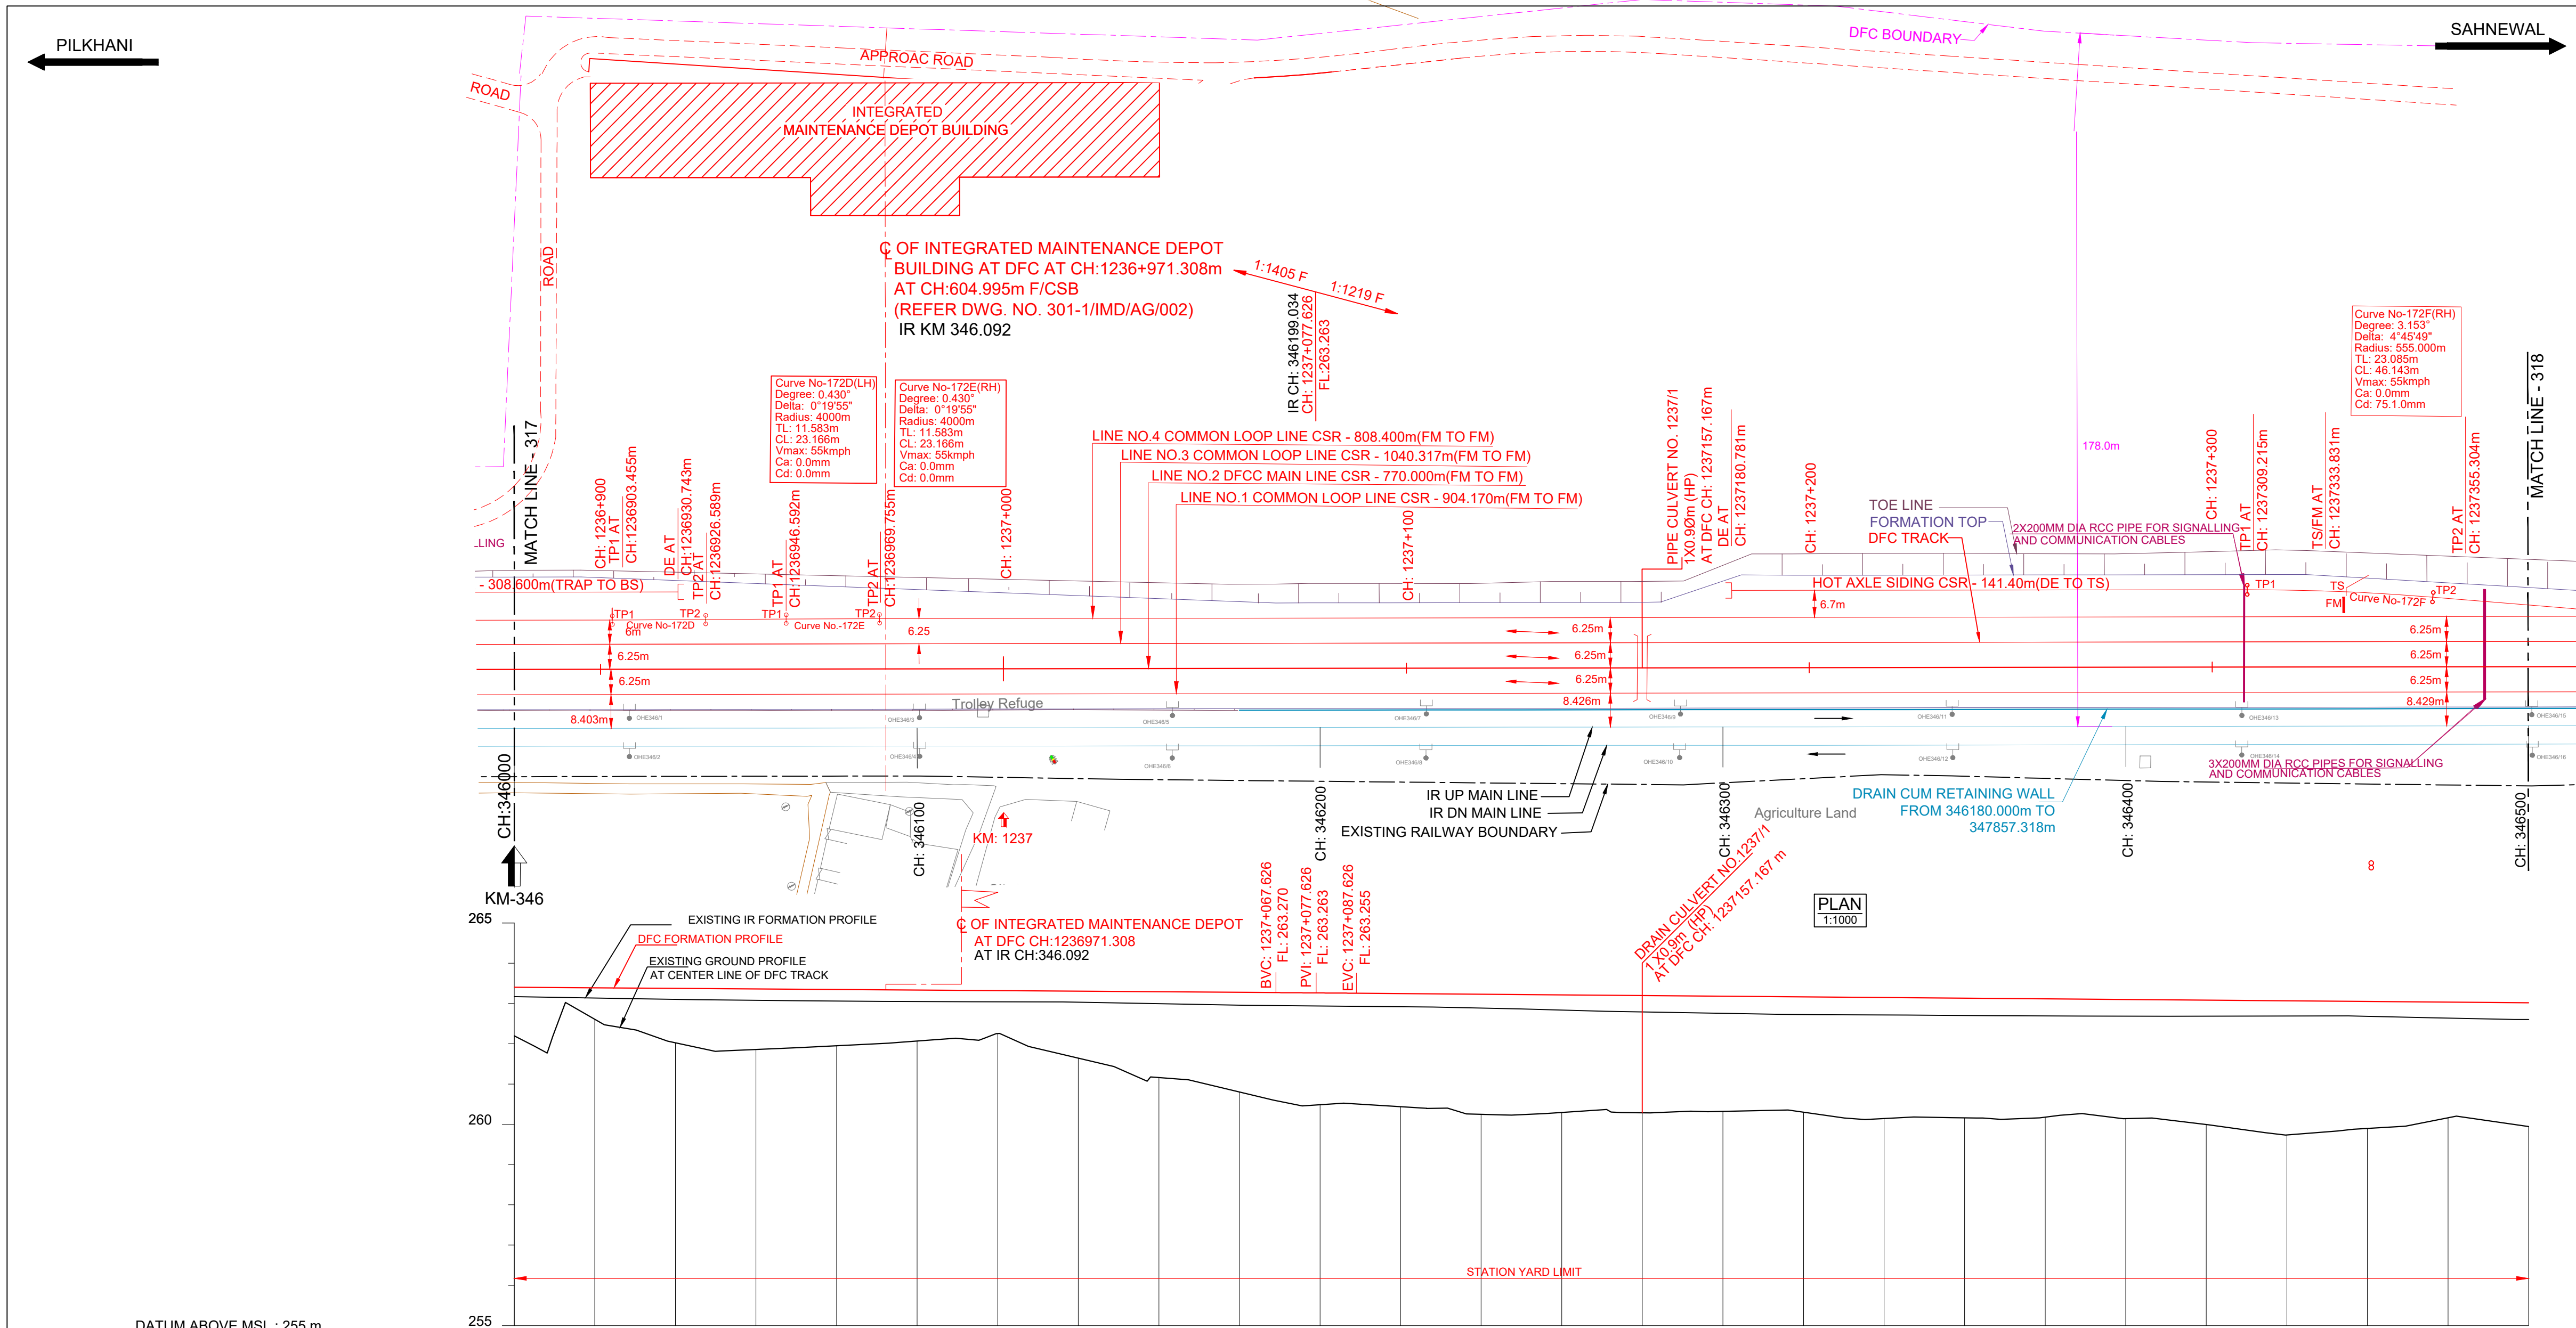

HORIZONTAL ALIGNMENT	L = 3014.655m																			
VERTICAL ALIGNMENT	L=1480.196 m 1 IN 1405.152 F																			
TRACK DISTANCE FROM EXISTING NEAREST IR UP MAIN LINE TO DFC MAIN LINE	-14.653	-14.653	-14.654	-14.651	-14.651	-14.652	-14.655	-14.655	-14.659	-14.662	-14.662	-14.660	-14.659	-14.671	-14.675	-14.676	-14.676	-14.686	-14.715	-14.730
HEIGHT OF BANKING(+) / DEPTH OF CUTTING(-) (PFL-GL)	+1.209	+0.783	+1.352	+1.505	+1.398	+1.267	+1.067	+1.662	+2.133	+2.476	+2.777	+2.811	+2.859	+2.885	+3.005	+2.971	+2.936	+2.958	+3.089	+3.152
EXG GROUND LEVEL AT CENTER LINE OF DFC TRACK (GL)	262.195	262.607	262.024	261.857	261.949	262.066	262.252	261.843	261.158	260.800	260.485	260.435	260.321	260.298	260.142	260.140	260.136	260.993	260.735	260.897
EXG GROUND LEVEL AT TOE LOCATION OF DFC TRACK	262.462	262.386	262.068	261.990	261.917	261.960	261.822	261.308	260.873	260.848	260.735	260.743	260.414	260.411	260.340	260.388	260.136	260.136	260.853	260.137
DIFFERENCE BETWEEN DFC FORMATION LEVEL AND EXG.FORMATION LEVEL (PFL-EFL)	0.234	0.255	0.274	0.283	0.286	0.285	0.276	0.273	0.296	0.317	0.324	0.327	0.425	0.440	0.434	0.413	0.398	0.378	0.369	0.395
DFC FORMATION LEVEL (PFL)	263.404	263.390	263.376	263.362	263.347	263.333	263.319	263.305	263.291	263.276	263.262	263.246	263.190	263.163	263.147	263.131	263.114	263.092	263.065	263.049
EXG. FORMATION LEVEL OF EXG IR UP MAIN LINE (EFL)	263.170	263.135	263.102	263.079	263.061	263.048	263.043	263.032	262.995	262.959	262.938	262.910	262.755	262.723	262.713	262.700	262.691	262.685	262.687	262.680
DIFFERENCE BETWEEN DFC RAIL LEVEL AND EXG. RAIL LEVEL (PRL - ERL)	0.276	0.296	0.315	0.324	0.328	0.328	0.317	0.314	0.336	0.359	0.366	0.368	0.467	0.482	0.476	0.472	0.465	0.440	0.420	0.411
DFC RAIL LEVEL (PRL)	264.117	264.103	264.089	264.075	264.061	264.046	264.032	264.018	264.004	263.989	263.976	263.959	263.894	263.877	263.861	263.845	263.828	263.795	263.779	263.763
EXG.RAIL LEVEL OF NEAREST IR UP MAIN LINE(ERL)	263.842	263.807	263.774	263.751	263.733	263.720	263.715	263.704	263.667	263.631	263.610	263.591	263.462	263.395	263.385	263.372	263.356	263.356	263.359	263.352
EQUIVALENT CHAINAGE ON DFC TRACK	-1236878	-1236897	-1236917	-1236937	-1236957	-1236977	-1236997	-1237017	-1237037	-1237057	-1237077	-1237097	-1237117	-1237137	-1237157	-1237177	-1237197	-1237217	-1237237	-1237257
EXISTING IR CHAINAGE	346000.0	346020.0	346040.0	346060.0	346080.0	346100.0	346120.0	346140.0	346160.0	346180.0	346200.0	346220.0	346240.0	346260.0	346280.0	346300.0	346320.0	346340.0	346360.0	346380.0

L - SECTION

NOTE:-

- DFCC WORKS ARE SHOWN IN RED.
- IR NEW WORKS ARE SHOWN IN VIOLET.
- ALL DIMENSIONS ARE SHOWN IN METRES.
- THIS DRAWING IS PREPARED BASED ON LATEST SURVEY DATA HELD ON APRIL-2022. GTS BENCH MARK OF 261.850M CONSIDERED ON TOP OF CANAL BRIDGE ABUTMENT AT DORANA VILLAGE ALONG THE NH1.
- DFC NEW CHAINAGE OF 1075.950M IS WITH REFERENCE TO THE IR KM OF 187.500KM END OF KM OF CP-303(SECTION P-3 PILKHANI END) AGAINST THE EXISTING DFC CHAINAGE. 116277.742M ISSUED VIDE LETTER NO. GOMDFCC/MB/SURVEY/2021-301-20016-011173 DT. 17.01.2023.
- BALLAST PROFILE HAS BEEN PROVIDED ACCORDING TO THE CLAUSE 1.11.3 OF STANDARD SCHEDULE OF DIMENSION(EASTERN CORRIDOR) & THE BALLAST CUSHION DIMENSION SHOWN IN 35CM ON GE-14 PARA 17. SPECIFICATIONS & RECOMMENDATIONS 2. TWO LAYER SYSTEM FIG.10.

REFERENCE DRAWINGS :-

- FOR KEY PLAN REFER DRAWING NO. 301-2/AL/0001
- FOR LEGEND AND ABBREVIATIONS REFER DRAWING NO. 301-2/AL/1000
- FOR TYPICAL SECTION OF BALLAST PROFILE (FL-RL) REFER DRG. NO. 301-2/TK/TFD/-004 (TR. 1952)

010.10.2024SUBMISSION OF AS-BUILT DRAWINGFOR APPROVAL

REV. DATE REVISION DETAILS PURPOSE OF ISSUE

SCALE
HOR - 1:1000
VER - 1:100
SHEET SIZE : A1

LEGEND:

- IR TRACK
- DFCC TRACK
- DFCC FUTURE PROPOSALS
- STRUCTURE / BUILDING
- DFCC TOE LINE
- DFCC FORMATION
- RETAINING WALL
- ROAD
- STREAM, DRAIN, NALA, CANAL.
- FENCE
- POWER LINES
- TBM
- ELECTRIC POLE/OHE MAST
- IR RAILWAY BOUNDARY
- DFCC BOUNDARY

TYPICAL SECTION

TRACK STRUCTURE	
RAIL SECTION: 60Kg/m (UIC 60Kg/m)	Difference between FL- RL (Below Rail Seat)
DFC LINE: 60Kg/m (UIC 60Kg/m)	IR Line
IR MAIN LINE: 52Kg/m	DFC
	172mm
RUBBER PAD	6mm
SLEEPER DEPTH	210mm
BALLAST CUSHION	300mm
	350mm
Total Depth (FL TO RL)	688mm
	742mm

OWNER
DEDICATED FREIGHT CORRIDOR CORPORATION OF INDIA LTD.
(A GOVERNMENT OF INDIA ENTERPRISE)
PROJECT OFFICE(AMBALA UNIT): OLD RAILWAY COLONY (NEAR ANAND MARKET),AMBALA CANTT-133001.
CORPORATE IDENTITY NO. : U60233DL2006GGI150068

ENGINEER:
DB Engineering & Consulting GmbH
Deutsche Bahn Engineering & Consulting GmbH

CONTRACTOR:
GIL - TPL JV

SUBMITTED BY	GIL - TPL JV		
	DATED	NAME	SIGNATURE
PREPARED BY			
CHECKED BY	10.10.2024	VIJAY PRATAP	
APPROVED BY	10.10.2024	PARASURAM KOTYADA	

APPROVED BY	DEUTSCHE BAHN ENGINEERING & CONSULTING GMBH		
	DATED	NAME	SIGNATURE
Sr. DE./CHIEF ENGINEER		SURESH K.YALANGI	
CHIEF TRACK ENGINEER		RAJ PAL SINGH	
T.L.		H.D. VIDJAK	

STAMP
A
AS-BUILT DRAWING
TR. Ref.:.....
ENGINEER Sign.:.....

EMPLOYER (DFCCIL): DEDICATED FREIGHT CORRIDOR CORPORATION OF INDIA LTD.

AS BUILT DRAWING

TITLE	AS-BUILT PLAN AND PROFILE	DFCC APPR. NO. -
	FROM IR KM: 346.000 TO 346.500	ENGG. APPR. NO. -
	FROM DFC KM: 1236.878 TO 1237.378	DRG. NO. :301-2/AL/A/1318
		SHEET NO. : 1 OF 1
		DATE : 10.10.2024
		STATUS A

TR.