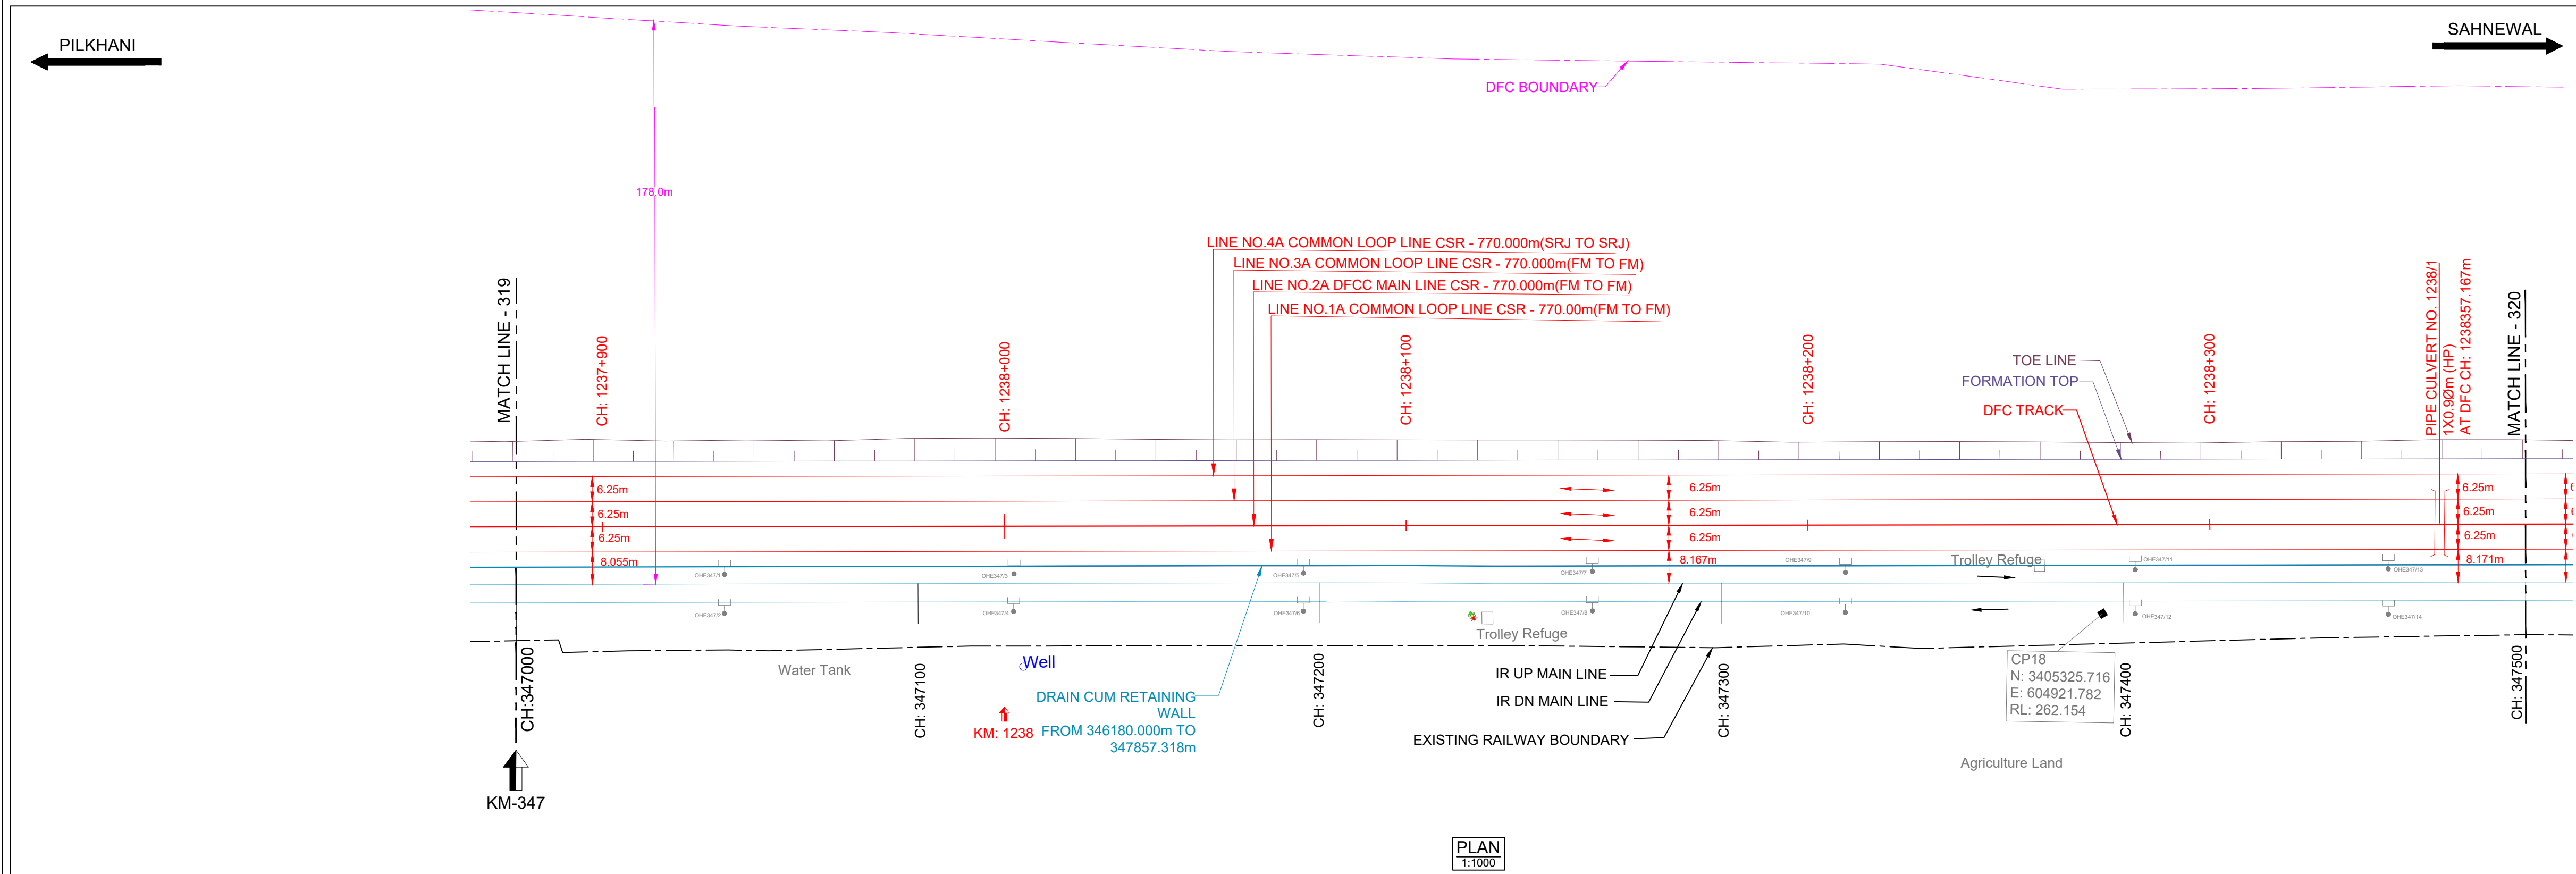


DATUM ABOVE MSL : 257 m

HORIZONTAL ALIGNMENT	L = 3014.655m																			
VERTICAL ALIGNMENT	L=2484.775 m 1 IN 1219.242 F																			
TRACK DISTANCE FROM EXISTING NEAREST IR UP MAIN LINE TO DFC MAIN LINE	14.320	14.304	14.289	14.277	14.264	14.248	14.232	14.212	14.193	14.189	14.184	14.238	14.401	14.426	14.430	14.451	14.453	14.449	14.445	14.440
HEIGHT OF BANKING(+) / DEPTH OF CUTTING(-) (PFL-GL)	+2.792	+3.014	+2.899	+2.914	+2.792	+3.042	+3.033	+2.974	+2.740	+2.507	+2.562	+2.939	+2.902	+2.403	+2.028	+1.911	+2.065	+1.995	+1.719	+1.660
EXG GROUND LEVEL AT CENTER LINE OF DFC TRACK (GL)	259.614	259.575	259.674	259.643	259.756	259.482	259.474	259.517	259.735	259.951	259.960	259.486	259.507	260.592	260.332	260.432	260.262	260.316	260.575	260.618
EXG GROUND LEVEL AT TOE LOCATION OF DFC TRACK	259.950	259.761	259.915	259.834	259.861	259.605	259.577	259.609	259.714	259.792	259.753	259.765	259.781	259.954	259.854	260.053	259.953	260.004	259.997	260.102
DIFFERENCE BETWEEN DFC FORMATION LEVEL AND EXG.FORMATION LEVEL(PFL-EFL)	0.409	0.399	0.381	0.353	0.329	0.320	0.311	0.302	0.311	0.289	0.280	0.295	0.297	0.304	0.302	0.285	0.281	0.282	0.294	0.318
DFC FORMATION LEVEL (PFL)	262.606	262.589	262.573	262.557	262.540	262.524	262.196	262.491	262.475	262.458	262.442	262.425	262.409	262.393	262.360	262.343	262.327	262.311	262.294	262.278
EXG. FORMATION LEVEL OF EXG IR UP MAIN LINE (EFL)	262.197	262.190	262.192	262.204	262.211	262.204	262.166	262.189	262.164	262.169	262.162	262.130	262.112	262.089	262.068	262.058	262.046	262.029	262.000	261.960
DIFFERENCE BETWEEN DFC RAIL LEVEL AND EXG. RAIL LEVEL (PRL - ERL)	0.451	0.441	0.423	0.394	0.371	0.362	0.353	0.344	0.352	0.331	0.322	0.337	0.339	0.345	0.343	0.327	0.323	0.324	0.336	0.360
DFC RAIL LEVEL (PRL)	263.320	263.303	263.287	263.270	263.254	263.238	263.221	263.205	263.188	263.172	263.156	263.139	263.123	263.106	263.074	263.057	263.041	263.024	263.008	262.992
EXG.RAIL LEVEL OF NEAREST IR UP MAIN LINE(ERL)	262.869	262.862	262.864	262.876	262.883	262.876	262.868	262.861	262.836	262.841	262.834	262.802	262.784	262.761	262.730	262.730	262.718	262.701	262.672	262.632
EQUIVALENT CHAINAGE ON DFC TRACK	1237876.0	1237897.9	1237917.9	1237937.9	1237957.9	1237977.9	1237997.9	1238017.9	1238037.9	1238057.9	1238077.9	1238096.0	1238116.1	1238137.9	1238157.9	1238177.9	1238197.9	1238217.9	1238237.9	1238257.9
EXISTING IR CHAINAGE	347000.0	347020.0	347040.0	347060.0	347080.0	347100.0	347120.0	347140.0	347160.0	347180.0	347200.0	347220.0	347240.0	347260.0	347280.0	347300.0	347320.0	347340.0	347360.0	347380.0

L - SECTION


- NOTE:-
- DFCC WORKS ARE SHOWN IN RED.
 - IR NEW WORKS ARE SHOWN IN VIOLET.
 - ALL DIMENSIONS ARE SHOWN IN METRES.
 - THIS DRAWING IS PREPARED BASED ON LATEST SURVEY DATA HELD ON APRIL-2022. GTS BENCH MARK OF 261.85M CONSIDERED ON TOP OF CANAL BRIDGE ABUTMENT AT DORANA VILLAGE ALONG THE NH1.
 - DFC NEW CHAINAGE OF 1075.950M IS WITH REFERENCE TO THE IR KM OF 187.500KM END OF KM OF CP-303(SECTION P-3 PILKHANI END) AGAINST THE EXISTING DFC CHAINAGE. 116277.742M ISSUED VIDE LETTER NO. GCM/DFCC/COMB/SURVEY/2021-301-2301/6-011173 DT. 17.01.2023.
 - BALLAST PROFILE HAS BEEN PROVIDED ACCORDING TO THE CLAUSE 1.11.3 OF STANDARD SCHEDULE OF DIMENSION(EASTERN CORRIDOR) & THE BALLAST CUSHION DIMENSION SHOWN IN 35CM ON GE-14 PARA 17. SPECIFICATIONS & RECOMMENDATIONS 2. TWO LAYER SYSTEM FIG.10.

REFERENCE DRAWINGS :-

- FOR KEY PLAN REFER DRAWING NO. 301-2/AL/0001
- FOR LEGEND AND ABBREVIATIONS REFER DRAWING NO. 301-2/AL/1000
- FOR TYPICAL SECTION OF BALLAST PROFILE (FL-RL) REFFER DRG. NO. 301-2/TK/TFD/-004 (TR.1952)

REV.	DATE	REVISION DETAILS	PURPOSE OF ISSUE
0	10.10.2024	SUBMISSION OF AS-BUILT DRAWING	FOR APPROVAL

SCALE	LEGEND:
HOR - 1:1000 0 10 20 30 40m 0 1 2 3 4m	IR TRACK DFCC TRACK DFCC FUTURE PROPOSALS STRUCTURE / BUILDING DFCC TOE LINE DFCC FORMATION RETAINING WALL ROAD STREAM, DRAIN, NALA, CANAL. FENCE POWER LINES TBM ELECTRIC POLE/OHE MAST IR RAILWAY BOUNDARY DFCC BOUNDARY

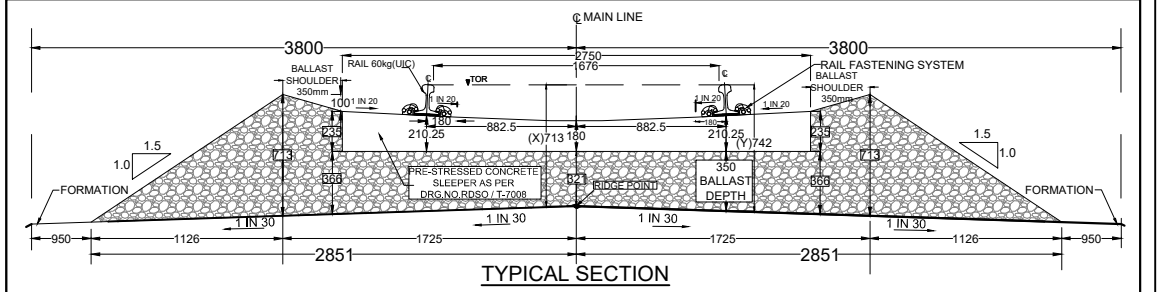

TRACK STRUCTURE		
RAIL SECTION: 60Kg/m (UIC 60Kg/m) DFC LINE: 60Kg/m (UIC 60Kg/m) IR MAIN LINE: 52Kg/m	Difference between FL- RL (Below Rail Seat)	
	IR Line	DFC
RUBBER PAD	172mm	172mm
SLEEPER DEPTH	6mm	10mm
BALLAST CUSHION	210mm	210mm
	300mm	350mm
Total Depth (FL TO RL)	688mm	742mm

OWNER
DEDICATED FREIGHT CORRIDOR CORPORATION OF INDIA LTD.
(A GOVERNMENT OF INDIA ENTERPRISE)
PROJECT OFFICE(AMBALA UNIT): OLD RAILWAY COLONY (NEAR ANAND MARKET),AMBALA CANTT-133001.
CORPORATE IDENTITY NO. : U60232DL2006001150068

ENGINEER:
DB Engineering & Consulting GmbH
Deutsche Bahn Engineering & Consulting GmbH

CONTRACTOR:
GIL - TPL JV
GAR TATA

SUBMITTED BY	GIL - TPL JV		
	DATED	NAME	SIGNATURE
PREPARED BY	10.10.2024	VIJAY PRATAP	
CHECKED BY	10.10.2024	PARASURAM KOTYADA	
APPROVED BY	10.10.2024	PARASURAM KOTYADA	
APPROVED BY	DEUTSCHE BAHN ENGINEERING & CONSULTING GMBH		
	DATED	NAME	SIGNATURE
Sr. DE./CHIEF ENGINEER		SURESH K.YALANGI	
CHIEF TRACK ENGINEER		RAJ PAL SINGH	
T.L.		H.D. VIDJAK	

STAMP	A AS-BUILT DRAWING TR. Ref:..... ENGINEER Sign.:.....
EMPLOYER (DFCCIL):	DEDICATED FREIGHT CORRIDOR CORPORATION OF INDIA LTD.

AS BUILT DRAWING		
TITLE AS-BUILT PLAN AND PROFILE FROM IR KM: 347.000 TO 347.500 FROM DFC KM: 1237.878 TO 1238.378	DFCC APPR. NO. - ENGG. APPR. NO. - DRG. NO. -301-2/AL/A/1320 SHEET NO. : 1 OF 1 DATE : 10.10.2024	STATUS A

TR.