


PILKHANI

SAHNEWAL

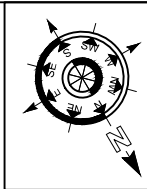

NOTE:-

- DFCC WORKS ARE SHOWN IN RED.
- IR NEW WORKS ARE SHOWN IN VIOLET.
- ALL DIMENSIONS ARE SHOWN IN METRES.
- THIS DRAWING IS PREPARED BASED ON LATEST SURVEY DATA HELD ON APRIL-2022. GTS BENCH MARK OF 261.850M CONSIDERED ON TOP OF CANAL BRIDGE ABUTMENT AT DORANA VILLAGE ALONG THE NH1.
- DFC NEW CHAINAGE OF 1075.950M IS WITH REFERENCE TO THE IR KM OF 187.500KM END OF KM OF CP-303(SECTION P-3 PILKHANI END) AGAINST THE EXISTING DFC CHAINAGE. 116277.742M ISSUED VIDE LETTER NO. GOMDFCC/UMBSURVEY/2021-301-230116-011173 DT. 17.01.2023.
- BALLAST PROFILE HAS BEEN PROVIDED ACCORDING TO THE CLAUSE 1.11.3 OF STANDARD SCHEDULE OF DIMENSION(EASTERN CORRIDOR) & THE BALLAST CUSHION DIMENSION SHOWN IN 35CM ON GE-14 PARA 17. SPECIFICATIONS & RECOMMENDATIONS 2. TWO LAYER SYSTEM FIG.10.

DRG NO. - 301-2/AL/A/1322

REFERENCE DRAWINGS :-

- FOR KEY PLAN REFER DRAWING NO. 301-2/AL/0001
- FOR LEGEND AND ABBREVIATIONS REFER DRAWING NO. 301-2/AL/1000
- FOR TYPICAL SECTION OF BALLAST PROFILE (FL-RL) REFFER DRG. NO. 301-2/TK/TFD/-004 (TR. 1952)

REV.	DATE	REVISION DETAILS	PURPOSE OF ISSUE
0	10.10.2024	SUBMISSION OF AS-BUILT DRAWING	FOR APPROVAL

SCALE

HOR - 1:1000

VER - 1:100

SHEET SIZE : A1

LEGEND:

IR TRACK

DFCC TRACK

DFCC FUTURE PROPOSALS

STRUCTURE / BUILDING

DFCC TOE LINE

DFCC FORMATION

RETAINING WALL

ROAD

STREAM, DRAIN, NALA, CANAL.

FENCE


POWER LINES

TBM

ELECTRIC POLE/OHE MAST

IR RAILWAY BOUNDARY

DFCC BOUNDARY

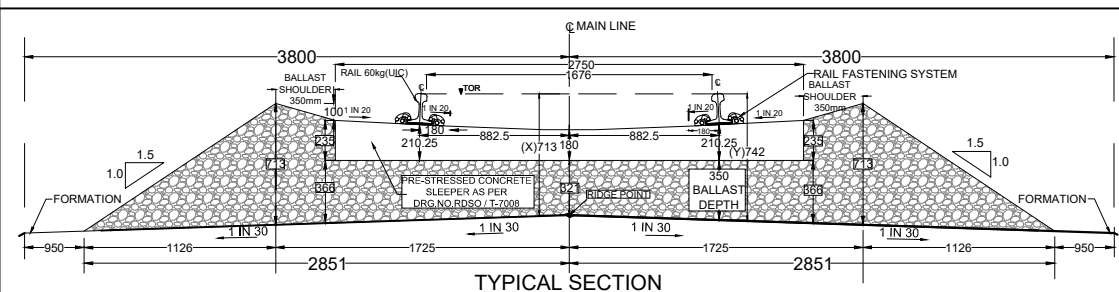

TRACK STRUCTURE		
RAIL SECTION: 60Kg/m (UIC 60Kg/m) DFC LINE: 60Kg/m (UIC 60Kg/m) IR MAIN LINE: 52Kg/m	Difference between FL - RL (Below Rail Seat)	
	IR Line	DFC
RUBBER PAD	172mm	172mm
SLEEPER DEPTH	210mm	210mm
BALLAST CUSHION	300mm	350mm
Total Depth (FL TO RL)	688mm	742mm

OWNER DEDICATED FREIGHT CORRIDOR CORPORATION OF INDIA LTD.
(A GOVERNMENT OF INDIA ENTERPRISE)
PROJECT OFFICE(AMBALA UNIT): OLD RAILWAY COLONY (NEAR ANAND MARKET),AMBALA CANTT-133001.
CORPORATE IDENTITY NO. : U60232DL2006GGI155068

ENGINEER: DB Engineering & Consulting GmbH
Deutsche Bahn Engineering & Consulting GmbH

CONTRACTOR: GIL - TPL JV
GAR TATA

SUBMITTED BY	GIL - TPL JV		
	DATED	NAME	SIGNATURE
PREPARED BY			
CHECKED BY	10.10.2024	VIJAY PRATAP	
APPROVED BY	10.10.2024	PARASURAM KOTYADA	



APPROVED BY	DEUTSCHE BAHN ENGINEERING & CONSULTING GMBH		
	DATED	NAME	SIGNATURE
Sr. DE./CHIEF ENGINEER		SURESH K.YALANGI	
CHIEF TRACK ENGINEER		RAJ PAL SINGH	
T.L.		H.D. VIDJAK	

STAMP	A AS-BUILT DRAWING TR. Ref.:..... ENGINEER Sign.:.....		
EMPLOYER (DFCCIL):	DEDICATED FREIGHT CORRIDOR CORPORATION OF INDIA LTD.		

AS BUILT DRAWING

TITLE	DFCC APPR. NO. -	STATUS A
AS-BUILT PLAN AND PROFILE	ENGG. APPR. NO. -	
FROM IR KM: 348.000 TO 348.500	DRG. NO. -301-2/AL/A/1322	
FROM DFC KM: 1238.852 TO 1239.352	SHEET NO. : 1 OF 1	
	DATE : 10.10.2024	

TR.

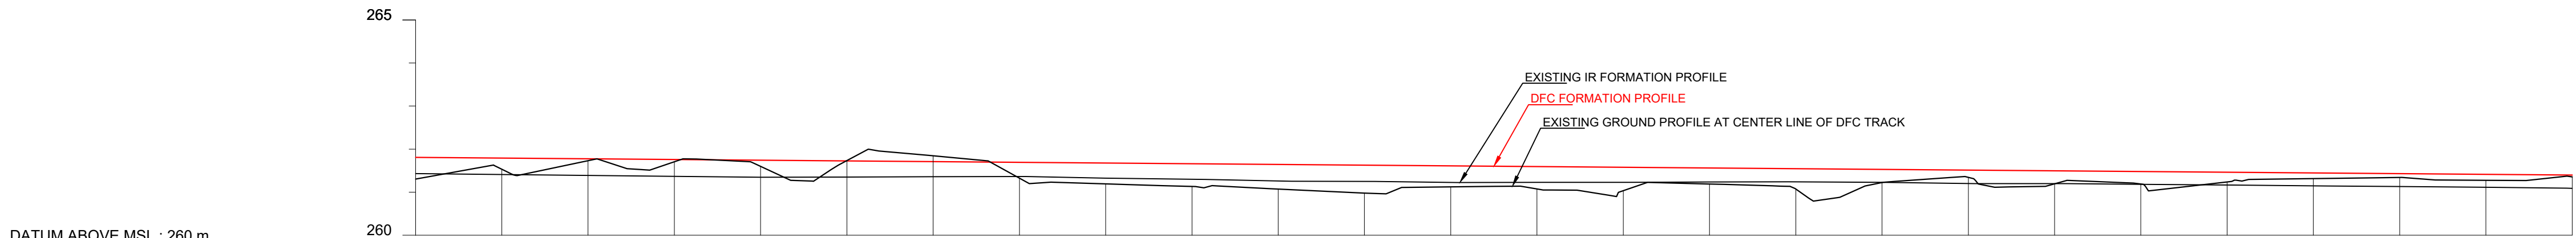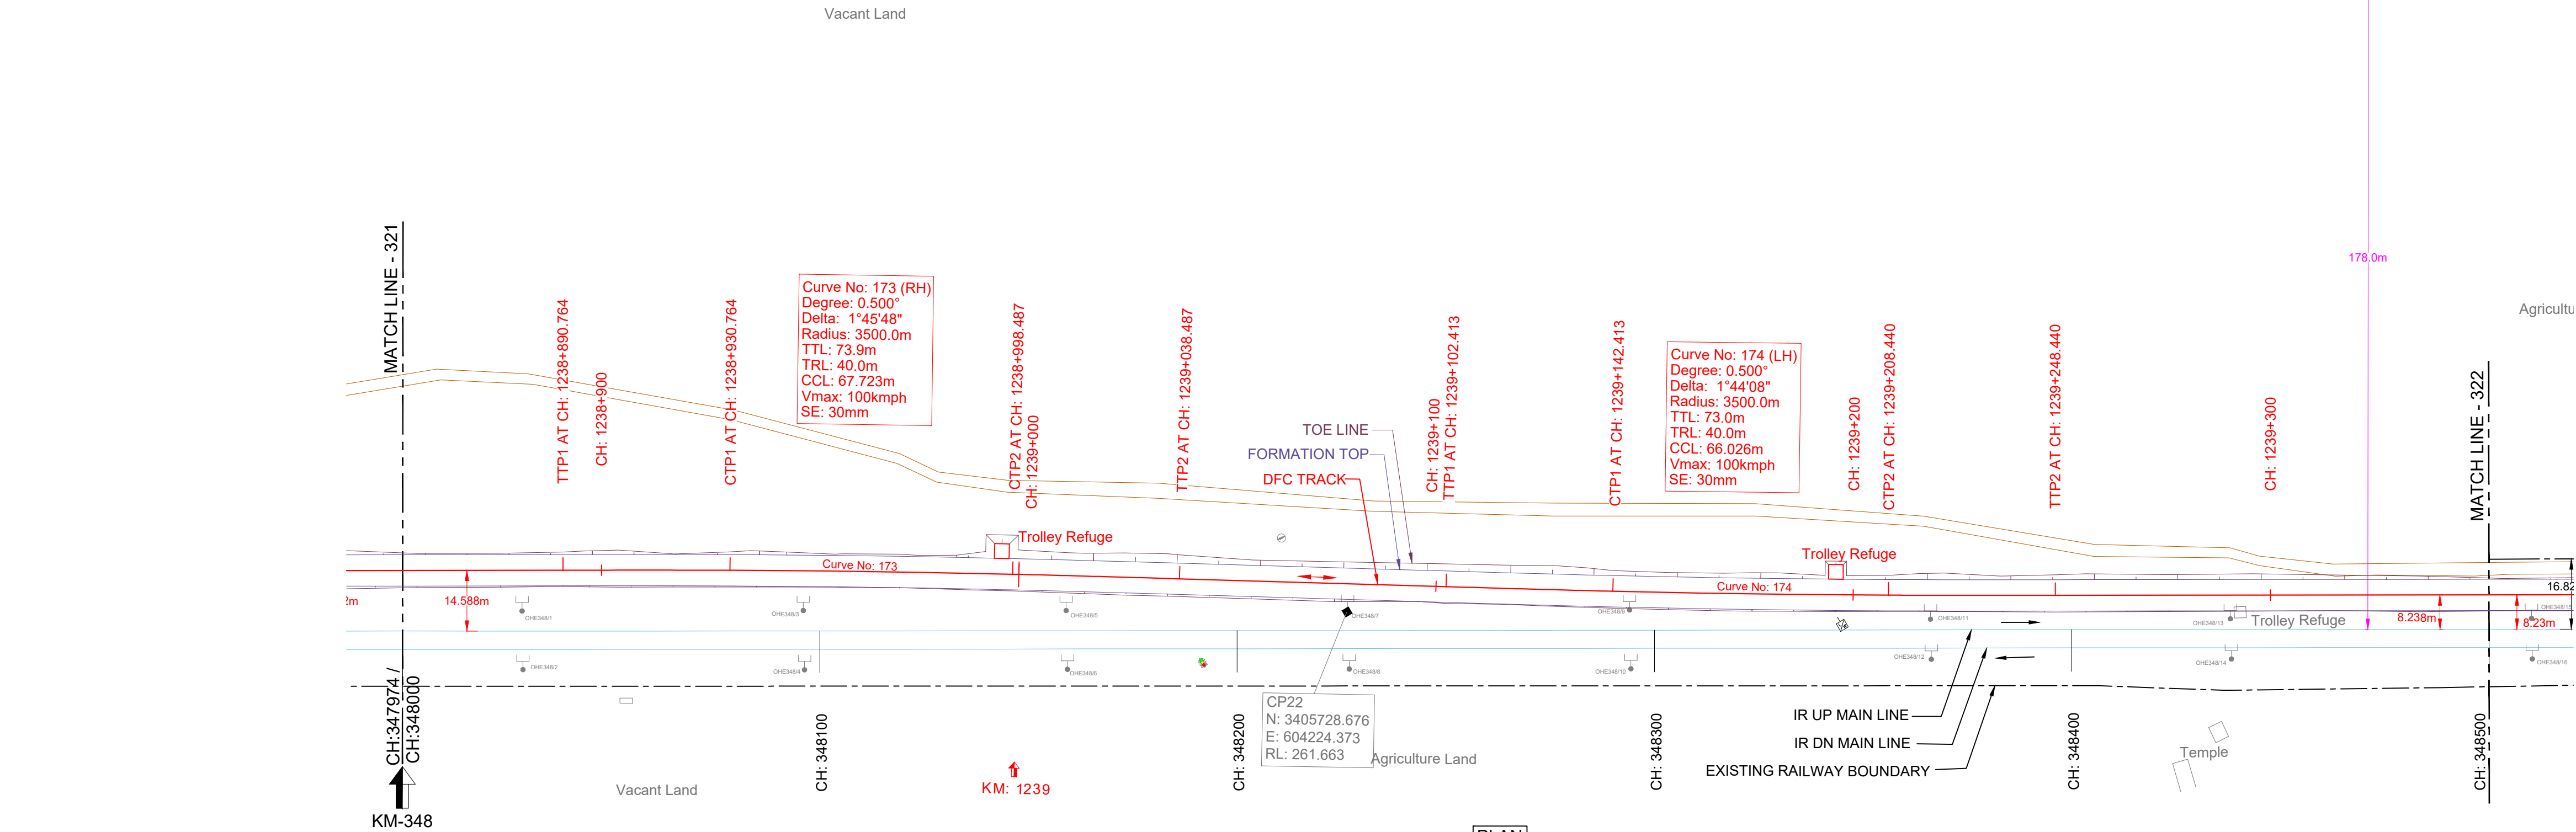

HORIZONTAL ALIGNMENT	L = 3014.655m TL= 40m R =3500m TL= 40m L = 63.925m TL= 40m R =-3500m TL= 40m L = 4280.337m																									
VERTICAL ALIGNMENT	L=2484.775 m 1 IN 1219.242 F																									
TRACK DISTANCE FROM EXISTING NEAREST IR UP MAIN LINE TO DFC MAIN LINE	14.535	14.593	14.612	14.618	14.554	14.399	14.131	13.721	13.199	12.617	12.019	11.409	10.798	10.195	9.622	9.127	8.744	8.469	8.311	8.247	8.231	8.221	8.211	8.224	8.242	8.233
HEIGHT OF BANKING(+)/ DEPTH OF CUTTING(-) (PFL-GL)	+0.506	+0.254	+0.045	+0.056	+0.139	-0.006	-0.136	+0.364	+0.484	+0.528	+0.573	+0.649	+0.488	+0.519	+0.542	+0.372	+0.473	+0.304	+0.167	+0.302	+0.290	+0.227	+0.133	+0.088	+0.137	+0.044
EXG GROUND LEVEL AT CENTER LINE OF DFC TRACK (GL)	261.301	261.537	261.729	261.702	261.603	261.731	261.845	261.328	261.192	261.132	261.070	260.978	261.122	261.075	261.035	261.189	261.072	261.224	261.345	261.193	261.189	261.236	261.313	261.342	261.276	261.353
EXG GROUND LEVEL AT TOE LOCATION OF DFC TRACK	261.300	261.526	261.778	261.849	261.793	261.735	261.697	261.443	261.234	261.098	261.035	260.902	261.122	261.041	260.620	260.996	260.906	261.072	260.788	260.646	260.746	260.757	260.634	260.753	260.884	261.137
DIFFERENCE BETWEEN DFC FORMATION LEVEL AND EXG.FORMATION LEVEL.(PFL-EFL)	0.376	0.381	0.385	0.390	0.394	0.373	0.352	0.330	0.353	0.360	0.385	0.378	0.383	0.387	0.349	0.326	0.304	0.302	0.314	0.299	0.295	0.296	0.299	0.298	0.299	0.308
DFC FORMATION LEVEL (PFL)	261.807	261.791	261.774	261.758	261.741	261.725	261.709	261.692	261.676	261.659	261.643	261.627	261.610	261.594	261.577	261.561	261.545	261.528	261.512	261.495	261.479	261.463	261.446	261.430	261.413	261.397
EXG. FORMATION LEVEL OF EXG IR UP MAIN LINE (EFL)	261.431	261.410	261.389	261.368	261.347	261.352	261.357	261.362	261.323	261.299	261.258	261.249	261.227	261.227	261.228	261.235	261.241	261.226	261.198	261.196	261.184	261.167	261.147	261.132	261.114	261.089
DIFFERENCE BETWEEN DFC RAIL LEVEL AND EXG. RAIL LEVEL (PRL - ERL)	0.418	0.422	0.427	0.432	0.436	0.415	0.393	0.372	0.395	0.402	0.427	0.420	0.425	0.408	0.391	0.367	0.345	0.344	0.355	0.341	0.337	0.338	0.341	0.339	0.341	0.350
DFC RAIL LEVEL (PRL)	262.521	262.505	262.488	262.472	262.455	262.439	262.423	262.406	262.390	262.373	262.357	262.341	262.324	262.308	262.291	262.275	262.258	262.242	262.226	262.209	262.193	262.176	262.160	262.144	262.127	262.111
EXG.RAIL LEVEL OF NEAREST IR UP MAIN LINE(ERL)	262.103	262.082	262.061	262.040	262.019	262.024	262.029	262.034	261.995	261.971	261.930	261.921	261.889	261.889	261.900	261.907	261.913	261.898	261.870	261.868	261.856	261.839	261.819	261.804	261.786	261.761
EQUIVALENT CHAINAGE ON DFC TRACK	1238851.7	1238871.7	1238891.7	1238911.7	1238931.7	1238951.7	1238971.7	1238991.7	1239011.7	1239031.7	1239051.7	1239071.7	1239091.7	1239111.7	1239131.7	1239151.7	1239171.7	1239191.7	1239211.7	1239231.7	1239251.7	1239271.7	1239291.7	1239311.7	1239331.7	1239351.7
EXISTING IR CHAINAGE	348000.0	348020.0	348040.0	348060.0	348080.0	348100.0	348120.0	348140.0	348160.0	348180.0	348200.0	348220.0	348240.0	348260.0	348280.0	348300.0	348320.0	348340.0	348360.0	348380.0	348400.0	348420.0	348440.0	348460.0	348480.0	348500.0

L - SECTION