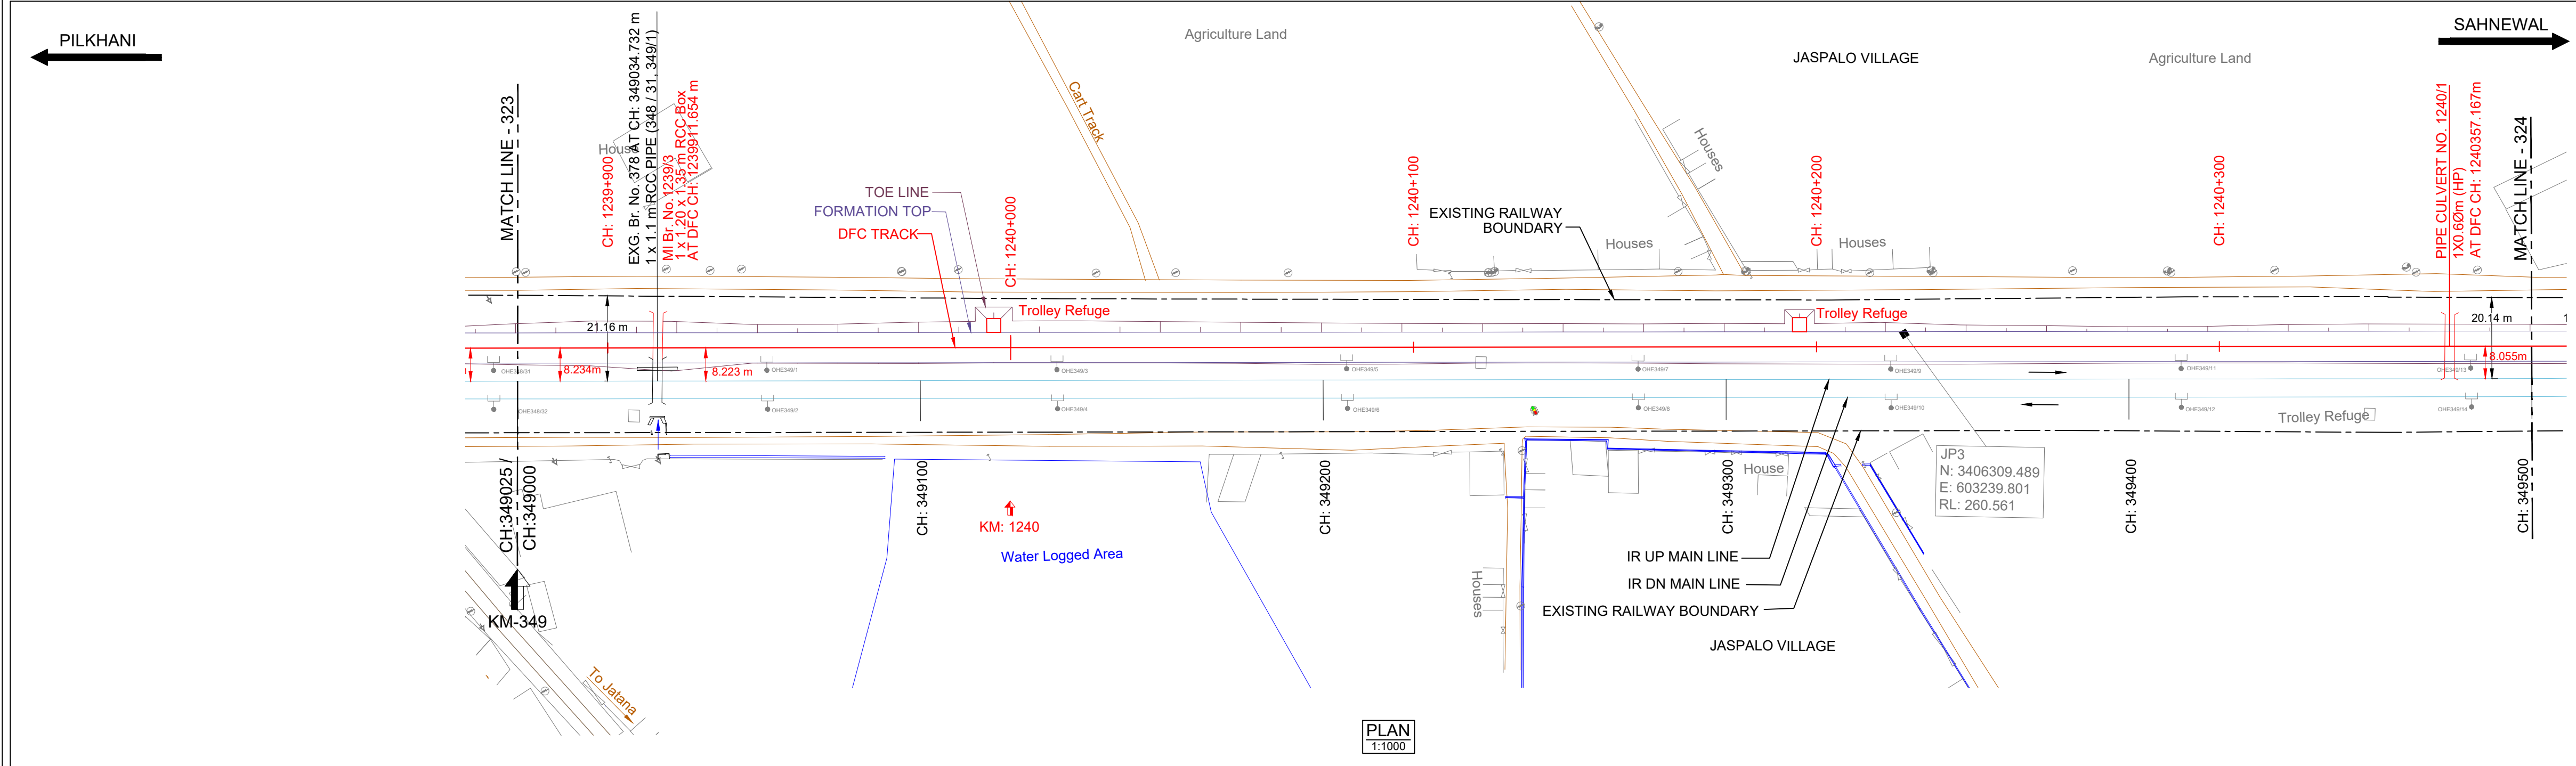


HORIZONTAL ALIGNMENT	L = 4280.337m																			
VERTICAL ALIGNMENT	L=1612.829 m 1 IN 1005.990																			
TRACK DISTANCE FROM EXISTING NEAREST IR UP MAIN LINE TO DFC MAIN LINE	8.246	8.228	8.225	8.217	8.208	8.196	8.180	8.160	8.133	8.119	8.112	8.108	8.102	8.099	8.098	8.097	8.096	8.095	8.094	8.023
HEIGHT OF BANKING(+) / DEPTH OF CUTTING(-) (PFL-GL)	+0.505	+0.742	+0.979	+0.956	+0.986	+0.987	+0.986	+0.986	+0.986	+0.985	+0.976	+0.985	+0.921	+0.899	+0.894	+0.905	+0.325	+0.319	+0.467	+0.538
EXG GROUND LEVEL AT CENTER LINE OF DFC TRACK (GL)	260.410	260.153	259.896	259.899	259.849	259.829	259.810	259.790	259.770	259.751	259.740	259.711	259.755	259.757	259.803	259.712	259.834	260.192	260.053	259.971
EXG GROUND LEVEL AT TOE LOCATION OF DFC TRACK	259.658	259.316	259.361	259.786	259.674	259.413	259.267	259.230	259.318	259.389	259.460	259.525	259.539	259.513	259.537	259.482	259.630	259.769	259.535	259.462
DIFFERENCE BETWEEN DFC FORMATION LEVEL AND EXG.FORMATION LEVEL (PFL-EFL)	0.007	0.008	-0.001	0.007	0.022	0.037	0.046	0.065	0.100	0.123	0.158	0.165	0.177	0.175	0.170	0.193	0.282	0.276	0.270	0.267
DFC FORMATION LEVEL (PFL)	260.915	260.895	260.875	260.855	260.835	260.816	260.796	260.776	260.756	260.736	260.716	260.696	260.676	260.656	260.637	260.617	260.597	260.577	260.557	260.418
EXG. FORMATION LEVEL OF EXG IR UP MAIN LINE (EFL)	260.908	260.887	260.876	260.848	260.813	260.779	260.750	260.711	260.656	260.613	260.558	260.531	260.499	260.481	260.467	260.424	260.371	260.321	260.273	260.135
DIFFERENCE BETWEEN DFC RAIL LEVEL AND EXG. RAIL LEVEL (PRL - ERL)	0.048	0.049	0.040	0.048	0.064	0.078	0.087	0.106	0.141	0.165	0.199	0.206	0.218	0.217	0.211	0.234	0.267	0.297	0.325	0.324
DFC RAIL LEVEL (PRL)	261.528	261.608	261.588	261.569	261.549	261.529	261.509	261.489	261.469	261.449	261.429	261.410	261.390	261.370	261.350	261.330	261.310	261.290	261.270	261.191
EXG.RAIL LEVEL OF NEAREST IR UP MAIN LINE(ERL)	261.580	261.559	261.548	261.520	261.485	261.451	261.422	261.383	261.328	261.285	261.230	261.203	261.171	261.153	261.139	261.096	261.043	260.993	260.945	260.880
EQUIVALENT CHAINAGE ON DFC TRACK	349000.0	349020.0	349040.0	349060.0	349080.0	349100.0	349120.0	349140.0	349160.0	349180.0	349200.0	349220.0	349240.0	349260.0	349280.0	349300.0	349320.0	349340.0	349360.0	349380.0
EXISTING IR CHAINAGE	349000.0	349020.0	349040.0	349060.0	349080.0	349100.0	349120.0	349140.0	349160.0	349180.0	349200.0	349220.0	349240.0	349260.0	349280.0	349300.0	349320.0	349340.0	349360.0	349380.0

L - SECTION

NOTE:-

- DFCC WORKS ARE SHOWN IN RED.
- IR NEW WORKS ARE SHOWN IN VIOLET.
- ALL DIMENSIONS ARE SHOWN IN METRES.
- THIS DRAWING IS PREPARED BASED ON LATEST SURVEY DATA HELD ON APRIL-2022. GTS BENCH MARK OF 261.850M CONSIDERED ON TOP OF CANAL BRIDGE ABUTMENT AT DORAH VILLAGE ALONG THE NH1.
- DFC NEW CHAINAGE OF 1075.950M IS WITH REFERENCE TO THE IR KM OF 187.500KM END OF KM OF CP-303(SECTION P-3 PILKHANI END) AGAINST THE EXISTING DFC CHAINAGE. 116277.742M ISSUED VIDE LETTER NO. GCM/DFC/CUMB/SURVEY/2021-301-20116-011173 DT. 17.01.2023.
- BALLAST PROFILE HAS BEEN PROVIDED ACCORDING TO THE CLAUSE 1.11.3 OF STANDARD SCHEDULE OF DIMENSION(EASTERN CORRIDOR) & THE BALLAST CUSHION DIMENSION SHOWN IN 35CM ON GE-14 PARA 17. SPECIFICATIONS & RECOMMENDATIONS 2. TWO LAYER SYSTEM FIG.10.

REFERENCE DRAWINGS :-

- FOR KEY PLAN REFER DRAWING NO. 301-2/AL/0001
- FOR LEGEND AND ABBREVIATIONS REFER DRAWING NO. 301-2/AL/1000
- FOR TYPICAL SECTION OF BALLAST PROFILE (FL-RL) REFER DRG. NO. 301-2/TK/TFD/-004 (TR.1952)

010.10.2024SUBMISSION OF AS-BUILT DRAWINGFOR APPROVAL

REV. DATE REVISION DETAILS PURPOSE OF ISSUE

SCALE
HOR - 1:1000
VER - 1:100
SHEET SIZE : A1

LEGEND:

- IR TRACK
- DFCC TRACK
- DFCC FUTURE PROPOSALS
- STRUCTURE / BUILDING
- DFCC TOE LINE
- DFCC FORMATION
- RETAINING WALL
- ROAD
- STREAM, DRAIN, NALA, CANAL.
- POWER LINES
- TBM
- ELECTRIC POLE/OHE MAST
- IR RAILWAY BOUNDARY
- DFCC BOUNDARY

TYPICAL SECTION

TRACK STRUCTURE

RAIL SECTION: 60Kg/m (UIC 60Kg/m) DFC LINE: 60Kg/m (UIC 60Kg/m) IR MAIN LINE: 52Kg/m	Difference between FL- RL (Below Rail Seat)	
	IR Line	DFC
RUBBER PAD	172mm	172mm
SLEEPER DEPTH	6mm	10mm
BALLAST CUSHION	210mm	210mm
	300mm	350mm
Total Depth (FL TO RL)	688mm	742mm

OWNER

DEDICATED FREIGHT CORRIDOR CORPORATION OF INDIA LTD.
(A GOVERNMENT OF INDIA ENTERPRISE)
PROJECT OFFICE (AMBALA UNIT): OLD RAILWAY COLONY (NEAR ANAND MARKET), AMBALA CANTT-133001.
CORPORATE IDENTITY NO : U60232DL2006GG1155068

ENGINEER:

DB Engineering & Consulting GmbH

Deutsche Bahn Engineering & Consulting GmbH

CONTRACTOR:

GIL - TPL JV

GAR

TATA

SUBMITTED BY	GIL - TPL JV		
	DATED	NAME	SIGNATURE
PREPARED BY			
CHECKED BY	10.10.2024	VIJAY PRATAP	
APPROVED BY	10.10.2024	PARASURAM KOTYADA	

APPROVED BY	DEUTSCHE BAHN ENGINEERING & CONSULTING GMBH		
	DATED	NAME	SIGNATURE
Sr. DE./CHIEF ENGINEER		SURESH K.YALANGI	
CHIEF TRACK ENGINEER		RAJ PAL SINGH	
T.L.		H.D. VIDJAK	

STAMP

A AS-BUILT DRAWING
TR. Ref.:.....
ENGINEER Sign.:.....

EMPLOYER (DFCCIL):

DEDICATED FREIGHT CORRIDOR CORPORATION OF INDIA LTD.

AS BUILT DRAWING

TITLE
AS-BUILT PLAN AND PROFILE
FROM IR KM: 349.000 TO 349.500
FROM DFC KM: 1239.877 to 1240.377

DFCC APPR. NO. -
ENGG. APPR. NO. -
DRG. NO. -301-2/AL/A/1324
SHEET NO. : 1 OF 1
DATE : 10.10.2024

STATUS
A

TR.