




DEDICATED FREIGHT CORRIDOR CORPORATION OF INDIA LTD.
(A GOVERNMENT OF INDIA ENTERPRISE)

EASTERN DEDICATED FREIGHT CORRIDOR
SAHNEWAL TO PILKHANI SECTION
CONTRACT PACKAGE - 301

PLAN & PROFILE OF AS BUILT DRAWINGS FOR DFC MAIN LINE

IR CHAINAGE FROM 350.000 KM TO 354.000 KM
DFCC CHAINAGE FROM KM 1240.877 TO KM 1244.856

DESIGN CONSULTANT

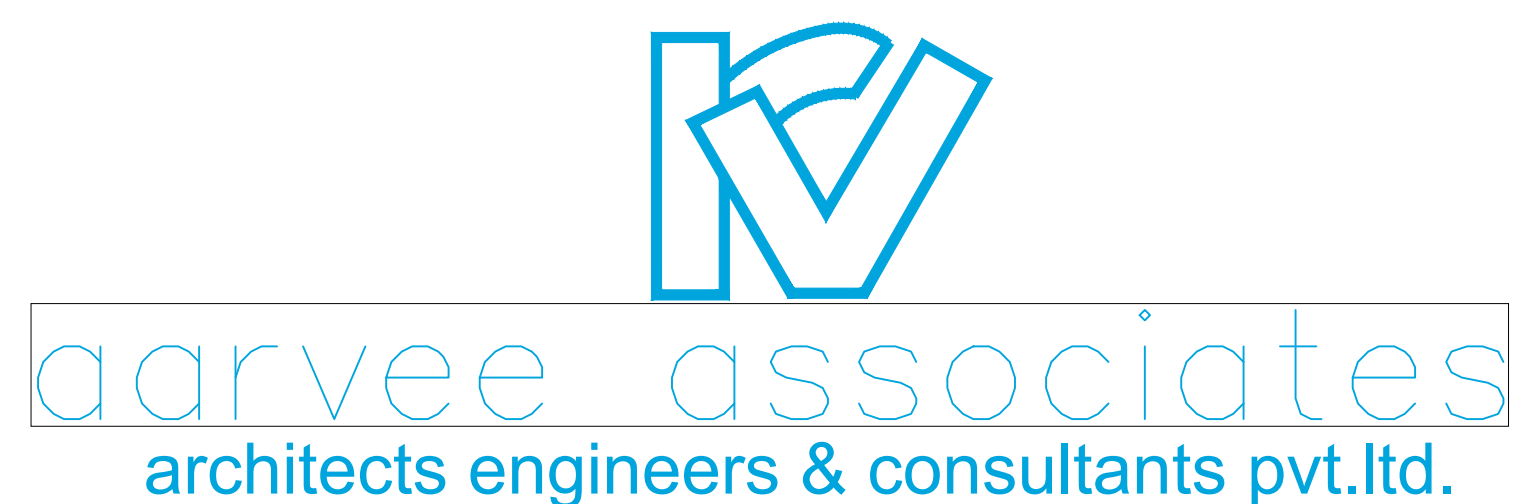


ENGINEER



CONTRACTOR CLIENT
GIL - TPL JV

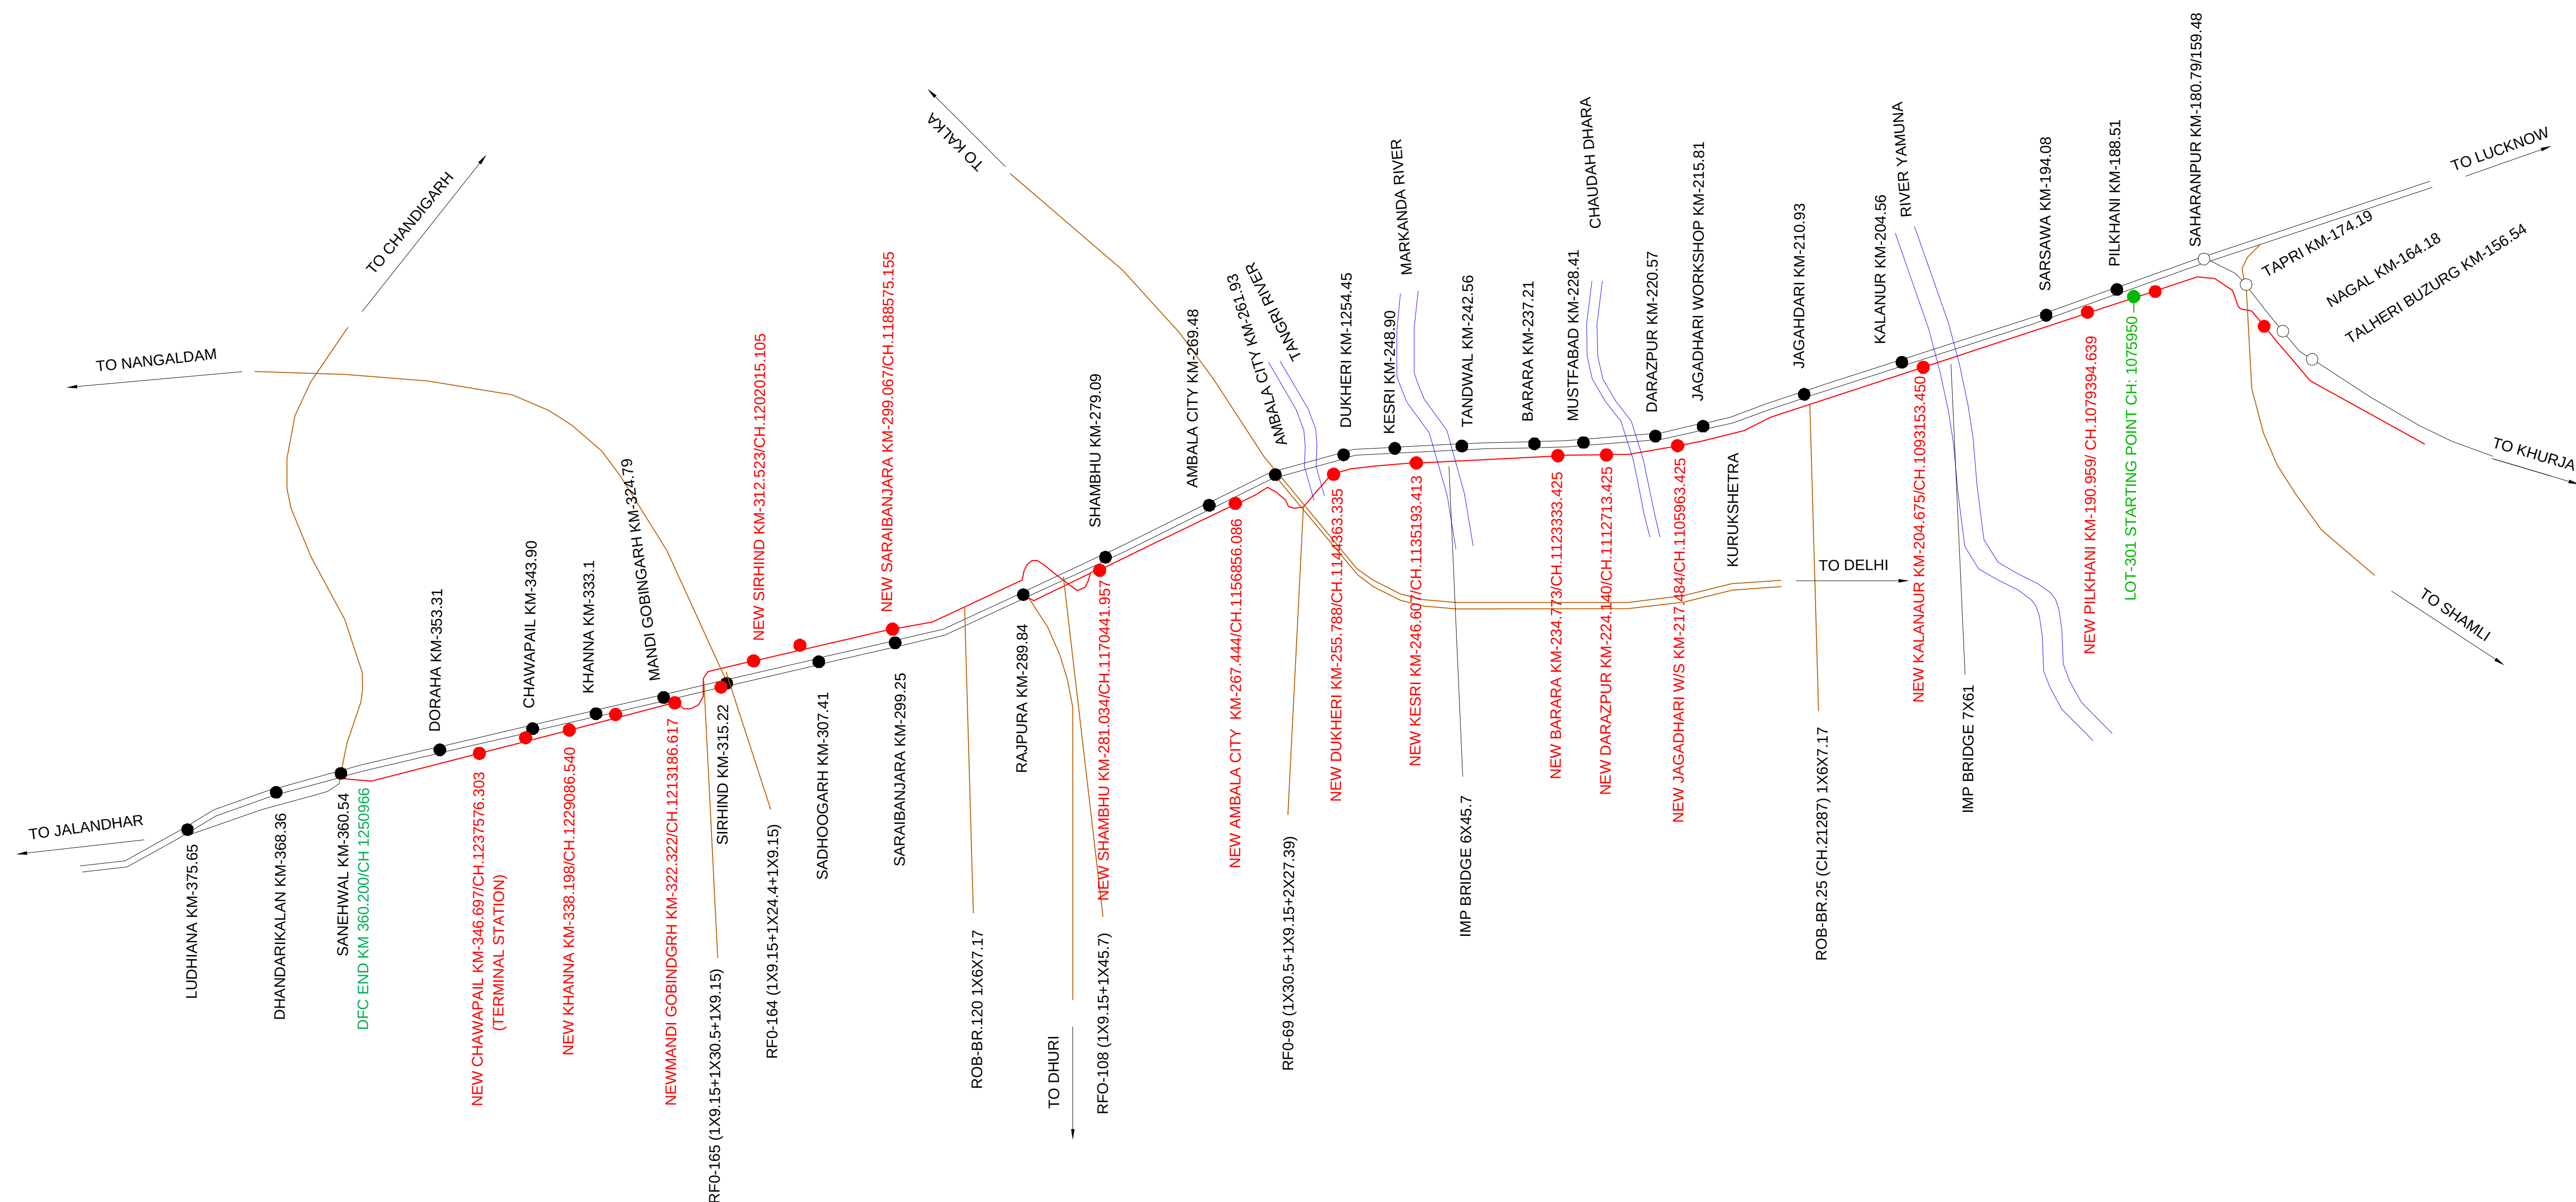


[illegible]

LEGEND	
EXISTING IR TRACK	
DFC TRACK	
DFC FUTURE PROPOSALS	
IR PROPOSALS	
TOE LINE	
FORMATION CESS	
RETAINING WALL	
DRAIN CUM RETAINING WALL	
ROAD	
STREAM, DRAIN, NALA, CANAL.	
FENCE	
POWER LINES	
GPS POINTS	
ELECTRIC POLE/OHE MAST	
EXISTING RAILWAY BOUNDARY	
DFC BOUNDARY	
DISMANTLED WORKS	
IOCL PIPE LINE	
IOCL ROW	
SIGNALLING CABLE PIPE	

ABBREVIATIONS		
1.	BL	- BED LEVEL
2.	BVC	- BEGIN OF VERTICAL CURVE
3.	Ca	- APPLIED CANT
4.	CCL	- CIRCULAR CURVE LENGTH
5.	CTP1	- COMMON TANGENT POINT
6.	CTP2	- COMMON TANGENT POINT
7.	DEGREE	- DEGREE OF CURVE
8.	DE	- DEAD END
9.	ECL	- EXISTING CLEARANCE
10.	EFB	- EXISTING FREE BOARD
11.	EFL	- EXISTING FORMATION LEVEL
12.	ERL	- EXISTING RAIL LEVEL
13.	ESL	- EXISTING SOFFIT LEVEL
14.	EVC	- END OF VERTICAL CURVE
15.	EVCL	- EXISTING VERTICAL CLEARANCE
16.	F/CSB	- FROM CENTER LINE OF STN BLDG
17.	FM	- FOULING MARK
18.	FSL	- FULL SUPPLY LEVEL
19.	HFL	- HIGH FLOOD LEVEL
20.	L	- STRAIGHT LENGTH
21.	LH	- LEFT HANDED
22.	LHS	- LIMITED HEIGHT SUBWAY
23.	PCL	- PROPOSED CLEARANCE
24.	PFB	- PROPOSED FREE BOARD
25.	PFL	- PROPOSED FORMATION LEVEL
26.	PRL	- PROPOSED RAIL LEVEL
27.	PSL	- PROPOSED SOFFIT LEVEL
28.	PVCL	- PROPOSED VERTICAL CLEARANCE
29.	PVI	- POINT OF VERTICAL INTERSECTION
30.	R	- RADIUS
31.	REV.BL	- REVISED BED LEVEL
32.	RH	- RIGHT HANDED
33.	Rr	- RESULTANT RADIUS
34.	SE	- SUPER ELEVATION
35.	SRJ	- STOCK RAIL JOINT
36.	TS	- TRAP SWITCH
37.	TTL	- TOTAL TANGENT LENGTH
38.	TTP1	- TRANSITION TANGENT POINT
39.	TTP2	- TRANSITION TANGENT POINT
40.	TL	- TRANSITION LENGTH
41.	DELTA	- DEFLECTION ANGLE

					SCALE	DESIGN CONSULTANT	CONTRACTOR	ENGINEER	OWNER	PROJECT	TITLE	DFCC APPR. NO. -			
					NOT TO SCALE	 aarvee associates architects engineers & consultants pvt.ltd.	  GIL - TPL JV	 DB Engineering & Consulting GmbH	 मेडीफ्रेट फ्रेट कॉर्पोरेश	DEDICATED FREIGHT CORRIDOR CORPORATION OF INDIA LTD. (A GOVERNMENT OF INDIA ENTERPRISE) PROJECT OFFICE(AMBALA UNIT): OLD RAILWAY COLONY (NEAR ANAND MARKET),AMBALA CANTT-133001. CORPORATE IDENTITY NO. : U60232DL2006GOI155068	EASTERN DEDICATED FREIGHT CORRIDOR SAHNEWAL TO PILKHANI CONTRACT PACKAGE - 301	ALIGNMENT DRAWINGS LEGEND AND ABBREVIATIONS	ENG. APPR. NO. -		
															DRG. NO. - 301-2/AL/1000
															SHEET NO. : 1 OF 1
REV.	DATE		REVISION DETAILS	PURPOSE OF ISSUE								DATE : 15-06-2024	0	A	

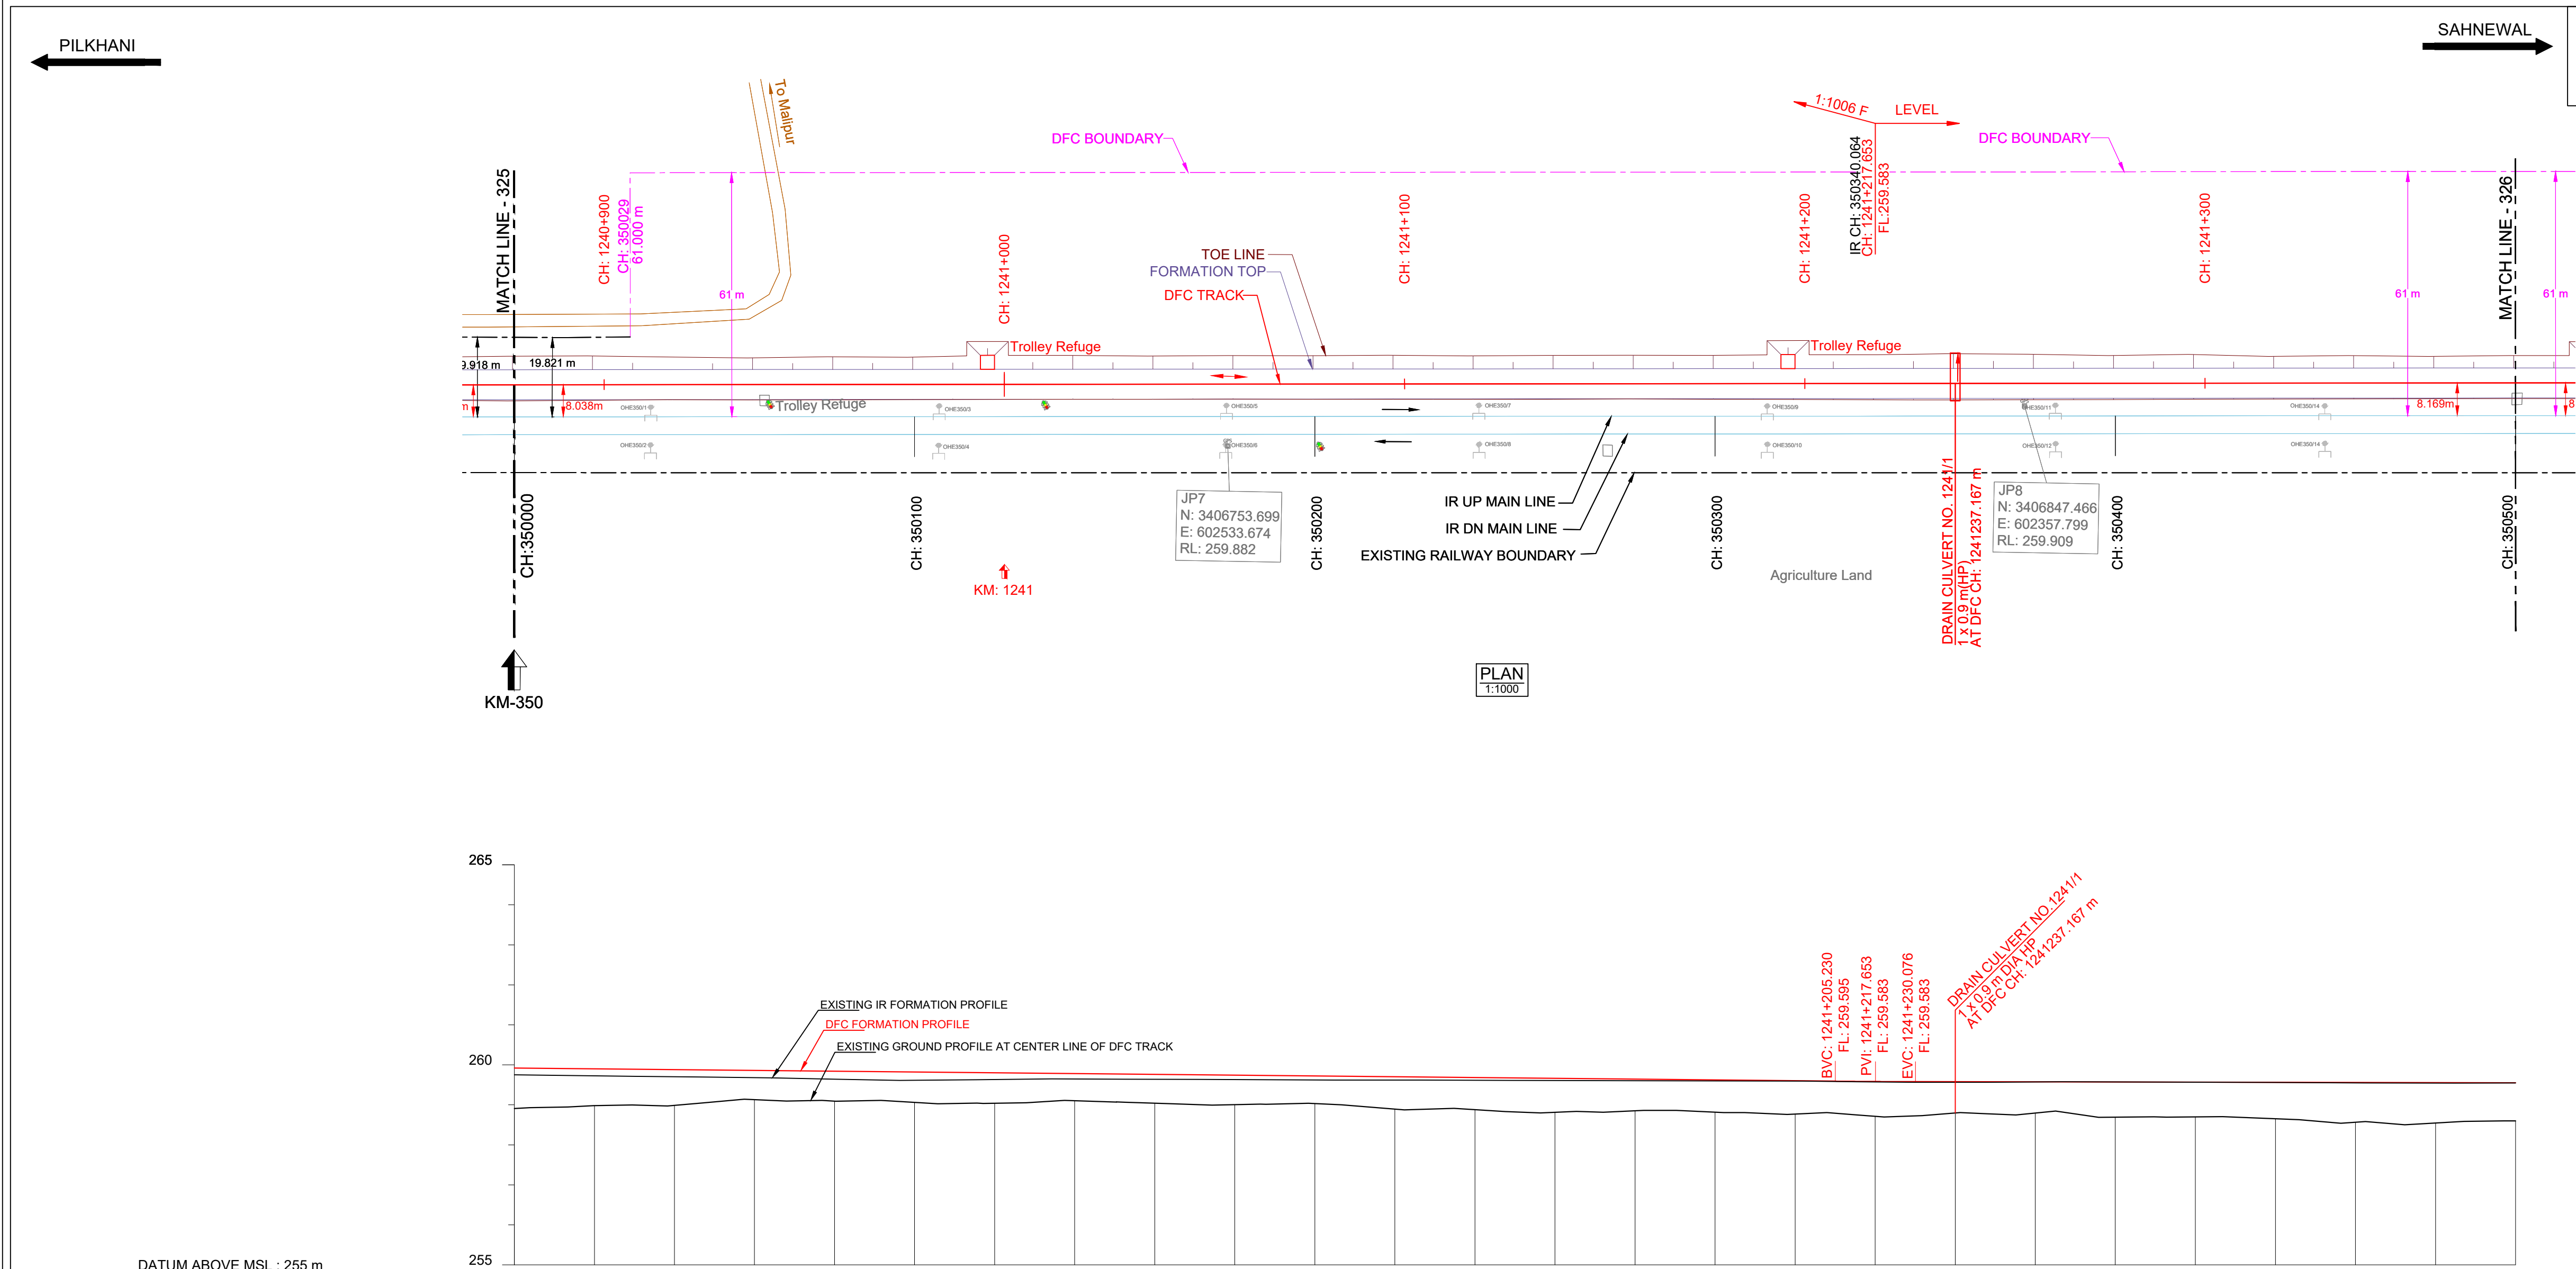

HORIZONTAL ALIGNMENT	L = 4280.337m																										
	L=1612.83 m 1 IN 1006 F																										
	L=24.84m R= -24994m																										
	L=957.554 m LEVEL																										
	TRACK DISTANCE FROM EXISTING NEAREST IR UP MAIN LINE TO DFC MAIN LINE	8.022	8.048	8.052	8.036	8.055	8.076	8.070	8.072	8.094	8.107	8.107	8.103	8.099	8.103	8.113	8.128	8.144	8.152	8.157	8.162	8.149	8.131	8.122	8.142	8.163	8.177
	HEIGHT OF BANKING(+)/ DEPTH OF CUTTING(-) (PFL-GL)	+1.013	+0.919	+0.895	+0.730	+0.747	+0.758	+0.762	+0.679	+0.720	+0.736	+0.690	+0.809	+0.802	+0.846	+0.791	+0.805	+0.833	0.872	0.785	0.787	0.891	0.883	0.931	1.019	1.037	0.982
	EXG GROUND LEVEL AT CENTER LINE OF DFC TRACK (GL)	258.908	258.982	258.986	259.131	259.094	259.063	259.040	259.103	259.042	259.006	259.032	258.893	258.880	258.816	258.852	258.818	258.770	258.714	258.798	258.796	258.692	258.700	258.652	258.564	258.546	258.601
	EXG GROUND LEVEL AT TOE LOCATION OF DFC TRACK	258.125	258.043	258.241	258.314	258.189	258.196	257.933	257.946	258.022	257.942	257.956	257.929	257.927	257.930	257.807	257.962	257.774	257.746	257.629	257.702	257.887	257.786	258.014	257.954	258.003	257.942
	DIFFERENCE BETWEEN DFC FORMATION LEVEL AND EXG.FORMATION LEVEL (PFL-EFL)	0.170	0.174	0.178	0.182	0.198	0.207	0.168	0.136	0.122	0.110	0.101	0.083	0.067	0.053	0.040	0.024	0.009	0.012	0.019	0.011	0.011	0.017	0.024	0.032	0.039	0.033
	DFC FORMATION LEVEL (PFL)	259.921	259.901	259.881	259.861	259.841	259.821	259.802	259.782	259.762	259.742	259.722	259.702	259.682	259.662	259.643	259.623	259.603	259.583	259.566	259.583	259.583	259.566	259.583	259.583	259.566	259.583
EXG. FORMATION LEVEL OF EXG IR UP MAIN LINE (EFL)	259.751	259.727	259.703	259.679	259.643	259.614	259.634	259.646	259.640	259.632	259.621	259.619	259.615	259.609	259.603	259.599	259.594	259.574	259.564	259.572	259.572	259.566	259.559	259.551	259.544	259.550	
DIFFERENCE BETWEEN DFC RAIL LEVEL AND EXG. RAIL LEVEL (PRL - ERL)	0.211	0.215	0.219	0.223	0.239	0.248	0.209	0.177	0.163	0.151	0.142	0.125	0.109	0.095	0.081	0.065	0.050	0.050	0.060	0.062	0.062	0.065	0.073	0.080	0.074		
DFC RAIL LEVEL (PRL)	260.634	260.614	260.594	260.575	260.555	260.535	260.515	260.495	260.475	260.455	260.435	260.415	260.396	260.376	260.356	260.336	260.316	260.296	260.296	260.296	260.296	260.296	260.296	260.296	260.296	260.296	260.296
EXG.RAIL LEVEL OF NEAREST IR UP MAIN LINE(ERL)	260.423	260.399	260.375	260.351	260.315	260.286	260.306	260.318	260.312	260.304	260.293	260.291	260.287	260.281	260.275	260.271	260.266	260.246	260.236	260.244	260.238	260.231	260.223	260.216	260.222	260.222	
EQUIVALENT CHAINAGE ON DFC TRACK	1240876.9	1240896.9	1240916.9	1240936.9	1240956.9	1240976.9	1240996.9	1241016.9	1241036.9	1241056.9	1241076.9	1241096.9	1241116.9	1241136.9	1241156.9	1241176.9	1241196.9	1241216.9	1241236.9	1241256.9	1241276.9	1241296.9	1241316.9	1241336.9	1241356.9	1241376.9	
EXISTING IR CHAINAGE	350000.0	350020.0	350040.0	350060.0	350080.0	350100.0	350120.0	350140.0	350160.0	350180.0	350200.0	350220.0	350240.0	350260.0	350280.0	350300.0	350320.0	350340.0	350360.0	350380.0	350400.0	350420.0	350440.0	350460.0	350480.0	350500.0	

L - SECTION

NOTE:-

- DFCC WORKS ARE SHOWN IN RED.
- IR NEW WORKS ARE SHOWN IN VIOLET.
- ALL DIMENSIONS ARE SHOWN IN METRES.
- THIS DRAWING IS PREPARED BASED ON LATEST SURVEY DATA HELD ON APRIL-2022. GTS BENCH MARK OF 261.850M CONSIDERED ON TOP OF CANAL BRIDGE ABUTMENT AT DORANA VILLAGE ALONG THE NH1.
- DFC NEW CHAINAGE OF 1075.950M IS WITH REFERENCE TO THE IR KM OF 187.500KM END OF KM OF CP-303(SECTION P-3 PILKHANI END) AGAINST THE EXISTING DFC CHAINAGE. 116277.742M ISSUED VIDE LETTER NO. COM/DFCC/UM/SURVEY/2021-301-230116-011173.DT. 17.01.2023.
- BALLAST PROFILE HAS BEEN PROVIDED ACCORDING TO THE CLAUSE 1.11.3 OF STANDARD SCHEDULE OF DIMENSION(EASTERN CORRIDOR) & THE BALLAST CUSHION DIMENSION SHOWN IN 35CM ON GE-14 PARA 17. SPECIFICATIONS & RECOMMENDATIONS 2. TWO LAYER SYSTEM FIG.10.

REFERENCE DRAWINGS :-

- FOR KEY PLAN REFER DRAWING NO. 301-2/AL/0001
- FOR LEGEND AND ABBREVIATIONS REFER DRAWING NO. 301-2/AL/1000
- FOR TYPICAL SECTION OF BALLAST PROFILE (FL-RL) REFER DRG. NO. 301-2/TK/TFD/004 (TR.1952)

REVISION DETAILS

REV.	DATE	REVISION DETAILS	PURPOSE OF ISSUE
0	17.10.2024	SUBMISSION OF AS-BUILT DRAWING	FOR APPROVAL

LEGEND:

SCALE: HOR - 1:1000, VER - 1:100, SHEET SIZE : A1

IR TRACK, DFC TRACK, DFC FUTURE PROPOSALS, STRUCTURE / BUILDING, DFC TOE LINE, DFC FORMATION, RETAINING WALL, ROAD, STREAM, DRAIN, NALA, CANAL, FENCE, POWER LINES, TBM, ELECTRIC POLE/OHE MAST, IR RAILWAY BOUNDARY, DFC BOUNDARY

TYPICAL SECTION

TRACK STRUCTURE

RAIL SECTION: 60Kg/m (UIC 60Kg/m) DFC LINE: 60Kg/m (UIC 60Kg/m) IR MAIN LINE: 52Kg/m	Difference between FL- RL (Below Rail Seat)	
	IR Line	DFC
RUBBER PAD	172mm	172mm
SLEEPER DEPTH	6mm	10mm
BALLAST CUSHION	210mm	210mm
Total Depth (FL TO RL)	300mm	350mm

OWNER: DEDICATED FREIGHT CORRIDOR CORPORATION OF INDIA LTD. (A GOVERNMENT OF INDIA ENTERPRISE) PROJECT OFFICE(AMBALA UNIT): OLD RAILWAY COLONY (NEAR ANAND MARKET),AMBALA CANTT-133001. CORPORATE IDENTITY NO. : U60232DL2006GGI155068

ENGINEER: DB Engineering & Consulting GmbH Deutsche Bahn Engineering & Consulting GmbH

CONTRACTOR: GIL - TPL JV GAR TATA

SUBMITTED BY	GIL - TPL JV		
	DATED	NAME	SIGNATURE
PREPARED BY			
CHECKED BY	17.10.2024	VIJAY PRATAP	
APPROVED BY	17.10.2024	PARASURAM KOTYADA	

APPROVED BY	DEUTSCHE BAHN ENGINEERING & CONSULTING GMBH		
	DATED	NAME	SIGNATURE
Sr. DE./CHIEF ENGINEER		SURESH K.YALANGI	
CHIEF TRACK ENGINEER		RAJ PAL SINGH	
T.L.		H.D. VIDJAK	



STAMP: A AS-BUILT DRAWING TR. Ref..... ENGINEER Sign.:

EMPLOYER (DFCCIL): DEDICATED FREIGHT CORRIDOR CORPORATION OF INDIA LTD.

AS BUILT DRAWING

TITLE: AS-BUILT PLAN AND PROFILE FROM IR KM: 350.000 TO 350.500 FROM DFC KM: 1240.877 to 1241.377

DFCC APPR. NO. -	STATUS: A
ENGG. APPR. NO. -	
DRG. NO. -301-2/AL/A/1326	
SHEET NO. : 1 OF 1	
DATE : 17.10.2024	

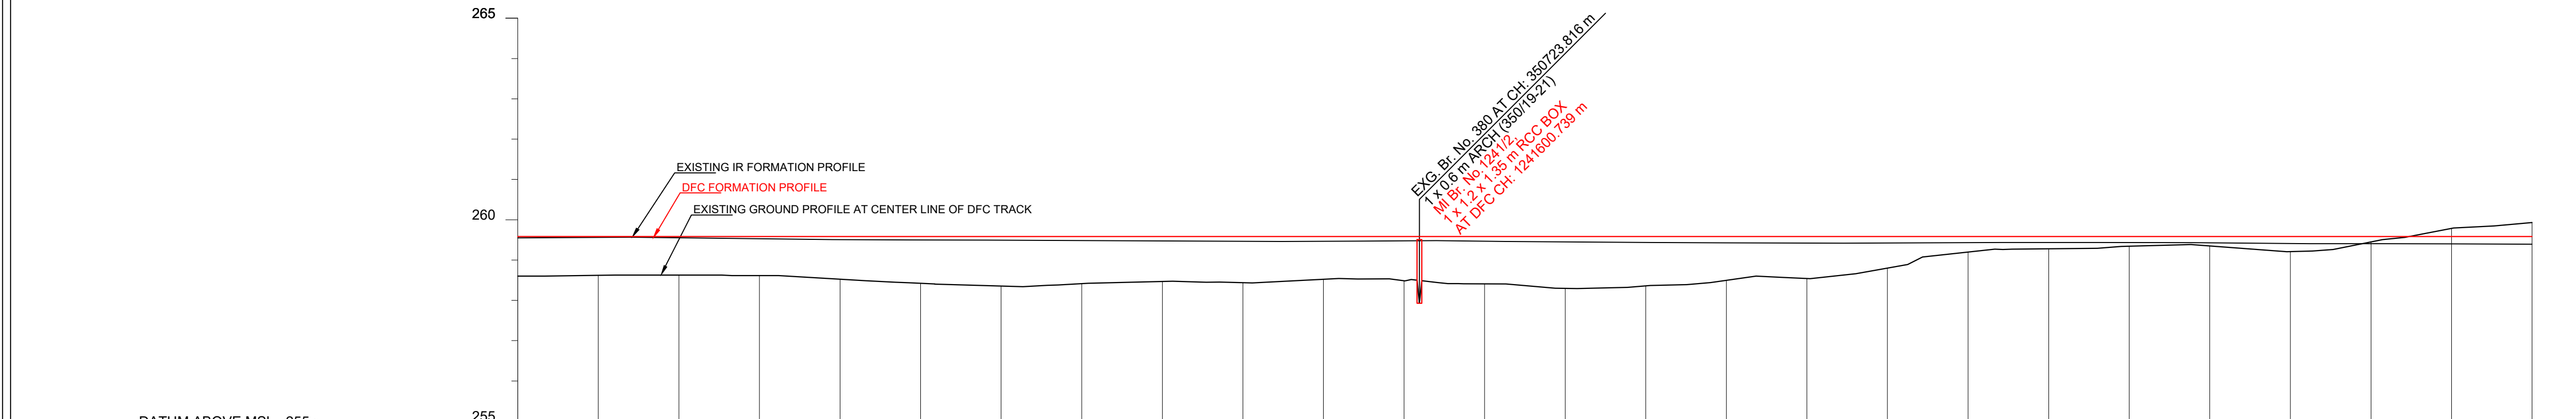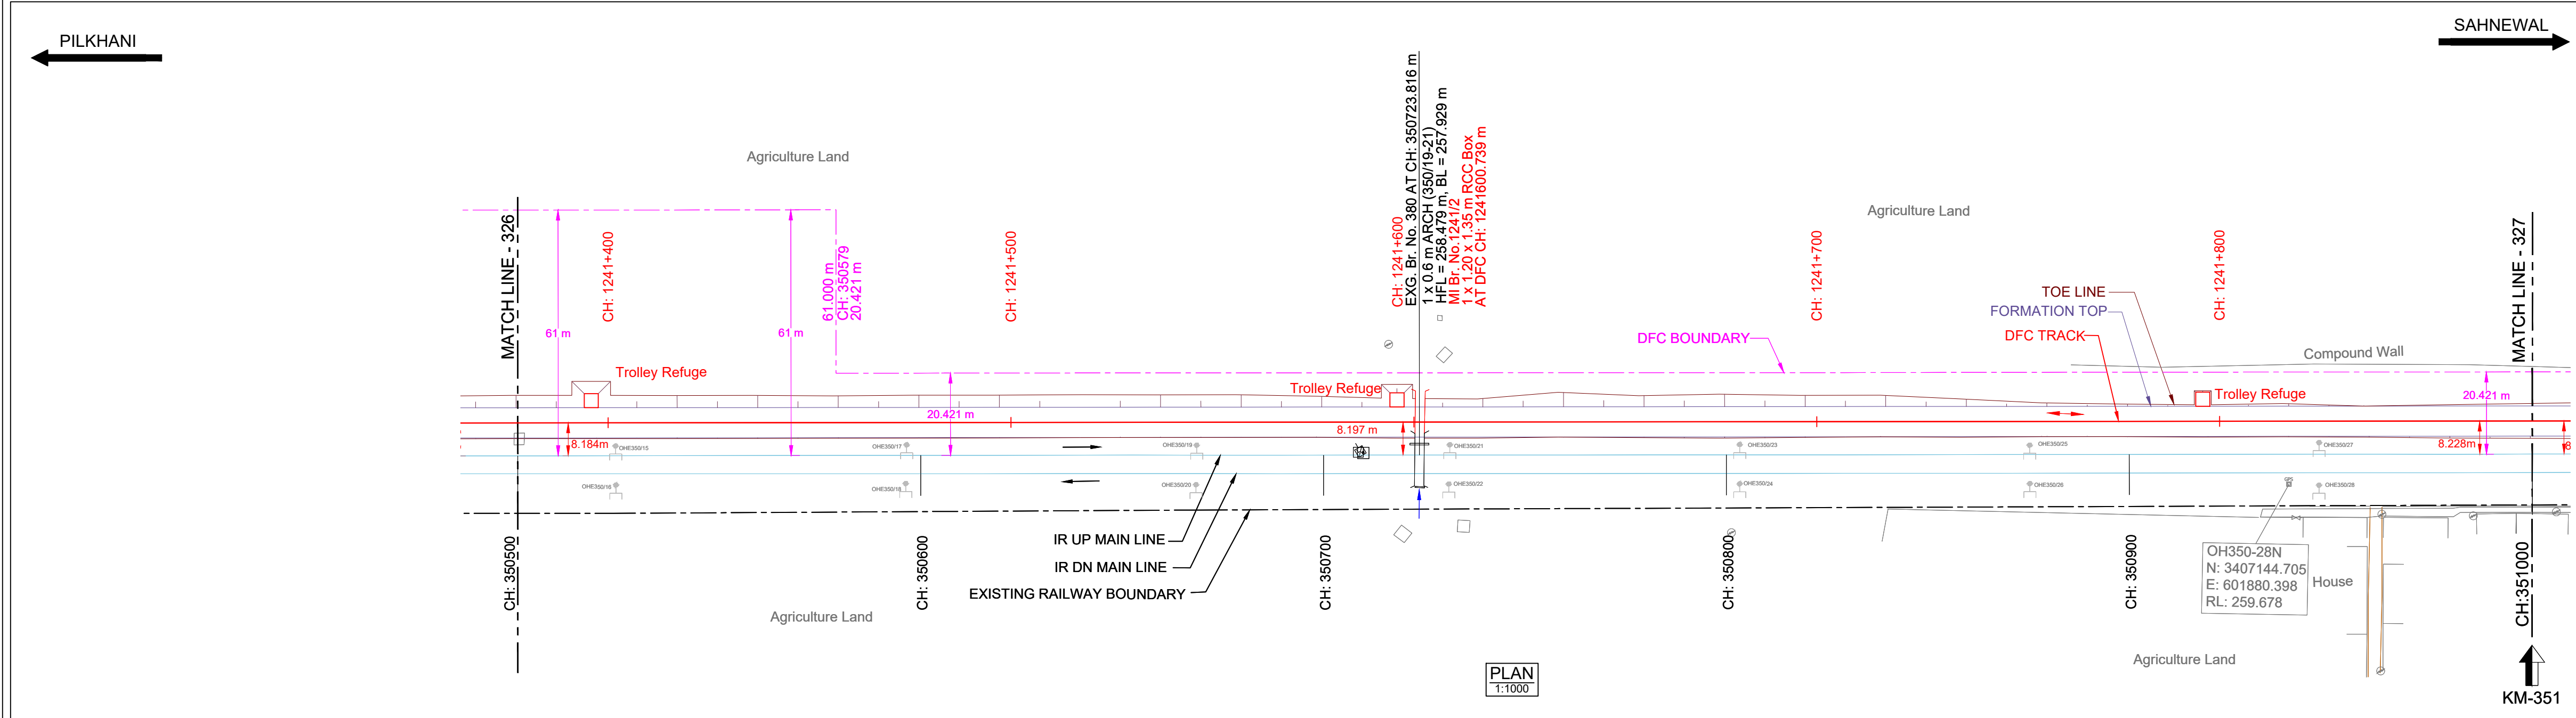

HORIZONTAL ALIGNMENT	L = 4280.337m																			
VERTICAL ALIGNMENT	L=957.554 m LEVEL																			
TRACK DISTANCE FROM EXISTING NEAREST IR UP MAIN LINE TO DFC MAIN LINE	8.177	8.189	8.184	8.167	8.152	8.159	8.163	8.151	8.154	8.181	8.195	8.197	8.201	8.208	8.215	8.223	8.239	8.233	8.210	8.204
HEIGHT OF BANKING(+) / DEPTH OF CUTTING(-) (PFL-GL)	0.982	0.961	0.957	0.969	1.060	1.160	1.227	1.170	1.117	1.146	1.061	1.096	1.174	1.287	1.225	1.087	1.040	0.783	0.385	0.303
EXG GROUND LEVEL AT CENTER LINE OF DFC TRACK (GL)	258.601	258.622	258.626	258.614	258.623	258.423	258.356	258.413	258.466	258.437	258.522	258.487	258.409	258.296	258.358	258.496	258.543	258.800	259.198	259.280
EXG GROUND LEVEL AT TOE LOCATION OF DFC TRACK	257.942	257.924	257.925	257.936	257.959	257.926	257.895	257.872	257.877	257.897	258.085	258.539	258.415	257.587	258.028	257.855	257.979	258.038	258.486	258.987
DIFFERENCE BETWEEN DFC FORMATION LEVEL AND EXG.FORMATION LEVEL (PFL-EFL)	0.033	0.022	0.031	0.054	0.075	0.083	0.092	0.099	0.107	0.117	0.116	0.106	0.115	0.134	0.146	0.158	0.161	0.159	0.150	0.148
DFC FORMATION LEVEL (PFL)	259.550	259.583	259.552	259.583	259.598	259.500	259.583	259.484	259.576	259.466	259.467	259.477	259.468	259.449	259.437	259.425	259.422	259.424	259.433	259.435
EXG. FORMATION LEVEL OF EXG IR UP MAIN LINE (EFL)	259.550	259.583	259.552	259.583	259.598	259.500	259.583	259.484	259.576	259.466	259.467	259.477	259.468	259.449	259.437	259.425	259.422	259.424	259.433	259.435
DIFFERENCE BETWEEN DFC RAIL LEVEL AND EXG. RAIL LEVEL (PRL - ERL)	0.074	0.063	0.072	0.095	0.116	0.124	0.133	0.140	0.148	0.158	0.157	0.147	0.156	0.175	0.167	0.199	0.202	0.200	0.191	0.189
DFC RAIL LEVEL (PRL)	260.296	260.296	260.296	260.296	260.296	260.296	260.296	260.296	260.296	260.296	260.296	260.296	260.296	260.296	260.296	260.296	260.296	260.296	260.296	260.296
EXG.RAIL LEVEL OF NEAREST IR UP MAIN LINE(ERL)	260.222	260.233	260.224	260.201	260.180	260.172	260.163	260.156	260.148	260.138	260.139	260.149	260.140	260.121	260.109	260.097	260.094	260.096	260.096	260.100
EQUIVALENT CHAINAGE ON DFC TRACK	-1241376.9	-1241396.9	-1241416.9	-1241436.9	-1241456.9	-1241476.9	-1241496.9	-1241516.9	-1241536.9	-1241556.9	-1241576.9	-1241596.9	-1241616.9	-1241636.9	-1241656.9	-1241676.9	-1241696.9	-1241716.9	-1241736.9	-1241756.9
EXISTING IR CHAINAGE	350500.0	350520.0	350540.0	350560.0	350580.0	350600.0	350620.0	350640.0	350660.0	350680.0	350700.0	350720.0	350740.0	350760.0	350780.0	350800.0	350820.0	350840.0	350860.0	350880.0

L - SECTION

NOTE:-

- DFCC WORKS ARE SHOWN IN RED.
- IR NEW WORKS ARE SHOWN IN VIOLET.
- ALL DIMENSIONS ARE SHOWN IN METRES.
- THIS DRAWING IS PREPARED BASED ON LATEST SURVEY DATA HELD ON APRIL-2022. GTS BENCH MARK OF 261.850M CONSIDERED ON TOP OF CANAL BRIDGE ABUTMENT AT DORANA VILLAGE ALONG THE NH1.
- DFC NEW CHAINAGE OF 1075.950M IS WITH REFERENCE TO THE IR KM OF 187.500KM END OF KM OF CP-303(SECTION P-3 PILKHANI END) AGAINST THE EXISTING DFC CHAINAGE. 116277.742M ISSUED VIDE LETTER NO. COM/DFCC/UMS/SURVEY/2021-301-230116-011173.DT. 17.01.2023.
- BALLAST PROFILE HAS BEEN PROVIDED ACCORDING TO THE CLAUSE 1.11.3 OF STANDARD SCHEDULE OF DIMESION(EASTERN CORRIDOR) & THE BALLAST CUSHION DIMESION SHOWN IN 35CM ON GE-14 PARA 17. SPECIFICATIONS & RECOMMENDATIONS 2. TWO LAYER SYSTEM FIG.10.

REFERENCE DRAWINGS :-

- FOR KEY PLAN REFER DRAWING NO. 301-2/AL/0001
- FOR LEGEND AND ABBREVIATIONS REFER DRAWING NO. 301-2/AL/1000
- FOR TYPICAL SECTION OF BALLAST PROFILE (FL-RL) REFER DRG. NO. 301-2/TK/TFD/004 (TR.1952)

SCALE
HOR - 1:1000
VER - 1:100
SHEET SIZE : A1

LEGEND:

- IR TRACK
- DFCC TRACK
- DFCC FUTURE PROPOSALS
- STRUCTURE / BUILDING
- DFCC TOE LINE
- DFCC FORMATION
- RETAINING WALL
- ROAD
- STREAM, DRAIN, NALA, CANAL.
- FENCE
- POWER LINES
- TBM
- ELECTRIC POLE/OHE MAST
- IR RAILWAY BOUNDARY
- DFCC BOUNDARY

TYPICAL SECTION

TRACK STRUCTURE

RAIL SECTION: 60Kg/m (UIC 60Kg/m)	Difference between FL- RL (Below Rail Seat)	
DFC LINE: 60Kg/m (UIC 60Kg/m)	IR Line	DFC
IR MAIN LINE: 52Kg/m	172mm	172mm
RUBBER PAD	6mm	10mm
SLEEPER DEPTH	210mm	210mm
BALLAST CUSHION	300mm	350mm
Total Depth (FL TO RL)	688mm	742mm

OWNER
DEDICATED FREIGHT CORRIDOR CORPORATION OF INDIA LTD.
(A GOVERNMENT OF INDIA ENTERPRISE)
PROJECT OFFICE(AMBALA UNIT): OLD RAILWAY COLONY (NEAR ANAND MARKET),AMBALA CANTT-133001.
CORPORATE IDENTITY NO. : U60232DL20060G0155068

ENGINEER:
DB Engineering & Consulting GmbH
Deutsche Bahn Engineering & Consulting GmbH

CONTRACTOR:
GIL - TPL JV
GAR TATA

SUBMITTED BY	GIL - TPL JV		
PREPARED BY	DATED	NAME	SIGNATURE
CHECKED BY	17.10.2024	VIJAY PRATAP	
APPROVED BY	17.10.2024	PARASURAM KOTYADA	
APPROVED BY	DEUTSCHE BAHN ENGINEERING & CONSULTING GMBH		
	DATED	NAME	SIGNATURE
Sr. DE./CHIEF ENGINEER		SURESH K.YALANGI	
CHIEF TRACK ENGINEER		RAJ PAL SINGH	
T.L.		H.D. VIDJAK	

STAMP
A AS-BUILT DRAWING
TR. Ref.....
ENGINEER Sign.:

EMPLOYER (DFCCIL): DEDICATED FREIGHT CORRIDOR CORPORATION OF INDIA LTD.


AS BUILT DRAWING

TITLE
AS-BUILT PLAN AND PROFILE
FROM IR KM: 350.500 TO 351.000
FROM DFC KM: 1241.377 to 1241.877

DFCC APPR. NO. -
ENGG. APPR. NO. -
DRG. NO. -301-2/AL/A/1327
SHEET NO. : 1 OF 1
DATE : 17.10.2024

STATUS
A

TR.

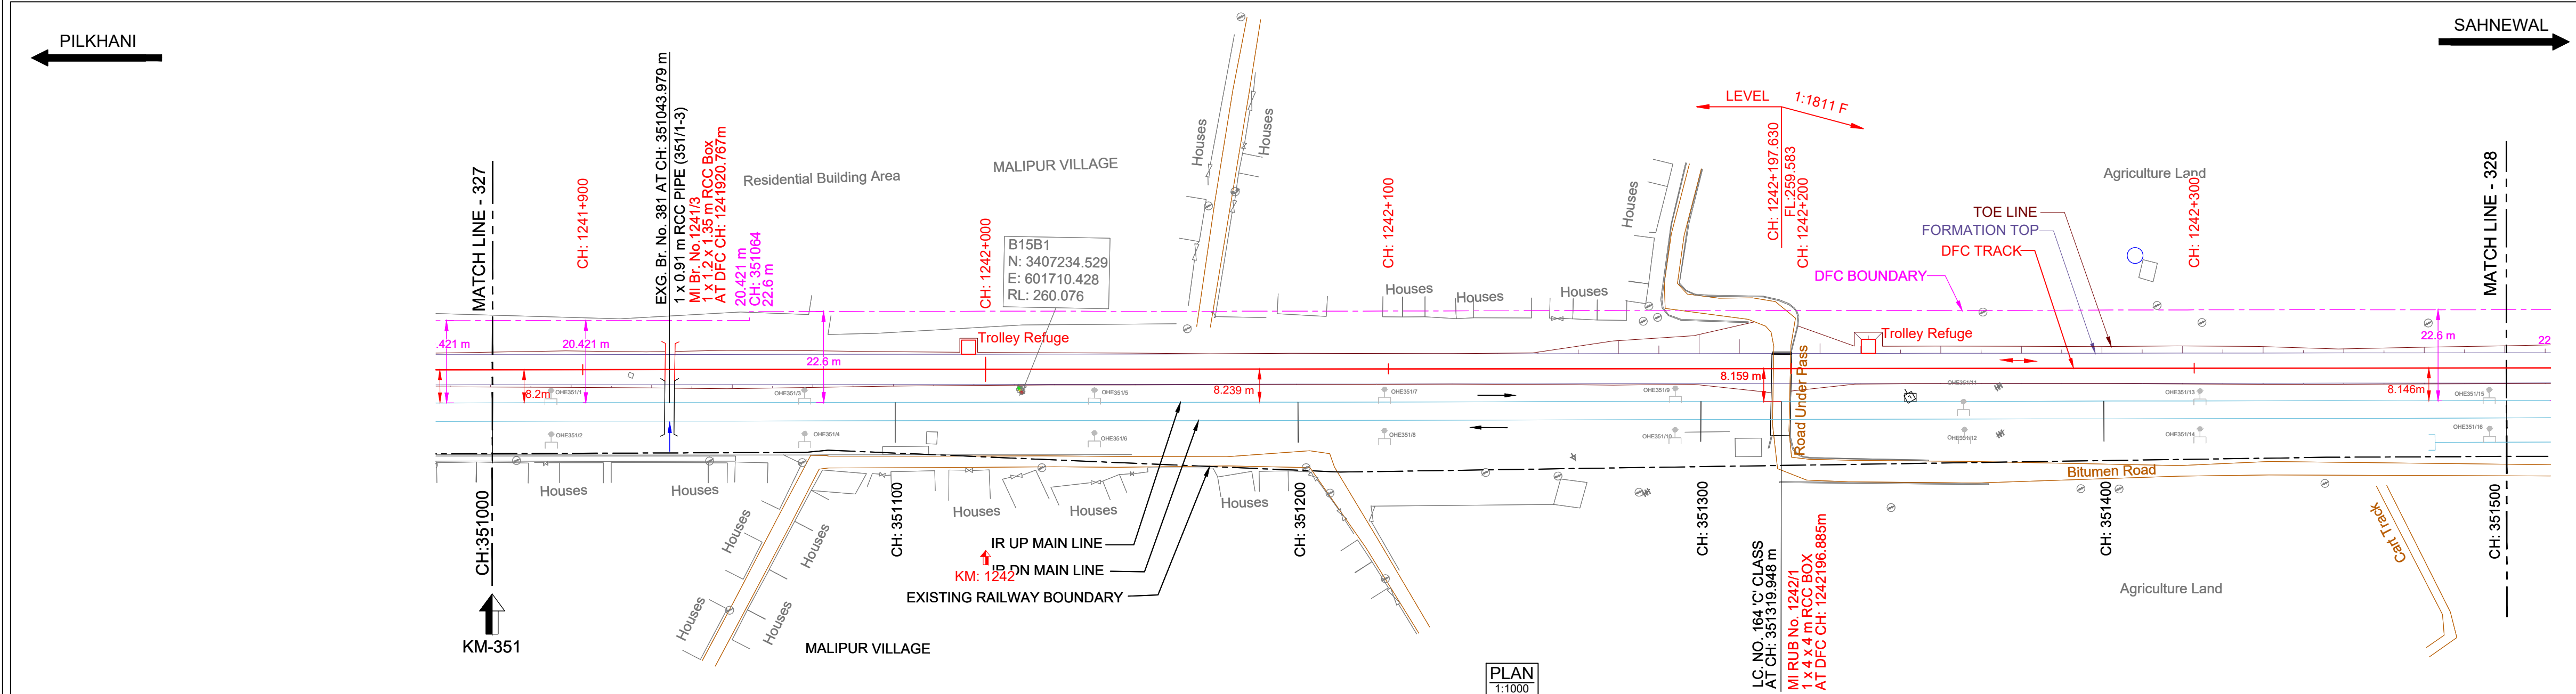

HORIZONTAL ALIGNMENT	L = 4280.337m																			
VERTICAL ALIGNMENT	L=957.554 m LEVEL L=20.000m R=36224 L=504.898 m 1 IN 1811.197 F																			
TRACK DISTANCE FROM EXISTING NEAREST IR UP MAIN LINE TO DFC MAIN LINE	8.211	8.182	8.213	8.244	8.213	8.186	8.183	8.195	8.226	8.240	8.239	8.227	8.207	8.166	8.108	8.124	8.196	8.235	8.197	8.147
HEIGHT OF BANKING(+) / DEPTH OF CUTTING(-) (PFL-GL)	-0.348	-0.437	-0.566	-0.816	-0.542	-0.151	-0.039	0.048	0.144	0.180	0.218	0.256	0.268	0.365	0.867	0.825	1.201	0.654	0.646	0.494
EXG GROUND LEVEL AT CENTER LINE OF DFC TRACK (GL)	259.931	260.020	260.149	260.399	260.125	259.734	259.622	259.535	259.439	259.403	259.365	259.327	259.315	259.218	257.716	258.758	258.382	258.907	258.904	258.001
EXG GROUND LEVEL AT TOE LOCATION OF DFC TRACK	259.941	260.241	259.941	260.361	260.198	259.965	259.748	259.656	259.540	259.348	259.454	259.386	259.281	259.137	257.456	258.842	258.482	258.383	258.404	258.543
DIFFERENCE BETWEEN DFC FORMATION LEVEL AND EXG.FORMATION LEVEL (PFL-EFL)	0.189	0.195	0.209	0.222	0.222	0.222	0.216	0.216	0.223	0.224	0.220	0.214	0.207	0.207	0.215	0.208	0.196	0.204	0.217	0.264
DFC FORMATION LEVEL (PFL)	259.583	259.583	259.583	259.583	259.583	259.583	259.583	259.583	259.583	259.583	259.583	259.583	259.583	259.583	259.583	259.583	259.583	259.583	259.583	259.484
EXG. FORMATION LEVEL OF EXG IR UP MAIN LINE (EFL)	259.394	259.388	259.374	259.361	259.361	259.361	259.367	259.367	259.360	259.359	259.363	259.369	259.376	259.376	259.368	259.375	259.385	259.357	259.333	259.231
DIFFERENCE BETWEEN DFC RAIL LEVEL AND EXG. RAIL LEVEL (PRL - ERL)	0.230	0.236	0.250	0.263	0.263	0.263	0.257	0.257	0.264	0.265	0.261	0.255	0.248	0.248	0.256	0.249	0.239	0.237	0.246	0.305
DFC RAIL LEVEL (PRL)	260.296	260.296	260.296	260.296	260.296	260.296	260.296	260.296	260.296	260.296	260.296	260.296	260.296	260.296	260.296	260.296	260.296	260.296	260.296	260.197
EXG.RAIL LEVEL OF NEAREST IR UP MAIN LINE(ERL)	260.066	260.060	260.046	260.033	260.033	260.033	260.039	260.039	260.032	260.031	260.035	260.041	260.048	260.048	260.040	260.047	260.057	260.029	260.029	260.001
EQUIVALENT CHAINAGE ON DFC TRACK	-1241877.0	-1241896.9	-1241916.9	-1241936.9	-1241956.9	-1241976.9	-1241996.9	-1242016.9	-1242036.9	-1242056.9	-1242076.9	-1242096.9	-1242116.9	-1242136.9	-1242156.9	-1242176.9	-1242196.9	-1242216.9	-1242236.9	-1242256.9
EXISTING IR CHAINAGE	351000.0	351020.0	351040.0	351060.0	351080.0	351100.0	351120.0	351140.0	351160.0	351180.0	351200.0	351220.0	351240.0	351260.0	351280.0	351300.0	351320.0	351340.0	351360.0	351380.0

L - SECTION

NOTE:-

- DFCC WORKS ARE SHOWN IN RED.
- IR NEW WORKS ARE SHOWN IN VIOLET.
- ALL DIMENSIONS ARE SHOWN IN METRES.
- THIS DRAWING IS PREPARED BASED ON LATEST SURVEY DATA HELD ON APRIL-2022. GTS BENCH MARK OF 261.850M CONSIDERED ON TOP OF CANAL BRIDGE ABUTMENT AT DORANA VILLAGE ALONG THE NH1.
- DFC NEW CHAINAGE OF 1075.950M IS WITH REFERENCE TO THE IR KM OF 187.500KM END OF KM OF CP-303(SECTION P-3 PILKHANI END) AGAINST THE EXISTING DFC CHAINAGE. 116277.742M ISSUED VIDE LETTER NO. COM/DFCC/UMS/SURVEY/2021-301-2301/16-011173.DT. 17.01.2023.
- BALLAST PROFILE HAS BEEN PROVIDED ACCORDING TO THE CLAUSE 1.11.3 OF STANDARD SCHEDULE OF DIMENSION(EASTERN CORRIDOR) & THE BALLAST CUSHION DIMENSION SHOWN IN 35CM ON GE-14 PARA 17. SPECIFICATIONS & RECOMMENDATIONS 2. TWO LAYER SYSTEM FIG.10.

REFERENCE DRAWINGS :-

- FOR KEY PLAN REFER DRAWING NO. 301-2/AL/0001
- FOR LEGEND AND ABBREVIATIONS REFER DRAWING NO. 301-2/AL/1000
- FOR TYPICAL SECTION OF BALLAST PROFILE (FL-RL) REFER DRG. NO. 301-2/TK/TFDI-004 (TR.1952)

017.10.2024SUBMISSION OF AS-BUILT DRAWINGFOR APPROVAL

REV. DATE REVISION DETAILS PURPOSE OF ISSUE

SCALE
HOR - 1:1000
VER - 1:100
SHEET SIZE : A1

LEGEND:

- IR TRACK
- DFCC TRACK
- DFCC FUTURE PROPOSALS
- STRUCTURE / BUILDING
- DFCC TOE LINE
- DFCC FORMATION
- RETAINING WALL
- ROAD
- STREAM, DRAIN, NALA, CANAL.
- POWER LINES
- TBM
- ELECTRIC POLE/OHE MAST
- IR RAILWAY BOUNDARY
- DFCC BOUNDARY

TRACK STRUCTURE

RAIL SECTION: 60Kg/m (UIC 60Kg/m)	Difference between FL- RL (Below Rail Seat)	
DFC LINE: 60Kg/m (UIC 60Kg/m)	IR Line	DFC
IR MAIN LINE: 52Kg/m	172mm	172mm
	6mm	10mm
RUBBER PAD	210mm	210mm
SLEEPER DEPTH	300mm	350mm
BALLAST CUSHION	688mm	742mm
Total Depth (FL TO RL)		

OWNER

DEDICATED FREIGHT CORRIDOR CORPORATION OF INDIA LTD.
(A GOVERNMENT OF INDIA ENTERPRISE)
PROJECT OFFICE (AMBALA UNIT): OLD RAILWAY COLONY (NEAR ANAND MARKET), AMBALA CANTT-133001.
CORPORATE IDENTITY NO. : U60232DL2006GGI155068

ENGINEER:

DB Engineering & Consulting GmbH
Deutsche Bahn Engineering & Consulting GmbH

CONTRACTOR:

GIL - TPL JV

SUBMITTED BY	GIL - TPL JV		
PREPARED BY	DATED	NAME	SIGNATURE
CHECKED BY	17.10.2024	VIJAY PRATAP	
APPROVED BY	17.10.2024	PARASURAM KOTYADA	

APPROVED BY

DEUTSCHE BAHN ENGINEERING & CONSULTING GMBH

DATED	NAME	SIGNATURE
Sr. DE./CHIEF ENGINEER	SURESH K.YALANGI	
CHIEF TRACK ENGINEER	RAJ PAL SINGH	
T.L.	H.D. VIDJAK	

STAMP

EMPLOYER (DFCCIL):

DEDICATED FREIGHT CORRIDOR CORPORATION OF INDIA LTD.

AS BUILT DRAWING

TITLE

AS-BUILT PLAN AND PROFILE

FROM IR KM: 351.000 TO 351.500

FROM DFC KM: 1241.877 to 1242.377

DFCC APPR. NO. -

ENGG. APPR. NO. -

DRG. NO. :301-2/AL/A/1328



SHEET NO. : 1 OF 1

DATE : 17.10.2024

STATUS

A

TR.

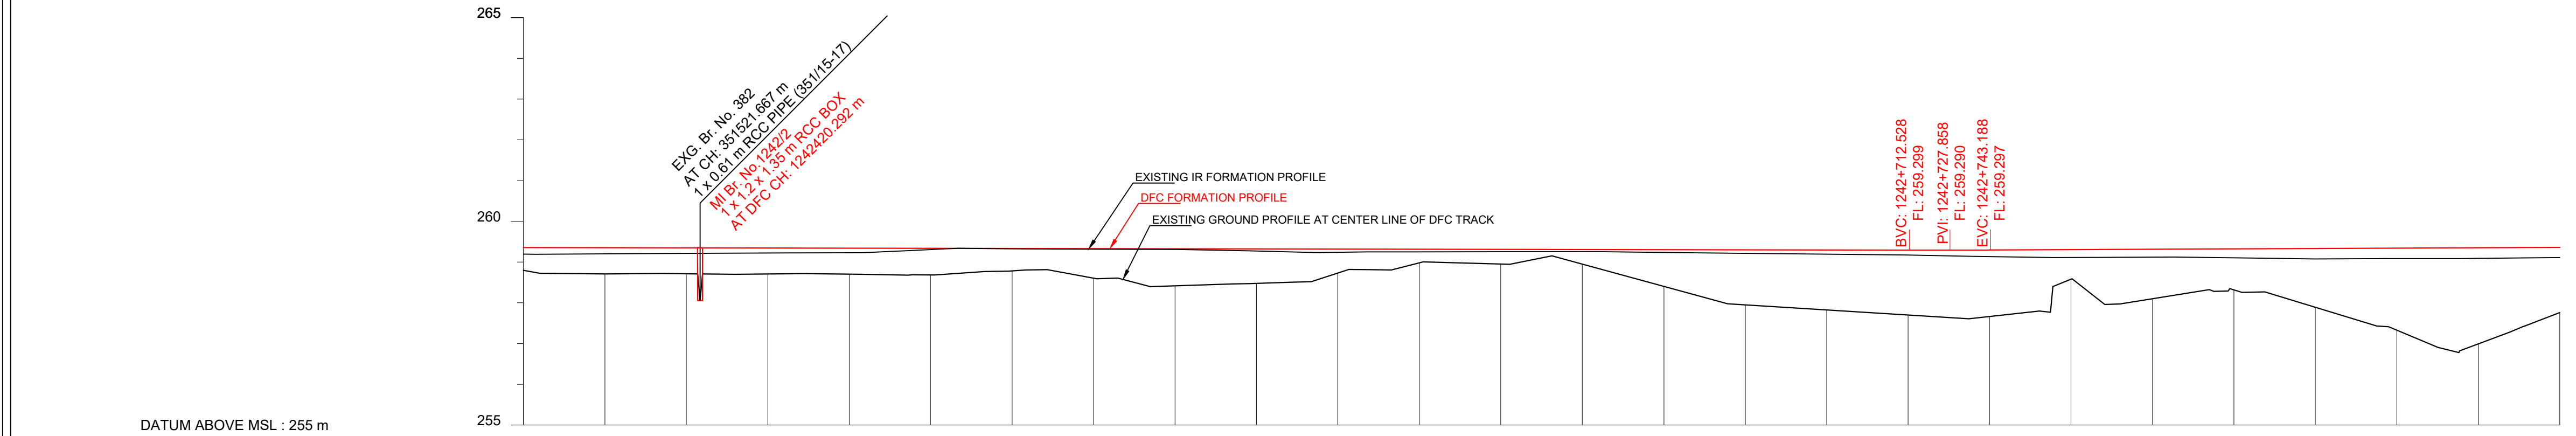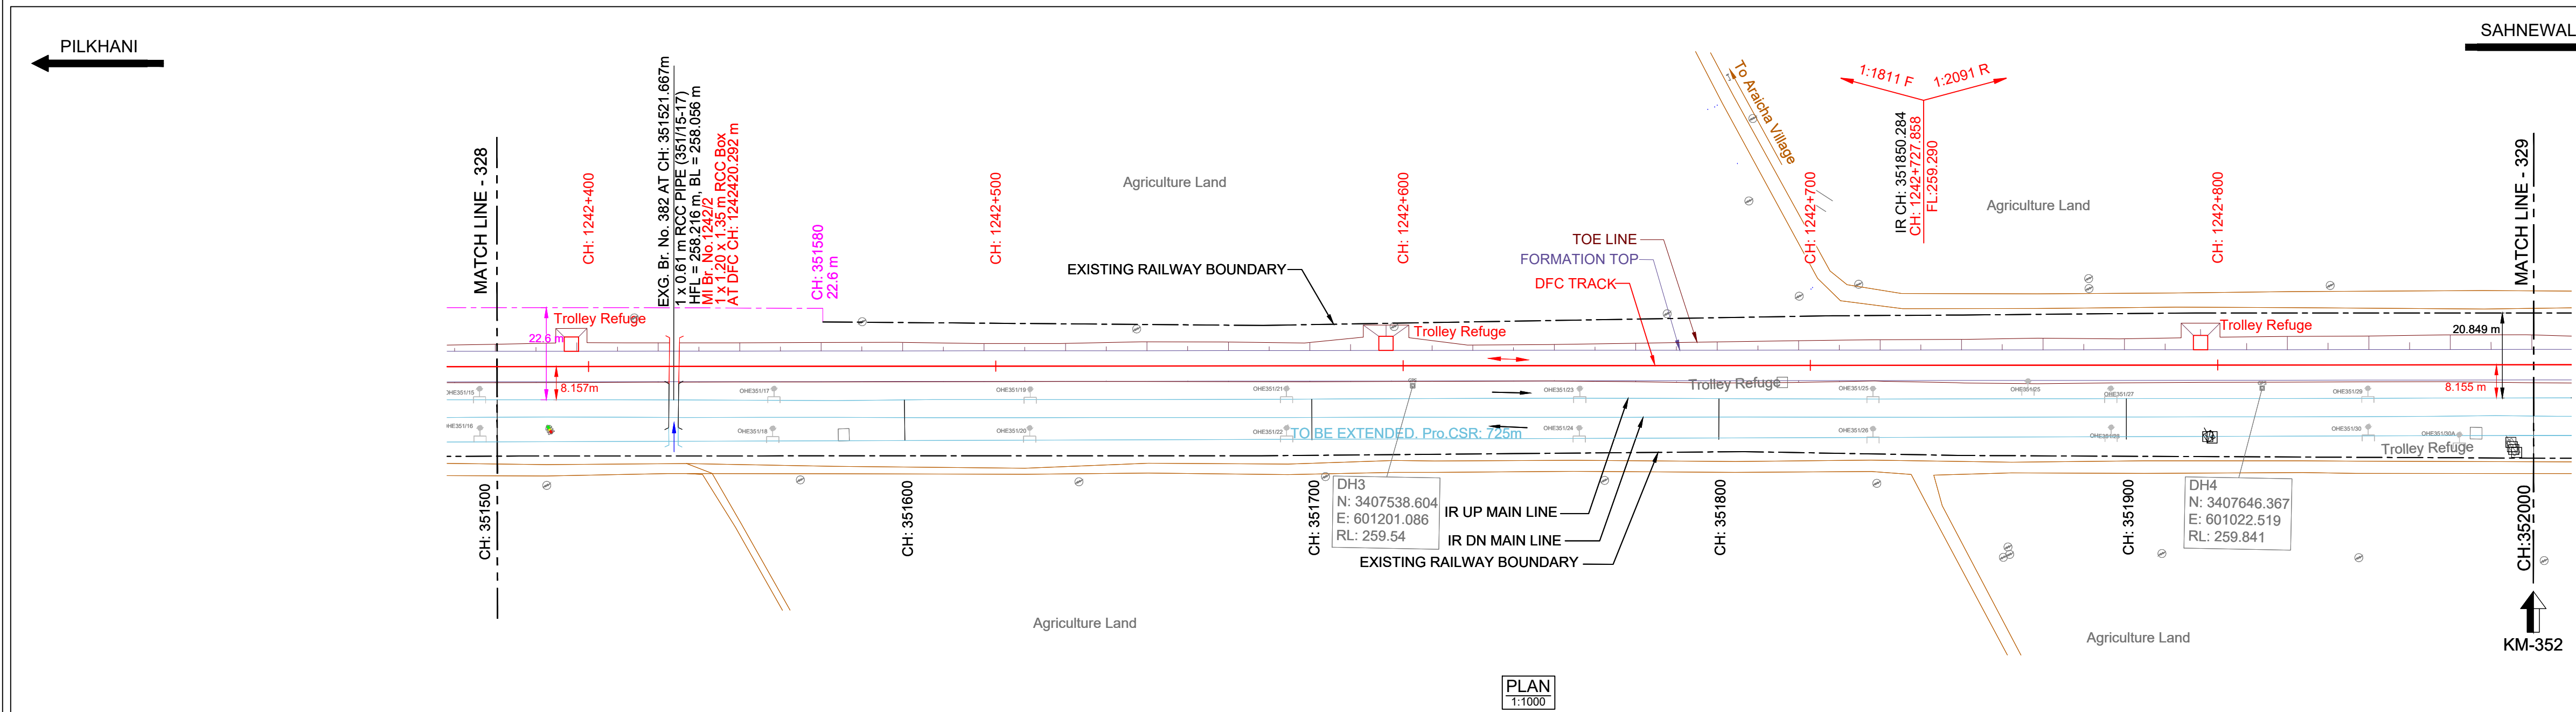

HORIZONTAL ALIGNMENT	L = 4280.337m																			
VERTICAL ALIGNMENT	L=504.898 m 1 IN 1811.197 F																			
TRACK DISTANCE FROM EXISTING NEAREST IR UP MAIN LINE TO DFC MAIN LINE	8.141	8.166	8.201	8.223	8.239	8.265	8.213	8.228	8.241	8.218	8.083	8.039	7.995	8.067	8.154	8.227	8.288	8.264	8.239	8.222
HEIGHT OF BANKING(+) / DEPTH OF CUTTING(-) (PFL-GL)	+0.686	+0.763	+0.749	+0.743	+0.736	+0.745	+0.634	+0.801	+0.980	+0.907	+0.381	+0.398	+0.392	+0.927	+1.369	+1.482	+1.595	+1.631	+0.724	+1.214
EXG GROUND LEVEL AT CENTER LINE OF DFC TRACK (GL)	258.798	258.709	258.712	258.707	258.703	258.683	258.783	258.605	258.415	258.477	258.981	258.953	258.948	258.402	257.949	257.825	257.701	257.684	256.580	256.100
EXG GROUND LEVEL AT TOE LOCATION OF DFC TRACK	258.394	258.191	258.227	258.198	258.188	258.199	258.337	258.338	258.143	258.141	257.166	258.555	258.479	258.332	258.179	258.040	257.923	257.894	257.794	257.812
DIFFERENCE BETWEEN DFC FORMATION LEVEL AND EXG.FORMATION LEVEL (PFL-EFL)	0.287	0.270	0.247	0.228	0.213	0.121	0.091	0.091	0.087	0.113	0.110	0.098	0.086	0.092	0.103	0.112	0.123	0.160	0.191	0.193
DFC FORMATION LEVEL (PFL)	259.484	259.472	259.461	259.450	259.439	259.428	259.417	259.406	259.395	259.384	259.252	259.351	259.340	259.329	259.318	259.307	259.296	259.295	259.304	259.314
EXG. FORMATION LEVEL OF EXG IR UP MAIN LINE (EFL)	259.197	259.202	259.214	259.222	259.226	259.307	259.326	259.315	259.308	259.271	259.252	259.253	259.254	259.237	259.215	259.195	259.173	259.135	259.113	259.121
DIFFERENCE BETWEEN DFC RAIL LEVEL AND EXG. RAIL LEVEL (PRL - ERL)	0.328	0.312	0.289	0.270	0.255	0.163	0.133	0.133	0.128	0.154	0.152	0.140	0.128	0.133	0.145	0.154	0.164	0.200	0.232	0.234
DFC RAIL LEVEL (PRL)	260.197	260.186	260.175	260.164	260.153	260.142	260.131	260.120	260.109	260.098	260.076	260.085	260.053	260.042	260.031	260.020	260.009	260.007	260.017	260.026
EXG.RAIL LEVEL OF NEAREST IR UP MAIN LINE(ERL)	259.869	259.874	259.886	259.894	259.898	259.979	259.988	259.987	259.980	259.943	259.924	259.925	259.926	259.909	259.887	259.867	259.845	259.807	259.785	259.783
EQUIVALENT CHAINAGE ON DFC TRACK	-1242376.9	-1242396.9	-1242416.9	-1242436.9	-1242456.9	-1242476.8	-1242496.9	-1242516.9	-1242536.9	-1242556.9	-1242576.9	-1242596.9	-1242616.9	-1242636.9	-1242657.0	-1242677.0	-1242696.9	-1242716.9	-1242736.9	-1242756.9
EXISTING IR CHAINAGE	351500.0	351520.0	351540.0	351560.0	351580.0	351600.0	351620.0	351640.0	351660.0	351680.0	351700.0	351720.0	351740.0	351760.0	351780.0	351800.0	351820.0	351840.0	351860.0	351880.0

L - SECTION

NOTE:-

- DFCC WORKS ARE SHOWN IN RED.
- IR NEW WORKS ARE SHOWN IN VIOLET.
- ALL DIMENSIONS ARE SHOWN IN METRES.
- THIS DRAWING IS PREPARED BASED ON LATEST SURVEY DATA HELD ON APRIL-2022. GTS BENCH MARK OF 261.850M CONSIDERED ON TOP OF CANAL BRIDGE ABUTMENT AT DORANA VILLAGE ALONG THE NH1.
- DFC NEW CHAINAGE OF 1075.950M IS WITH REFERENCE TO THE IR KM OF 187.500KM END OF KM OF CP-303(SECTION P-3 PILKHANI END) AGAINST THE EXISTING DFC CHAINAGE. 116277.742M ISSUED VIDE LETTER NO. COM/DFCC/UMS/SURVEY/2021-301-2301/6-011173 DT. 17.01.2023.
- BALLAST PROFILE HAS BEEN PROVIDED ACCORDING TO THE CLAUSE 1.11.3 OF STANDARD SCHEDULE OF DIMENSION(EASTERN CORRIDOR) & THE BALLAST CUSHION DIMENSION SHOWN IN 35CM ON GE-14 PARA 17. SPECIFICATIONS & RECOMMENDATIONS 2. TWO LAYER SYSTEM FIG.10.

REFERENCE DRAWINGS :-

- FOR KEY PLAN REFER DRAWING NO. 301-2/AL/0001
- FOR LEGEND AND ABBREVIATIONS REFER DRAWING NO. 301-2/AL/1000
- FOR TYPICAL SECTION OF BALLAST PROFILE (FL-RL) REFER DRG. NO. 301-2/TK/TFD/-004 (TR.1952)

DRG NO.- 301-2/AL/A/1329

0	17.10.2024	SUBMISSION OF AS-BUILT DRAWING	FOR APPROVAL
REV.	DATE	REVISION DETAILS	PURPOSE OF ISSUE

LEGEND:

SCALE

HOR - 1:1000

VER - 1:100

SHEET SIZE : A1

TYPICAL SECTION

TRACK STRUCTURE

RAIL SECTION: 60Kg/m (UIC 60Kg/m)	Difference between FL- RL (Below Rail Seat)	
DFC LINE: 60Kg/m (UIC 60Kg/m)	IR Line	DFC
IR MAIN LINE: 52Kg/m	172mm	172mm
RUBBER PAD	6mm	10mm
SLEEPER DEPTH	210mm	210mm
BALLAST CUSHION	300mm	350mm
Total Depth (FL TO RL)	688mm	742mm

OWNER

DEDICATED FREIGHT CORRIDOR CORPORATION OF INDIA LTD.

(A GOVERNMENT OF INDIA ENTERPRISE)

PROJECT OFFICE(AMBALA UNIT): OLD RAILWAY COLONY (NEAR ANAND MARKET),AMBALA CANTT-133001.

CORPORATE IDENTITY NO. : U60232DL2006GGI155068

ENGINEER:

DB Engineering & Consulting GmbH

Deutsche Bahn Engineering & Consulting GmbH

CONTRACTOR:

GIL - TPL JV

GAR TATA

SUBMITTED BY	GIL - TPL JV		
PREPARED BY	DATED	NAME	SIGNATURE
CHECKED BY	17.10.2024	VIJAY PRATAP	
APPROVED BY	17.10.2024	PARASURAM KOTYADA	
APPROVED BY	DEUTSCHE BAHN ENGINEERING & CONSULTING GMBH		
	DATED	NAME	SIGNATURE
Sr. DE./CHIEF ENGINEER		SURESH K.YALANGI	
CHIEF TRACK ENGINEER		RAJ PAL SINGH	
T.L.		H.D. VIDJAK	

STAMP

AS-BUILT DRAWING

TR. Ref.....

ENGINEER Sign.:

EMPLOYER (DFCCIL): DEDICATED FREIGHT CORRIDOR CORPORATION OF INDIA LTD.

AS BUILT DRAWING

TITLE

AS-BUILT PLAN AND PROFILE

FROM IR KM: 351.500 TO 352.000

FROM DFC KM: 1242.377 TO 1242.877

DFCC APPR. NO. -

ENGG. APPR. NO. -

DRG. NO. :301-2/AL/A/1329



SHEET NO. : 1 OF 1

DATE : 17.10.2024

STATUS

A

TR.

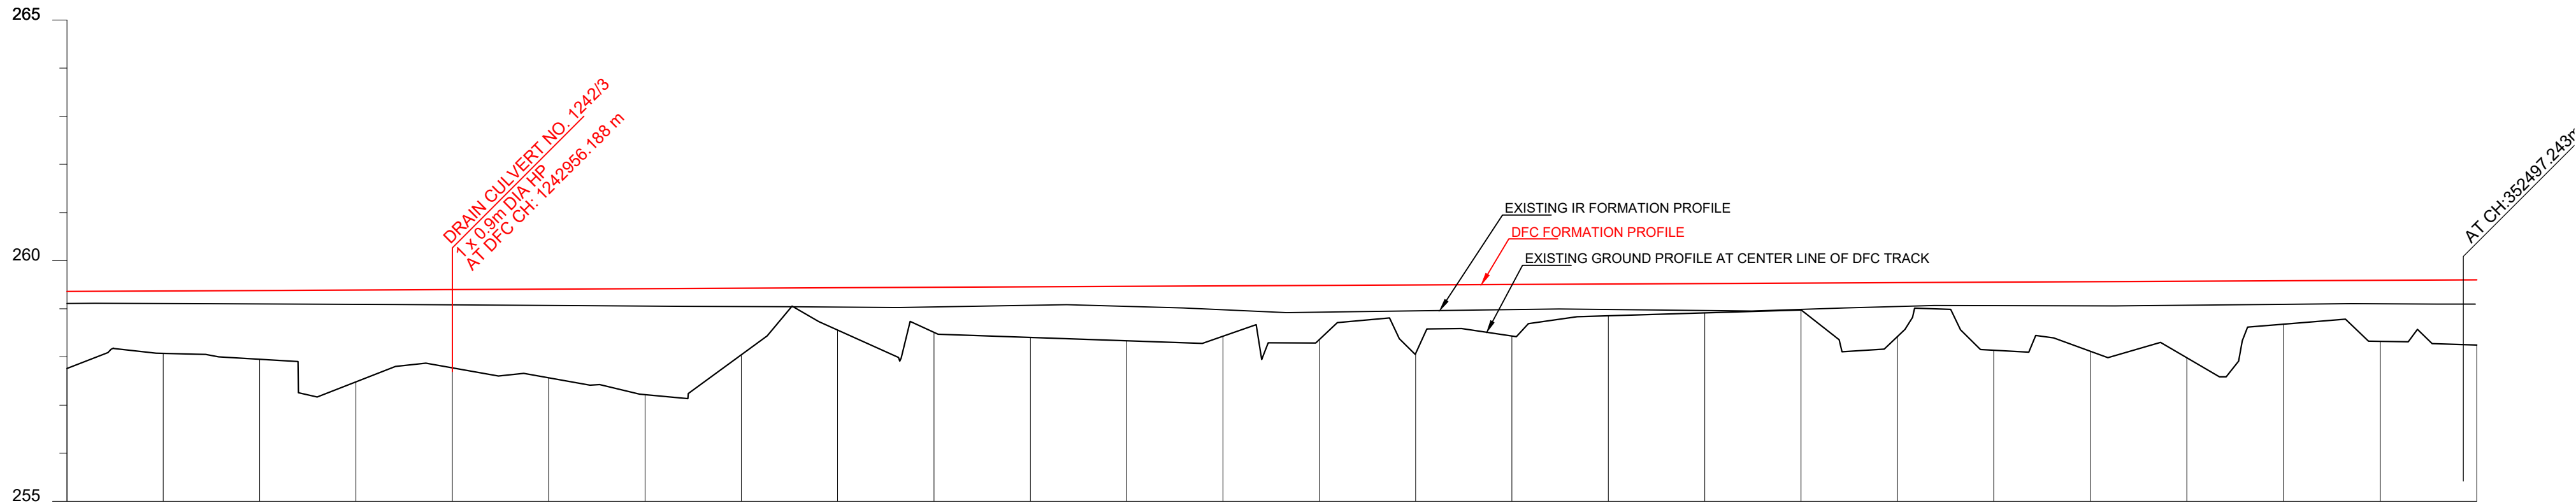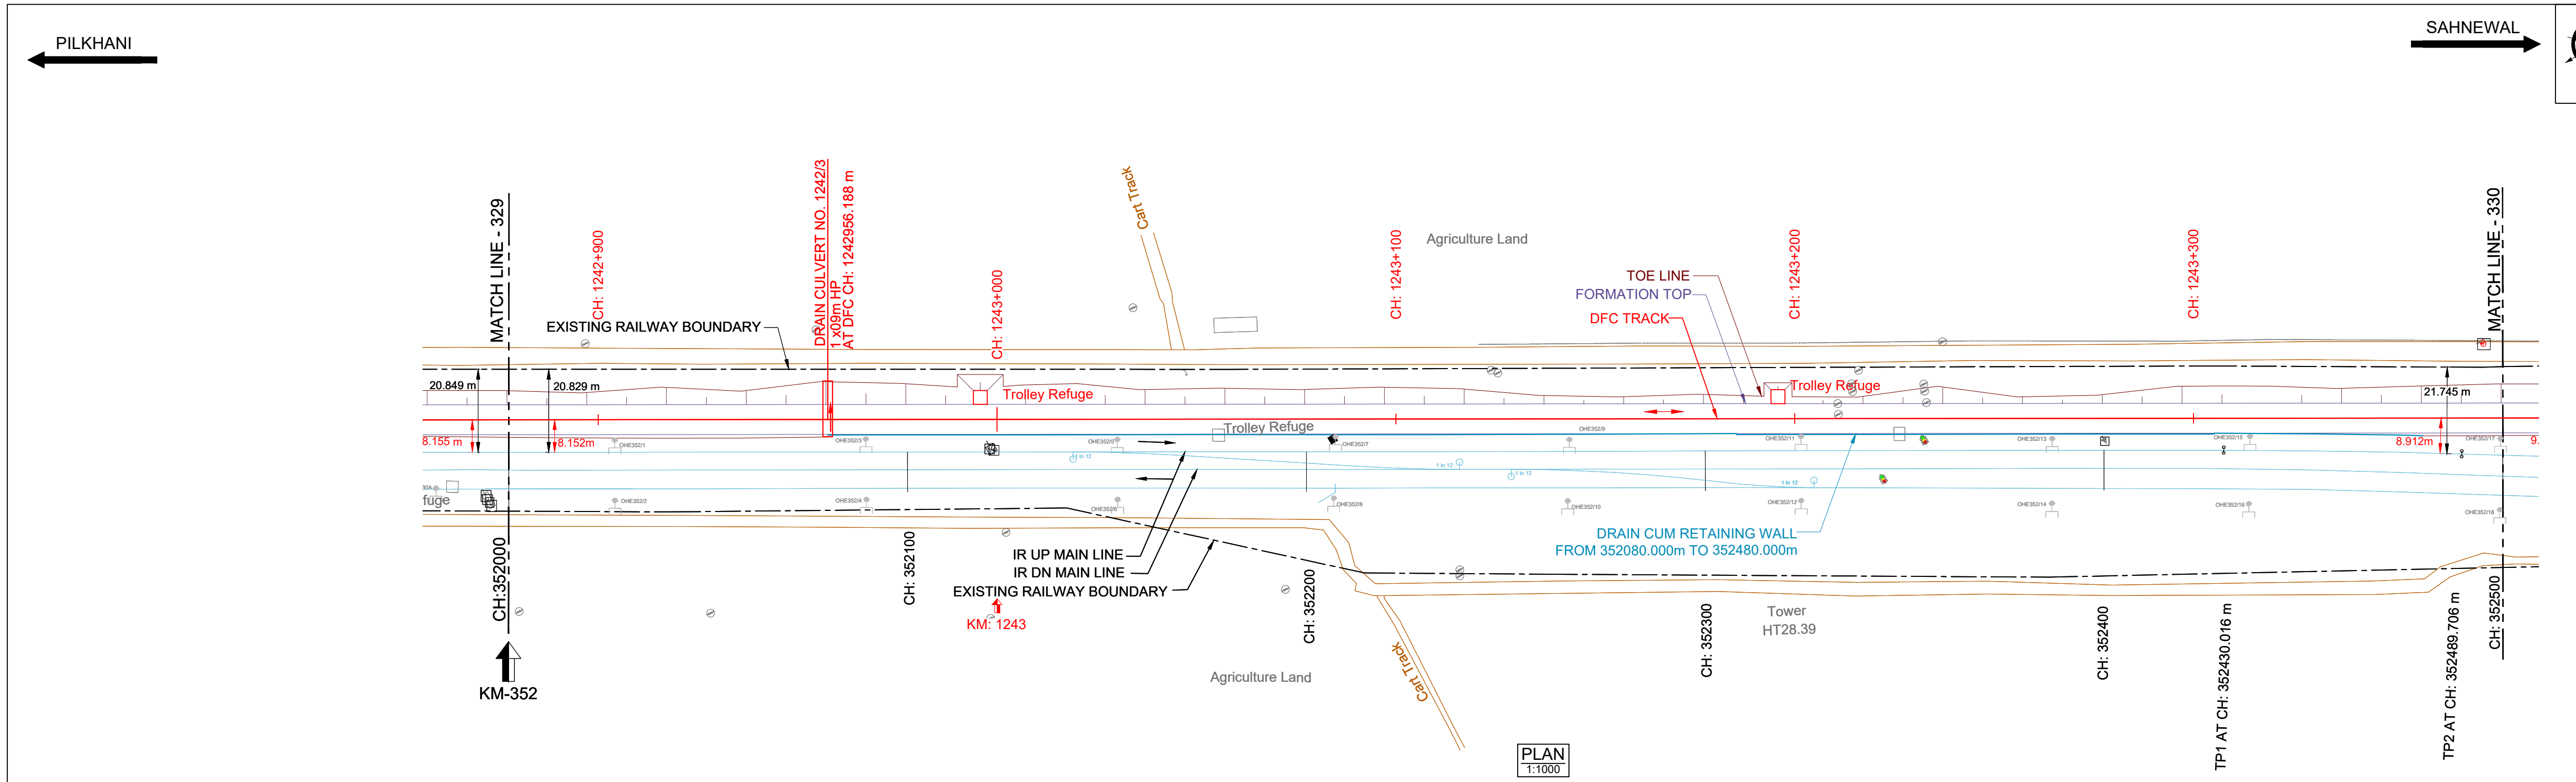

DATUM ABOVE MSL : 255 m

HORIZONTAL ALIGNMENT	L = 4280.337m																			
VERTICAL ALIGNMENT	L = 1475.096m 1 IN 2090.525 R																			
TRACK DISTANCE FROM EXISTING NEAREST IR UP MAIN LINE TO DFC MAIN LINE	8.152	8.154	8.156	8.158	8.160	8.162	8.164	8.166	8.168	8.170	8.172	8.174	8.176	8.178	8.180	8.182	8.184	8.186	8.188	8.190
HEIGHT OF BANKING(+) / DEPTH OF CUTTING(-) (PFL-GL)	+1.600	+1.296	+1.430	+1.909	+1.626	+1.844	+2.204	+1.386	+0.882	+0.938	+1.052	+1.131	+1.047	+1.126	+1.426	+1.069	+0.661	+0.609	+0.558	+0.503
EXG GROUND LEVEL AT CENTER LINE OF DFC TRACK (GL)	257.762	258.075	257.951	257.481	257.774	257.566	257.215	258.043	258.556	258.510	258.405	258.336	258.430	258.360	258.070	258.436	258.854	258.915	258.976	258.943
EXG GROUND LEVEL AT TOE LOCATION OF DFC TRACK	257.555	257.757	257.041	257.596	256.402	256.447	257.459	256.621	257.406	257.522	257.454	257.270	257.455	258.343	258.218	258.236	258.536	258.589	257.222	257.109
DIFFERENCE BETWEEN DFC FORMATION LEVEL AND EXG.FORMATION LEVEL.(PFL-EFL)	0.253	0.262	0.281	0.259	0.318	0.339	0.361	0.381	0.403	0.411	0.385	0.417	0.498	0.567	0.540	0.521	0.529	0.560	0.547	0.503
DFC FORMATION LEVEL (PFL)	259.362	259.371	259.381	259.390	259.400	259.410	259.419	259.429	259.438	259.448	259.457	259.467	259.477	259.486	259.496	259.505	259.515	259.524	259.534	259.543
EXG. FORMATION LEVEL OF EXG IR UP MAIN LINE (EFL)	259.109	259.109	259.100	259.081	259.082	259.071	259.058	259.048	259.035	259.037	259.072	259.050	259.079	259.092	259.056	259.084	259.086	259.064	259.087	259.083
DIFFERENCE BETWEEN DFC RAIL LEVEL AND EXG. RAIL LEVEL (PRL - ERL)	0.293	0.303	0.321	0.340	0.359	0.380	0.401	0.422	0.444	0.451	0.426	0.458	0.538	0.598	0.580	0.561	0.569	0.601	0.588	0.543
DFC RAIL LEVEL (PRL)	260.074	260.084	260.093	260.103	260.113	260.122	260.132	260.141	260.151	260.160	260.170	260.180	260.189	260.199	260.208	260.218	260.227	260.237	260.247	260.256
EXG.RAIL LEVEL OF NEAREST IR UP MAIN LINE(ERL)	259.781	259.781	259.772	259.763	259.754	259.743	259.730	259.720	259.707	259.709	259.744	259.722	259.651	259.601	259.628	259.656	259.658	259.636	259.659	259.670
EQUIVALENT CHAINAGE ON DFC TRACK	1242976.9	1242986.9	1242916.9	1242936.9	1242956.9	1242976.9	1242996.9	1243016.9	1243036.9	1243056.9	1243076.9	1243096.9	1243116.9	1243136.9	1243156.9	1243176.9	1243196.9	1243216.9	1243236.9	1243256.9
EXISTING IR CHAINAGE	352000.0	352020.0	352040.0	352060.0	352080.0	352100.0	352120.0	352140.0	352160.0	352180.0	352200.0	352220.0	352240.0	352260.0	352280.0	352300.0	352320.0	352340.0	352360.0	352380.0

L - SECTION

NOTE:-

- DFCC WORKS ARE SHOWN IN RED.
- IR NEW WORKS ARE SHOWN IN VIOLET.
- ALL DIMENSIONS ARE SHOWN IN METRES.
- THIS DRAWING IS PREPARED BASED ON LATEST SURVEY DATA HELD ON APRIL-2022. GTS BENCH MARK OF 261.850M CONSIDERED ON TOP OF CANAL BRIDGE ABUTMENT AT DORANA VILLAGE ALONG THE NH1.
- DFC NEW CHAINAGE OF 1075.950M IS WITH REFERENCE TO THE IR KM OF 187.500KM END OF KM OF CP-303(SECTION P-3 PILKHANI END) AGAINST THE EXISTING DFC CHAINAGE. 116277.742M ISSUED VIDE LETTER NO. COM/DFCC/UMS/SURVEY/2021-301-230116-011173 DT. 17.01.2023.
- BALLAST PROFILE HAS BEEN PROVIDED ACCORDING TO THE CLAUSE 1.11.3 OF STANDARD SCHEDULE OF DIMENSION(EASTERN CORRIDOR) & THE BALLAST CUSHION DIMENSION SHOWN IN 35CM ON GE-14 PARA 17. SPECIFICATIONS & RECOMMENDATIONS 2. TWO LAYER SYSTEM FIG.10.

REFERENCE DRAWINGS :-

- FOR KEY PLAN REFER DRAWING NO. 301-2/AL/0001
- FOR LEGEND AND ABBREVIATIONS REFER DRAWING NO. 301-2/AL/1000
- FOR TYPICAL SECTION OF BALLAST PROFILE (FL-RL) REFER DRG. NO. 301-2/TK/TFDI-004 (TR.1952)

SCALE

HOR - 1:1000

VER - 1:100

SHEET SIZE - A1

LEGEND:

IR TRACK

DFCC TRACK

DFCC FUTURE PROPOSALS

STRUCTURE / BUILDING

DFCC TOE LINE

DFCC FORMATION

RETAINING WALL

ROAD

STREAM, DRAIN, NALA, CANAL

FENCE

POWER LINES

TBM

ELECTRIC POLE/OHE MAST

IR RAILWAY BOUNDARY

DFCC BOUNDARY

TYPICAL SECTION

TRACK STRUCTURE	
RAIL SECTION: 60Kg/m (UIC 60Kg/m)	Difference between FL- RL (Below Rail Seat)
DFC LINE: 60Kg/m (UIC 60Kg/m)	IR Line
IR MAIN LINE: 52Kg/m	DFC
RUBBER PAD	172mm
SLEEPER DEPTH	6mm
BALLAST CUSHION	10mm
Total Depth (FL TO RL)	210mm
	300mm
	350mm
	688mm
	742mm

OWNER

DEDICATED FREIGHT CORRIDOR CORPORATION OF INDIA LTD.

(A GOVERNMENT OF INDIA ENTERPRISE)

PROJECT OFFICE/AMBALA UNIT: OLD RAILWAY COLONY (NEAR ANAND MARKET),AMBALA CANTT-133001.

CORPORATE IDENTITY NO. : U60232DL20060G0155068

ENGINEER:

DB Engineering & Consulting GmbH

Deutsche Bahn Engineering & Consulting GmbH

CONTRACTOR:

GIL - TPL JV

GAR TATA

SUBMITTED BY	GIL - TPL JV		
DATED	NAME	SIGNATURE	
PREPARED BY			
CHECKED BY	17.10.2024	VIJAY PRATAP	
APPROVED BY	17.10.2024	PARASURAM KOTYADA	
APPROVED BY	DEUTSCHE BAHN ENGINEERING & CONSULTING GMBH		
DATED	NAME	SIGNATURE	
Sr. DE./CHIEF ENGINEER	SURESH K.YALANGI		
CHIEF TRACK ENGINEER	RAJ PAL SINGH		
T.L.	H.D. VIDJAK		



STAMP

A AS-BUILT DRAWING TR. Ref.:..... ENGINEER Sign.:.

EMPLOYER (DFCCIL): DEDICATED FREIGHT CORRIDOR CORPORATION OF INDIA LTD.

AS BUILT DRAWING			
TITLE		DFCC APPR. NO. -	
AS-BUILT PLAN AND PROFILE		ENGG. APPR. NO. -	
FROM IR KM: 352.000 TO 352.500		DRG. NO. -301-2/AL/A/1330	
FROM DFC KM: 1242.877 to 1243.377		SHEET NO. : 1 OF 1	STATUS
		DATE : 17.10.2024	A


TR.

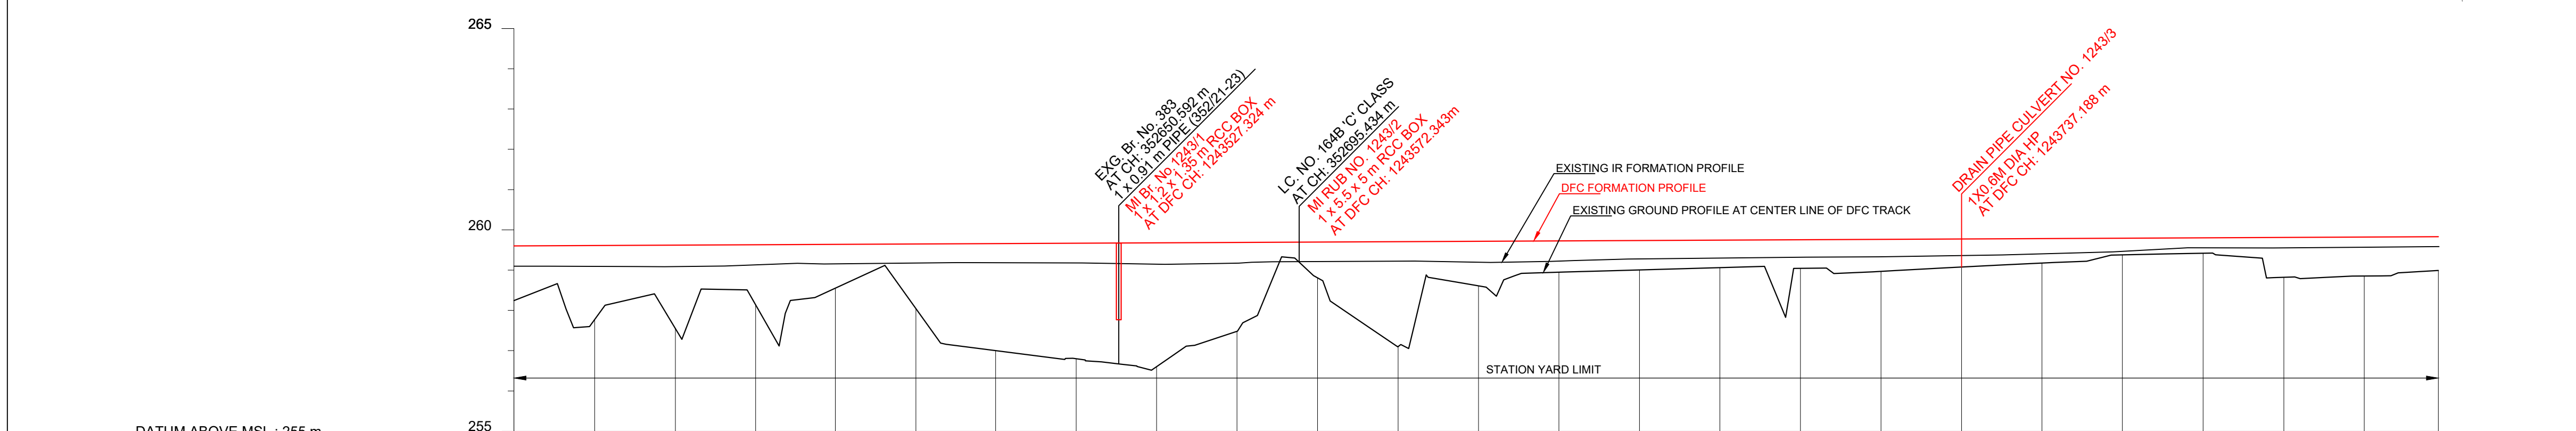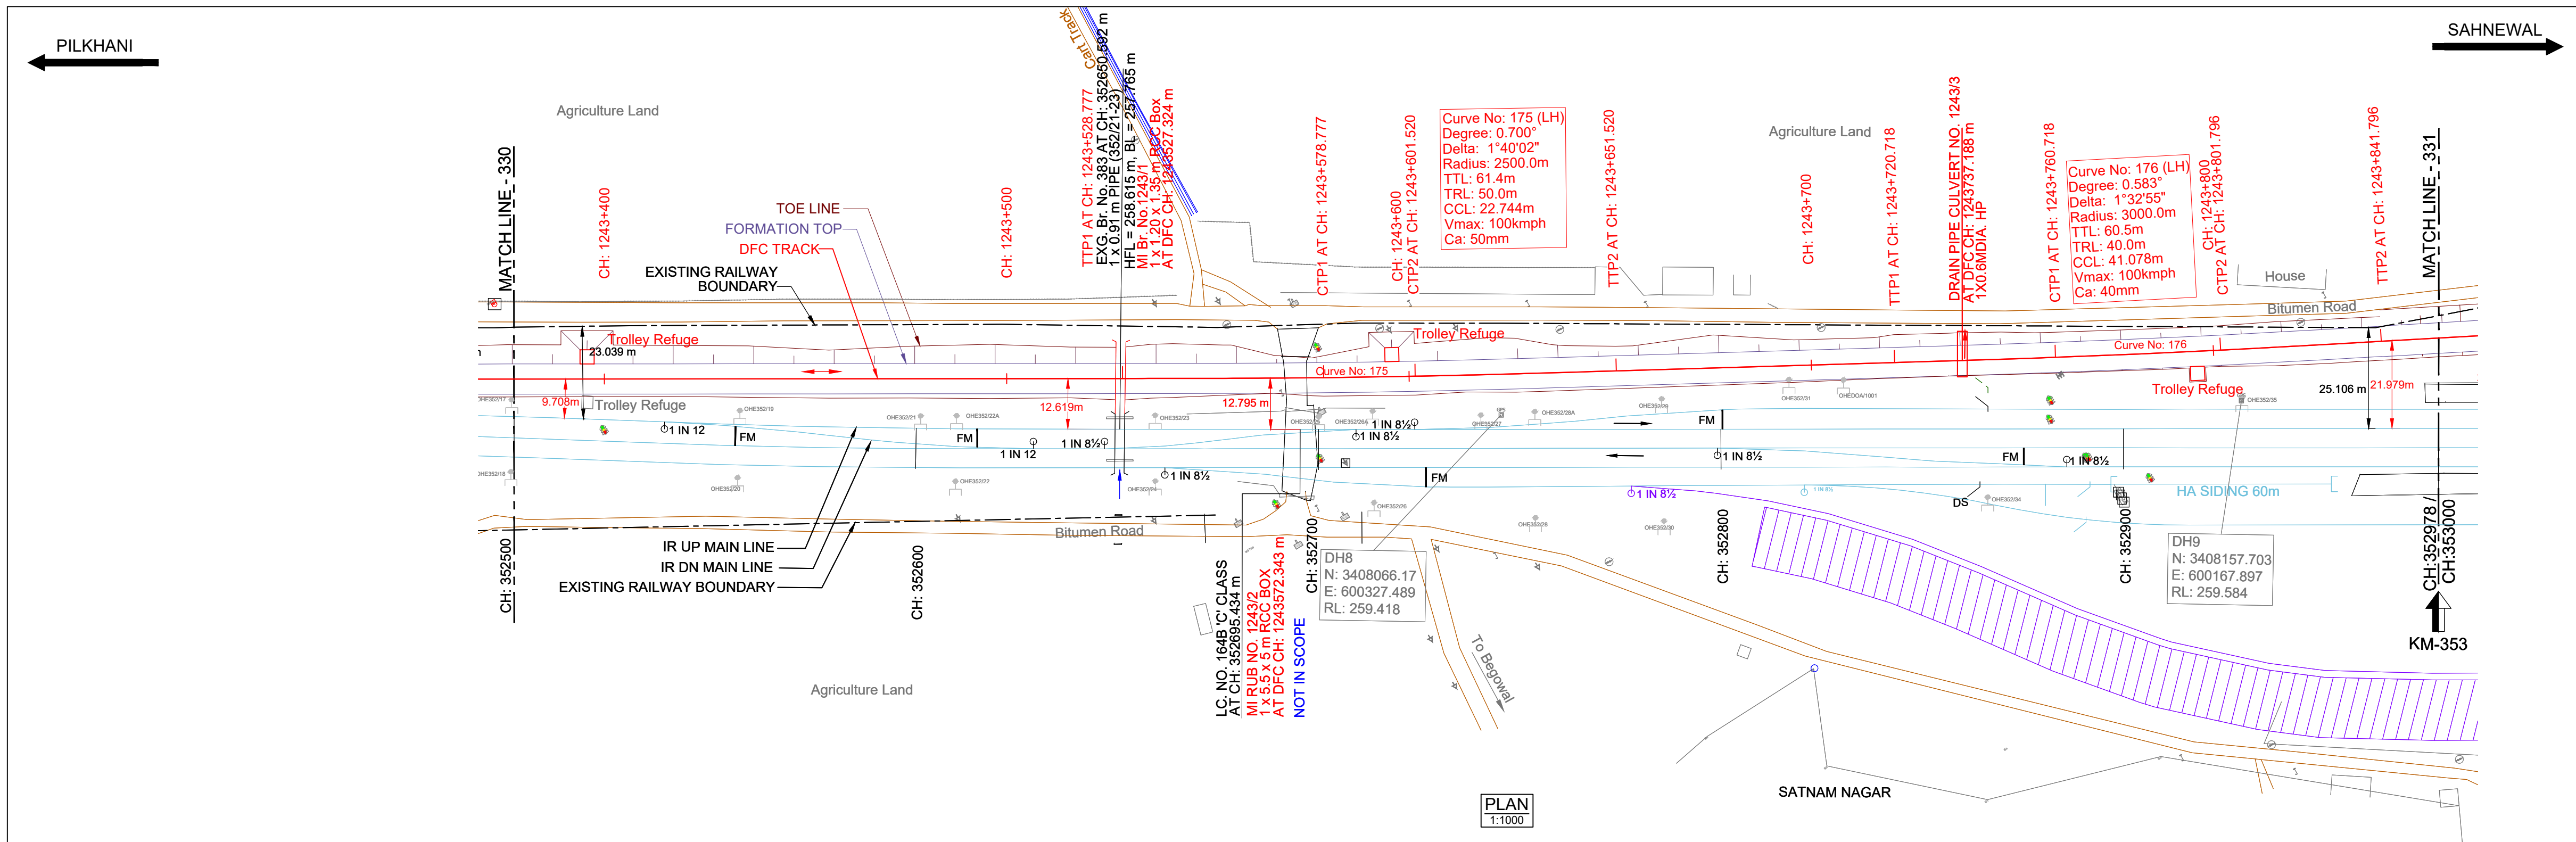

HORIZONTAL ALIGNMENT	L = 4280.337m TL = 50m R = 2500m TL = 50m L = 69.198m TL = 40m R = 3000m TL = 40m L = 137.732m																								
VERTICAL ALIGNMENT	L=1475.096m 1 IN 2090.525 R																								
TRACK DISTANCE FROM EXISTING NEAREST IR UP MAIN LINE TO DFC MAIN LINE	9.343																								
HEIGHT OF BANKING(+) / DEPTH OF CUTTING(-) (PFL-GL)	+1.354																								
EXG GROUND LEVEL AT CENTER LINE OF DFC TRACK (GL)	257.109	257.247																							
EXG GROUND LEVEL AT TOE LOCATION OF DFC TRACK	257.109	257.135	257.774																						
DIFFERENCE BETWEEN DFC FORMATION LEVEL AND EXG.FORMATION LEVEL (PFL-EFL)	0.503																								
DFC FORMATION LEVEL (PFL)	259.601	259.601																							
EXG. FORMATION LEVEL OF EXG IR UP MAIN LINE (EFL)	259.098	259.098																							
DIFFERENCE BETWEEN DFC RAIL LEVEL AND EXG. RAIL LEVEL (PRL - ERL)	0.543	0.543																							
DFC RAIL LEVEL (PRL)	260.313	260.313																							
EXG.RAIL LEVEL OF NEAREST IR UP MAIN LINE(ERL)	259.770	259.770																							
EQUIVALENT CHAINAGE ON DFC TRACK	1243376.9	1243376.9																							
EXISTING IR CHAINAGE	352500.0	352500.0																							

L - SECTION

SAHNEWAL

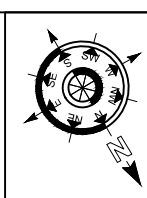

NOTE:-

1. DFC WORKS ARE SHOWN IN RED.
2. IR NEW WORKS ARE SHOWN IN VIOLET.
3. ALL DIMENSIONS ARE SHOWN IN METRES.
4. THIS DRAWING IS PREPARED BASED ON LATEST SURVEY DATA HELD ON APRIL-2022. GTS BENCH MARK OF 261.850M CONSIDERED ON TOP OF CANAL BRIDGE ABUTMENT AT DORAH VILLAGE ALONG THE NH1.
5. DFC NEW CHAINAGE OF 1075.950M IS WITH REFERENCE TO THE IR KM OF 187.500KM END OF KM OF CP-303(SECTION P-3 PILKHANI END) AGAINST THE EXISTING DFC CHAINAGE. 116277.742M ISSUED VIDE LETTER NO. COM/DFCC/MB/SURVEY/2021-301-230116-011173 DT. 17.01.2023.
6. BALLAST PROFILE HAS BEEN PROVIDED ACCORDING TO THE CLAUSE 1.11.3 OF STANDARD SCHEDULE OF DIMENSION(EASTERN CORRIDOR) & THE BALLAST CUSHION DIMENSION SHOWN IN 35CM ON GE-14 PARA 17. SPECIFICATIONS & RECOMMENDATIONS 2. TWO LAYER SYSTEM FIG.10.

REFERENCE DRAWINGS :-


1. FOR KEY PLAN REFER DRAWING NO. 301-2/AL/0001
2. FOR LEGEND AND ABBREVIATIONS REFER DRAWING NO. 301-2/AL/1000
3. FOR TYPICAL SECTION OF BALLAST PROFILE (FL-RL) REFER DRG. NO. 301-2/TK/TFD/004 (TR.1952)

REV.	DATE	REVISION DETAILS	PURPOSE OF ISSUE
0	17.10.2024	SUBMISSION OF AS-BUILT DRAWING	FOR APPROVAL

LEGEND:

SCALE: HOR - 1:1000, VER - 1:100, SHEET SIZE : A1

IR TRACK, DFC TRACK, DFC FUTURE PROPOSALS, STRUCTURE / BUILDING, DFC TOE LINE, DFC FORMATION, RETAINING WALL, ROAD, STREAM, DRAIN, NALA, CANAL, FENCE, POWER LINES, TBM, ELECTRIC POLE/OHE MAST, IR RAILWAY BOUNDARY, DFC BOUNDARY

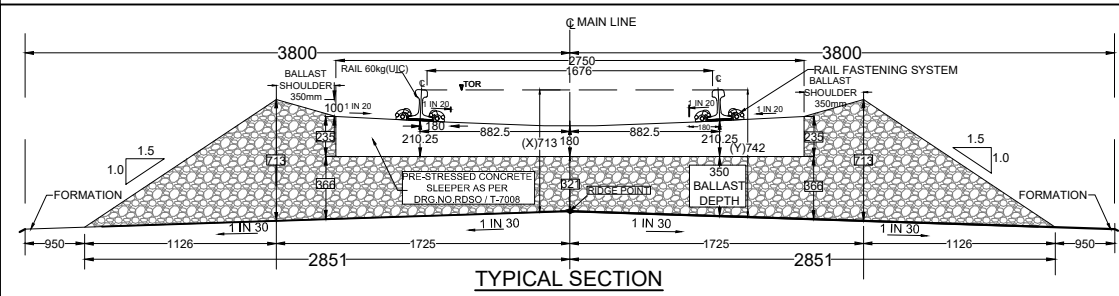

TRACK STRUCTURE		
RAIL SECTION: 60Kg/m (UIC 60Kg/m) DFC LINE: 60Kg/m (UIC 60Kg/m) IR MAIN LINE: 52Kg/m	Difference between FL- RL (Below Rail Seat)	
	IR Line	DFC
RUBBER PAD	172mm	172mm
SLEEPER DEPTH	6mm	10mm
BALLAST CUSHION	210mm	210mm
	300mm	350mm
Total Depth (FL TO RL)	688mm	742mm

OWNER: DEDICATED FREIGHT CORRIDOR CORPORATION OF INDIA LTD. (A GOVERNMENT OF INDIA ENTERPRISE) PROJECT OFFICE (AMBALA UNIT): OLD RAILWAY COLONY (NEAR ANAND MARKET), AMBALA CANTT-133001. CORPORATE IDENTITY NO. : U60232DL2006001155068

ENGINEER: DB Engineering & Consulting GmbH Deutsche Bahn Engineering & Consulting GmbH

CONTRACTOR: GIL - TPL JV GAR TATA

SUBMITTED BY	GIL - TPL JV		
	DATED	NAME	SIGNATURE
PREPARED BY			
CHECKED BY	17.10.2024	VIJAY PRATAP	
APPROVED BY	17.10.2024	PARASURAM KOTYADA	


APPROVED BY	DEUTSCHE BAHN ENGINEERING & CONSULTING GMBH		
	DATED	NAME	SIGNATURE
Sr. DE./CHIEF ENGINEER		SURESH K.YALANGI	
CHIEF TRACK ENGINEER		RAJ PAL SINGH	
T.L.		H.D. VIDJAK	



STAMP: A AS-BUILT DRAWING TR. Ref.: ENGINEER Sign.:

EMPLOYER (DFCCIL): DEDICATED FREIGHT CORRIDOR CORPORATION OF INDIA LTD.

AS BUILT DRAWING		
TITLE: AS-BUILT PLAN AND PROFILE	DFCC APPR. NO. -	
FROM IR KM: 352.500 TO 353.000	ENGG. APPR. NO. -	
FROM DFC KM: 1243.377 to 1243.855	DRG. NO. :301-2/AL/A/1331	
	SHEET NO. : 1 OF 1	STATUS: A
	DATE : 17.10.2024	

TR.

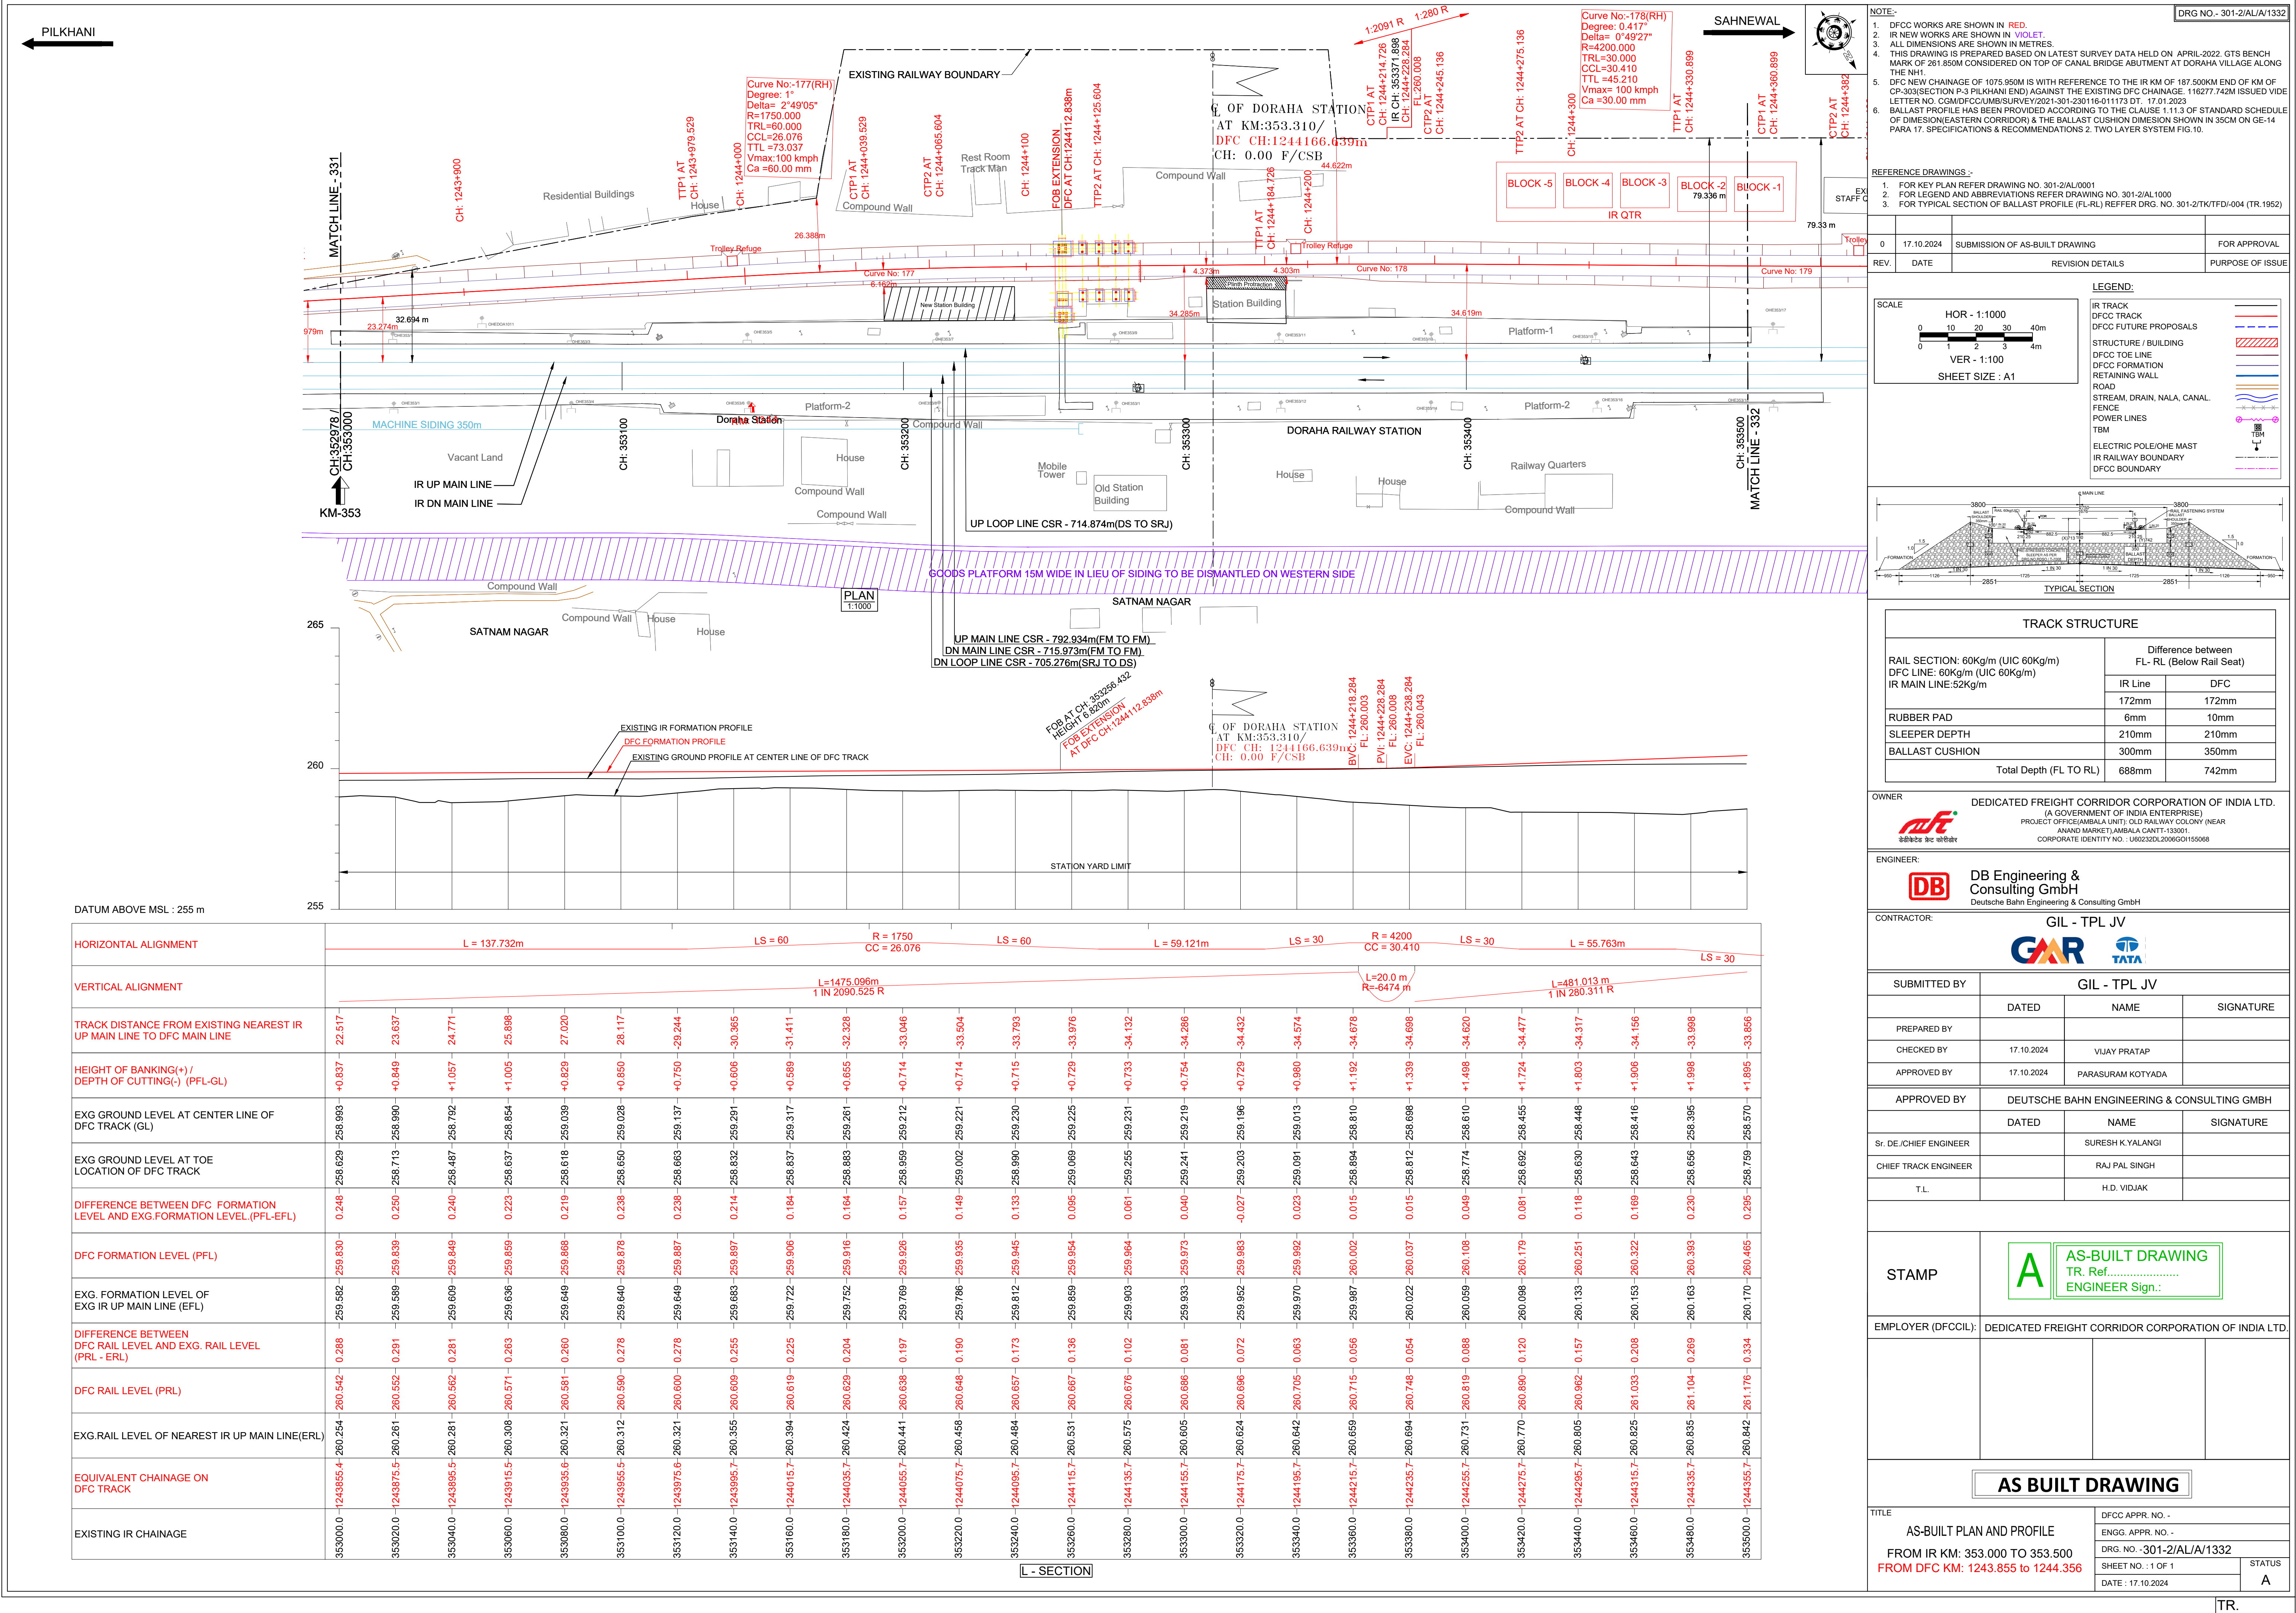

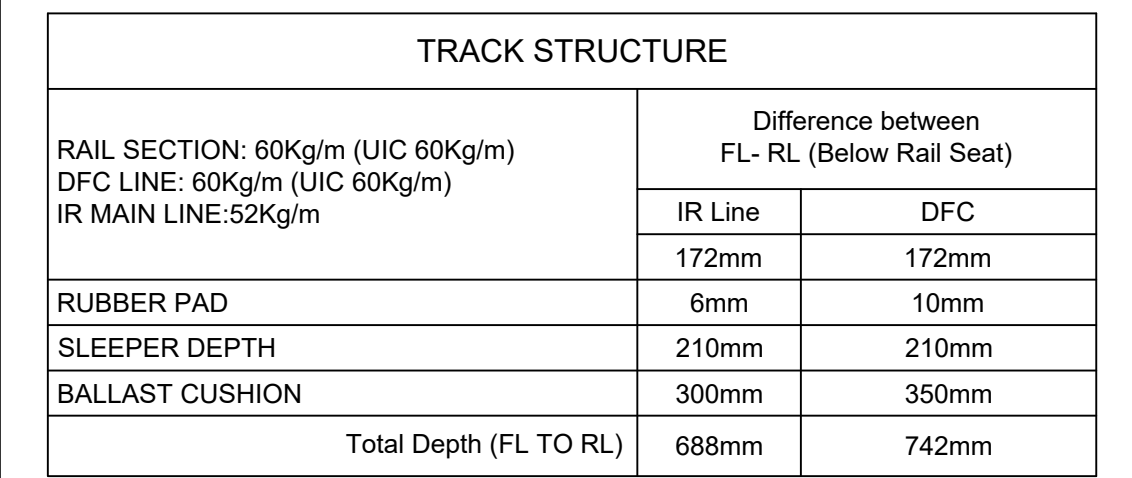
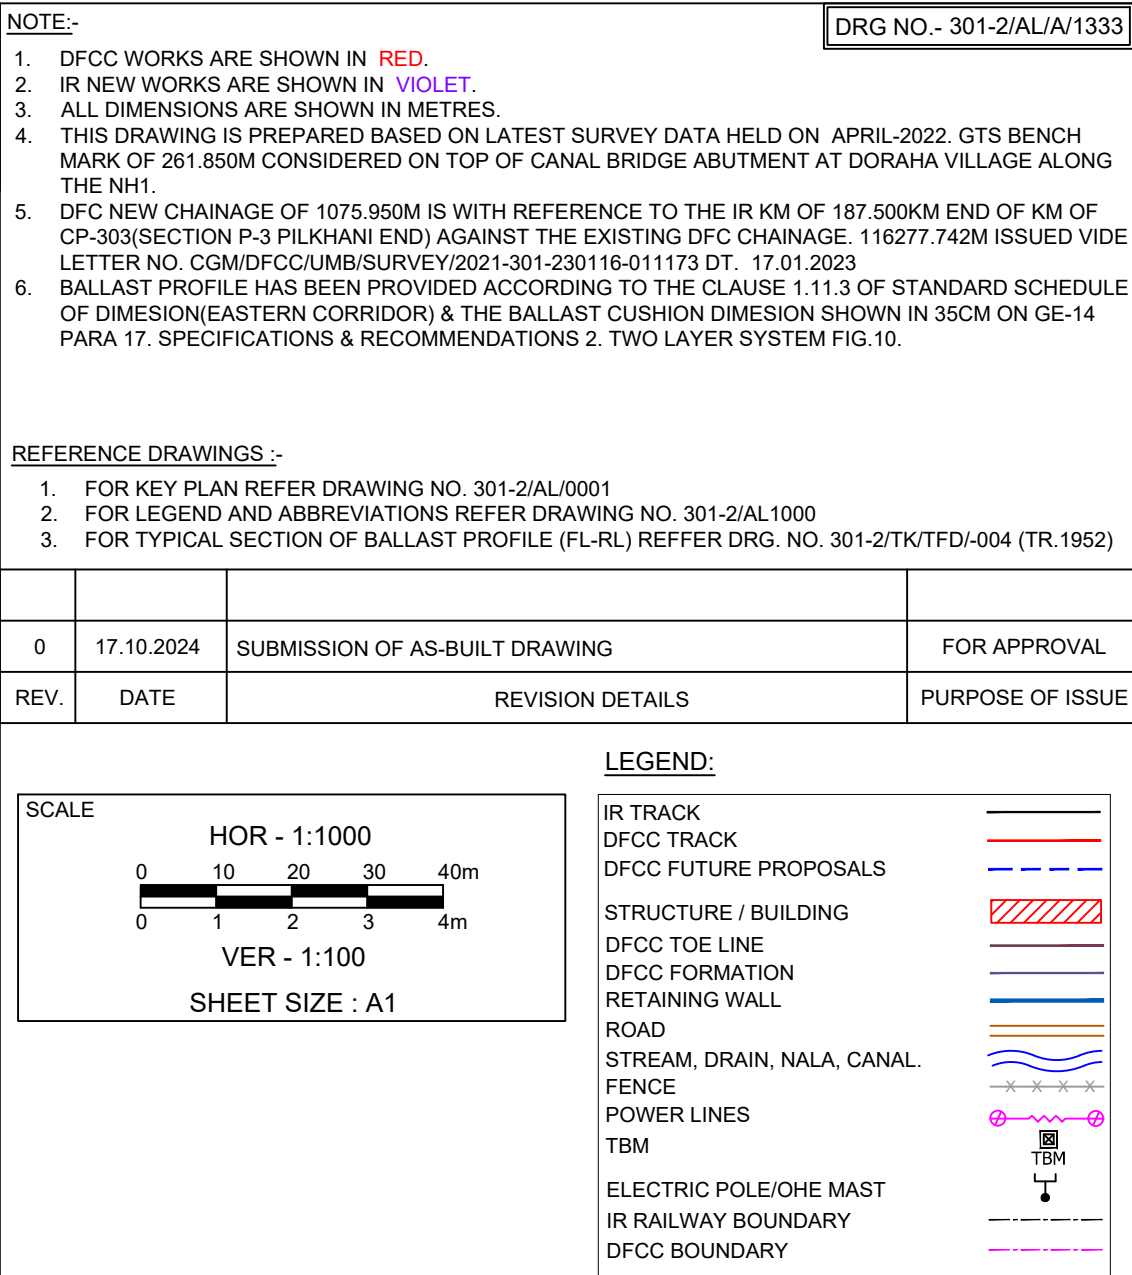


ENGINEER:

 DB Engineering & Consulting GmbH
Deutsche Bahn Engineering & Consulting GmbH

SUBMITTED BY	GIL - TPL JV		
	DATED	NAME	SIGNATURE
PREPARED BY			
CHECKED BY	17.10.2024	VIJAY PRATAP	
APPROVED BY	17.10.2024	PARASURAM KOTYADA	

APPROVED BY	DEUTSCHE BAHN ENGINEERING & CONSULTING GMBH		
	DATED	NAME	SIGNATURE
Sr. DE./CHIEF ENGINEER		SURESH K.YALANGI	
CHIEF TRACK ENGINEER		RAJ PAL SINGH	
T.L.		H.D. VIDJAK	

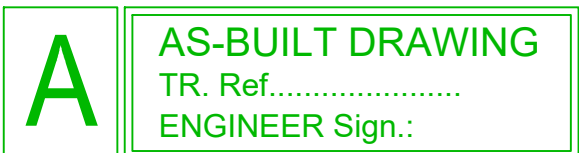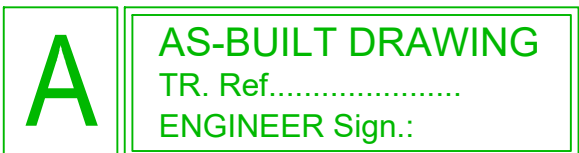STAMP			
			
EMPLOYER (DFCCIL):	DEDICATED FREIGHT CORRIDOR CORPORATION OF INDIA LTD.		

AS BUILT DRAWING	
TITLE AS-BUILT PLAN AND PROFILE FROM IR KM: 353.500 TO 354.000 FROM DFC KM: 1244.356 to 1244.856	DFCC APPR. NO. -
	ENGG. APPR. NO. -
	DRG. NO. -301-2/AL/A/1333
	SHEET NO. : 1 OF 1
	DATE : 17.10.2024
STATUS A	