



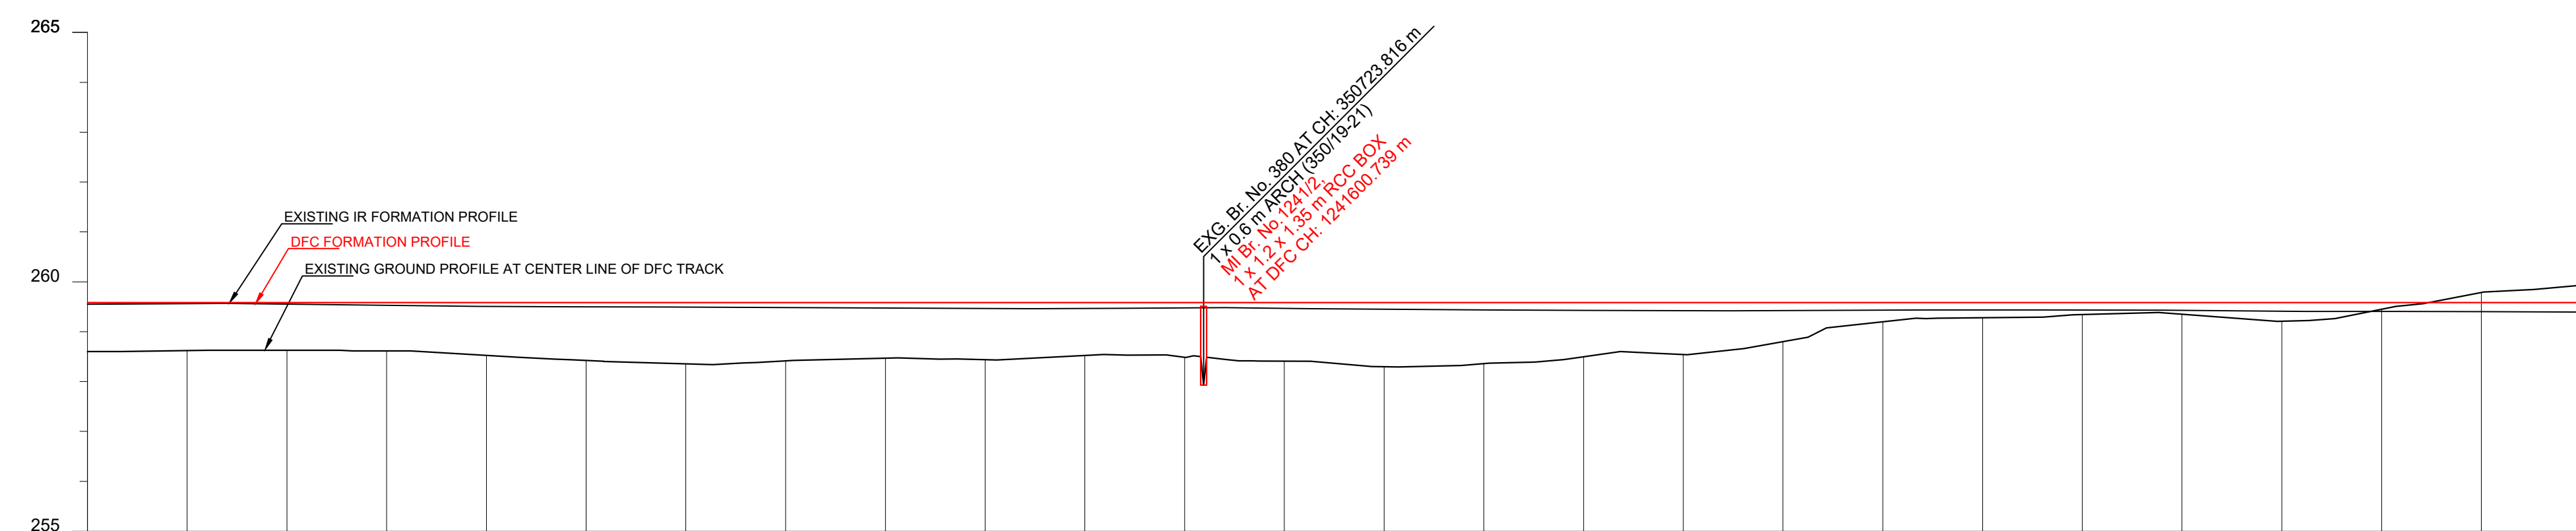

HORIZONTAL ALIGNMENT	L = 4280.337m									
VERTICAL ALIGNMENT	L=957.554 m LEVEL									
TRACK DISTANCE FROM EXISTING NEAREST IR UP MAIN LINE TO DFC MAIN LINE		- 8.177 -								
HEIGHT OF BANKING(+) / DEPTH OF CUTTING(-) (PFL-GL)		- 0.982 -								
EXG GROUND LEVEL AT CENTER LINE OF DFC TRACK (GL)		- 257.942 -	- 258.601 -							
EXG GROUND LEVEL AT TOE LOCATION OF DFC TRACK		- 257.924 -	- 258.622 -							
DIFFERENCE BETWEEN DFC FORMATION LEVEL AND EXG.FORMATION LEVEL(PFL-EFL)		- 0.033 -	- 0.022 -	- 0.031 -	- 0.054 -	- 0.069 -	- 0.167 -	- 0.152 -	- 0.160 -	- 0.159 -
DFC FORMATION LEVEL (PFL)		- 259.583 -	- 259.583 -	- 259.583 -	- 259.583 -	- 259.583 -	- 259.583 -	- 259.583 -	- 259.583 -	- 259.583 -
EXG. FORMATION LEVEL OF EXG IR UP MAIN LINE (EFL)		- 259.550 -	- 259.561 -	- 259.552 -	- 259.529 -	- 259.508 -	- 259.449 -	- 259.476 -	- 259.466 -	- 259.437 -
DIFFERENCE BETWEEN DFC RAIL LEVEL AND EXG. RAIL LEVEL (PRL - ERL)		- 0.074 -	- 0.063 -	- 0.072 -	- 0.095 -	- 0.116 -	- 0.124 -	- 0.148 -	- 0.158 -	- 0.157 -
DFC RAIL LEVEL (PRL)		- 260.296 -	- 260.296 -	- 260.296 -	- 260.296 -	- 260.296 -	- 260.296 -	- 260.296 -	- 260.296 -	- 260.296 -
EXG.RAIL LEVEL OF NEAREST IR UP MAIN LINE(ERL)		- 260.222 -	- 260.233 -	- 260.224 -	- 260.201 -	- 260.180 -	- 260.172 -	- 260.148 -	- 260.138 -	- 260.139 -
EQUIVALENT CHAINEGE ON DFC TRACK		- 1241376.9 -	- 1241396.9 -	- 1241416.9 -	- 1241436.9 -	- 1241456.9 -	- 1241476.9 -	- 1241536.9 -	- 1241556.9 -	- 1241576.9 -
EXISTING IR CHAINEGE		- 3505000.0 -	- 3505020.0 -	- 3505040.0 -	- 3505060.0 -	- 3505080.0 -	- 3505000.0 -	- 3505060.0 -	- 3505070.0 -	- 3505070.0 -
		- 3505080.0 -	- 3505100.0 -	- 3505120.0 -	- 3505140.0 -	- 3505160.0 -	- 3505180.0 -	- 3505200.0 -	- 3505220.0 -	- 3505240.0 -
		- 3505260.0 -	- 3505280.0 -	- 3505300.0 -	- 3505320.0 -	- 3505340.0 -	- 3505360.0 -	- 3505380.0 -	- 3505400.0 -	- 3505420.0 -
		- 3505440.0 -	- 3505460.0 -	- 3505480.0 -	- 3505500.0 -	- 3505520.0 -	- 3505540.0 -	- 3505560.0 -	- 3505580.0 -	- 3505600.0 -
		- 3505620.0 -	- 3505640.0 -	- 3505660.0 -	- 3505680.0 -	- 3505700.0 -	- 3505720.0 -	- 3505740.0 -	- 3505760.0 -	- 3505780.0 -
		- 3505800.0 -	- 3505820.0 -	- 3505840.0 -	- 3505860.0 -	- 3505880.0 -	- 3505900.0 -	- 3505920.0 -	- 3505940.0 -	- 3505960.0 -
		- 3505980.0 -	- 3506000.0 -	- 3506020.0 -	- 3506040.0 -	- 3506060.0 -	- 3506080.0 -	- 3506100.0 -	- 3506120.0 -	- 3506140.0 -
		- 3506160.0 -	- 3506180.0 -	- 3506200.0 -	- 3506220.0 -	- 3506240.0 -	- 3506260.0 -	- 3506280.0 -	- 3506300.0 -	- 3506320.0 -
		- 3506340.0 -	- 3506360.0 -	- 3506380.0 -	- 3506400.0 -	- 3506420.0 -	- 3506440.0 -	- 3506460.0 -	- 3506480.0 -	- 3506500.0 -
		- 3507780.0 -	- 3507800.0 -	- 3507820.0 -	- 3507840.0 -	- 3507860.0 -	- 3507880.0 -	- 3507900.0 -	- 3507920.0 -	- 3507940.0 -</

L - SECTION

SAHNEWAL

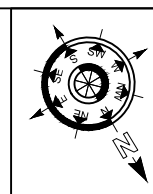

- | | |
|-------|---|
| NOTE: | DRG NO. - 301-2/AL/1327 |
| 1. | DFCC WORKS ARE SHOWN IN RED . |
| 2. | IR NEW WORKS ARE SHOWN IN VIOLET . |
| 3. | ALL DIMENSIONS ARE SHOWN IN METRES. |
| 4. | THIS DRAWING IS PREPARED BASED ON THE LATEST SURVEY DATA HELD ON APRIL-2022. GTS BENCH MARK OF 261.850M CONSIDERED ON TOP OF CANAL BRIDGE ABUTMENT AT DORAHA VILLAGE ALONG THE NH1. |
| 5. | DFC NEW ELEVATION OF 1075.950M IS WITH REFERENCE TO THE IR KM OF 187.500M END OF KM OF CP-303/SECTION 3/5 PULHANI END AGAINST THE EXISTING DFC CHAINAGE. 116277.742M ISSUED VIDEO LETTER NO. GCM/DFCO/UMB/SURVEY/2021-301-2301-261161173 DT. 17.01.2023 |
| 6. | PALLA PROFILE HAS BEEN PROVIDED ACCORDING TO THE CLAUSE 11.1.3 OF STANDARD SCHEDULE FOR NEWCASTER CORRIDOR & THE BALLAST CUSHION DIMENSION IN 35CM ON GE-14 BALLAST 17. SPECIFICATIONS & RECOMMENDATIONS 2. TWO LAYER SYSTEM OF FLD. |


REFERENCE DRAWINGS :

1. FOR KEY PLAN REFER DRAWING NO. 301-2/AL/0001
2. FOR LEGEND AND ABBREVIATIONS REFER DRAWING NO. 301-2/AL/1000
3. FOR TYPICAL SECTION OF BALLAST PROFILE (FL-RL) REFFER DRG. NO. 301-2/TK/TFD/-004 (TR.1952)

0	17.10.2024	SUBMISSION OF AS-BUILT DRAWING	FOR APPROVAL
REV.	DATE	REVISION DETAILS	PURPOSE OF ISSUE

LEGEND:

SCALE		
	HOR - 1:1000 VER - 1:100 SHEET SIZE : A1	IR TRACK DFCC TRACK DFCC FUTURE PROPOSALS STRUCTURE / BUILDING DFCC TOE LINE DFCC FORMATION RETAINING WALL ROAD STREAM, DRAIN, NALA, CANAL.. FENCE POWER LINES TBM ELECTRIC POLE/OHE MAST IR RAILWAY BOUNDARY DFCC BOUNDARY

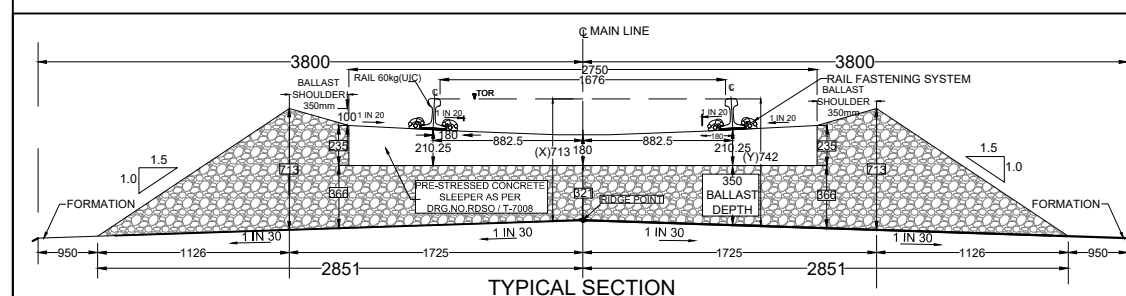

TRACK STRUCTURE		
RAIL SECTION: 60Kg/m (UIC 60Kg/m) DFC LINE: 60Kg/m (UIC 60Kg/m) IR MAIN LINE: 52Kg/m	Difference between FL- RL (Below Rail Seat)	
	IR Line	DFC
	172mm	172mm
RUBBER PAD	6mm	10mm
SLEEPER DEPTH	210mm	210mm
BALLAST CUSHION	300mm	350mm
Total Depth (FL TO RL)	688mm	742mm

OWNER



केंद्रीय फ्रीट कॉरिडोर

DEDICATED FREIGHT CORRIDOR CORPORATION OF INDIA LTD.
(A GOVERNMENT OF INDIA ENTERPRISE)
PROJECT OFFICE/AMBALA UNIT: OLD RAILWAY COLONY (NEAR
ANAND MARKET), AMBALA CANTT-133001.
CORPORATE IDENTITY NO.: U60232DL2006GG0155068

ENGINEER:

 DB Engineering & Consulting GmbH
Deutsche Bahn Engineering & Consulting GmbH

CONTRACTOR: GIL - TPL JV

SUBMITTED BY	GIL - TPL JV		
	DATED	NAME	SIGNATURE
PREPARED BY			
CHECKED BY	17.10.2024	VIJAY PRATAP	
APPROVED BY	17.10.2024	PARASURAM KOTYADA	

APPROVED BY	DEUTSCHE BAHN ENGINEERING & CONSULTING GMBH		
	DATED	NAME	SIGNATURE
Sr. DE./CHIEF ENGINEER		SURESH K.YALANGI	
CHIEF TRACK ENGINEER		RAJ PAL SINGH	
T.L.		H.D. VIDJAK	

STAMP	 
EMPLOYER (DFCCIL):	DEDICATED FREIGHT CORRIDOR CORPORATION OF INDIA LTD

EMPLOYER (DFCCIL):	DEDICATED FREIGHT CORRIDOR CORPORATION OF INDIA LTD
--------------------	---

AS BUILT DRAWING

TITLE AS-BUILT PLAN AND PROFILE FROM IR KM: 350.500 TO 351.000 FROM DFC KM: 1241.377 to 1241.877	DFCC APPR. NO. -	STATUS A
	ENGG. APPR. NO. -	
	DRG. NO. -301-2/AL/A/1327	
	SHEET NO. : 1 OF 1	
	DATE : 17.10.2024	

TR
