


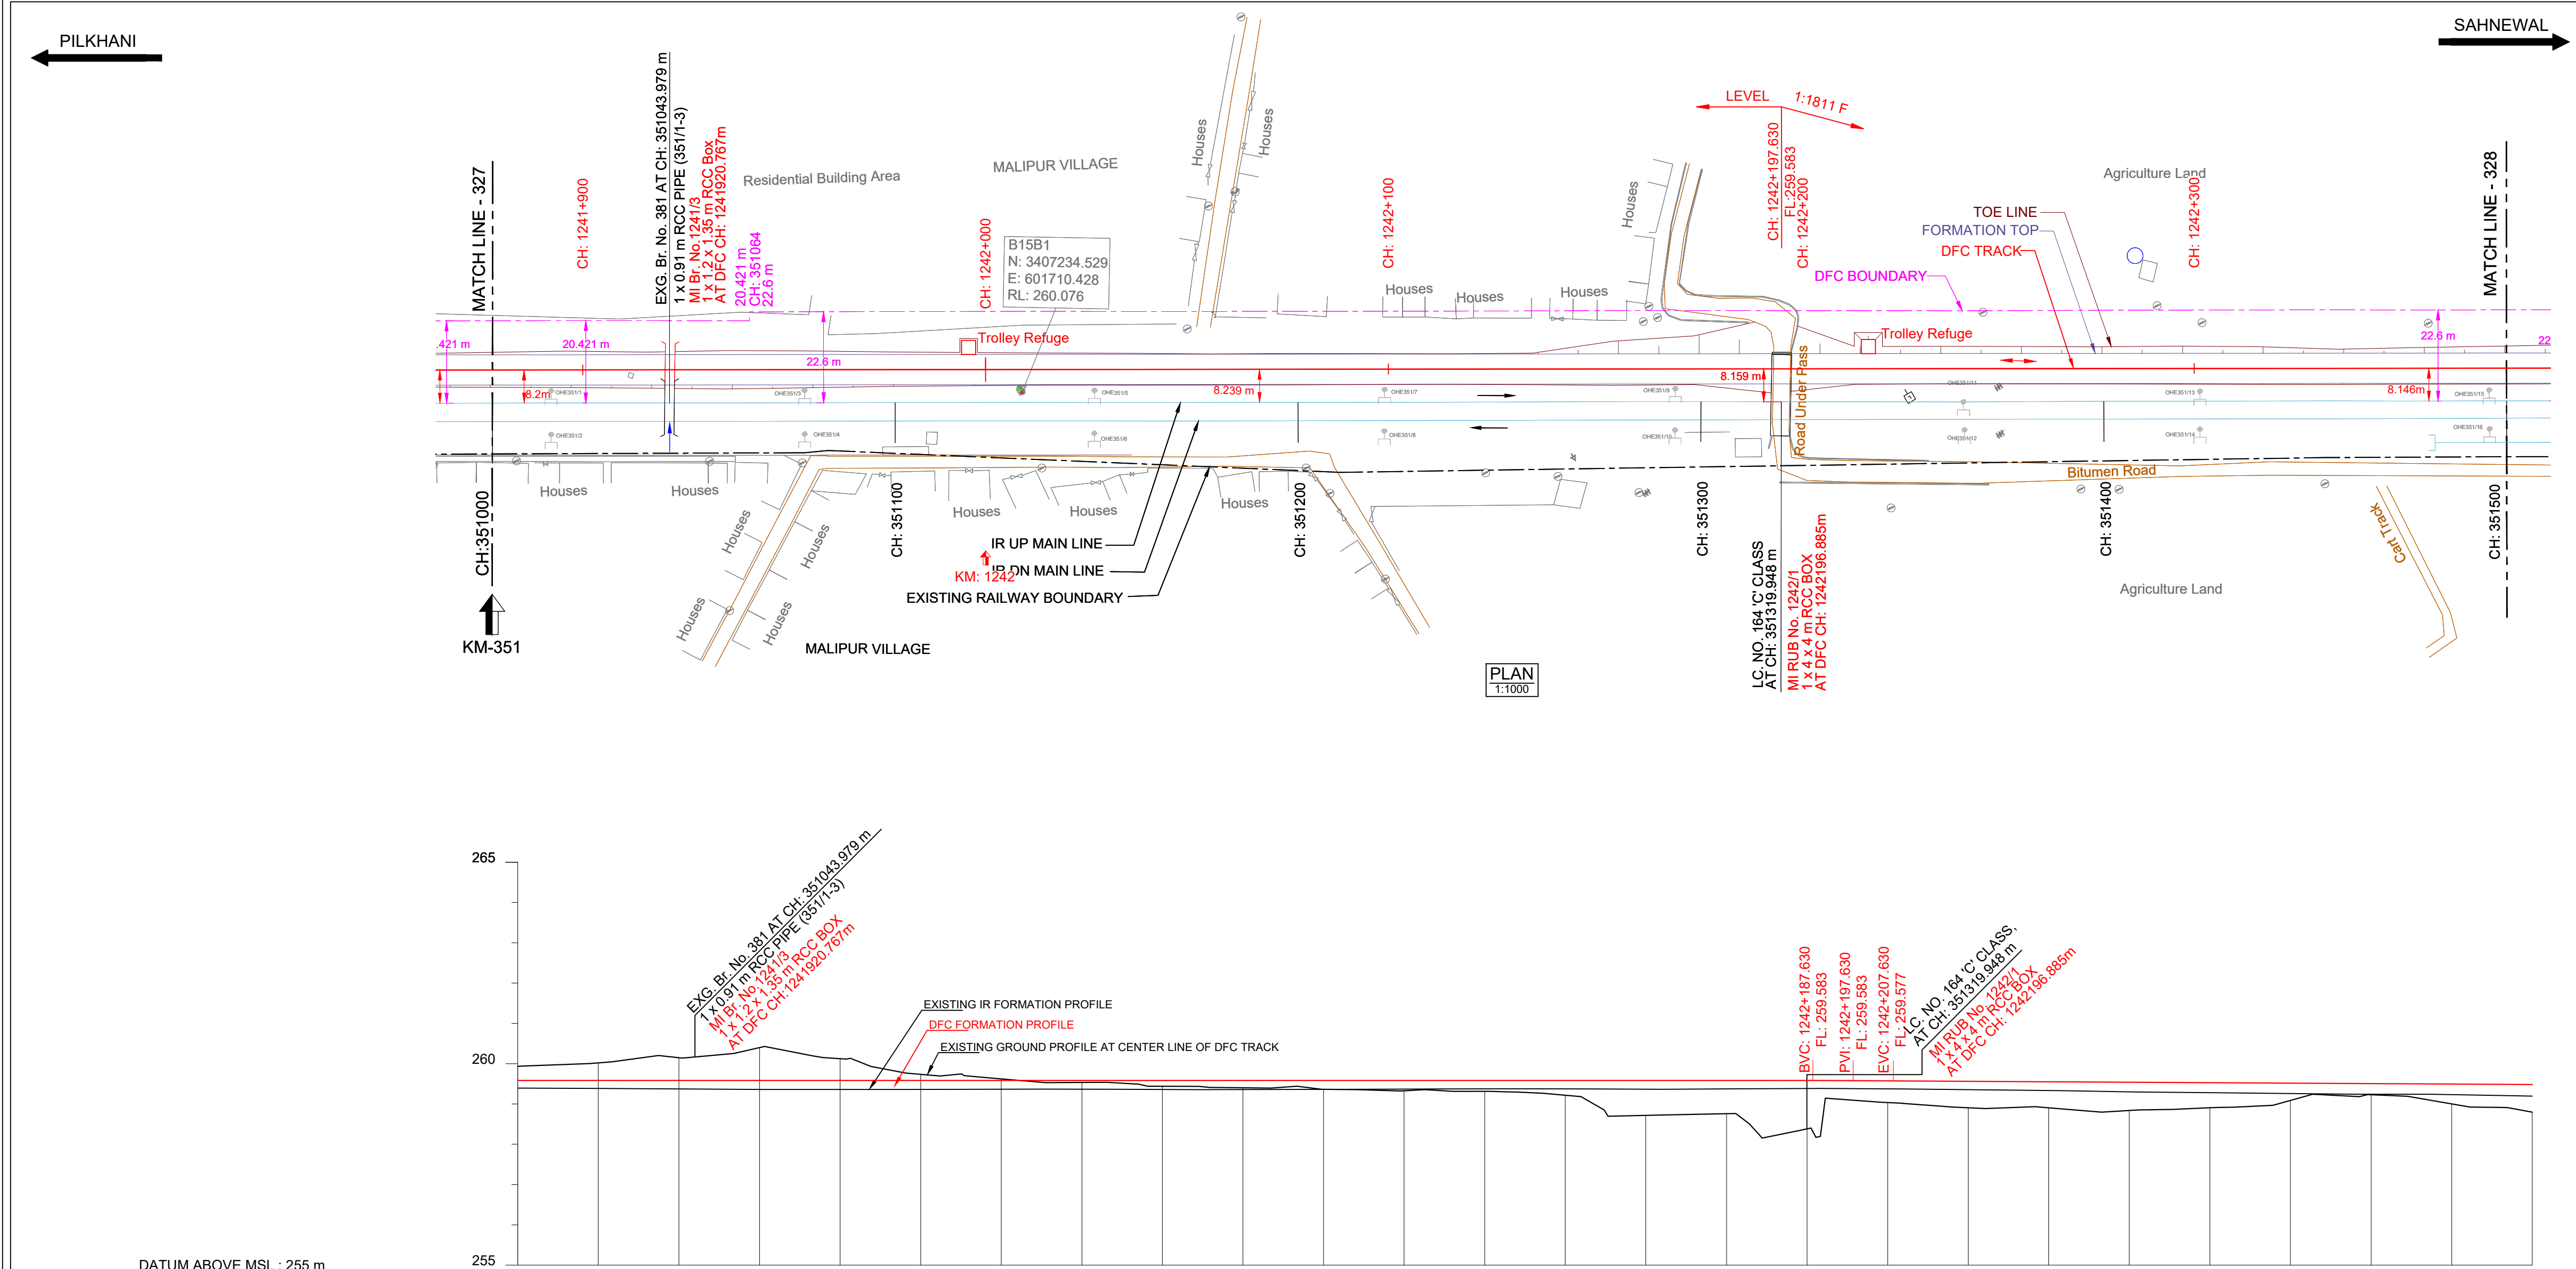

HORIZONTAL ALIGNMENT	L = 4280.337m																			
VERTICAL ALIGNMENT	L=957.554 m LEVEL L=20.000m R=36224 L=504.898 m 1 IN 1811.197 F																			
TRACK DISTANCE FROM EXISTING NEAREST IR UP MAIN LINE TO DFC MAIN LINE	8.211	8.182	8.213	8.244	8.213	8.186	8.183	8.195	8.226	8.240	8.239	8.227	8.207	8.166	8.108	8.124	8.196	8.235	8.197	8.147
HEIGHT OF BANKING(+) / DEPTH OF CUTTING(-) (PFL-GL)	-0.348	-0.437	-0.566	-0.816	-0.542	-0.151	-0.039	0.048	0.144	0.180	0.218	0.256	0.268	0.365	0.867	0.825	1.201	0.654	0.646	0.494
EXG GROUND LEVEL AT CENTER LINE OF DFC TRACK (GL)	259.931	260.020	260.149	260.399	260.125	259.734	259.622	259.535	259.439	259.403	259.365	259.327	259.315	259.218	257.716	258.758	258.382	258.907	258.904	259.001
EXG GROUND LEVEL AT TOE LOCATION OF DFC TRACK	259.941	260.241	259.941	260.361	260.198	259.965	259.748	259.656	259.540	259.348	259.454	259.386	259.281	259.137	257.456	258.842	258.482	258.383	258.404	258.543
DIFFERENCE BETWEEN DFC FORMATION LEVEL AND EXG.FORMATION LEVEL (PFL-EFL)	0.189	0.195	0.209	0.222	0.222	0.222	0.216	0.216	0.223	0.224	0.220	0.214	0.207	0.207	0.215	0.208	0.196	0.204	0.217	0.264
DFC FORMATION LEVEL (PFL)	259.583	259.583	259.583	259.583	259.583	259.583	259.583	259.583	259.583	259.583	259.583	259.583	259.583	259.583	259.583	259.583	259.572	259.561	259.550	259.485
EXG. FORMATION LEVEL OF EXG IR UP MAIN LINE (EFL)	259.394	259.388	259.374	259.361	259.361	259.361	259.367	259.367	259.360	259.359	259.363	259.369	259.376	259.376	259.368	259.375	259.376	259.357	259.333	259.231
DIFFERENCE BETWEEN DFC RAIL LEVEL AND EXG. RAIL LEVEL (PRL - ERL)	0.230	0.236	0.250	0.263	0.263	0.263	0.257	0.257	0.264	0.265	0.261	0.255	0.248	0.248	0.256	0.249	0.237	0.246	0.258	0.305
DFC RAIL LEVEL (PRL)	260.296	260.296	260.296	260.296	260.296	260.296	260.296	260.296	260.296	260.296	260.296	260.296	260.296	260.296	260.296	260.296	260.285	260.274	260.263	260.208
EXG.RAIL LEVEL OF NEAREST IR UP MAIN LINE(ERL)	260.066	260.060	260.046	260.033	260.033	260.033	260.039	260.039	260.032	260.031	260.035	260.041	260.048	260.048	260.040	260.047	260.057	260.029	260.005	260.003
EQUIVALENT CHAINAGE ON DFC TRACK	-1241877.0	-1241896.9	-1241916.9	-1241936.9	-1241956.9	-1241976.9	-1241996.9	-1242016.9	-1242036.9	-1242056.9	-1242076.9	-1242096.9	-1242116.9	-1242136.9	-1242156.9	-1242176.9	-1242196.9	-1242216.9	-1242236.9	-1242256.9
EXISTING IR CHAINAGE	351000.0	351020.0	351040.0	351060.0	351080.0	351100.0	351120.0	351140.0	351160.0	351180.0	351200.0	351220.0	351240.0	351260.0	351280.0	351300.0	351320.0	351340.0	351360.0	351380.0

L - SECTION

NOTE:-

- DFCC WORKS ARE SHOWN IN RED.
- IR NEW WORKS ARE SHOWN IN VIOLET.
- ALL DIMENSIONS ARE SHOWN IN METRES.
- THIS DRAWING IS PREPARED BASED ON LATEST SURVEY DATA HELD ON APRIL-2022. GTS BENCH MARK OF 261.850M CONSIDERED ON TOP OF CANAL BRIDGE ABUTMENT AT DORANA VILLAGE ALONG THE NH1.
- DFC NEW CHAINAGE OF 1075.950M IS WITH REFERENCE TO THE IR KM OF 187.500KM END OF KM OF CP-303(SECTION P-3 PILKHANI END) AGAINST THE EXISTING DFC CHAINAGE. 116277.742M ISSUED VIDE LETTER NO. COM/DFCC/UM/SURVEY/2021-301-2301/16-011173.DT. 17.01.2023.
- BALLAST PROFILE HAS BEEN PROVIDED ACCORDING TO THE CLAUSE 1.11.3 OF STANDARD SCHEDULE OF DIMENSION(EASTERN CORRIDOR) & THE BALLAST CUSHION DIMENSION SHOWN IN 35CM ON GE-14 PARA 17. SPECIFICATIONS & RECOMMENDATIONS 2. TWO LAYER SYSTEM FIG.10.

REFERENCE DRAWINGS :-

- FOR KEY PLAN REFER DRAWING NO. 301-2/AL/0001
- FOR LEGEND AND ABBREVIATIONS REFER DRAWING NO. 301-2/AL/1000
- FOR TYPICAL SECTION OF BALLAST PROFILE (FL-RL) REFER DRG. NO. 301-2/TK/TFDI-004 (TR.1952)

017.10.2024SUBMISSION OF AS-BUILT DRAWINGFOR APPROVAL

REV. DATE REVISION DETAILS PURPOSE OF ISSUE

SCALE
HOR - 1:1000
VER - 1:100
SHEET SIZE : A1

LEGEND:

- IR TRACK
- DFCC TRACK
- DFCC FUTURE PROPOSALS
- STRUCTURE / BUILDING
- DFCC TOE LINE
- DFCC FORMATION
- RETAINING WALL
- ROAD
- STREAM, DRAIN, NALA, CANAL.
- POWER LINES
- TBM
- ELECTRIC POLE/OHE MAST
- IR RAILWAY BOUNDARY
- DFCC BOUNDARY

TRACK STRUCTURE

RAIL SECTION: 60Kg/m (UIC 60Kg/m)	Difference between FL- RL (Below Rail Seat)	
DFC LINE: 60Kg/m (UIC 60Kg/m)	IR Line	DFC
IR MAIN LINE: 52Kg/m	172mm	172mm
	6mm	10mm
RUBBER PAD	210mm	210mm
SLEEPER DEPTH	300mm	350mm
BALLAST CUSHION	688mm	742mm
Total Depth (FL TO RL)		

OWNER

DEDICATED FREIGHT CORRIDOR CORPORATION OF INDIA LTD.
(A GOVERNMENT OF INDIA ENTERPRISE)
PROJECT OFFICE(AMBALA UNIT): OLD RAILWAY COLONY (NEAR ANAND MARKET),AMBALA CANTT-133001.
CORPORATE IDENTITY NO. : U60232DL2006GGI155068

ENGINEER:

DB Engineering & Consulting GmbH
Deutsche Bahn Engineering & Consulting GmbH

CONTRACTOR:

GIL - TPL JV

SUBMITTED BY	GIL - TPL JV		
	DATED	NAME	SIGNATURE
PREPARED BY			
CHECKED BY	17.10.2024	VIJAY PRATAP	
APPROVED BY	17.10.2024	PARASURAM KOTYADA	
APPROVED BY	DEUTSCHE BAHN ENGINEERING & CONSULTING GMBH		
	DATED	NAME	SIGNATURE
Sr. DE./CHIEF ENGINEER		SURESH K.YALANGI	
CHIEF TRACK ENGINEER		RAJ PAL SINGH	
T.L.		H.D. VIDJAK	

STAMP

EMPLOYER (DFCCIL):

DEDICATED FREIGHT CORRIDOR CORPORATION OF INDIA LTD.

TITLE

AS-BUILT PLAN AND PROFILE

FROM IR KM: 351.000 TO 351.500

FROM DFC KM: 1241.877 to 1242.377

DFCC APPR. NO. -

ENGG. APPR. NO. -

DRG. NO. :301-2/AL/A/1328

SHEET NO. :1 OF 1

DATE : 17.10.2024

STATUS

A

TR.