
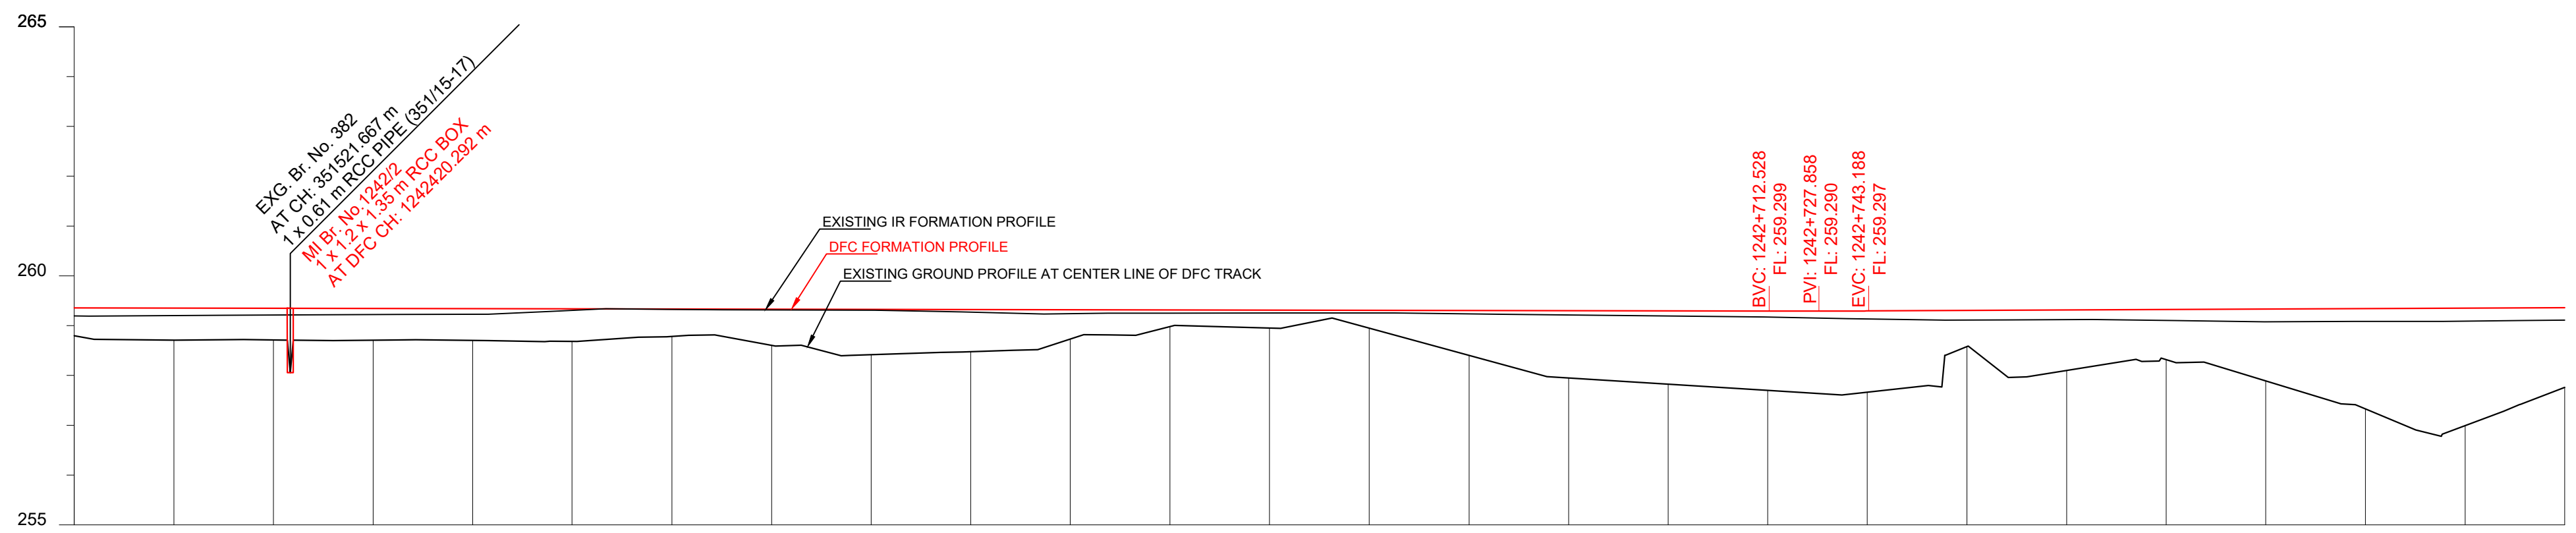


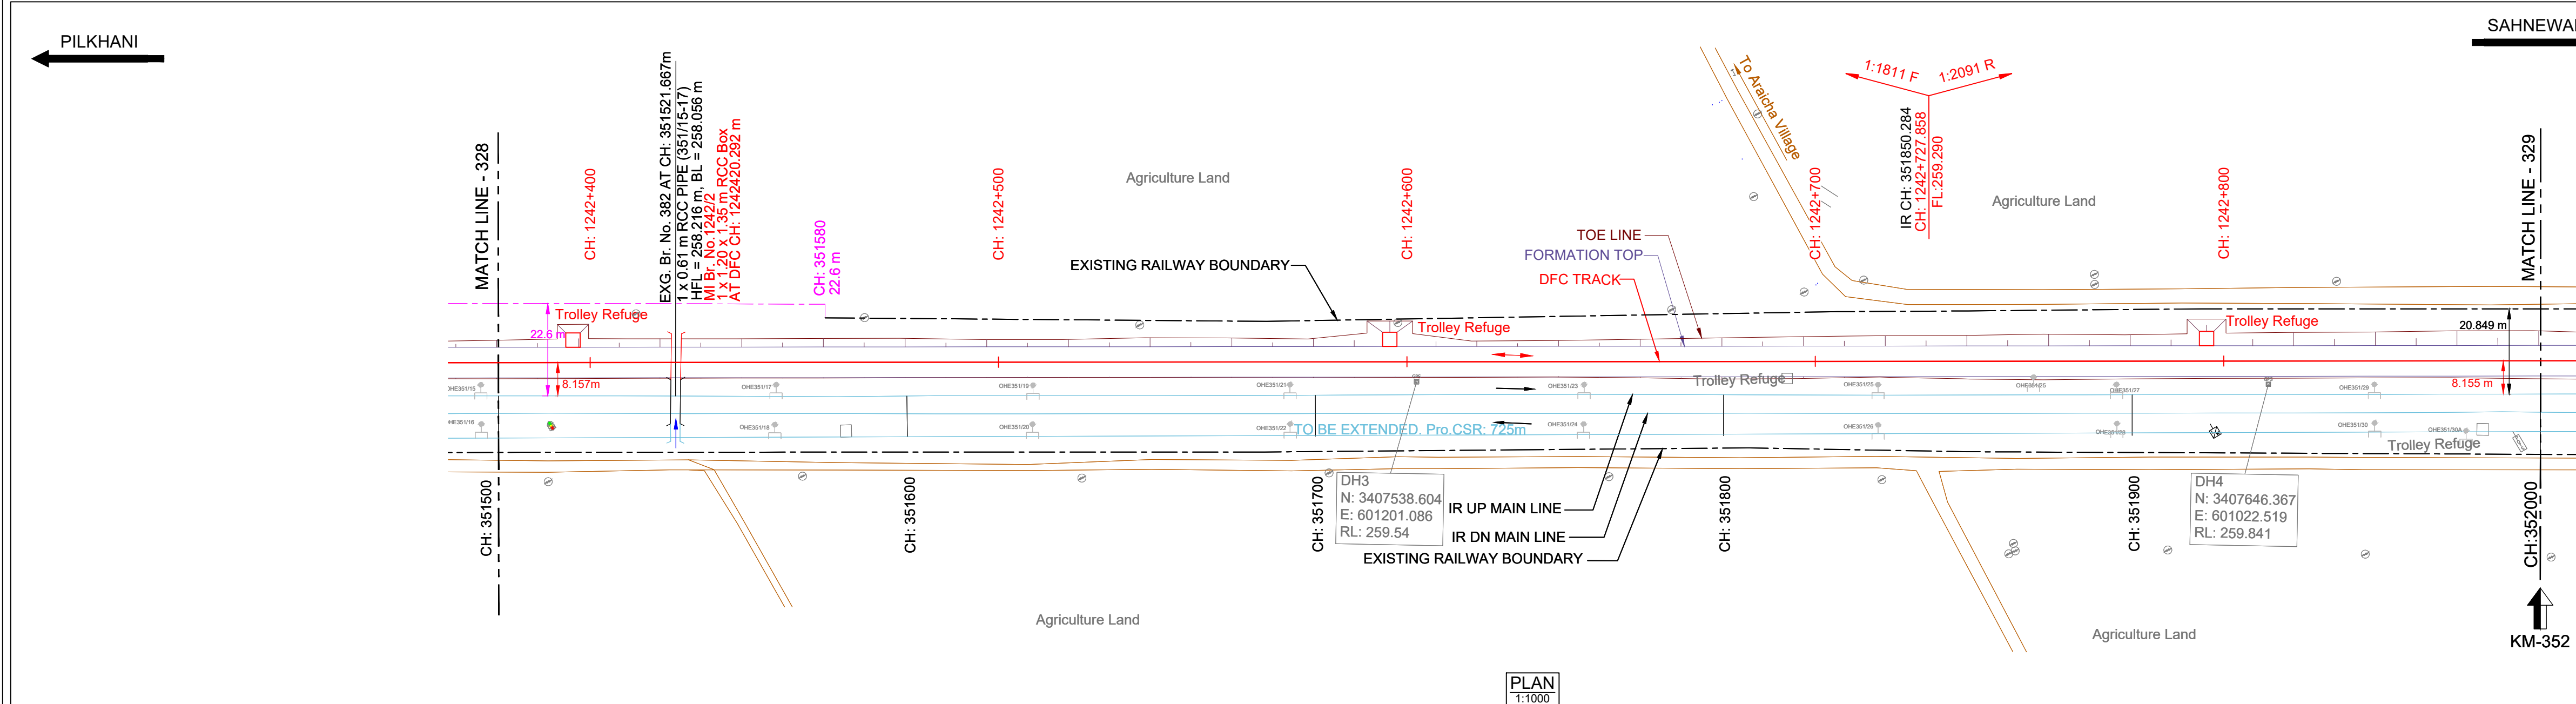


DATUM ABOVE MSL : 255 m

HORIZONTAL ALIGNMENT	L = 4280.337m																			
VERTICAL ALIGNMENT	L=504.898 m 1 IN 1811.197 F																			
TRACK DISTANCE FROM EXISTING NEAREST IR UP MAIN LINE TO DFC MAIN LINE	8.141	8.166	8.201	8.223	8.239	8.265	8.213	8.228	8.241	8.218	8.083	8.039	7.995	8.067	8.154	8.227	8.286	8.264	8.239	8.222
HEIGHT OF BANKING(+) / DEPTH OF CUTTING(-) (PFL-GL)	+0.686	+0.763	+0.749	+0.743	+0.736	+0.745	+0.634	+0.801	+0.980	+0.907	+0.381	+0.398	+0.392	+0.927	+1.369	+1.482	+1.595	+1.631	+0.724	+1.214
EXG GROUND LEVEL AT CENTER LINE OF DFC TRACK (GL)	258.798	258.709	258.712	258.707	258.703	258.683	258.783	258.605	258.415	258.477	258.981	258.953	258.948	258.402	257.949	257.825	257.701	257.684	256.580	256.100
EXG GROUND LEVEL AT TOE LOCATION OF DFC TRACK	258.394	258.191	258.227	258.198	258.188	258.199	258.337	258.338	258.143	258.141	257.166	258.555	258.479	258.332	258.179	258.040	257.923	257.894	257.794	257.812
DIFFERENCE BETWEEN DFC FORMATION LEVEL AND EXG.FORMATION LEVEL (PFL-EFL)	0.287	0.270	0.247	0.228	0.213	0.121	0.091	0.091	0.087	0.113	0.110	0.098	0.086	0.092	0.103	0.112	0.123	0.160	0.191	0.193
DFC FORMATION LEVEL (PFL)	259.484	259.472	259.461	259.450	259.439	259.428	259.417	259.406	259.395	259.384	259.252	259.351	259.340	259.329	259.318	259.307	259.296	259.295	259.304	259.314
EXG. FORMATION LEVEL OF EXG IR UP MAIN LINE (EFL)	259.197	259.202	259.214	259.222	259.226	259.307	259.326	259.315	259.308	259.271	259.252	259.253	259.254	259.237	259.215	259.195	259.173	259.135	259.113	259.121
DIFFERENCE BETWEEN DFC RAIL LEVEL AND EXG. RAIL LEVEL (PRL - ERL)	0.328	0.312	0.289	0.270	0.255	0.163	0.133	0.133	0.128	0.154	0.152	0.140	0.128	0.133	0.145	0.154	0.164	0.200	0.232	0.234
DFC RAIL LEVEL (PRL)	260.197	260.186	260.175	260.164	260.153	260.142	260.131	260.120	260.109	260.098	260.076	260.085	260.053	260.042	260.031	260.020	260.009	260.007	260.017	260.026
EXG.RAIL LEVEL OF NEAREST IR UP MAIN LINE(ERL)	259.869	259.874	259.886	259.894	259.898	259.979	259.988	259.987	259.980	259.943	259.924	259.925	259.926	259.909	259.887	259.867	259.845	259.807	259.785	259.793
EQUIVALENT CHAINAGE ON DFC TRACK	-1242376.9	-1242396.9	-1242416.9	-1242436.9	-1242456.9	-1242476.8	-1242496.9	-1242516.9	-1242536.9	-1242556.9	-1242576.9	-1242596.9	-1242616.9	-1242636.9	-1242657.0	-1242677.0	-1242696.9	-1242716.9	-1242736.9	-1242756.9
EXISTING IR CHAINAGE	351500.0	351520.0	351540.0	351560.0	351580.0	351600.0	351620.0	351640.0	351660.0	351680.0	351700.0	351720.0	351740.0	351760.0	351780.0	351800.0	351820.0	351840.0	351860.0	351880.0

L - SECTION

SAHNEWAL

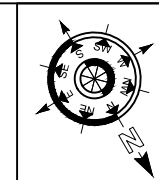

- NOTE:-
- DFCC WORKS ARE SHOWN IN RED.
 - IR NEW WORKS ARE SHOWN IN VIOLET.
 - ALL DIMENSIONS ARE SHOWN IN METRES.
 - THIS DRAWING IS PREPARED BASED ON LATEST SURVEY DATA HELD ON APRIL-2022. GTS BENCH MARK OF 261.850M CONSIDERED ON TOP OF CANAL BRIDGE ABUTMENT AT DORANA VILLAGE ALONG THE NH1.
 - DFC NEW CHAINAGE OF 1075.950M IS WITH REFERENCE TO THE IR KM OF 187.500KM END OF KM OF CP-303(SECTION P-3 PILKHANI END) AGAINST THE EXISTING DFC CHAINAGE. 116277.742M ISSUED VIDE LETTER NO. COM/DFCC/UMS/SURVEY/2021-301-2301/16-011173 DT. 17.01.2023.
 - BALLAST PROFILE HAS BEEN PROVIDED ACCORDING TO THE CLAUSE 1.11.3 OF STANDARD SCHEDULE OF DIMENSION(EASTERN CORRIDOR) & THE BALLAST CUSHION DIMENSION SHOWN IN 35CM ON GE-14 PARA 17. SPECIFICATIONS & RECOMMENDATIONS 2. TWO LAYER SYSTEM FIG.10.

- REFERENCE DRAWINGS :-
- FOR KEY PLAN REFER DRAWING NO. 301-2/AL/0001
 - FOR LEGEND AND ABBREVIATIONS REFER DRAWING NO. 301-2/AL/1000
 - FOR TYPICAL SECTION OF BALLAST PROFILE (FL-RL) REFER DRG. NO. 301-2/TK/TFD/-004 (TR.1952)

0	17.10.2024	SUBMISSION OF AS-BUILT DRAWING	FOR APPROVAL
REV.	DATE	REVISION DETAILS	PURPOSE OF ISSUE

LEGEND:


SCALE

HOR - 1:1000

VER - 1:100

SHEET SIZE : A1

IR TRACK
DFCC TRACK
DFCC FUTURE PROPOSALS
STRUCTURE / BUILDING
DFCC TOE LINE
DFCC FORMATION
RETAINING WALL
ROAD
STREAM, DRAIN, NALA, CANAL.
FENCE
POWER LINES
TBM
ELECTRIC POLE/OHE MAST
IR RAILWAY BOUNDARY
DFCC BOUNDARY

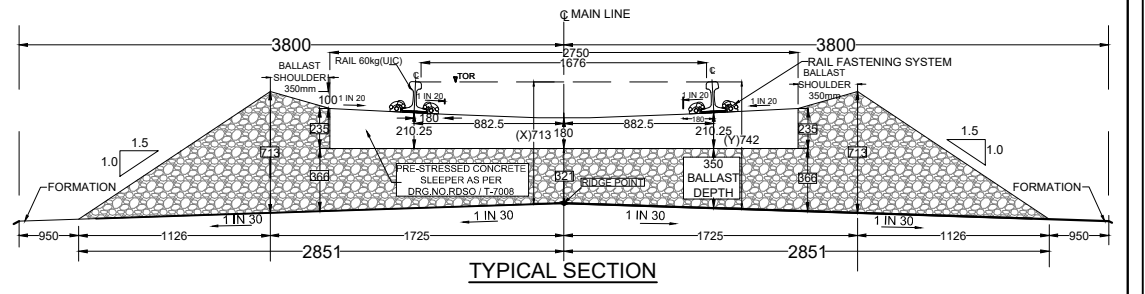

TRACK STRUCTURE		
RAIL SECTION: 60Kg/m (UIC 60Kg/m) DFC LINE: 60Kg/m (UIC 60Kg/m) IR MAIN LINE: 52Kg/m	Difference between FL- RL (Below Rail Seat)	
	IR Line	DFC
RUBBER PAD	172mm	172mm
SLEEPER DEPTH	6mm	10mm
BALLAST CUSHION	210mm	210mm
	300mm	350mm
Total Depth (FL TO RL)	688mm	742mm

OWNER

DEDICATED FREIGHT CORRIDOR CORPORATION OF INDIA LTD.

(A GOVERNMENT OF INDIA ENTERPRISE)

PROJECT OFFICE(AMBALA UNIT): OLD RAILWAY COLONY (NEAR ANAND MARKET),AMBALA CANTT-133001.

CORPORATE IDENTITY NO. : U60232DL2006GGI155068

ENGINEER:

DB Engineering & Consulting GmbH

Deutsche Bahn Engineering & Consulting GmbH

CONTRACTOR:

GIL - TPL JV

GAR TATA

SUBMITTED BY	GIL - TPL JV		
	DATED	NAME	SIGNATURE
PREPARED BY			
CHECKED BY	17.10.2024	VIJAY PRATAP	
APPROVED BY	17.10.2024	PARASURAM KOTYADA	

APPROVED BY	DEUTSCHE BAHN ENGINEERING & CONSULTING GMBH		
	DATED	NAME	SIGNATURE
Sr. DE./CHIEF ENGINEER		SURESH K.YALANGI	
CHIEF TRACK ENGINEER		RAJ PAL SINGH	
T.L.		H.D. VIDJAK	

STAMP

AS-BUILT DRAWING

TR. Ref.:.....

ENGINEER Sign.:.....

EMPLOYER (DFCCIL): DEDICATED FREIGHT CORRIDOR CORPORATION OF INDIA LTD.

AS BUILT DRAWING

TITLE

AS-BUILT PLAN AND PROFILE

FROM IR KM: 351.500 TO 352.000

FROM DFC KM: 1242.377 TO 1242.877

DFCC APPR. NO. -

ENGG. APPR. NO. -

DRG. NO. :301-2/AL/A/1329

SHEET NO. : 1 OF 1

DATE : 17.10.2024

STATUS

A

TR.