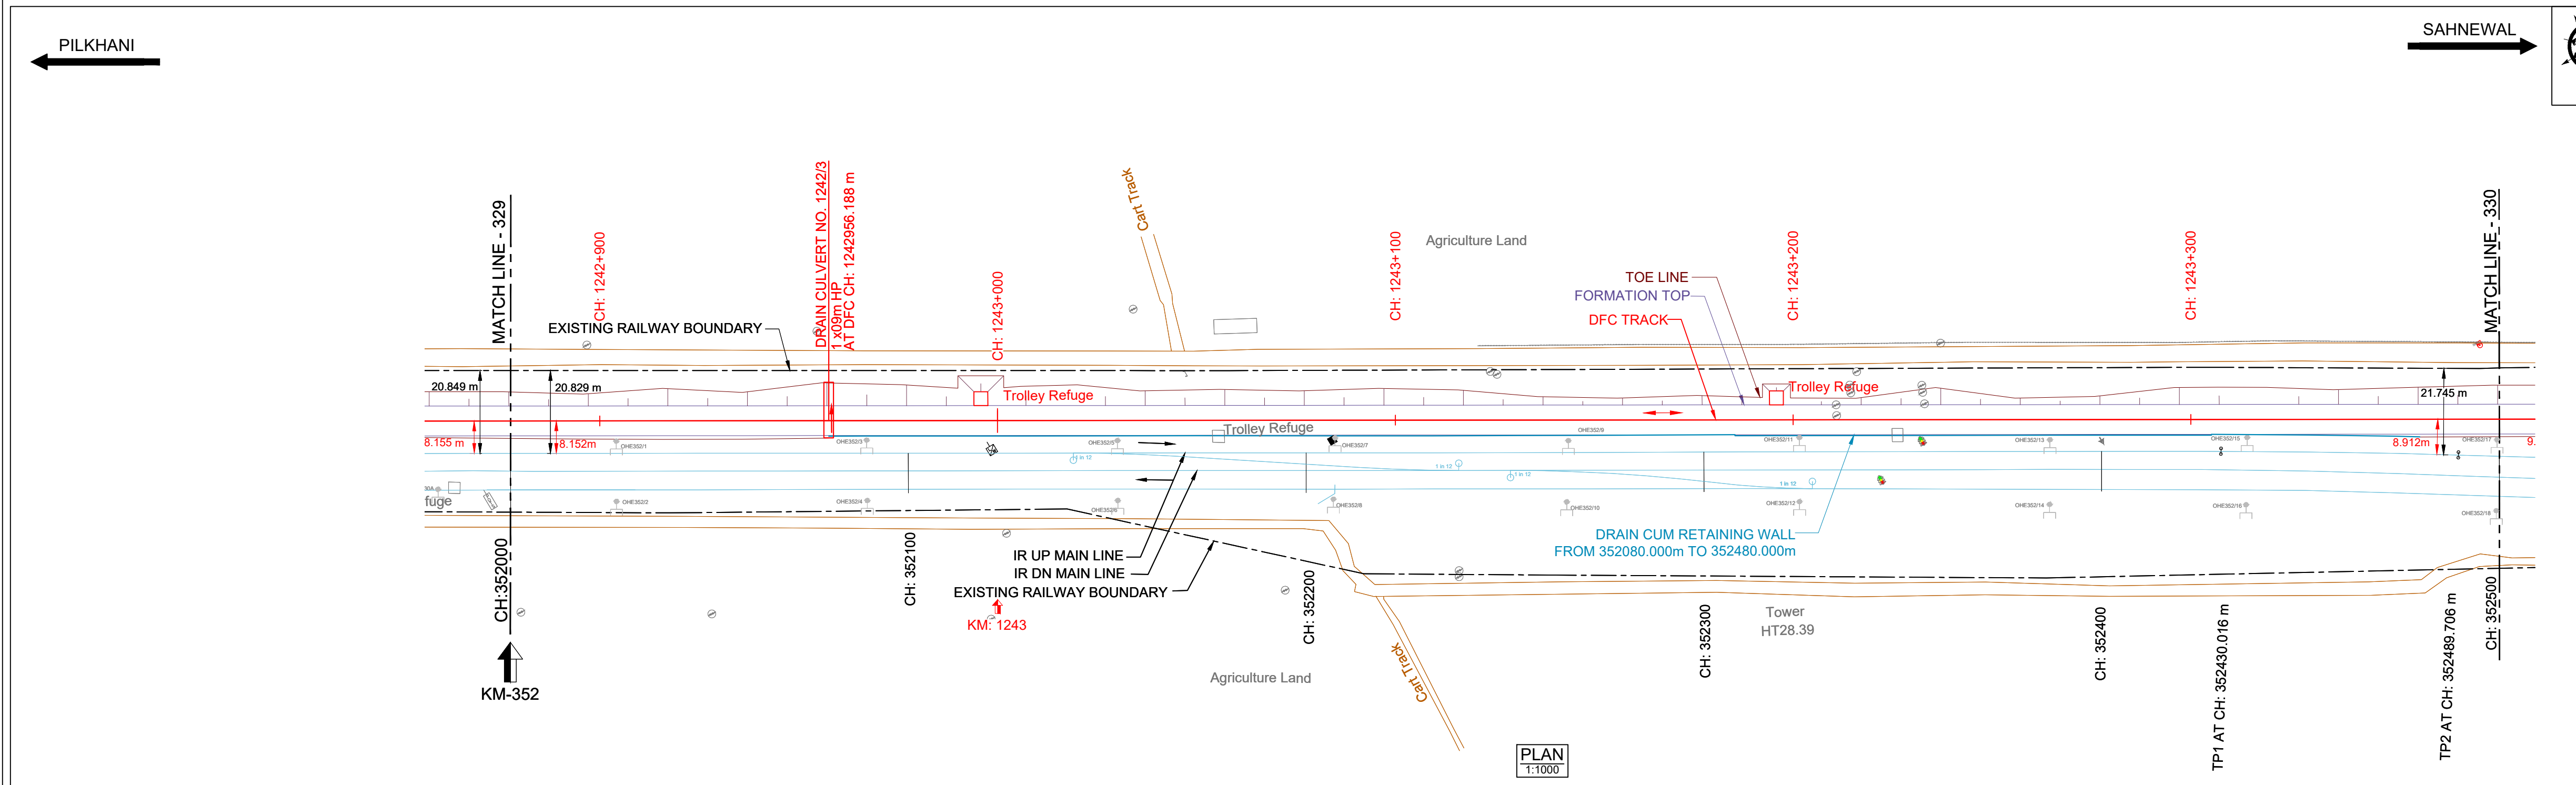


|                                                                          |                                  |--------------------------------------------------------------------------|----------------------------------|-----------|-----------|-----------|-----------|-----------|-----------|-----------|-----------|-----------|-----------|-----------|-----------|-----------|-----------|-----------|-----------|-----------|-----------|-----------|
| HORIZONTAL ALIGNMENT                                                     | L = 4280.337m                    |           |           |           |           |           |           |           |           |           |           |           |           |           |           |           |           |           |           |           |
| VERTICAL ALIGNMENT                                                       | L = 1475.096m<br>1 IN 2090.525 R |           |           |           |           |           |           |           |           |           |           |           |           |           |           |           |           |           |           |           |
| TRACK DISTANCE FROM EXISTING NEAREST IR UP MAIN LINE TO DFC MAIN LINE    | 8.152                            | 8.154     | 8.158     | 8.166     | 8.182     | 8.193     | 8.200     | 8.194     | 8.180     | 8.182     | 8.210     | 8.230     | 8.227     | 8.201     | 8.153     | 8.079     | 8.042     | 8.040     | 8.034     | 8.025     |
| HEIGHT OF BANKING(+) / DEPTH OF CUTTING(-) (PFL-GL)                      | +1.600                           | +1.296    | +1.430    | +1.909    | +1.626    | +1.844    | +2.204    | +1.386    | +0.882    | +0.938    | +1.052    | +1.131    | +1.047    | +1.126    | +1.426    | +1.069    | +0.661    | +0.609    | +0.558    | +1.120    |
| EXG GROUND LEVEL AT CENTER LINE OF DFC TRACK (GL)                        | 257.762                          | 258.075   | 257.951   | 257.481   | 257.774   | 257.566   | 257.215   | 258.043   | 258.556   | 258.510   | 258.405   | 258.336   | 258.430   | 258.360   | 258.070   | 258.436   | 258.854   | 258.915   | 258.976   | 258.423   |
| EXG GROUND LEVEL AT TOE LOCATION OF DFC TRACK                            | 257.555                          | 257.757   | 257.041   | 257.596   | 256.402   | 256.447   | 257.459   | 256.621   | 257.406   | 257.522   | 257.454   | 257.270   | 257.455   | 258.343   | 258.218   | 258.236   | 258.536   | 258.589   | 257.222   | 258.623   |
| DIFFERENCE BETWEEN DFC FORMATION LEVEL AND EXG.FORMATION LEVEL.(PFL-EFL) | 0.253                            | 0.262     | 0.281     | 0.259     | 0.318     | 0.339     | 0.361     | 0.381     | 0.403     | 0.411     | 0.385     | 0.417     | 0.498     | 0.557     | 0.540     | 0.521     | 0.529     | 0.560     | 0.547     | 0.495     |
| DFC FORMATION LEVEL (PFL)                                                | 259.362                          | 259.371   | 259.381   | 259.390   | 259.400   | 259.410   | 259.419   | 259.429   | 259.438   | 259.448   | 259.457   | 259.467   | 259.477   | 259.486   | 259.496   | 259.505   | 259.515   | 259.524   | 259.534   | 259.543   |
| EXG. FORMATION LEVEL OF EXG IR UP MAIN LINE (EFL)                        | 259.109                          | 259.109   | 259.100   | 259.081   | 259.082   | 259.071   | 259.058   | 259.048   | 259.035   | 259.037   | 259.072   | 259.050   | 259.079   | 259.092   | 259.956   | 259.984   | 259.986   | 259.964   | 259.987   | 259.048   |
| DIFFERENCE BETWEEN DFC RAIL LEVEL AND EXG. RAIL LEVEL (PRL - ERL)        | 0.293                            | 0.303     | 0.321     | 0.340     | 0.359     | 0.380     | 0.401     | 0.422     | 0.444     | 0.451     | 0.426     | 0.458     | 0.538     | 0.598     | 0.580     | 0.561     | 0.569     | 0.601     | 0.588     | 0.536     |
| DFC RAIL LEVEL (PRL)                                                     | 260.074                          | 260.084   | 260.093   | 260.103   | 260.113   | 260.122   | 260.132   | 260.141   | 260.151   | 260.160   | 260.170   | 260.180   | 260.189   | 260.199   | 260.208   | 260.218   | 260.227   | 260.237   | 260.247   | 260.256   |
| EXG.RAIL LEVEL OF NEAREST IR UP MAIN LINE(ERL)                           | 259.781                          | 259.781   | 259.772   | 259.763   | 259.754   | 259.743   | 259.730   | 259.720   | 259.707   | 259.709   | 259.744   | 259.722   | 259.651   | 259.601   | 259.628   | 259.656   | 259.658   | 259.638   | 259.659   | 259.720   |
| EQUIVALENT CHAINAGE ON DFC TRACK                                         | 1242976.9                        | 1242986.9 | 1242916.9 | 1242936.9 | 1242956.9 | 1242976.9 | 1242986.9 | 1243016.9 | 1243036.9 | 1243056.9 | 1243076.9 | 1243096.9 | 1243116.9 | 1243136.9 | 1243156.9 | 1243176.9 | 1243196.9 | 1243216.9 | 1243236.9 | 1243256.9 |
| EXISTING IR CHAINAGE                                                     | 352000.0                         | 352020.0  | 352040.0  | 352060.0  | 352080.0  | 352100.0  | 352120.0  | 352140.0  | 352160.0  | 352180.0  | 352200.0  | 352220.0  | 352240.0  | 352260.0  | 352280.0  | 352300.0  | 352320.0  | 352340.0  | 352360.0  | 352380.0  |

L - SECTION

NOTE:-

- DFCC WORKS ARE SHOWN IN RED.
- IR NEW WORKS ARE SHOWN IN VIOLET.
- ALL DIMENSIONS ARE SHOWN IN METRES.
- THIS DRAWING IS PREPARED BASED ON LATEST SURVEY DATA HELD ON APRIL-2022. GTS BENCH MARK OF 261.850M CONSIDERED ON TOP OF CANAL BRIDGE ABUTMENT AT DORANA VILLAGE ALONG THE NH1.
- DFC NEW CHAINAGE OF 1075.950M IS WITH REFERENCE TO THE IR KM OF 187.500KM END OF KM OF CP-303(SECTION P-3 PILKHANI END) AGAINST THE EXISTING DFC CHAINAGE. 116277.742M ISSUED VIDE LETTER NO. COM/DFCC/UMS/SURVEY/2021-301-230116-011173 DT. 17.01.2023.
- BALLAST PROFILE HAS BEEN PROVIDED ACCORDING TO THE CLAUSE 1.11.3 OF STANDARD SCHEDULE OF DIMENSION(EASTERN CORRIDOR) & THE BALLAST CUSHION DIMESION SHOWN IN 35CM ON GE-14 PARA 17. SPECIFICATIONS & RECOMMENDATIONS 2. TWO LAYER SYSTEM FIG.10.

REFERENCE DRAWINGS :-

- FOR KEY PLAN REFER DRAWING NO. 301-2/AL/0001
- FOR LEGEND AND ABBREVIATIONS REFER DRAWING NO. 301-2/AL/1000
- FOR TYPICAL SECTION OF BALLAST PROFILE (FL-RL) REFFER DRG. NO. 301-2/TK/TFDI-004 (TR.1952)

|      |            |                                |                  |
|------|------------|--------------------------------|------------------|
| 0    | 17.10.2024 | SUBMISSION OF AS-BUILT DRAWING | FOR APPROVAL     |
| REV. | DATE       | REVISION DETAILS               | PURPOSE OF ISSUE |

LEGEND:

IR TRACK  
DFCC TRACK  
DFCC FUTURE PROPOSALS  
STRUCTURE / BUILDING  
DFCC TOE LINE  
DFCC FORMATION  
RETAINING WALL  
ROAD  
STREAM, DRAIN, NALA, CANAL.  
FENCE  
POWER LINES  
TBM  
ELECTRIC POLE/OHE MAST  
IR RAILWAY BOUNDARY  
DFCC BOUNDARY

SCALE

HOR - 1:1000  
VER - 1:100  
SHEET SIZE : A1

TYPICAL SECTION

| TRACK STRUCTURE                                                                            |                                             |
|--------------------------------------------------------------------------------------------|---------------------------------------------|
| RAIL SECTION: 60Kg/m (UIC 60Kg/m)<br>DFC LINE: 60Kg/m (UIC 60Kg/m)<br>IR MAIN LINE: 52Kg/m | Difference between FL- RL (Below Rail Seat) |
|                                                                                            | IR Line      DFC                            |
|                                                                                            | 172mm      172mm                            |
| RUBBER PAD                                                                                 | 6mm      10mm                               |
| SLEEPER DEPTH                                                                              | 210mm      210mm                            |
| BALLAST CUSHION                                                                            | 300mm      350mm                            |
| Total Depth (FL TO RL)                                                                     | 688mm      742mm                            |

OWNER

DEDICATED FREIGHT CORRIDOR CORPORATION OF INDIA LTD.  
(A GOVERNMENT OF INDIA ENTERPRISE)  
PROJECT OFFICE(AMBALA UNIT): OLD RAILWAY COLONY (NEAR ANAND MARKET),AMBALA CANTT-133001.  
CORPORATE IDENTITY NO. : U60232DL2006GGI155068

ENGINEER:

DB Engineering & Consulting GmbH  
Deutsche Bahn Engineering & Consulting GmbH

CONTRACTOR:

GIL - TPL JV  
GAR TATA

| SUBMITTED BY           | GIL - TPL JV |                   |           |
|------------------------|--------------|-------------------|-----------|
|                        | DATED        | NAME              | SIGNATURE |
| PREPARED BY            | 17.10.2024   | VIJAY PRATAP      |           |
| CHECKED BY             | 17.10.2024   | PARASURAM KOTYADA |           |
| APPROVED BY            | 17.10.2024   | PARASURAM KOTYADA |           |
|                        | DATED        | NAME              | SIGNATURE |
| Sr. DE./CHIEF ENGINEER |              | SURESH K.YALANGI  |           |
| CHIEF TRACK ENGINEER   |              | RAJ PAL SINGH     |           |
| T.L.                   |              | H.D. VIDJAK       |           |

STAMP

A AS-BUILT DRAWING  
TR. Ref.:.....  
ENGINEER Sign.:.....

EMPLOYER (DFCCIL):

DEDICATED FREIGHT CORRIDOR CORPORATION OF INDIA LTD.

AS BUILT DRAWING

|                                   |                                         |             |
|-----------------------------------|-----------------------------------------|-------------|
| TITLE                             | DFCC APPR. NO. -                        | STATUS<br>A |
| AS-BUILT PLAN AND PROFILE         | ENGG. APPR. NO. -                       |             |
| FROM IR KM: 352.000 TO 352.500    | DRG. NO. -301-2/AL/A/1330               |             |
| FROM DFC KM: 1242.877 to 1243.377 | SHEET NO. : 1 OF 1<br>DATE : 17.10.2024 |             |

TR.