




DEDICATED FREIGHT CORRIDOR CORPORATION OF INDIA LTD.  
(A GOVERNMENT OF INDIA ENTERPRISE)

EASTERN DEDICATED FREIGHT CORRIDOR  
SAHNEWAL TO PILKHANI SECTION  
CONTRACT PACKAGE - 301

PLAN & PROFILE OF AS BUILT DRAWINGS FOR DFC MAIN LINE

IR CHAINAGE FROM 354.000 KM TO 360.200 KM  
DFCC CHAINAGE FROM KM 1244.856 TO KM 1251.031

DESIGN CONSULTANT


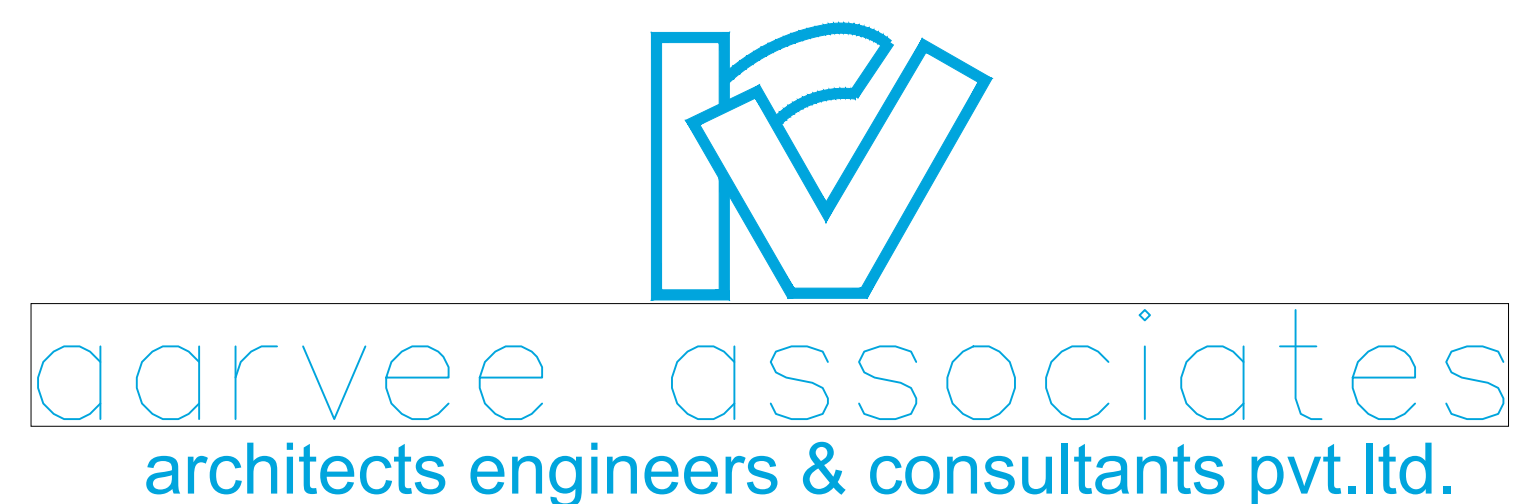


ENGINEER



CONTRACTOR CLIENT  
GIL - TPL JV



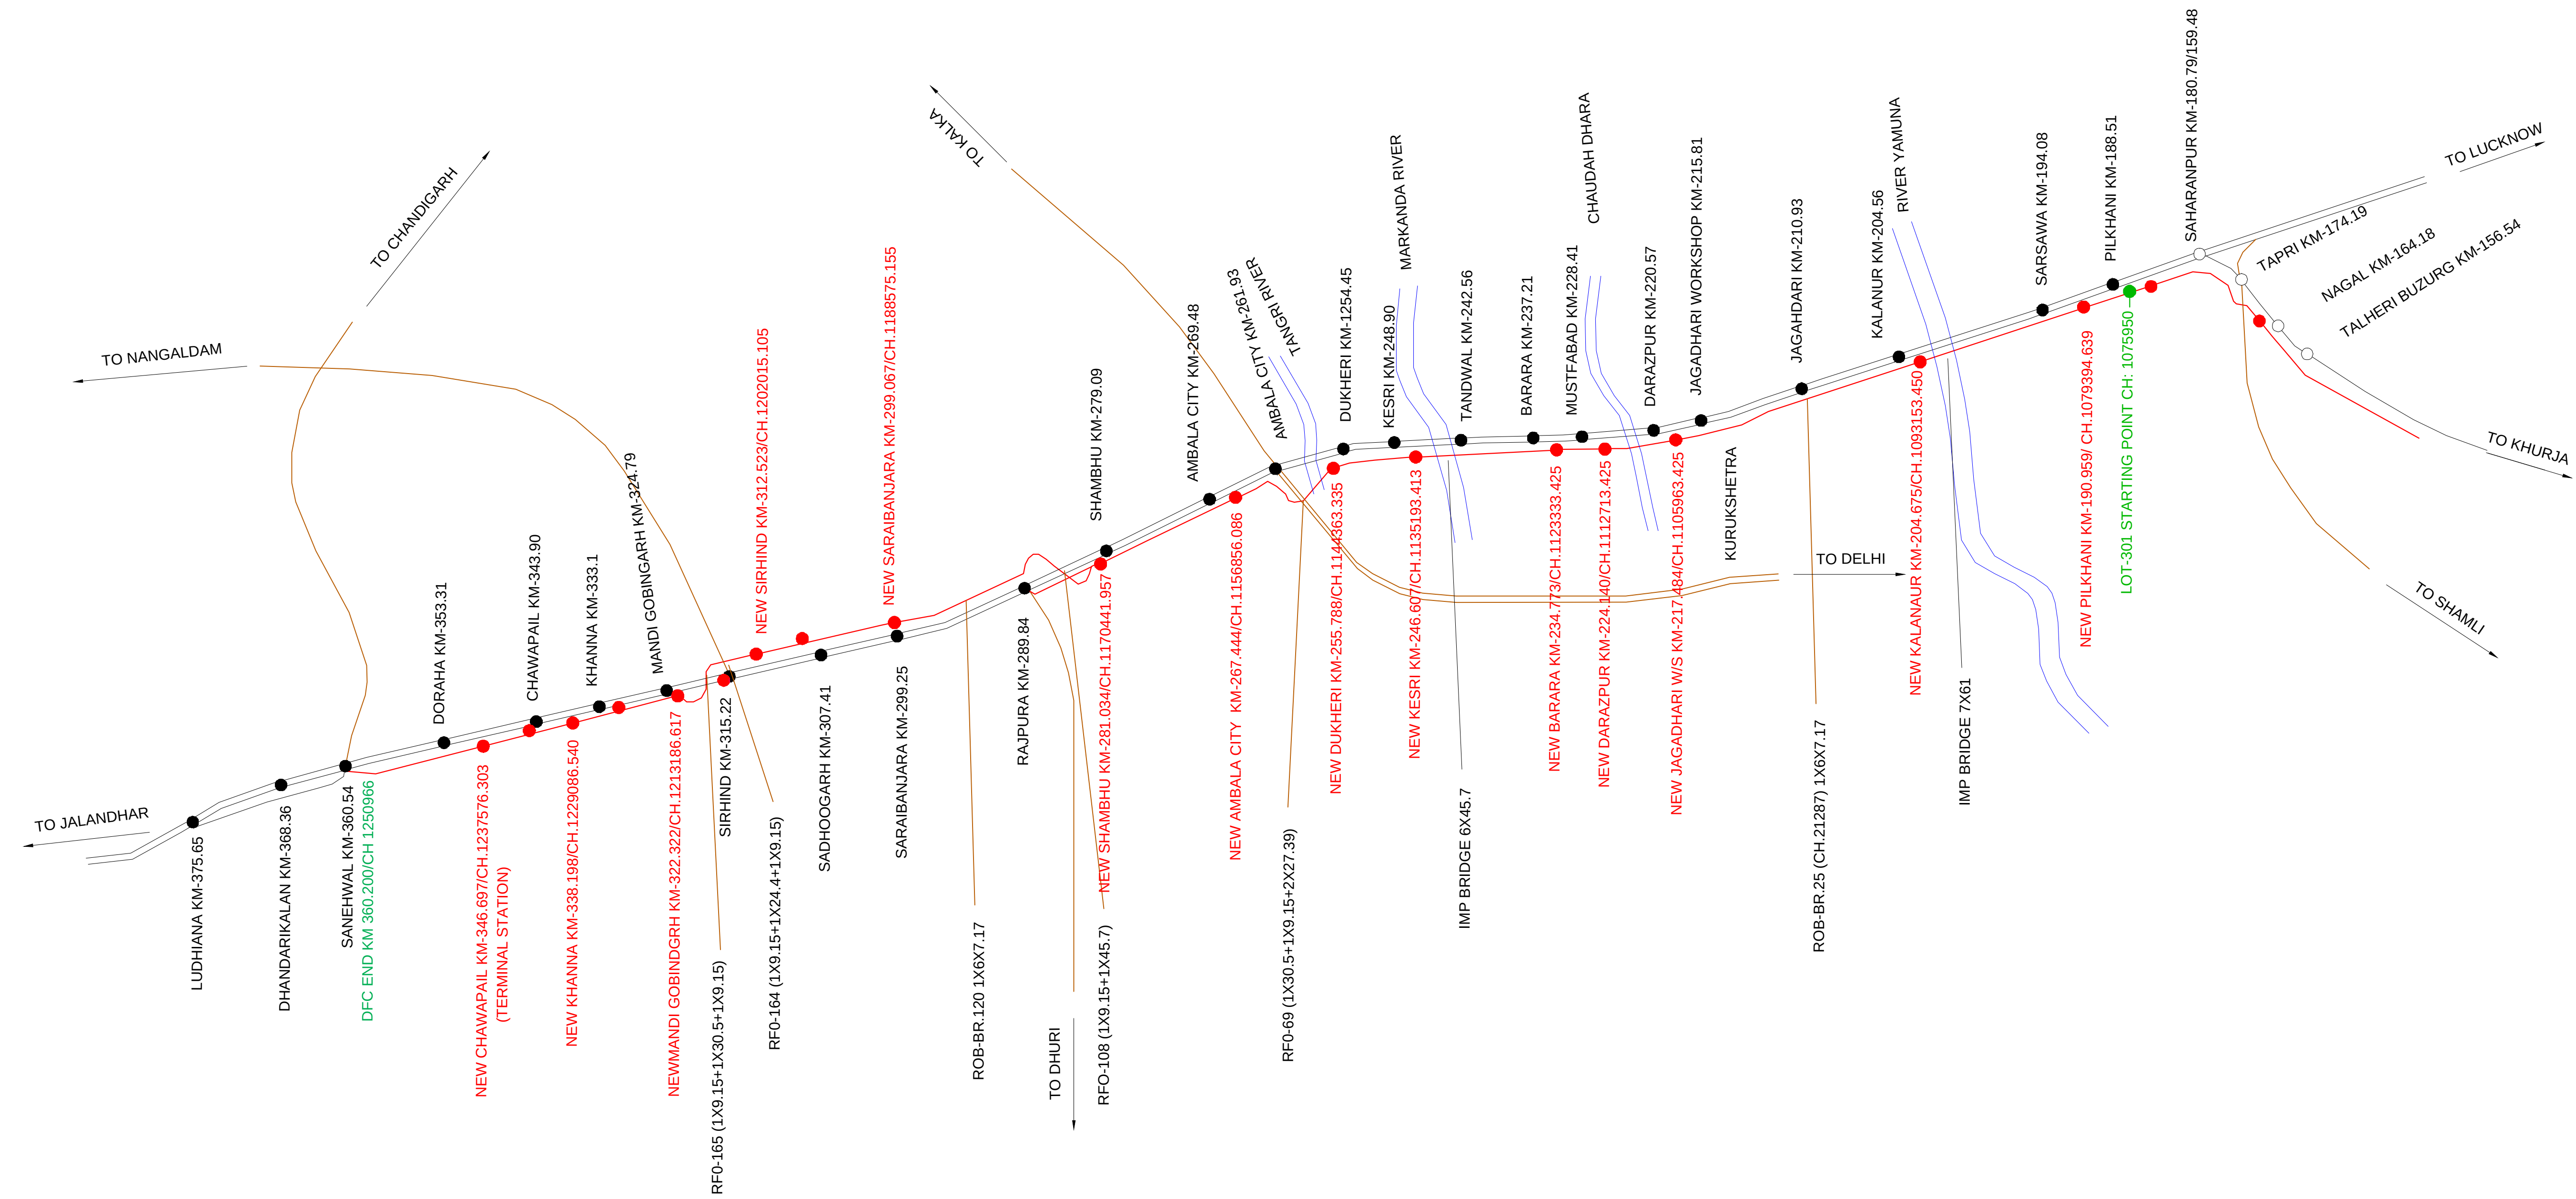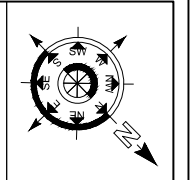



|                          |      |--------------------------|------|------------------|--|-------|--------------|----------------------------------------------------------------------------------------------------------------------------------------------------------------------------------------------------------------------|-------------------------------------------------------------------------------------------------------------------------------------------------------------------------------------------------------------------------------------|----------------------------------------------------------------------------------------------------------------------------------------------------------------------|--------------------------------------------------------------------------------------------------------------------------------------------------------------------------------------------------------------------------------------------------------------------------------------------------------------------------------------------------------------------------|----------------------------------------------------------------------------------------------------------------------|-------------------------------------------------------------|------------------|------------------|------------------|---|---|--|--|--|--|
|                          |      |                  |  | SCALE | NOT TO SCALE | <div>DESIGN CONSULTANT</div> <div></div> <div>aarvee associates</div> <div>architects engineers &amp; consultants Pvt.Ltd.</div> | <div>CONTRACTOR</div> <div></div> <div>GIL - TPL JV</div> | <div>ENGINEER</div> <div></div> <div>DB Engineering &amp; Consulting GmbH</div> | <div>OWNER</div> <div></div> <div>DEDICATED FREIGHT CORRIDOR CORPORATION OF INDIA LTD.<br/>(A GOVERNMENT OF INDIA ENTERPRISE)<br/>PROJECT OFFICE(AMBALA UNIT): OLD RAILWAY COLONY (NEAR ANAND MARKET),AMBALA CANTT-133001.<br/>CORPORATE IDENTITY NO. : U60232DL2006GOI155068</div> | <div>PROJECT</div> <div>EASTERN DEDICATED FREIGHT CORRIDOR<br/>SAHNEWAL TO PILKHANI<br/>CONTRACT PACKAGE - 301</div> | <div>TITLE</div> <div>ALIGNMENT DRAWINGS<br/>KEY PLAN</div> | DFCC APPR. NO. - |                  |                  |   |   |  |  |  |  |
| ENGG. APPR. NO. -        |      |                  | DRG. NO. - 301-2/AL/0001 |      |                  | SHEET NO.: 1 OF 1        |      |                  |  |       |              |                                                                                                                                                                                                                      |                                                                                                                                                                                                                                     |                                                                                                                                                                      |                                                                                                                                                                                                                                                                                                                                                                          |                                                                                                                      |                                                             | REV. No.         | STATUS           |                  |   |   |  |  |  |  |
| REV.                     | DATE | REVISION DETAILS |  |       |              |                                                                                                                                                                                                                      |                                                                                                                                                                                                                                     |                                                                                                                                                                      |                                                                                                                                                                                                                                                                                                                                                                          |                                                                                                                      |                                                             |                  | PURPOSE OF ISSUE | DATE: 15-06-2024 | 0 | A |  |  |  |  |

| LEGEND                      |  |
|-----------------------------|--|
| EXISTING IR TRACK           |  |
| DFC TRACK                   |  |
| DFC FUTURE PROPOSALS        |  |
| IR PROPOSALS                |  |
| TOE LINE                    |  |
| FORMATION CESS              |  |
| RETAINING WALL              |  |
| DRAIN CUM RETAINING WALL    |  |
| ROAD                        |  |
| STREAM, DRAIN, NALA, CANAL. |  |
| FENCE                       |  |
| POWER LINES                 |  |
| GPS POINTS                  |  |
| ELECTRIC POLE/OHE MAST      |  |
| EXISTING RAILWAY BOUNDARY   |  |
| DFC BOUNDARY                |  |
| DISMANTLED WORKS            |  |
| IOCL PIPE LINE              |  |
| IOCL ROW                    |  |
| SIGNALLING CABLE PIPE       |  |

| ABBREVIATIONS |        |                                  |
|---------------|--------|----------------------------------|
| 1.            | BL     | - BED LEVEL                      |
| 2.            | BVC    | - BEGIN OF VERTICAL CURVE        |
| 3.            | Ca     | - APPLIED CANT                   |
| 4.            | CCL    | - CIRCULAR CURVE LENGTH          |
| 5.            | CTP1   | - COMMON TANGENT POINT           |
| 6.            | CTP2   | - COMMON TANGENT POINT           |
| 7.            | DEGREE | - DEGREE OF CURVE                |
| 8.            | DE     | - DEAD END                       |
| 9.            | ECL    | - EXISTING CLEARANCE             |
| 10.           | EFB    | - EXISTING FREE BOARD            |
| 11.           | EFL    | - EXISTING FORMATION LEVEL       |
| 12.           | ERL    | - EXISTING RAIL LEVEL            |
| 13.           | ESL    | - EXISTING SOFFIT LEVEL          |
| 14.           | EVC    | - END OF VERTICAL CURVE          |
| 15.           | EVCL   | - EXISTING VERTICAL CLEARANCE    |
| 16.           | F/CSB  | - FROM CENTER LINE OF STN BLDG   |
| 17.           | FM     | - FOULING MARK                   |
| 18.           | FSL    | - FULL SUPPLY LEVEL              |
| 19.           | HFL    | - HIGH FLOOD LEVEL               |
| 20.           | L      | - STRAIGHT LENGTH                |
| 21.           | LH     | - LEFT HANDED                    |
| 22.           | LHS    | - LIMITED HEIGHT SUBWAY          |
| 23.           | PCL    | - PROPOSED CLEARANCE             |
| 24.           | PFB    | - PROPOSED FREE BOARD            |
| 25.           | PFL    | - PROPOSED FORMATION LEVEL       |
| 26.           | PRL    | - PROPOSED RAIL LEVEL            |
| 27.           | PSL    | - PROPOSED SOFFIT LEVEL          |
| 28.           | PVCL   | - PROPOSED VERTICAL CLEARANCE    |
| 29.           | PVI    | - POINT OF VERTICAL INTERSECTION |
| 30.           | R      | - RADIUS                         |
| 31.           | REV.BL | - REVISED BED LEVEL              |
| 32.           | RH     | - RIGHT HANDED                   |
| 33.           | Rr     | - RESULTANT RADIUS               |
| 34.           | SE     | - SUPER ELEVATION                |
| 35.           | SRJ    | - STOCK RAIL JOINT               |
| 36.           | TS     | - TRAP SWITCH                    |
| 37.           | TTL    | - TOTAL TANGENT LENGTH           |
| 38.           | TTP1   | - TRANSITION TANGENT POINT       |
| 39.           | TTP2   | - TRANSITION TANGENT POINT       |
| 40.           | TL     | - TRANSITION LENGTH              |
| 41.           | DELTA  | - DEFLECTION ANGLE               |

|      |      |  |                  |                  |              |                                                                                                                                                          |                                                                                                                                                                                             |                                                                                                                           |                                                                                                                   |                                                                                                                                                                                                                                          |                                                                                      |                                                |                  |   |                          |
|------|------|--|------------------|------------------|--------------|----------------------------------------------------------------------------------------------------------------------------------------------------------|---------------------------------------------------------------------------------------------------------------------------------------------------------------------------------------------|---------------------------------------------------------------------------------------------------------------------------|-------------------------------------------------------------------------------------------------------------------|------------------------------------------------------------------------------------------------------------------------------------------------------------------------------------------------------------------------------------------|--------------------------------------------------------------------------------------|------------------------------------------------|------------------|---|--------------------------|
|      |      |  |                  |                  | SCALE        | DESIGN CONSULTANT                                                                                                                                        | CONTRACTOR                                                                                                                                                                                  | ENGINEER                                                                                                                  | OWNER                                                                                                             | PROJECT                                                                                                                                                                                                                                  | TITLE                                                                                | DFCC APPR. NO. -                               |                  |   |                          |
|      |      |  |                  |                  | NOT TO SCALE | <br>aarvee associates<br>architects engineers & consultants pvt.ltd. |  <br>GIL - TPL JV | <br>DB Engineering & Consulting GmbH | <br>मेडीकेटर फ्रेट कॉर्पोरेश | DEDICATED FREIGHT CORRIDOR CORPORATION OF INDIA LTD.<br>(A GOVERNMENT OF INDIA ENTERPRISE)<br>PROJECT OFFICE(AMBALA UNIT): OLD RAILWAY COLONY (NEAR ANAND MARKET),AMBALA CANTT-133001.<br>CORPORATE IDENTITY NO. : U60232DL2006GOI155068 | EASTERN DEDICATED FREIGHT CORRIDOR<br>SAHNEWAL TO PILKHANI<br>CONTRACT PACKAGE - 301 | ALIGNMENT DRAWINGS<br>LEGEND AND ABBREVIATIONS | ENG. APPR. NO. - |   |                          |
|      |      |  |                  |                  |              |                                                                                                                                                          |                                                                                                                                                                                             |                                                                                                                           |                                                                                                                   |                                                                                                                                                                                                                                          |                                                                                      |                                                |                  |   | DRG. NO. - 301-2/AL/1000 |
|      |      |  |                  |                  |              |                                                                                                                                                          |                                                                                                                                                                                             |                                                                                                                           |                                                                                                                   |                                                                                                                                                                                                                                          |                                                                                      |                                                |                  |   | SHEET NO. : 1 OF 1       |
| REV. | DATE |  | REVISION DETAILS | PURPOSE OF ISSUE |              |                                                                                                                                                          |                                                                                                                                                                                             |                                                                                                                           |                                                                                                                   |                                                                                                                                                                                                                                          |                                                                                      | DATE : 15-06-2024                              | 0                | A |                          |



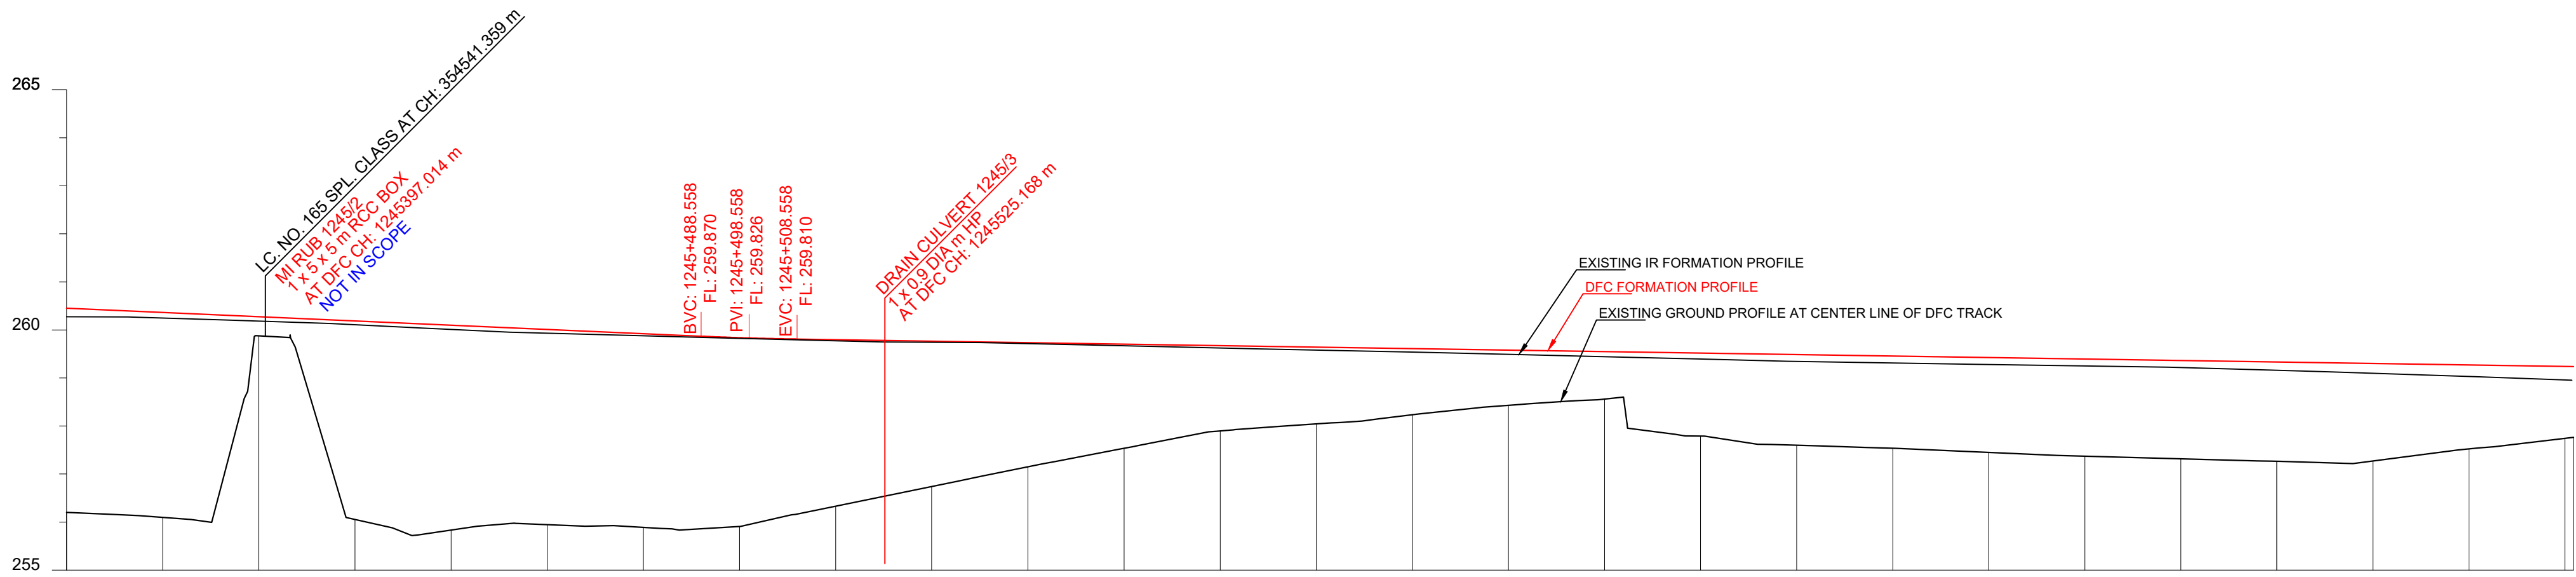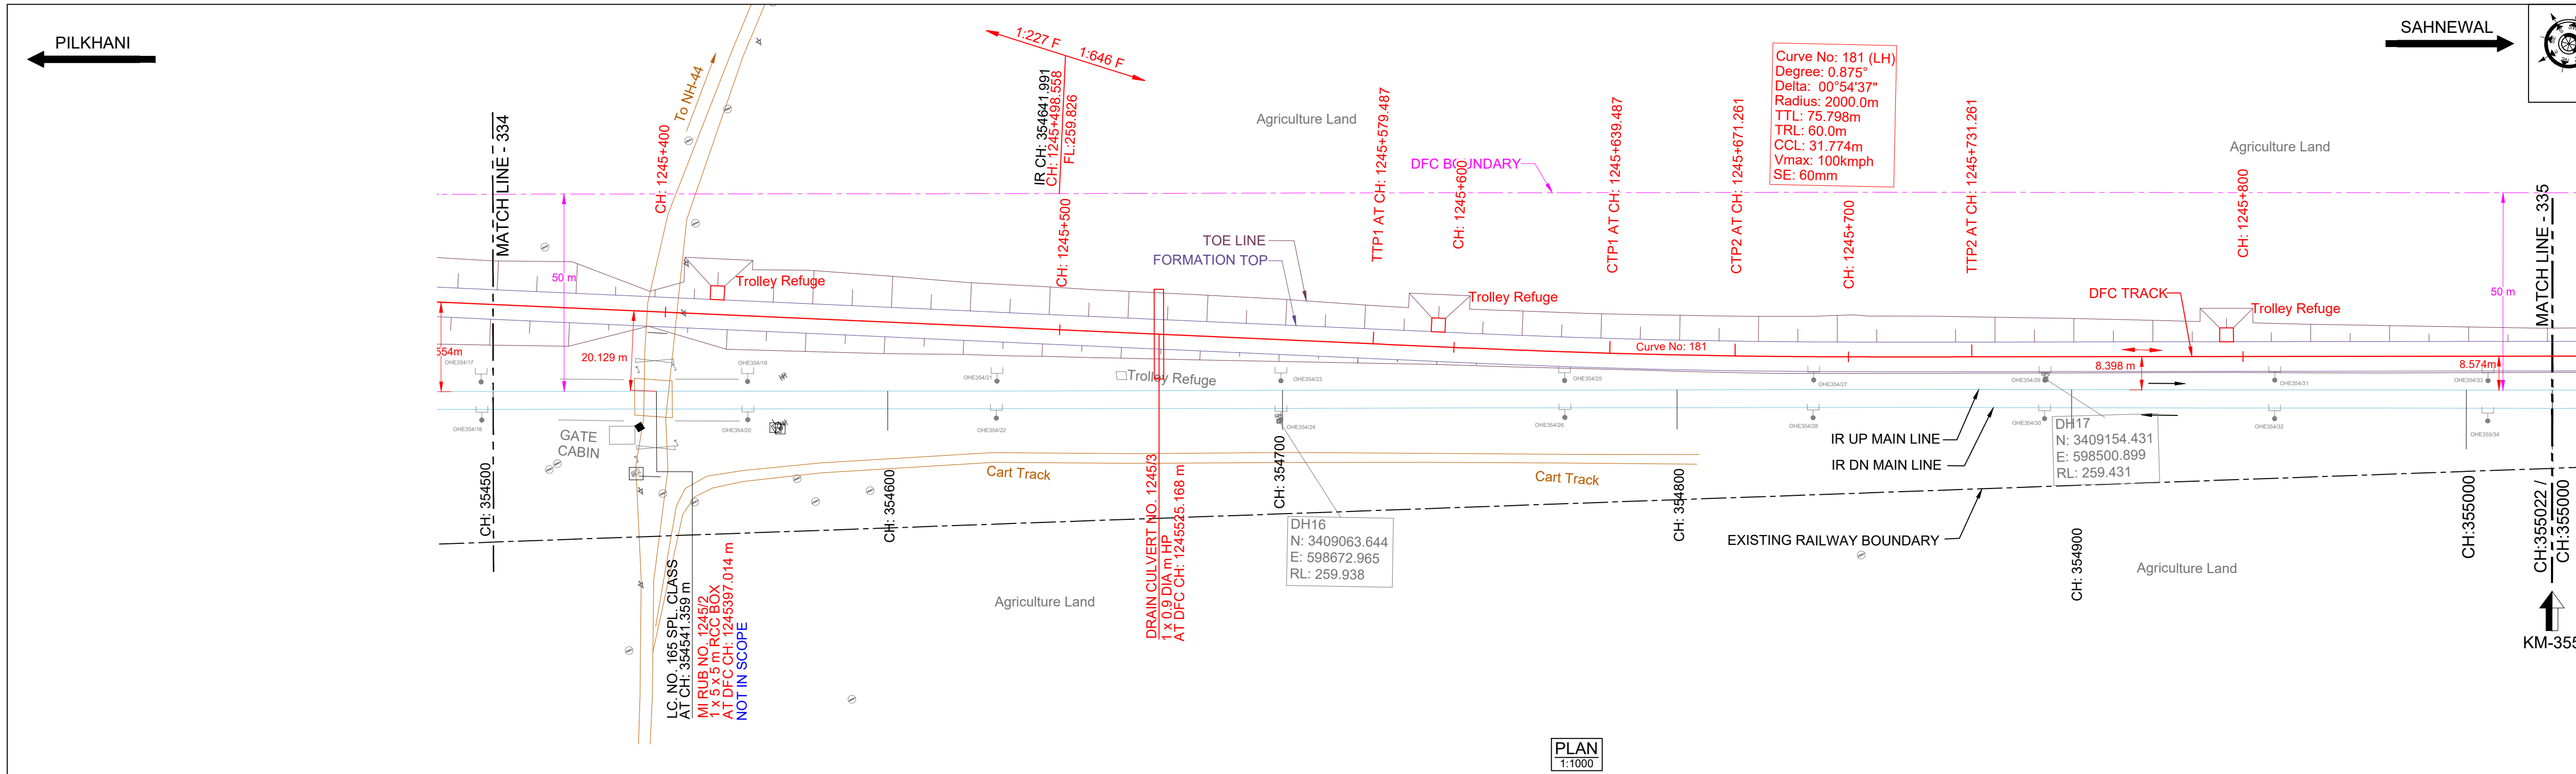

| HORIZONTAL ALIGNMENT                                                        | <div><div>L = 289.490m</div><div>TL = 60m</div><div>R = -2000m</div><div>TL = 60m</div><div>L = 5018.785m</div></div>              |  |            |-----------------------------------------------------------------------------|------------------------------------------------------------------------------------------------------------------------------------|--|------------|------------|------------|------------|------------|------------|------------|------------|------------|------------|------------|------------|------------|------------|------------|------------|------------|------------|------------|------------|------------|------------|------------|------------|------------|
| VERTICAL ALIGNMENT                                                          | <div><div>L=427.680 m<br/>1 IN 227.307 F</div><div>R=20.0 m<br/>1 IN 7014.0 m</div><div>L=1479.855m<br/>1 IN 646.028 F</div></div> |  |            | TRACK DISTANCE FROM EXISTING NEAREST IR UP MAIN LINE TO DFC MAIN LINE       | 22.065                                                                                                                             |  | 21.137     | 20.214     | 19.291     | 18.374     | 17.460     | 16.555     | 15.642     | 14.716     | 13.770     | 12.819     | 11.892     | 10.970     | 10.121     | 9.407      | 8.846      | 8.484      | 8.309      | 8.360      | 8.411      | 8.460      | 8.486      | 8.518      | 8.558      | 8.598      | 8.601      |
| HEIGHT OF BANKING(+)/<br>DEPTH OF CUTTING(-) (PFL-GL)                       | +4.251                                                                                                                             |  | +4.264     | +0.396     | +4.134     | +4.265     | +4.064     | +4.031     | +3.930     | +3.467     | +3.027     | +2.585     | +2.168     | +1.778     | +1.599     | +1.377     | +1.148     | +0.987     | +1.321     | +1.376     | +2.022     | +2.047     | +2.068     | +2.030     | +1.748     | +1.497     | +1.474     |
| EXG GROUND LEVEL AT CENTER LINE OF<br>DFC TRACK (GL)                        | -256.200                                                                                                                           |  | -256.099   | -259.879   | -256.053   | -255.834   | -255.947   | -255.891   | -255.909   | -256.331   | -256.740   | -257.151   | -257.537   | -257.896   | -258.044   | -258.235   | -258.433   | -258.563   | -257.536   | -257.450   | -257.373   | -257.317   | -257.265   | -257.272   | -257.443   | -257.743   | -257.764   |
| EXG GROUND LEVEL AT TOE<br>LOCATION OF DFC TRACK                            | -256.692                                                                                                                           |  | -256.257   | -259.496   | -256.153   | -255.766   | -255.942   | -255.891   | -255.909   | -256.316   | -256.740   | -257.151   | -257.537   | -257.896   | -258.044   | -258.235   | -258.433   | -258.563   | -256.214   | -257.450   | -257.373   | -257.317   | -257.265   | -257.272   | -257.443   | -257.743   | -257.764   |
| DIFFERENCE BETWEEN DFC FORMATION<br>LEVEL AND EXG.FORMATION LEVEL (PFL-EFL) | 0.177                                                                                                                              |  | 0.116      | 0.092      | 0.077      | 0.087      | 0.080      | 0.046      | 0.010      | 0.024      | 0.024      | 0.020      | 0.033      | 0.049      | 0.061      | 0.074      | 0.090      | 0.106      | 0.145      | 0.145      | 0.145      | 0.147      | 0.171      | 0.203      | 0.240      | 0.279      | 0.284      |
| DFC FORMATION LEVEL (PFL)                                                   | -260.451                                                                                                                           |  | -260.363   | -260.275   | -260.187   | -260.099   | -260.011   | -259.922   | -259.839   | -259.798   | -259.767   | -259.736   | -259.705   | -259.674   | -259.643   | -259.612   | -259.581   | -259.550   | -259.519   | -259.426   | -259.395   | -259.333   | -259.271   | -259.209   | -259.147   | -259.085   | -259.023   |
| EXG. FORMATION LEVEL OF<br>EXG IR UP MAIN LINE (EFL)                        | -260.274                                                                                                                           |  | -260.247   | -260.183   | -260.110   | -260.012   | -259.931   | -259.876   | -259.824   | -259.774   | -259.743   | -259.716   | -259.672   | -259.625   | -259.582   | -259.538   | -259.491   | -259.444   | -259.393   | -259.281   | -259.250   | -259.162   | -259.031   | -258.954   | -258.823   | -258.692   | -258.561   |
| DIFFERENCE BETWEEN<br>DFC RAIL LEVEL AND EXG. RAIL LEVEL<br>(PRL - ERL)     | 0.221                                                                                                                              |  | 0.161      | 0.136      | 0.121      | 0.131      | 0.124      | 0.090      | 0.055      | 0.067      | 0.067      | 0.063      | 0.076      | 0.091      | 0.103      | 0.117      | 0.133      | 0.149      | 0.168      | 0.187      | 0.187      | 0.246      | 0.283      | 0.320      | 0.357      | 0.394      | 0.332      |
| DFC RAIL LEVEL (PRL)                                                        | -261.167                                                                                                                           |  | -261.079   | -260.991   | -260.903   | -260.815   | -260.727   | -260.639   | -260.551   | -260.512   | -260.481   | -260.450   | -260.419   | -260.388   | -260.357   | -260.326   | -260.295   | -260.264   | -260.233   | -260.141   | -260.11    | -260.017   | -259.986   | -259.906   | -259.826   | -259.746   | -259.666   |
| EXG.RAIL LEVEL OF NEAREST IR UP MAIN LINE(ERL)                              | -260.946                                                                                                                           |  | -260.919   | -260.855   | -260.782   | -260.684   | -260.603   | -260.548   | -260.496   | -260.446   | -260.415   | -260.388   | -260.344   | -260.297   | -260.254   | -260.210   | -260.163   | -260.116   | -260.065   | -259.953   | -259.922   | -259.834   | -259.771   | -259.703   | -259.623   | -259.543   | -259.463   |
| EQUIVALENT CHAINAGE ON<br>DFC TRACK                                         | -1245355.6                                                                                                                         |  | -1245375.6 | -1245395.7 | -1245415.7 | -1245435.7 | -1245455.7 | -1245475.8 | -1245495.8 | -1245515.8 | -1245535.8 | -1245555.8 | -1245575.9 | -1245595.9 | -1245615.9 | -1245635.9 | -1245655.9 | -1245675.9 | -1245695.9 | -1245715.9 | -1245735.9 | -1245755.9 | -1245775.9 | -1245795.9 | -1245815.9 | -1245835.9 | -1245855.9 |
| EXISTING IR CHAINAGE                                                        | 354500.0                                                                                                                           |  | 354520.0   | 354540.0   | 354560.0   | 354580.0   | 354600.0   | 354620.0   | 354640.0   | 354660.0   | 354680.0   | 354700.0   | 354720.0   | 354740.0   | 354760.0   | 354780.0   | 354800.0   | 354820.0   | 354840.0   | 354860.0   | 354880.0   | 354900.0   | 354920.0   | 354940.0   | 354960.0   | 354980.0   | 355000.0   |

L - SECTION

NOTE:-  
1. DFC WORKS ARE SHOWN IN RED.  
2. IR NEW WORKS ARE SHOWN IN VIOLET.  
3. ALL DIMENSIONS ARE SHOWN IN METRES.  
4. THIS DRAWING IS PREPARED BASED ON LATEST SURVEY DATA HELD ON APRIL-2022. GTS BENCH MARK OF 261.850M CONSIDERED ON TOP OF CANAL BRIDGE ABUTMENT AT DORAH VILLAGE ALONG THE NH1.  
5. DFC NEW CHAINAGE OF 1075.950M IS WITH REFERENCE TO THE IR KM OF 187.500KM END OF KM OF CP-303(SECTION P-3 PILKHANI END) AGAINST THE EXISTING DFC CHAINAGE. 116277.742M ISSUED VIDE LETTER NO. COM/DFCC/MB/SURVEY/2021-301-230116-011173 DT. 17.01.2023.  
6. BALLAST PROFILE HAS BEEN PROVIDED ACCORDING TO THE CLAUSE 1.11.3 OF STANDARD SCHEDULE OF DIMENSION(EASTERN CORRIDOR) & THE BALLAST CUSHION DIMENSION SHOWN IN 35CM ON GE-14 PARA 17. SPECIFICATIONS & RECOMMENDATIONS 2. TWO LAYER SYSTEM FIG.10.

DRG NO. - 301-2/AL/A/1335


REFERENCE DRAWINGS :-  
1. FOR KEY PLAN REFER DRAWING NO. 301-2/AL/0001  
2. FOR LEGEND AND ABBREVIATIONS REFER DRAWING NO. 301-2/AL/1000  
3. FOR TYPICAL SECTION OF BALLAST PROFILE (FL-RL) REFER DRG. NO. 301-2/TK/TFD/-004 (TR.1952)

|      |            |                                |                  |
|------|------------|--------------------------------|------------------|
| 0    | 21.10.2024 | SUBMISSION OF AS-BUILT DRAWING | FOR APPROVAL     |
| REV. | DATE       | REVISION DETAILS               | PURPOSE OF ISSUE |

LEGEND:

SCALE  
HOR - 1:1000  
VER - 1:100  
SHEET SIZE : A1

IR TRACK  
DFCC TRACK  
DFCC FUTURE PROPOSALS  
STRUCTURE / BUILDING  
DFCC TOE LINE  
DFCC FORMATION  
RETAINING WALL  
ROAD  
STREAM, DRAIN, NALA, CANAL.  
FENCE  
POWER LINES  
TBM  
ELECTRIC POLE/OHE MAST  
IR RAILWAY BOUNDARY  
DFCC BOUNDARY

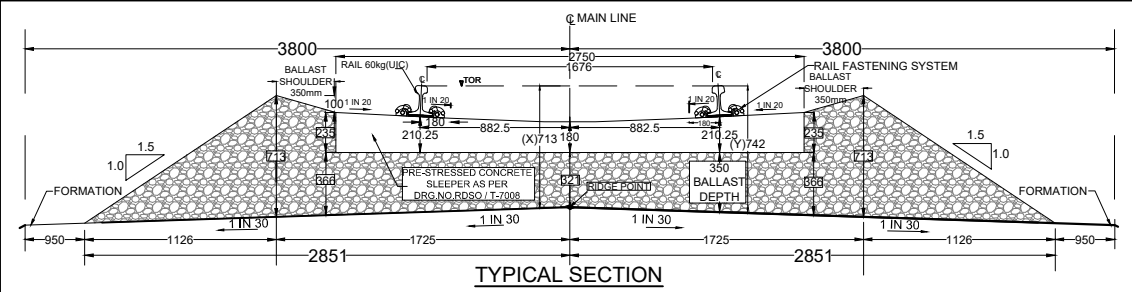

| TRACK STRUCTURE                                                                            |                                             |       |
|--------------------------------------------------------------------------------------------|---------------------------------------------|-------|
| RAIL SECTION: 60Kg/m (UIC 60Kg/m)<br>DFC LINE: 60Kg/m (UIC 60Kg/m)<br>IR MAIN LINE: 52Kg/m | Difference between FL- RL (Below Rail Seat) |       |
|                                                                                            | IR Line                                     | DFC   |
| RUBBER PAD                                                                                 | 172mm                                       | 172mm |
| SLEEPER DEPTH                                                                              | 210mm                                       | 210mm |
| BALLAST CUSHION                                                                            | 300mm                                       | 350mm |
| Total Depth (FL TO RL)                                                                     | 688mm                                       | 742mm |

OWNER  
DEDICATED FREIGHT CORRIDOR CORPORATION OF INDIA LTD.  
(A GOVERNMENT OF INDIA ENTERPRISE)  
PROJECT OFFICE(AMBALA UNIT): OLD RAILWAY COLONY (NEAR ANAND MARKET),AMBALA CANTT-133001.  
CORPORATE IDENTITY NO. : U60232DL2006GG01155068

ENGINEER:  
DB Engineering & Consulting GmbH  
Deutsche Bahn Engineering & Consulting GmbH



CONTRACTOR:  
GIL - TPL JV  
GAR TATA

| SUBMITTED BY | GIL - TPL JV |                   |           |
|--------------|--------------|-------------------|-----------|
|              | DATED        | NAME              | SIGNATURE |
| PREPARED BY  | 21.10.2024   | VIJAY PRATAP      |           |
| CHECKED BY   | 21.10.2024   | PARASURAM KOTYADA |           |
| APPROVED BY  | 21.10.2024   | PARASURAM KOTYADA |           |

| APPROVED BY            | DEUTSCHE BAHN ENGINEERING & CONSULTING GMBH |                  |           |
|------------------------|---------------------------------------------|------------------|-----------|
|                        | DATED                                       | NAME             | SIGNATURE |
| Sr. DE./CHIEF ENGINEER |                                             | SURESH K.YALANGI |           |
| CHIEF TRACK ENGINEER   |                                             | RAJ PAL SINGH    |           |
| T.L.                   |                                             | H.D. VIDJAK      |           |

|                    |                                                        |  |  |
|--------------------|--------------------------------------------------------|--|--|
| STAMP              | A AS-BUILT DRAWING TR. Ref.:..... ENGINEER Sign.:..... |  |  |
| EMPLOYER (DFCCIL): | DEDICATED FREIGHT CORRIDOR CORPORATION OF INDIA LTD.   |  |  |
|                    |                                                        |  |  |
|                    |                                                        |  |  |

| AS BUILT DRAWING |                                   |                            |        |
|------------------|-----------------------------------|----------------------------|--------|
| TITLE            | AS-BUILT PLAN AND PROFILE         | DFCC APPR. NO. -           |        |
|                  | FROM IR KM: 354.500 TO 355.000    | ENG. APPR. NO. -           |        |
|                  | FROM DFC KM: 1245.356 TO 1245.878 | DRG. NO. - 301-2/AL/A/1335 |        |
|                  |                                   | SHEET NO. : 1 OF 1         | STATUS |
|                  |                                   | DATE : 21.10.2024          | A      |

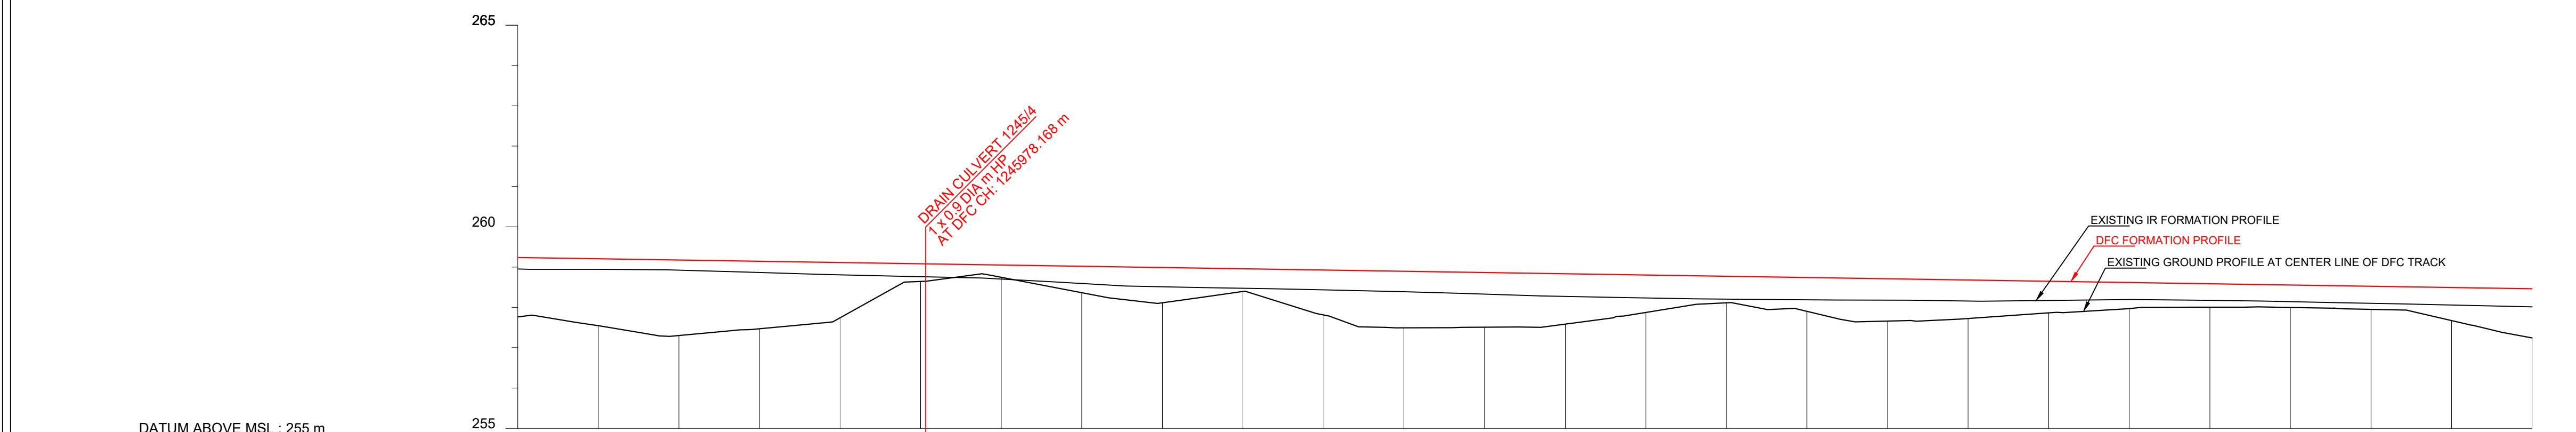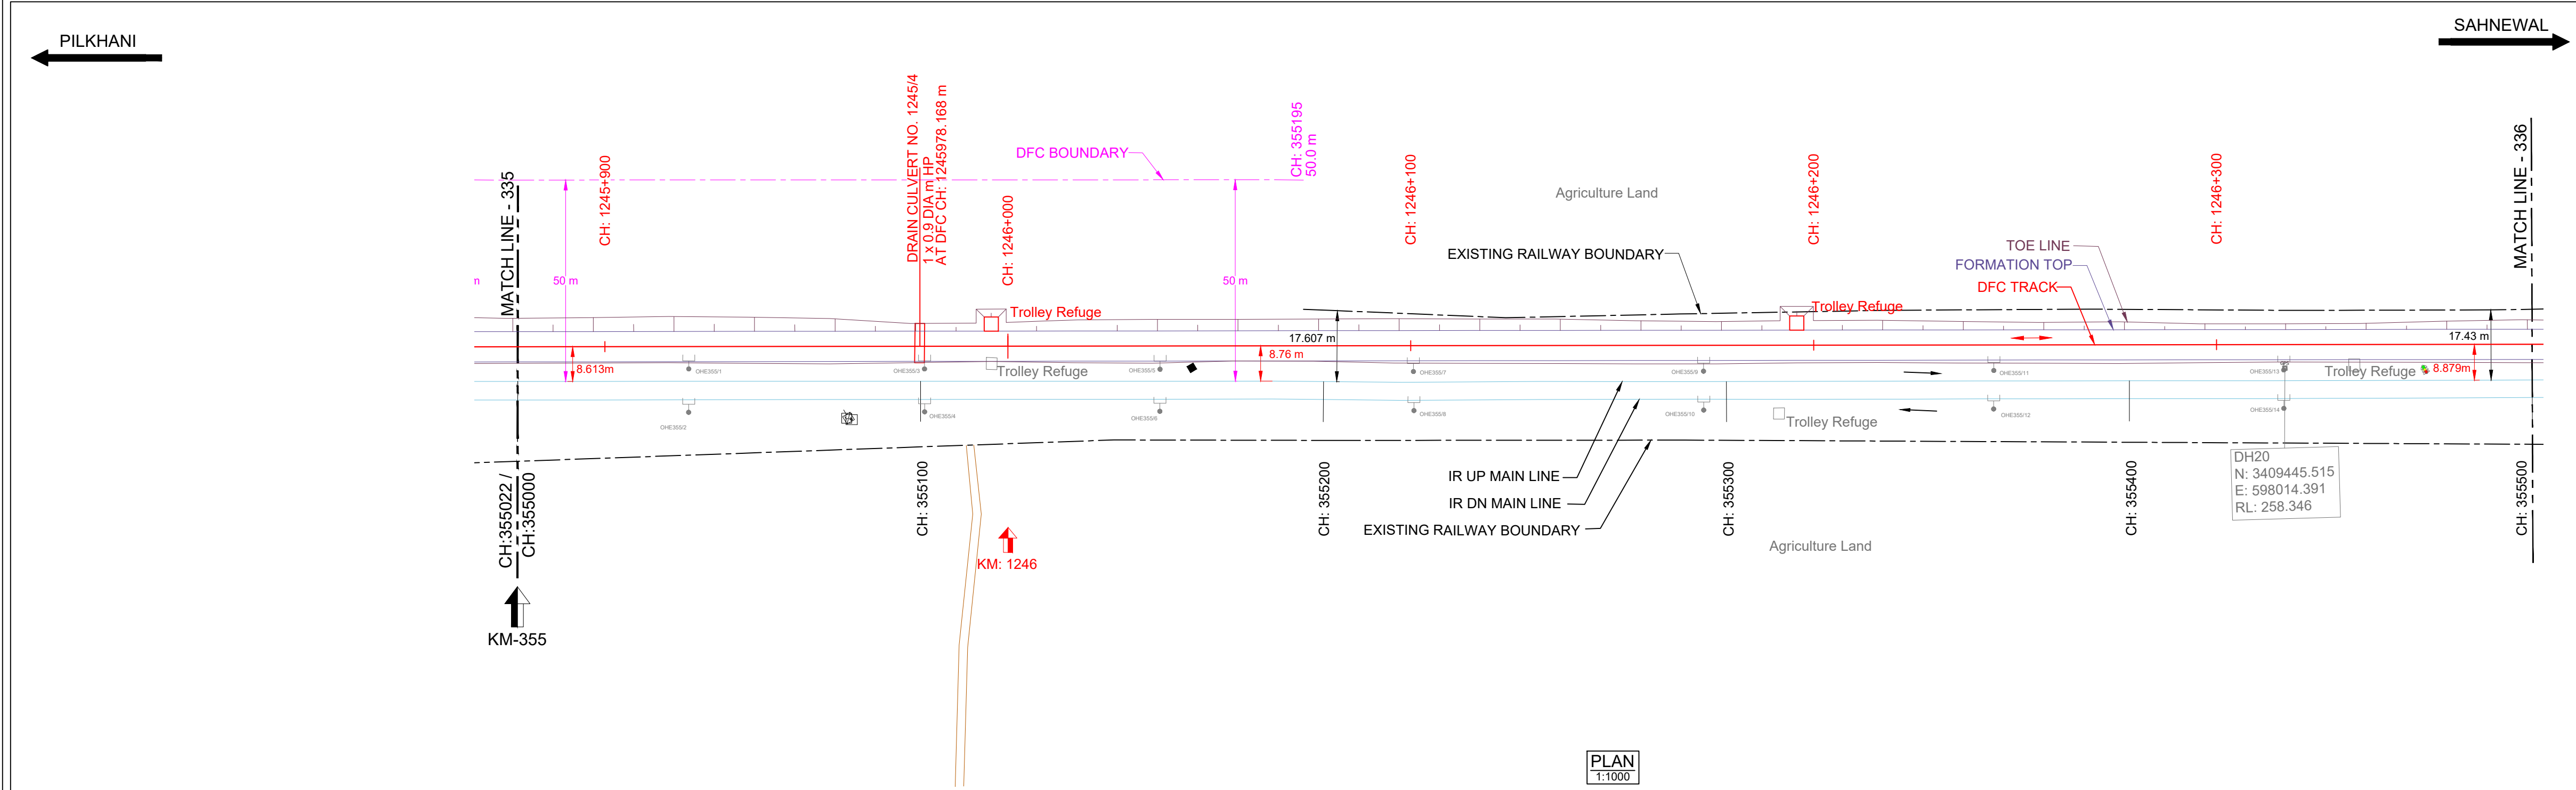

|                                                                          |                                 |--------------------------------------------------------------------------|---------------------------------|------------|------------|------------|------------|------------|------------|------------|------------|------------|------------|------------|------------|------------|------------|------------|------------|------------|------------|------------|
| HORIZONTAL ALIGNMENT                                                     | L = 5018.785m                   |            |            |            |            |            |            |            |            |            |            |            |            |            |            |            |            |            |            |            |
| VERTICAL ALIGNMENT                                                       | L = 1479.859m<br>1 IN 646.026 F |            |            |            |            |            |            |            |            |            |            |            |            |            |            |            |            |            |            |            |
| TRACK DISTANCE FROM EXISTING NEAREST IR UP MAIN LINE TO DFC MAIN LINE    | 8.601                           | 8.618      | 8.632      | 8.645      | 8.657      | 8.694      | 8.726      | 8.739      | 8.744      | 8.755      | 8.883      | 9.071      | 8.990      | 8.931      | 8.991      | 9.001      | 8.974      | 8.950      | 8.928      | 8.933      |
| HEIGHT OF BANKING(+) / DEPTH OF CUTTING(-) (PFL-GL)                      | +1.474                          | +1.659     | +1.873     | +1.676     | +1.373     | +0.441     | +0.305     | +0.655     | +0.876     | +0.564     | +1.117     | +1.405     | +1.357     | +1.249     | +0.930     | +0.659     | +0.841     | +1.050     | +0.958     | +0.783     |
| EXG GROUND LEVEL AT CENTER LINE OF DFC TRACK (GL)                        | 257.764                         | 257.548    | 257.303    | 257.469    | 257.741    | 258.642    | 258.747    | 258.366    | 258.114    | 258.395    | 257.811    | 257.492    | 257.509    | 257.586    | 257.874    | 258.114    | 257.902    | 257.662    | 257.723    | 257.867    |
| EXG GROUND LEVEL AT TOE LOCATION OF DFC TRACK                            | 257.487                         | 257.383    | 257.212    | 257.286    | 257.457    | 258.034    | 257.915    | 257.519    | 257.486    | 257.417    | 257.390    | 257.294    | 257.344    | 257.376    | 257.471    | 257.629    | 257.417    | 257.424    | 257.535    | 257.600    |
| DIFFERENCE BETWEEN DFC FORMATION LEVEL AND EXG.FORMATION LEVEL (PFL-EFL) | 0.284                           | 0.264      | 0.250      | 0.278      | 0.308      | 0.321      | 0.349      | 0.429      | 0.478      | 0.485      | 0.494      | 0.506      | 0.537      | 0.563      | 0.570      | 0.567      | 0.554      | 0.533      | 0.524      | 0.477      |
| DFC FORMATION LEVEL (PFL)                                                | 259.238                         | 259.207    | 259.176    | 259.145    | 259.114    | 259.083    | 259.052    | 259.021    | 258.990    | 258.959    | 258.928    | 258.897    | 258.866    | 258.835    | 258.804    | 258.773    | 258.743    | 258.712    | 258.681    | 258.650    |
| EXG. FORMATION LEVEL OF EXG IR UP MAIN LINE (EFL)                        | 258.954                         | 258.943    | 258.926    | 258.867    | 258.806    | 258.762    | 258.703    | 258.592    | 258.512    | 258.474    | 258.434    | 258.391    | 258.329    | 258.272    | 258.234    | 258.206    | 258.189    | 258.179    | 258.157    | 258.173    |
| DIFFERENCE BETWEEN DFC RAIL LEVEL AND EXG. RAIL LEVEL (PRL - ERL)        | 0.326                           | 0.306      | 0.292      | 0.320      | 0.350      | 0.363      | 0.392      | 0.472      | 0.521      | 0.527      | 0.537      | 0.549      | 0.580      | 0.606      | 0.612      | 0.610      | 0.596      | 0.575      | 0.566      | 0.519      |
| DFC RAIL LEVEL (PRL)                                                     | 259.952                         | 259.921    | 259.890    | 259.859    | 259.828    | 259.797    | 259.766    | 259.735    | 259.704    | 259.673    | 259.642    | 259.612    | 259.581    | 259.550    | 259.519    | 259.488    | 259.457    | 259.426    | 259.395    | 259.364    |
| EXG.RAIL LEVEL OF NEAREST IR UP MAIN LINE(ERL)                           | 259.626                         | 259.615    | 259.598    | 259.539    | 259.478    | 259.434    | 259.375    | 259.264    | 259.184    | 259.146    | 259.106    | 259.063    | 259.001    | 258.944    | 258.906    | 258.878    | 258.861    | 258.851    | 258.829    | 258.845    |
| EQUIVALENT CHAINEGE ON DFC TRACK                                         | -1245887.7                      | -1245897.7 | -1245917.7 | -1245937.7 | -1245957.7 | -1245977.7 | -1245997.7 | -1246017.7 | -1246037.7 | -1246057.7 | -1246077.7 | -1246097.7 | -1246117.7 | -1246137.7 | -1246157.7 | -1246177.7 | -1246197.7 | -1246217.7 | -1246237.7 | -1246257.7 |
| EXISTING IR CHAINEGE                                                     | 355000.0                        | 355020.0   | 355040.0   | 355060.0   | 355080.0   | 355100.0   | 355120.0   | 355140.0   | 355160.0   | 355180.0   | 355200.0   | 355220.0   | 355240.0   | 355260.0   | 355280.0   | 355300.0   | 355320.0   | 355340.0   | 355360.0   | 355380.0   |

L - SECTION

NOTE:-

- DFCC WORKS ARE SHOWN IN RED.
- IR NEW WORKS ARE SHOWN IN VIOLET.
- ALL DIMENSIONS ARE SHOWN IN METRES.
- THIS DRAWING IS PREPARED BASED ON LATEST SURVEY DATA HELD ON APRIL-2022. GTS BENCH MARK OF 261.850M CONSIDERED ON TOP OF CANAL BRIDGE ABUTMENT AT DORANA VILLAGE ALONG THE NH1.
- DFC NEW CHAINEGE OF 1075.950M IS WITH REFERENCE TO THE IR KM OF 187.500KM END OF KM OF CP-303(SECTION P-3 PILKHANI END) AGAINST THE EXISTING DFC CHAINEGE. 116277.742M ISSUED VIDE LETTER NO. COM/DFCC/UMS/SURVEY/2021-301-230116-011173 DT. 17.01.2023.
- BALLAST PROFILE HAS BEEN PROVIDED ACCORDING TO THE CLAUSE 1.11.3 OF STANDARD SCHEDULE OF DIMENSION(EASTERN CORRIDOR) & THE BALLAST CUSHION DIMESION SHOWN IN 35CM ON GE-14 PARA 17. SPECIFICATIONS & RECOMMENDATIONS 2. TWO LAYER SYSTEM FIG.10.

REFERENCE DRAWINGS :-

- FOR KEY PLAN REFER DRAWING NO. 301-2/AL/0001
- FOR LEGEND AND ABBREVIATIONS REFER DRAWING NO. 301-2/AL/1000
- FOR TYPICAL SECTION OF BALLAST PROFILE (FL-RL) REFER DRG. NO. 301-2/TK/TFD/004 (TR.1952)

LEGEND:

IR TRACK  
DFCC TRACK  
DFCC FUTURE PROPOSALS  
STRUCTURE / BUILDING  
DFCC TOE LINE  
DFCC FORMATION  
RETAINING WALL  
ROAD  
STREAM, DRAIN, NALA, CANAL.  
FENCE  
POWER LINES  
TBM  
ELECTRIC POLE/OHE MAST  
IR RAILWAY BOUNDARY  
DFCC BOUNDARY

SCALE

HOR - 1:1000  
VER - 1:100  
SHEET SIZE : A1

TYPICAL SECTION

| TRACK STRUCTURE                                                                            |                                             |             |
|--------------------------------------------------------------------------------------------|---------------------------------------------|-------------|
| RAIL SECTION: 60Kg/m (UIC 60Kg/m)<br>DFC LINE: 60Kg/m (UIC 60Kg/m)<br>IR MAIN LINE: 52Kg/m | Difference between FL- RL (Below Rail Seat) |             |
|                                                                                            | IR Line                                     | DFC         |
|                                                                                            | 172mm                                       | 172mm       |
| RUBBER PAD                                                                                 | 6mm                                         | 10mm        |
| SLEEPER DEPTH                                                                              | 210mm                                       | 210mm       |
| BALLAST CUSHION                                                                            | 300mm                                       | 350mm       |
| Total Depth (FL TO RL)                                                                     |                                             | 688mm 742mm |

OWNER

DEDICATED FREIGHT CORRIDOR CORPORATION OF INDIA LTD.  
(A GOVERNMENT OF INDIA ENTERPRISE)  
PROJECT OFFICE/AMBALA UNIT: OLD RAILWAY COLONY (NEAR ANAND MARKET),AMBALA CANTT.-133001.  
CORPORATE IDENTITY NO. : U60232DL2006GGI155068

ENGINEER:

DB Engineering & Consulting GmbH  
Deutsche Bahn Engineering & Consulting GmbH

CONTRACTOR:

GIL - TPL JV  
GAR TATA

| SUBMITTED BY           | GIL - TPL JV                                |                   |           |
|------------------------|---------------------------------------------|-------------------|-----------|
|                        | DATED                                       | NAME              | SIGNATURE |
| PREPARED BY            |                                             |                   |           |
| CHECKED BY             | 21.10.2024                                  | VIJAY PRATAP      |           |
| APPROVED BY            | 21.10.2024                                  | PARASURAM KOTYADA |           |
| APPROVED BY            | DEUTSCHE BAHN ENGINEERING & CONSULTING GMBH |                   |           |
|                        | DATED                                       | NAME              | SIGNATURE |
| Sr. DE./CHIEF ENGINEER |                                             | SURESH K.YALANGI  |           |
| CHIEF TRACK ENGINEER   |                                             | RAJ PAL SINGH     |           |
| T.L.                   |                                             | H.D. VIDJAK       |           |

STAMP

A AS-BUILT DRAWING  
TR. Ref.:.....  
ENGINEER Sign.:.....

EMPLOYER (DFCCIL): DEDICATED FREIGHT CORRIDOR CORPORATION OF INDIA LTD.

AS BUILT DRAWING

TITLE



AS-BUILT PLAN AND PROFILE



FROM IR KM: 355.000 TO 355.500  
FROM DFC KM: 1245.878 to 1246.378

DFCC APPR. NO. -  
ENGNG. APPR. NO. -  
DRG. NO. :301-2/AL/A/1336  
SHEET NO. :1 OF 1  
DATE : 21.10.2024

STATUS  
A

TR.

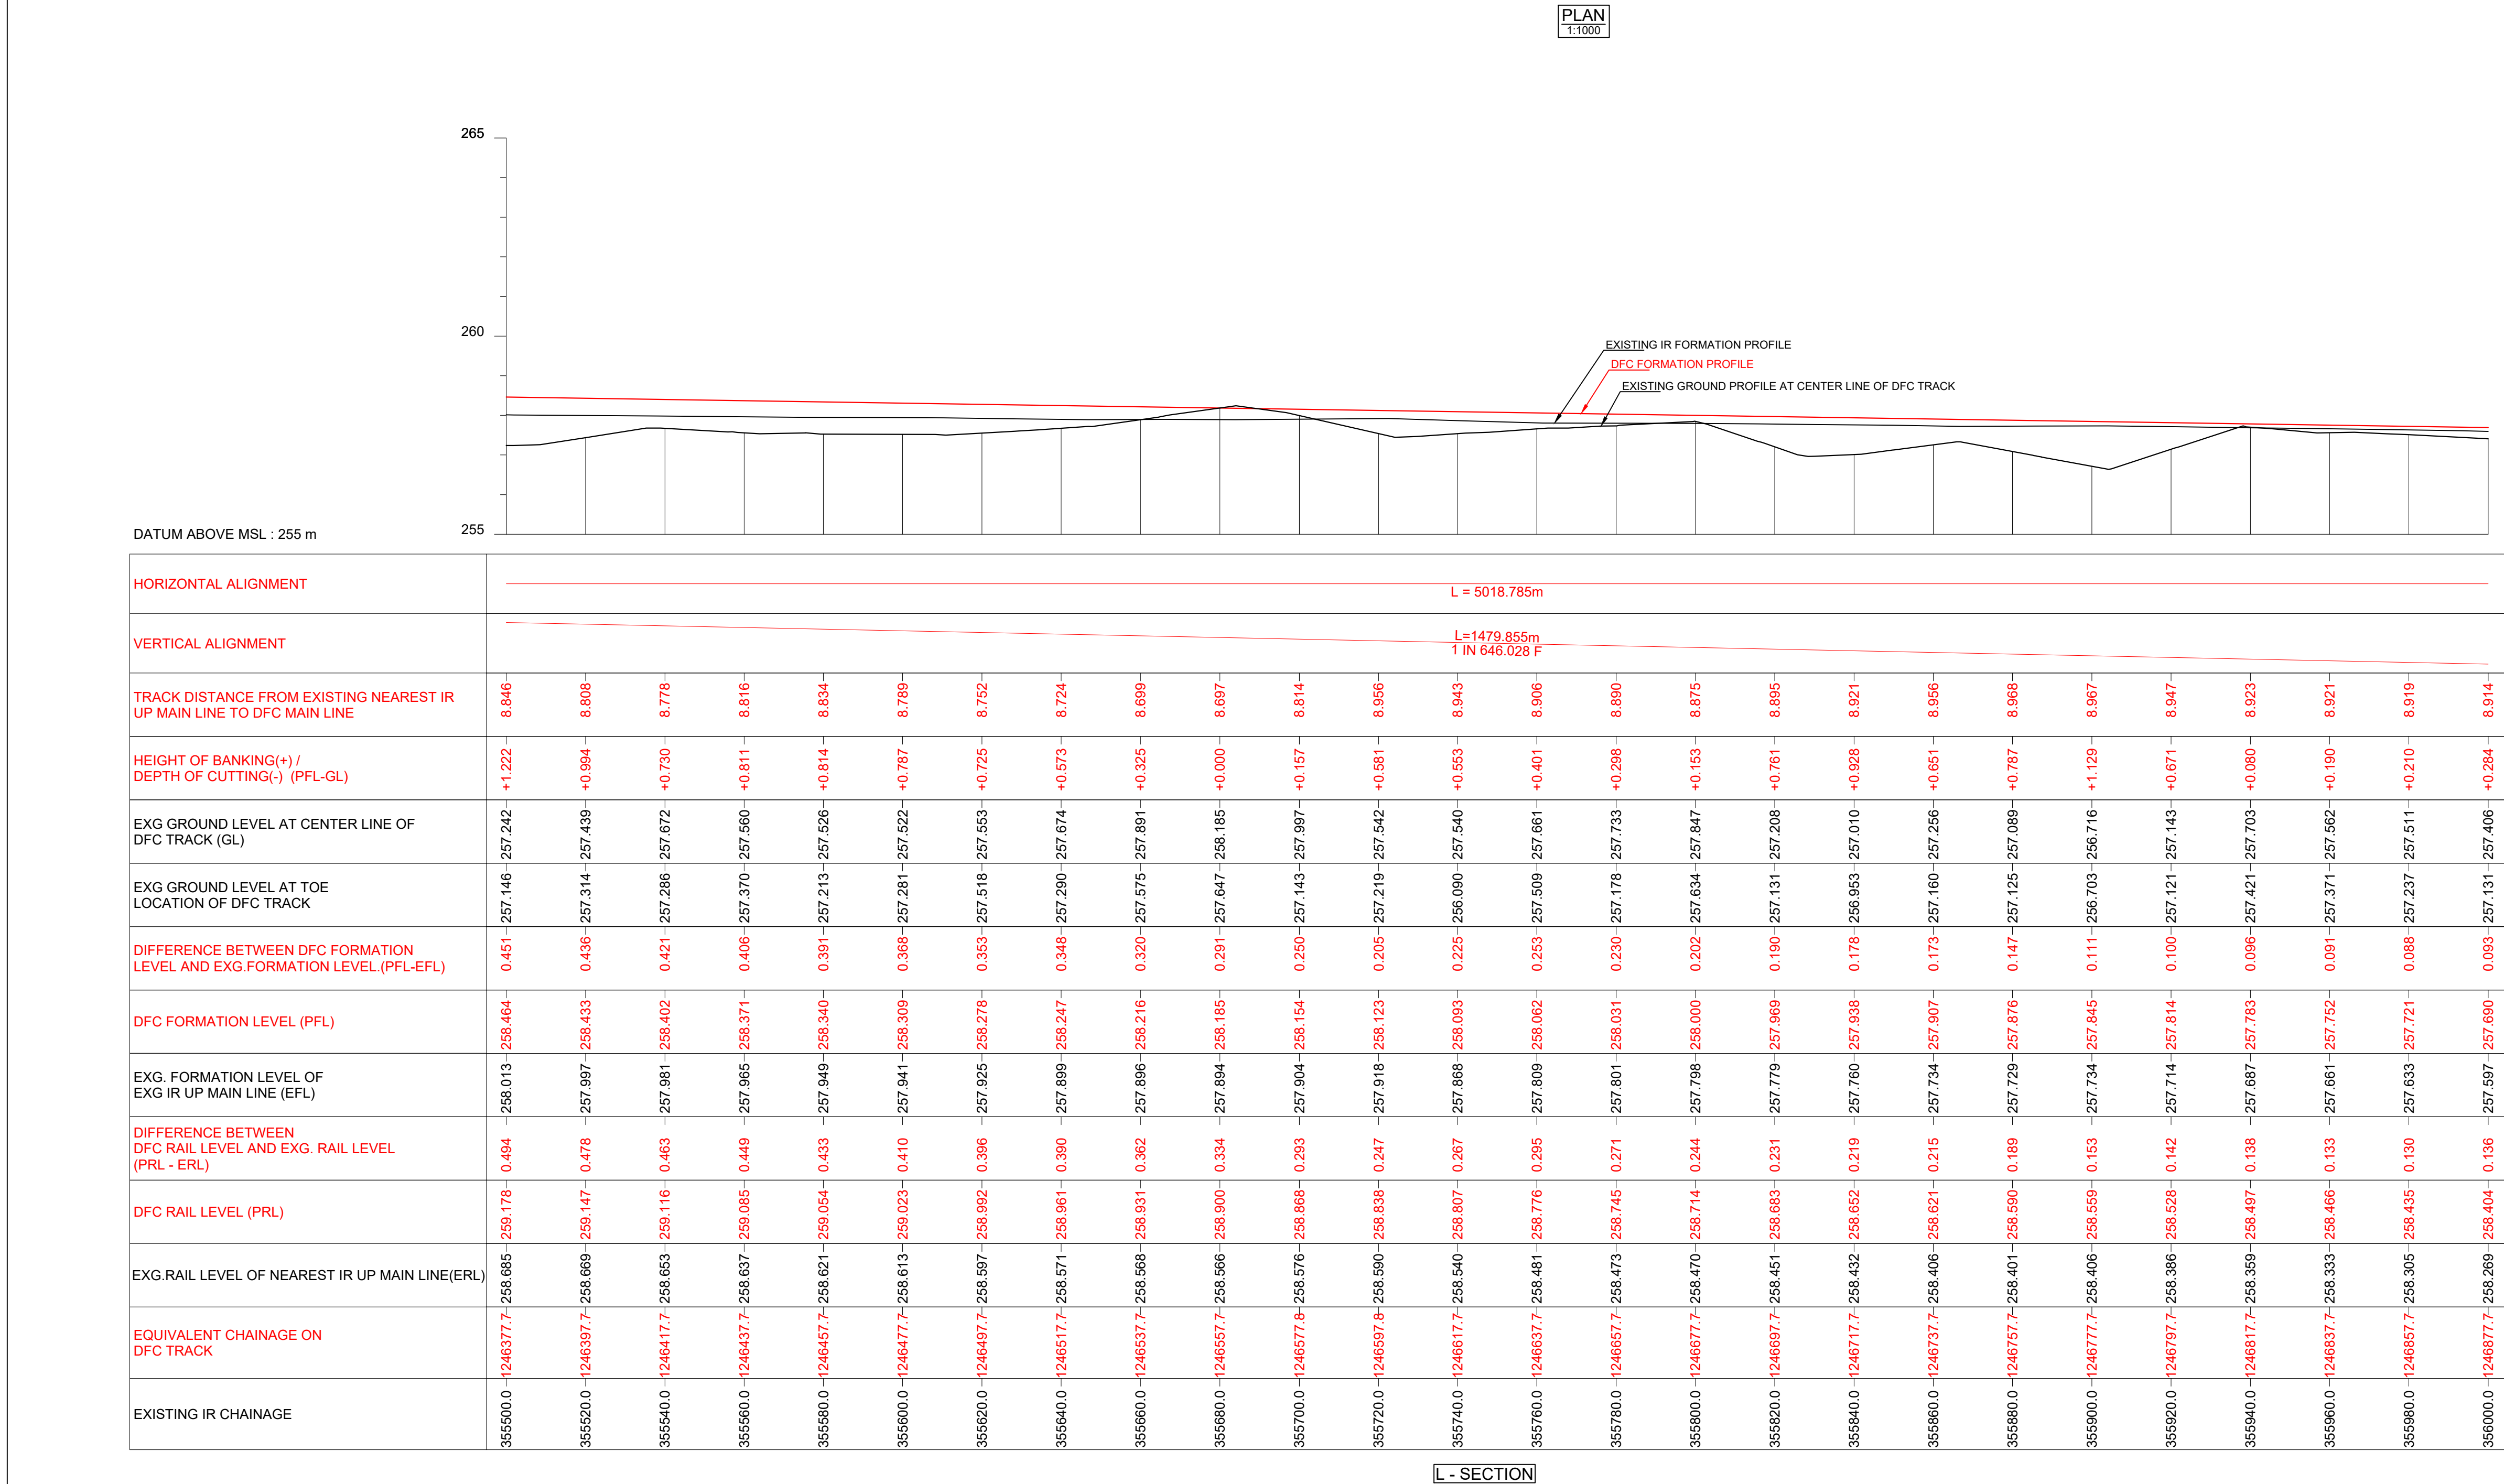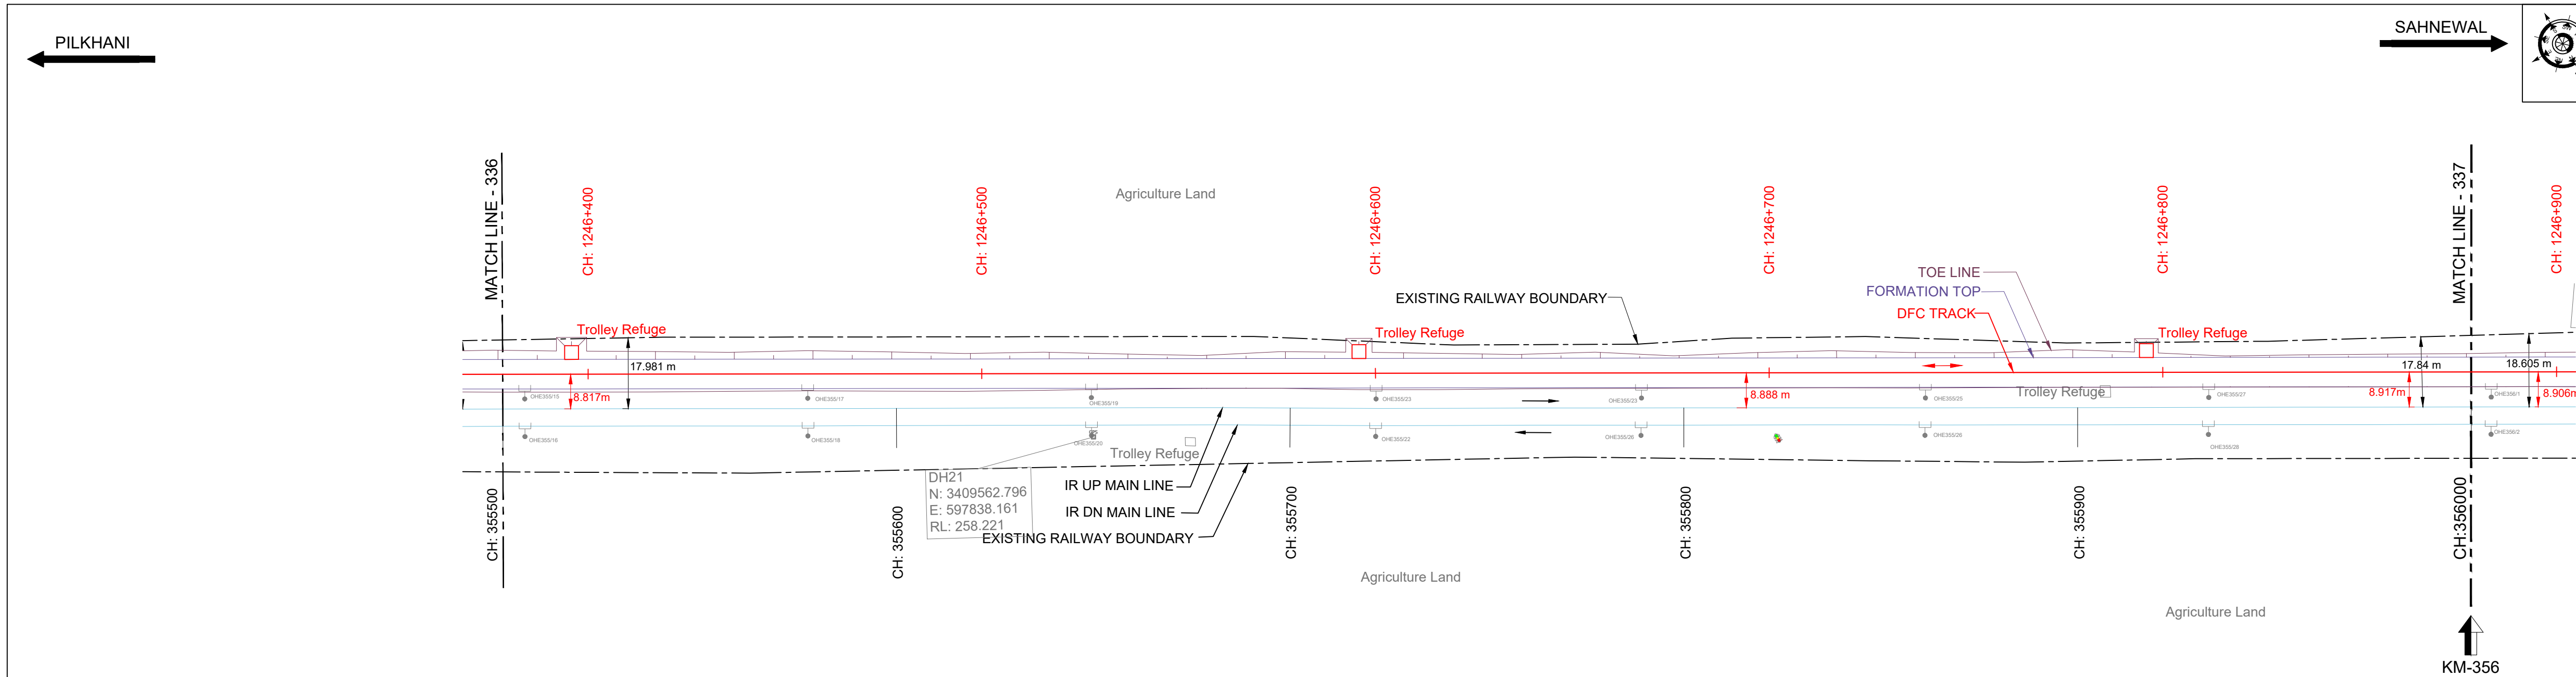

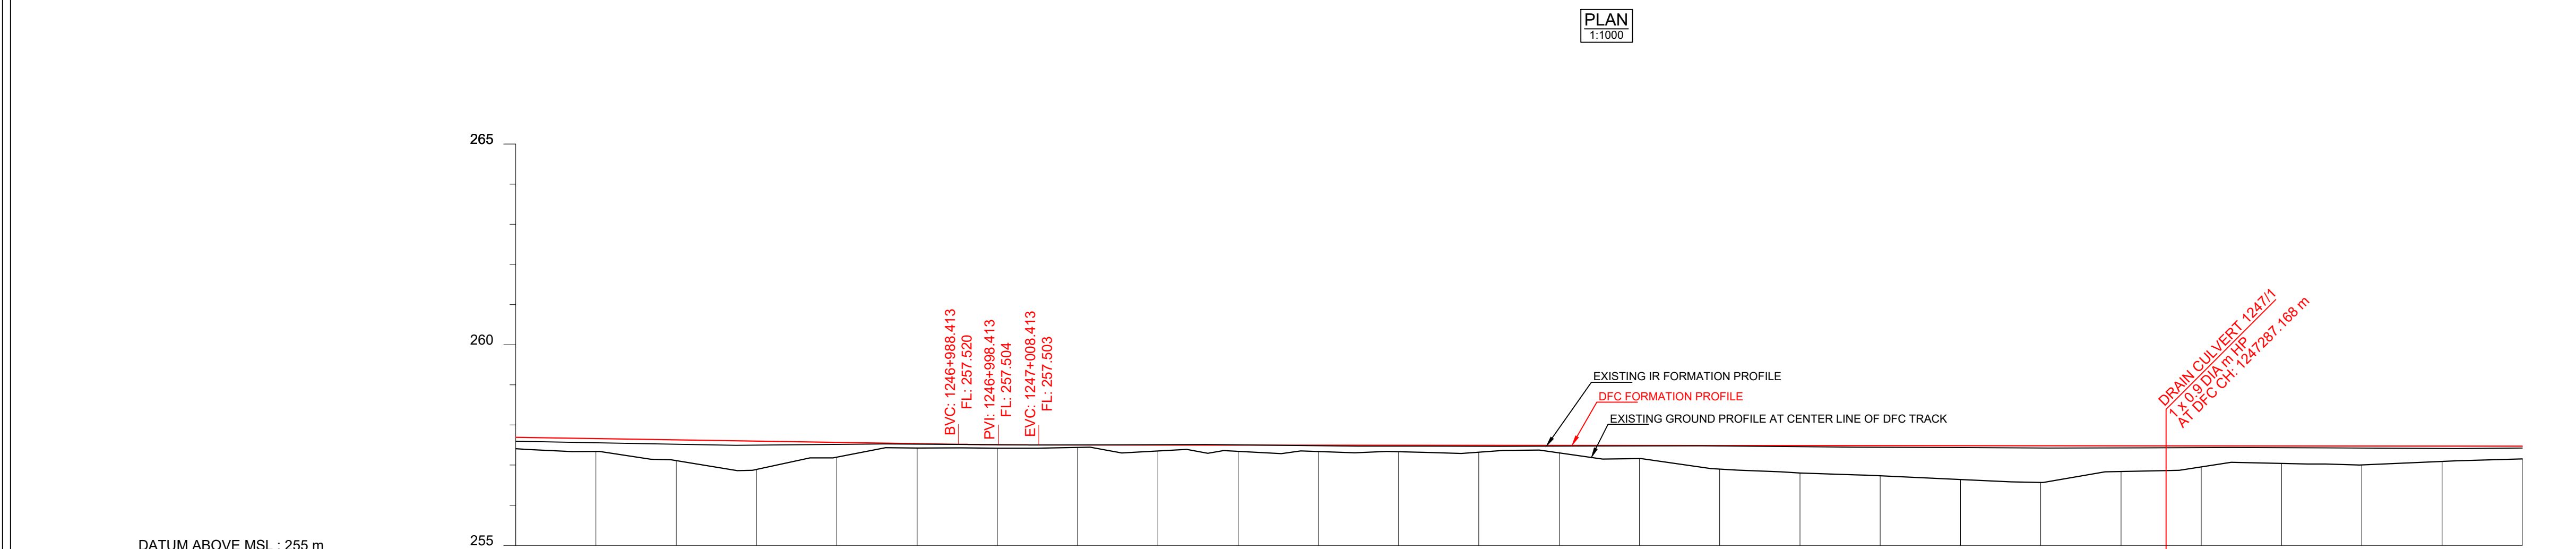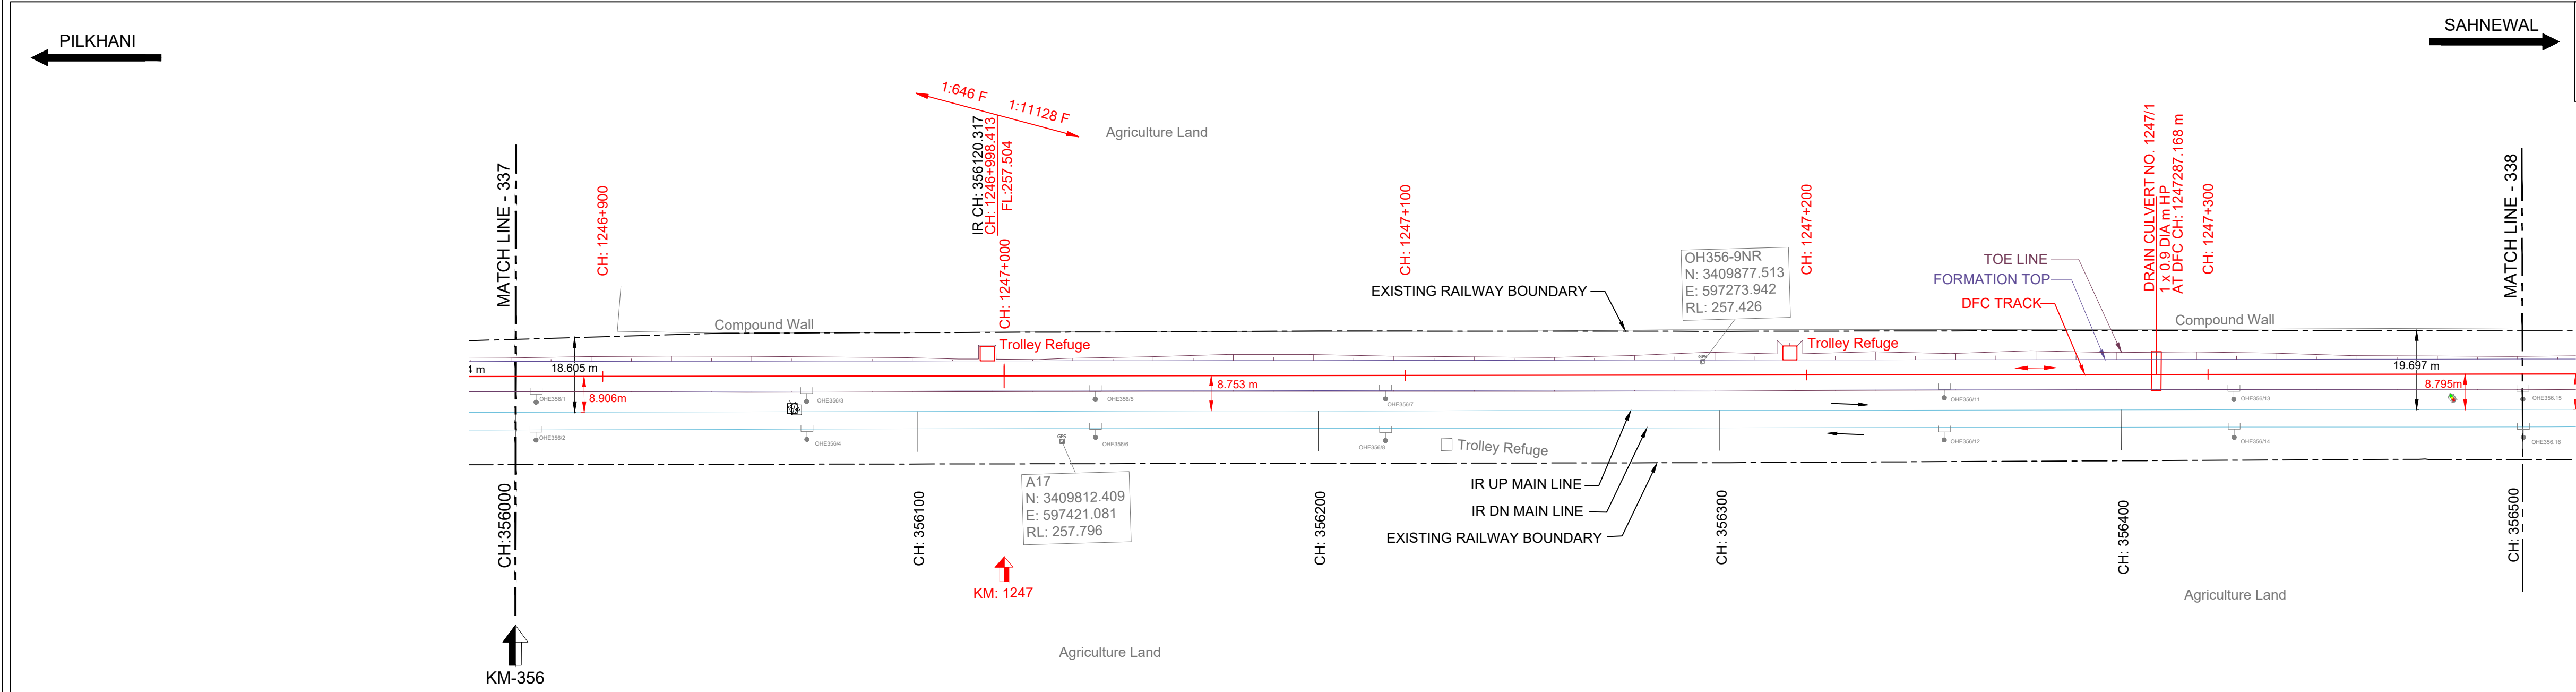

| HORIZONTAL ALIGNMENT                                                     | L = 5018.785m                                                                              |           |           |           |           |           |           |           |           |           |           |           |           |           |           |           |           |           |           |           |
|--------------------------------------------------------------------------|--------------------------------------------------------------------------------------------|-----------|-----------|-----------|-----------|-----------|-----------|-----------|-----------|-----------|-----------|-----------|-----------|-----------|-----------|-----------|-----------|-----------|-----------|-----------|
| VERTICAL ALIGNMENT                                                       | L=1479.859m<br>1 IN 646.028 F<br>L=20.0 m<br>R=13717 m<br>L=1480.145 m<br>1 IN 11127.847 F |           |           |           |           |           |           |           |           |           |           |           |           |           |           |           |           |           |           |           |
| TRACK DISTANCE FROM EXISTING NEAREST IR UP MAIN LINE TO DFC MAIN LINE    | 8.914                                                                                      | 8.901     | 8.872     | 8.846     | 8.826     | 8.820     | 8.837     | 8.818     | 8.775     | 8.771     | 8.822     | 8.823     | 8.776     | 8.772     | 8.784     | 8.795     | 8.809     | 8.818     | 8.816     | 8.815     |
| HEIGHT OF BANKING(+) / DEPTH OF CUTTING(-) (PFL-GL)                      | +0.284                                                                                     | +0.317    | +0.517    | +0.704    | +0.370    | +0.108    | +0.087    | +0.060    | +0.149    | +0.158    | +0.159    | +0.161    | +0.171    | +0.187    | +0.329    | +0.588    | +0.683    | +0.748    | +0.841    | +0.914    |
| EXG GROUND LEVEL AT CENTER LINE OF DFC TRACK (GL)                        | 257.406                                                                                    | 257.342   | 257.111   | 256.893   | 257.196   | 257.427   | 257.421   | 257.442   | 257.351   | 257.341   | 257.338   | 257.334   | 257.322   | 257.304   | 257.161   | 256.900   | 256.803   | 256.736   | 256.641   | 256.567   |
| EXG GROUND LEVEL AT TOE LOCATION OF DFC TRACK                            | 257.131                                                                                    | 256.955   | 256.895   | 256.906   | 256.980   | 257.056   | 257.187   | 257.038   | 256.944   | 256.657   | 256.681   | 256.876   | 256.931   | 257.039   | 256.802   | 256.421   | 256.596   | 256.414   | 256.615   | 256.201   |
| DIFFERENCE BETWEEN DFC FORMATION LEVEL AND EXG.FORMATION LEVEL (PFL-EFL) | 0.093                                                                                      | 0.103     | 0.108     | 0.099     | 0.049     | 0.014     | -0.001    | -0.001    | -0.010    | -0.007    | 0.013     | 0.023     | 0.023     | 0.019     | 0.014     | 0.012     | 0.026     | 0.039     | 0.047     | 0.055     |
| DFC FORMATION LEVEL (PFL)                                                | 257.690                                                                                    | 257.659   | 257.628   | 257.597   | 257.566   | 257.535   | 257.508   | 257.502   | 257.500   | 257.499   | 257.484   | 257.495   | 257.493   | 257.491   | 257.490   | 257.476   | 257.486   | 257.484   | 257.482   | 257.481   |
| EXG. FORMATION LEVEL OF EXG IR UP MAIN LINE (EFL)                        | 257.597                                                                                    | 257.556   | 257.520   | 257.498   | 257.517   | 257.521   | 257.506   | 257.503   | 257.510   | 257.506   | 257.484   | 257.472   | 257.470   | 257.472   | 257.476   | 257.476   | 257.460   | 257.445   | 257.435   | 257.426   |
| DIFFERENCE BETWEEN DFC RAIL LEVEL AND EXG. RAIL LEVEL (PRL - ERL)        | 0.136                                                                                      | 0.146     | 0.150     | 0.141     | 0.092     | 0.056     | 0.040     | 0.040     | 0.032     | 0.034     | 0.054     | 0.064     | 0.064     | 0.060     | 0.064     | 0.053     | 0.068     | 0.080     | 0.088     | 0.095     |
| DFC RAIL LEVEL (PRL)                                                     | 258.404                                                                                    | 258.373   | 258.342   | 258.311   | 258.280   | 258.249   | 258.218   | 258.215   | 258.213   | 258.212   | 258.210   | 258.208   | 258.206   | 258.204   | 258.203   | 258.201   | 258.199   | 258.197   | 258.195   | 258.194   |
| EXG.RAIL LEVEL OF NEAREST IR UP MAIN LINE(ERL)                           | 258.269                                                                                    | 258.228   | 258.192   | 258.170   | 258.189   | 258.193   | 258.178   | 258.175   | 258.182   | 258.178   | 258.156   | 258.144   | 258.142   | 258.144   | 258.148   | 258.148   | 258.132   | 258.117   | 258.107   | 258.098   |
| EQUIVALENT CHAINAGE ON DFC TRACK                                         | 1246887.7                                                                                  | 1246897.7 | 1246917.7 | 1246937.7 | 1246957.7 | 1246977.7 | 1246997.7 | 1247017.7 | 1247037.7 | 1247057.7 | 1247077.7 | 1247097.7 | 1247117.7 | 1247137.7 | 1247157.7 | 1247177.7 | 1247197.7 | 1247217.7 | 1247237.7 | 1247257.7 |
| EXISTING IR CHAINAGE                                                     | 356000.0                                                                                   | 356020.0  | 356040.0  | 356060.0  | 356080.0  | 356100.0  | 356120.0  | 356140.0  | 356160.0  | 356180.0  | 356200.0  | 356220.0  | 356240.0  | 356260.0  | 356280.0  | 356300.0  | 356320.0  | 356340.0  | 356360.0  | 356380.0  |

L - SECTION

NOTE:-  
1. DFC WORKS ARE SHOWN IN RED.  
2. IR NEW WORKS ARE SHOWN IN VIOLET.  
3. ALL DIMENSIONS ARE SHOWN IN METRES.  
4. THIS DRAWING IS PREPARED BASED ON LATEST SURVEY DATA HELD ON APRIL-2022. GTS BENCH MARK OF 261.850M CONSIDERED ON TOP OF CANAL BRIDGE ABUTMENT AT DORANA VILLAGE ALONG THE NH1.  
5. DFC NEW CHAINAGE OF 1075.950M IS WITH REFERENCE TO THE IR KM OF 187.500KM END OF KM OF CP-303(SECTION P-3 PILKHANI END) AGAINST THE EXISTING DFC CHAINAGE. 116277.742M ISSUED VIDE LETTER NO. COM/DFCC/UMS/SURVEY/2021-301-2301/16-011173 DT. 17.01.2023.  
6. BALLAST PROFILE HAS BEEN PROVIDED ACCORDING TO THE CLAUSE 1.11.3 OF STANDARD SCHEDULE OF DIMENSION(EASTERN CORRIDOR) & THE BALLAST CUSHION DIMENSION SHOWN IN 35CM ON GE-14 PARA 17. SPECIFICATIONS & RECOMMENDATIONS 2. TWO LAYER SYSTEM FIG.10.


REFERENCE DRAWINGS :-  
1. FOR KEY PLAN REFER DRAWING NO. 301-2/AL/0001  
2. FOR LEGEND AND ABBREVIATIONS REFER DRAWING NO. 301-2/AL/1000  
3. FOR TYPICAL SECTION OF BALLAST PROFILE (FL-RL) REFER DRG. NO. 301-2/TK/TFD/004 (TR.1952)

| REV. | DATE       | SUBMISSION OF AS-BUILT DRAWING | FOR APPROVAL |
|------|------------|--------------------------------|--------------|
| 0    | 21.10.2024 | SUBMISSION OF AS-BUILT DRAWING | FOR APPROVAL |

LEGEND:

SCALE  
HOR - 1:1000  
VER - 1:100  
SHEET SIZE : A1

IR TRACK  
DFCC TRACK  
DFCC FUTURE PROPOSALS  
STRUCTURE / BUILDING  
DFCC TOE LINE  
DFCC FORMATION  
RETAINING WALL  
ROAD  
STREAM, DRAIN, NALA, CANAL.  
FENCE  
POWER LINES  
TBM  
ELECTRIC POLE/OHE MAST  
IR RAILWAY BOUNDARY  
DFCC BOUNDARY

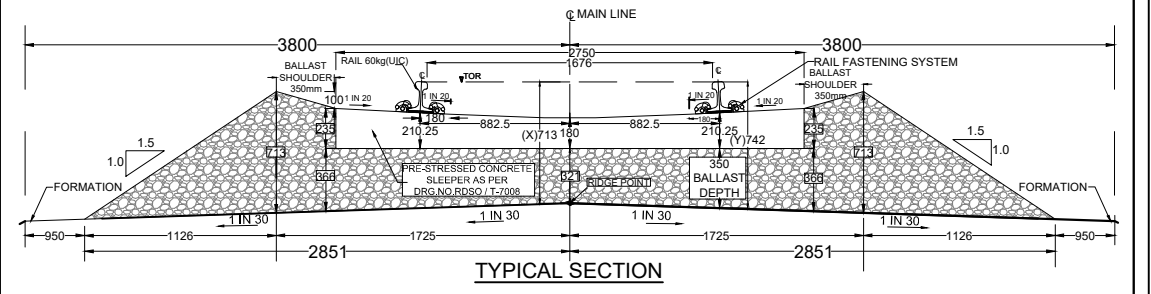

| TRACK STRUCTURE                                                                            |                                             |       |
|--------------------------------------------------------------------------------------------|---------------------------------------------|-------|
| RAIL SECTION: 60Kg/m (UIC 60Kg/m)<br>DFC LINE: 60Kg/m (UIC 60Kg/m)<br>IR MAIN LINE: 52Kg/m | Difference between FL- RL (Below Rail Seat) |       |
|                                                                                            | IR Line                                     | DFC   |
| RUBBER PAD                                                                                 | 172mm                                       | 172mm |
| SLEEPER DEPTH                                                                              | 6mm                                         | 10mm  |
| BALLAST CUSHION                                                                            | 210mm                                       | 210mm |
| Total Depth (FL TO RL)                                                                     | 300mm                                       | 350mm |

OWNER: DEDICATED FREIGHT CORRIDOR CORPORATION OF INDIA LTD. (A GOVERNMENT OF INDIA ENTERPRISE)  
PROJECT OFFICE/AMBALA UNIT: OLD RAILWAY COLONY (NEAR ANAND MARKET), AMBALA CANTT-133001.  
CORPORATE IDENTITY NO. : U60232DL2006GG155068

ENGINEER: DB Engineering & Consulting GmbH  
Deutsche Bahn Engineering & Consulting GmbH

CONTRACTOR: GIL - TPL JV  
GAR TATA

| SUBMITTED BY | GIL - TPL JV |                   |           |
|--------------|--------------|-------------------|-----------|
|              | DATED        | NAME              | SIGNATURE |
| PREPARED BY  | 21.10.2024   | VIJAY PRATAP      |           |
| CHECKED BY   | 21.10.2024   | PARASURAM KOTYADA |           |
| APPROVED BY  | 21.10.2024   | PARASURAM KOTYADA |           |

| APPROVED BY            | DEUTSCHE BAHN ENGINEERING & CONSULTING GMBH |                  |           |
|------------------------|---------------------------------------------|------------------|-----------|
|                        | DATED                                       | NAME             | SIGNATURE |
| Sr. DE./CHIEF ENGINEER |                                             | SURESH K.YALANGI |           |
| CHIEF TRACK ENGINEER   |                                             | RAJ PAL SINGH    |           |
| T.L.                   |                                             | H.D. VIDJAK      |           |

STAMP: A AS-BUILT DRAWING TR. Ref.: ENGINEER Sign.:

EMPLOYER (DFCCIL): DEDICATED FREIGHT CORRIDOR CORPORATION OF INDIA LTD.



AS BUILT DRAWING

TITLE: AS-BUILT PLAN AND PROFILE

FROM IR KM: 356.000 TO 356.500  
FROM DFC KM: 1246.878 TO 1247.378

DFCC APPR. NO. -  
ENGG. APPR. NO. -  
DRG. NO. -301-2/AL/A/1338  
SHEET NO.: 1 OF 1  
DATE: 21.10.2024

STATUS: A

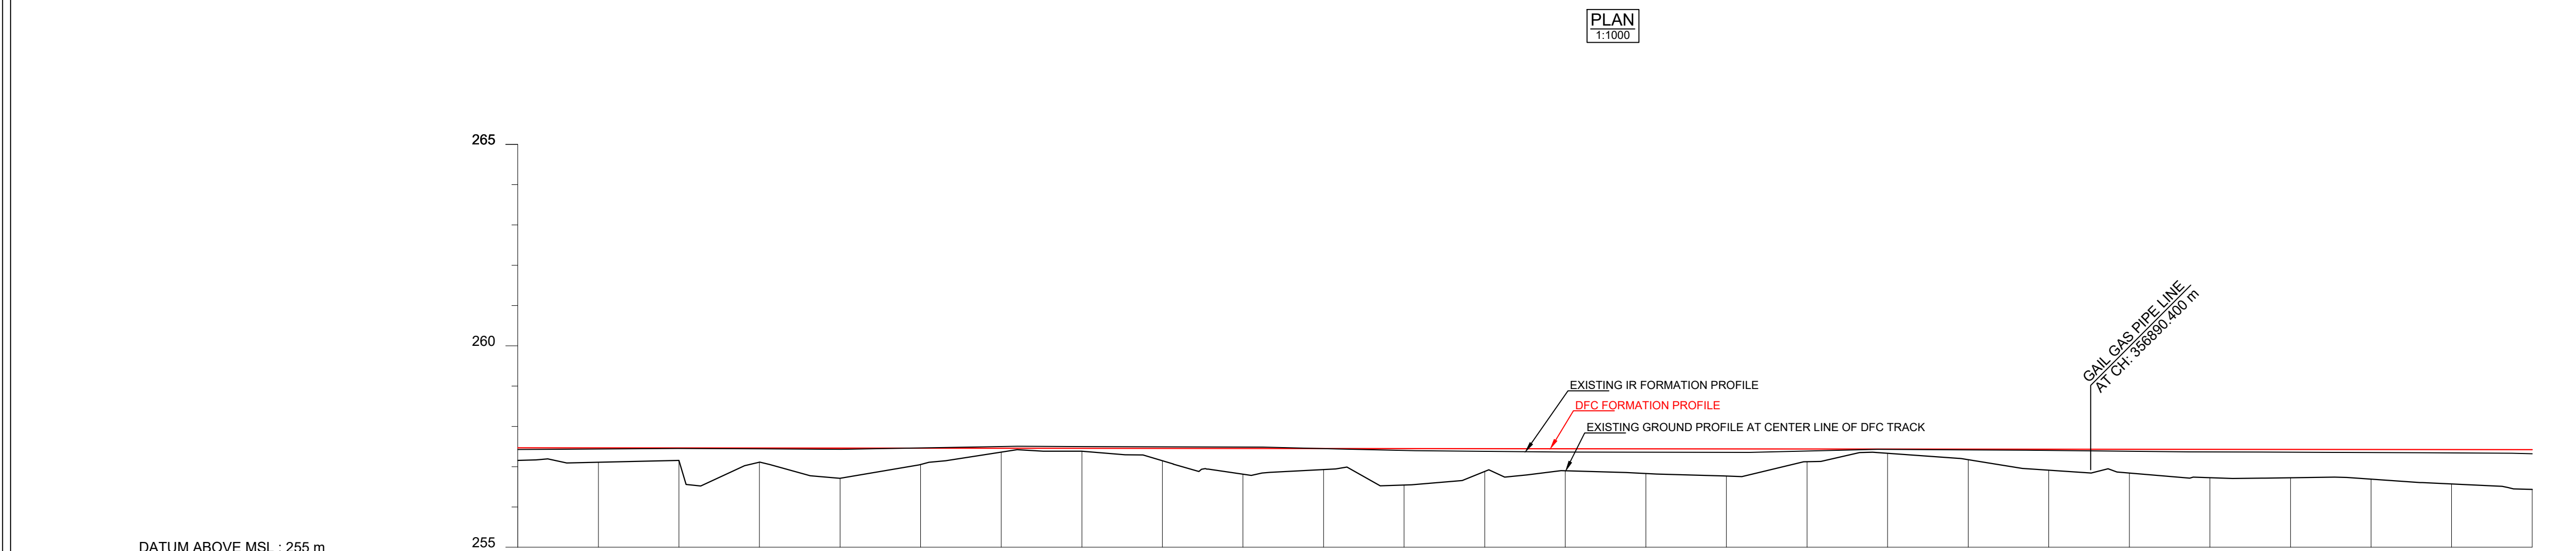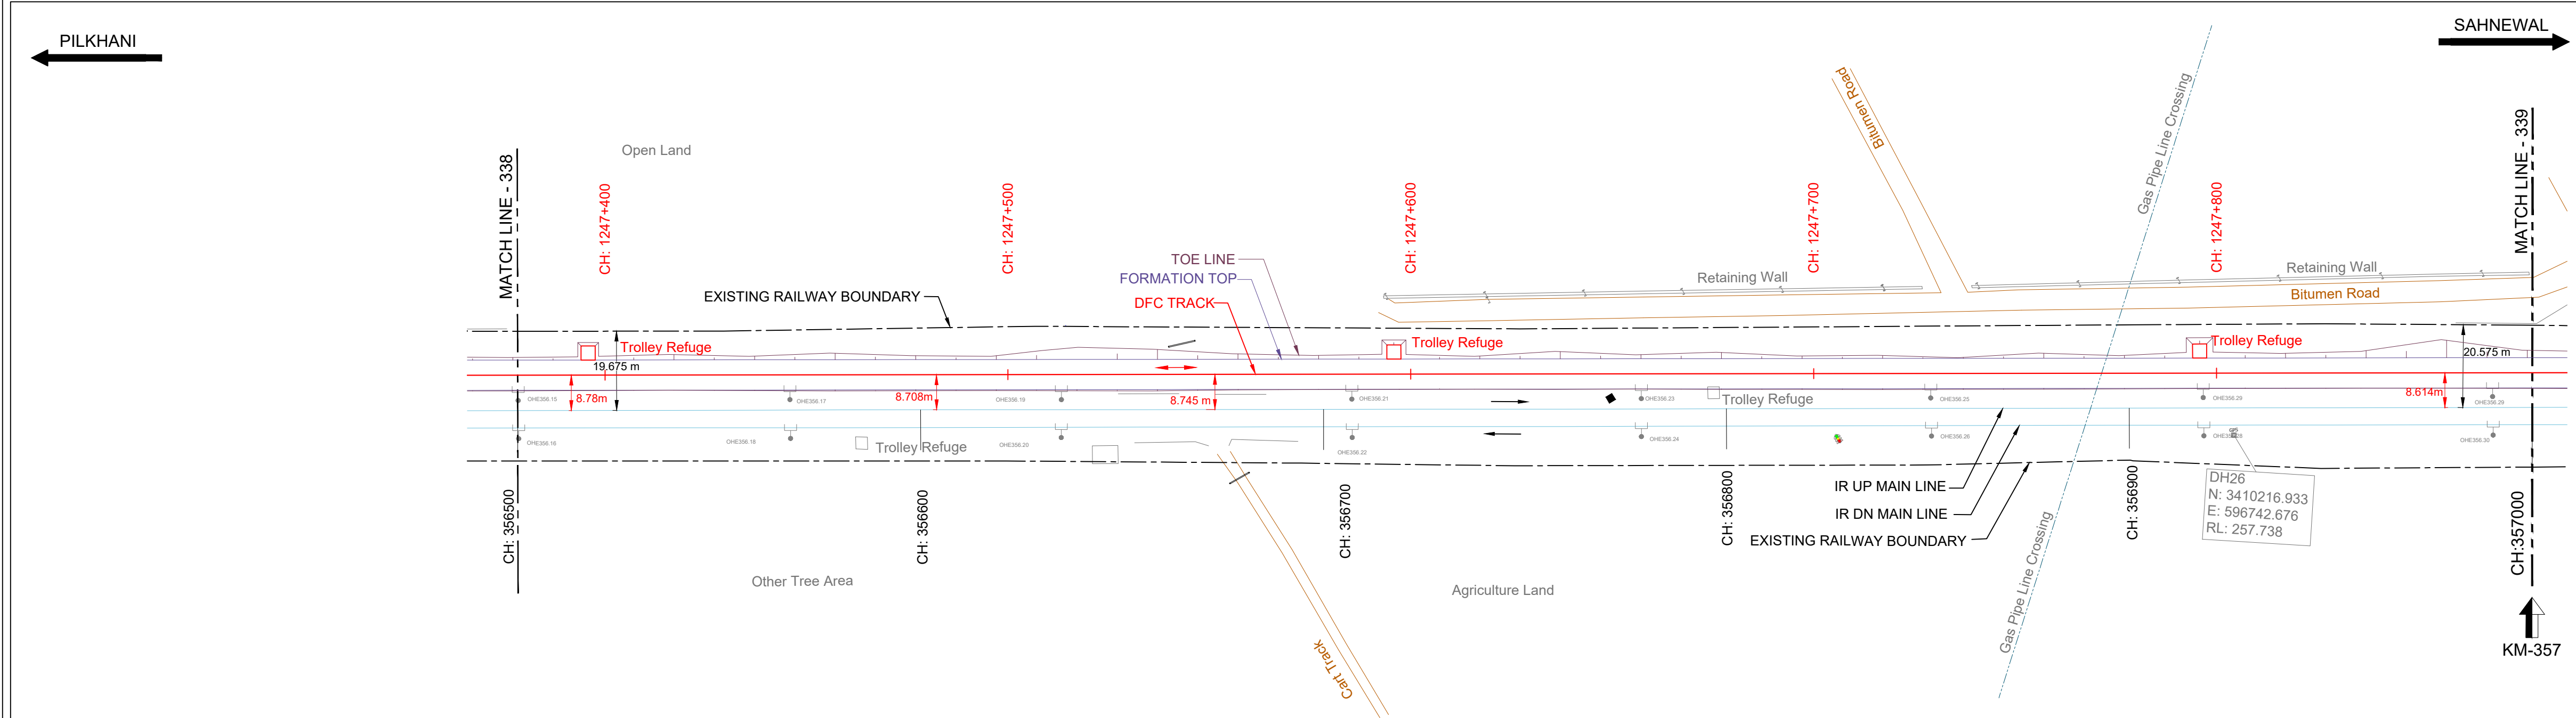

|                                                                          |                                    |--------------------------------------------------------------------------|------------------------------------|-----------|-----------|-----------|-----------|-----------|-----------|-----------|-----------|-----------|-----------|-----------|-----------|-----------|-----------|-----------|-----------|-----------|-----------|-----------|
| HORIZONTAL ALIGNMENT                                                     | L = 5018.785m                      |           |           |           |           |           |           |           |           |           |           |           |           |           |           |           |           |           |           |           |
| VERTICAL ALIGNMENT                                                       | L = 1490.145 m<br>1 IN 11127.847 F |           |           |           |           |           |           |           |           |           |           |           |           |           |           |           |           |           |           |           |
| TRACK DISTANCE FROM EXISTING NEAREST IR UP MAIN LINE TO DFC MAIN LINE    | 8.787                              | 8.776     | 8.764     | 8.745     | 8.724     | 8.710     | 8.697     | 8.679     | 8.657     | 8.633     | 8.613     | 8.594     |           |           |           |           |           |           |           |           |
| HEIGHT OF BANKING(+) / DEPTH OF CUTTING(-) (PFL-GL)                      | +0.315                             | +0.357    | +0.310    | +0.353    | +0.752    | +0.404    | +0.097    | +0.072    | +0.309    | +0.641    | +0.523    | +0.904    | +0.584    | +0.548    | +0.613    | +0.673    | +0.316    | +0.106    | +0.282    | +0.522    |
| EXG GROUND LEVEL AT CENTER LINE OF DFC TRACK (GL)                        | 257.155                            | 257.111   | 257.156   | 257.112   | 256.986   | 257.112   | 256.986   | 257.112   | 256.986   | 257.112   | 256.986   | 257.112   | 256.986   | 257.112   | 256.986   | 257.112   | 256.986   | 257.112   | 256.986   | 257.112   |
| EXG GROUND LEVEL AT TOE LOCATION OF DFC TRACK                            | 257.071                            | 256.896   | 257.156   | 257.112   | 256.986   | 257.112   | 256.986   | 257.112   | 256.986   | 257.112   | 256.986   | 257.112   | 256.986   | 257.112   | 256.986   | 257.112   | 256.986   | 257.112   | 256.986   | 257.112   |
| DIFFERENCE BETWEEN DFC FORMATION LEVEL AND EXG.FORMATION LEVEL (PFL-EFL) | 0.045                              | 0.029     | 0.015     | 0.023     | 0.029     | -0.007    | -0.042    | -0.043    | -0.037    | -0.034    | 0.002     | 0.047     | 0.066     | 0.082     | 0.084     | 0.086     | 0.051     | 0.009     | 0.020     | 0.033     |
| DFC FORMATION LEVEL (PFL)                                                | 257.470                            | 257.468   | 257.466   | 257.465   | 257.463   | 257.461   | 257.459   | 257.457   | 257.456   | 257.454   | 257.452   | 257.450   | 257.448   | 257.447   | 257.445   | 257.443   | 257.441   | 257.439   | 257.438   | 257.436   |
| EXG. FORMATION LEVEL OF EXG IR UP MAIN LINE (EFL)                        | 257.425                            | 257.439   | 257.451   | 257.442   | 257.434   | 257.468   | 257.501   | 257.500   | 257.493   | 257.488   | 257.450   | 257.403   | 257.382   | 257.365   | 257.361   | 257.357   | 257.390   | 257.430   | 257.418   | 257.403   |
| DIFFERENCE BETWEEN DFC RAIL LEVEL AND EXG. RAIL LEVEL (PRL - ERL)        | 0.086                              | 0.070     | 0.056     | 0.063     | 0.070     | 0.034     | -0.001    | -0.002    | 0.004     | 0.007     | 0.043     | 0.088     | 0.107     | 0.122     | 0.125     | 0.127     | 0.092     | 0.050     | 0.061     | 0.074     |
| DFC RAIL LEVEL (PRL)                                                     | 258.163                            | 258.181   | 258.179   | 258.178   | 258.176   | 258.174   | 258.172   | 258.170   | 258.165   | 258.167   | 258.165   | 258.163   | 258.161   | 258.160   | 258.158   | 258.156   | 258.154   | 258.152   | 258.151   | 258.149   |
| EXG.RAIL LEVEL OF NEAREST IR UP MAIN LINE(ERL)                           | 258.097                            | 258.111   | 258.123   | 258.114   | 258.106   | 258.140   | 258.173   | 258.172   | 258.165   | 258.160   | 258.122   | 258.075   | 258.054   | 258.037   | 258.033   | 258.029   | 258.062   | 258.102   | 258.090   | 258.075   |
| EQUIVALENT CHAINEGE ON DFC TRACK                                         | 1247377.7                          | 1247397.7 | 1247417.7 | 1247437.7 | 1247457.7 | 1247477.7 | 1247497.7 | 1247517.7 | 1247537.7 | 1247557.7 | 1247577.7 | 1247597.7 | 1247617.7 | 1247637.7 | 1247657.7 | 1247677.7 | 1247697.7 | 1247717.7 | 1247737.7 | 1247757.7 |
| EXISTING IR CHAINEGE                                                     | 356900.0                           | 356920.0  | 356940.0  | 356960.0  | 356980.0  | 357000.0  | 357020.0  | 357040.0  | 357060.0  | 357080.0  | 357100.0  | 357120.0  | 357140.0  | 357160.0  | 357180.0  | 357200.0  | 357220.0  | 357240.0  | 357260.0  | 357280.0  |

L - SECTION

NOTE:-

- DFCC WORKS ARE SHOWN IN RED.
- IR NEW WORKS ARE SHOWN IN VIOLET.
- ALL DIMENSIONS ARE SHOWN IN METRES.
- THIS DRAWING IS PREPARED BASED ON LATEST SURVEY DATA HELD ON APRIL-2022. GTS BENCH MARK OF 261.850M CONSIDERED ON TOP OF CANAL BRIDGE ABUTMENT AT DORAH VILLAGE ALONG THE NH1.
- DFC NEW CHAINEGE OF 1075.950M IS WITH REFERENCE TO THE IR KM OF 187.500KM END OF KM OF CP-303(SECTION P-3 PILKHANI END) AGAINST THE EXISTING DFC CHAINEGE. 116277.742M ISSUED VIDE LETTER NO. COM/DFCC/UMS/SURVEY/2021-301-230116-011173 DT. 17.01.2023.
- BALLAST PROFILE HAS BEEN PROVIDED ACCORDING TO THE CLAUSE 1.11.3 OF STANDARD SCHEDULE OF DIMENSION(EASTERN CORRIDOR) & THE BALLAST CUSHION DIMENSION SHOWN IN 35CM ON GE-14 PARA 17. SPECIFICATIONS & RECOMMENDATIONS 2. TWO LAYER SYSTEM FIG.10.

REFERENCE DRAWINGS :-

- FOR KEY PLAN REFER DRAWING NO. 301-2/AL/0001
- FOR LEGEND AND ABBREVIATIONS REFER DRAWING NO. 301-2/AL/1000
- FOR TYPICAL SECTION OF BALLAST PROFILE (FL-RL) REFER DRG. NO. 301-2/TK/TFD/004 (TR.1952)

LEGEND:

IR TRACK  
DFCC TRACK  
DFCC FUTURE PROPOSALS  
STRUCTURE / BUILDING  
DFCC TOE LINE  
DFCC FORMATION  
RETAINING WALL  
ROAD  
STREAM, DRAIN, NALA, CANAL.  
FENCE  
POWER LINES  
TBM  
ELECTRIC POLE/OHE MAST  
IR RAILWAY BOUNDARY  
DFCC BOUNDARY

SCALE

HOR - 1:1000  
VER - 1:100  
SHEET SIZE : A1

TYPICAL SECTION

| TRACK STRUCTURE                                                                            |                                             |       |
|--------------------------------------------------------------------------------------------|---------------------------------------------|-------|
| RAIL SECTION: 60Kg/m (UIC 60Kg/m)<br>DFC LINE: 60Kg/m (UIC 60Kg/m)<br>IR MAIN LINE: 52Kg/m | Difference between FL- RL (Below Rail Seat) |       |
|                                                                                            | IR Line                                     | DFC   |
|                                                                                            | 172mm                                       | 172mm |
| RUBBER PAD                                                                                 | 6mm                                         | 10mm  |
| SLEEPER DEPTH                                                                              | 210mm                                       | 210mm |
| BALLAST CUSHION                                                                            | 300mm                                       | 350mm |
| Total Depth (FL TO RL)                                                                     | 688mm                                       | 742mm |

OWNER

DEDICATED FREIGHT CORRIDOR CORPORATION OF INDIA LTD.  
(A GOVERNMENT OF INDIA ENTERPRISE)  
PROJECT OFFICE/AMBALA UNIT: OLD RAILWAY COLONY (NEAR ANAND MARKET), AMBALA CANTT-133001.  
CORPORATE IDENTITY NO. : U60232DL2006GGI155068

ENGINEER:

DB Engineering & Consulting GmbH  
Deutsche Bahn Engineering & Consulting GmbH

CONTRACTOR:

GIL - TPL JV  
GAR TATA

| SUBMITTED BY           | GIL - TPL JV                                |                   |           |
|------------------------|---------------------------------------------|-------------------|-----------|
|                        | DATED                                       | NAME              | SIGNATURE |
| PREPARED BY            |                                             |                   |           |
| CHECKED BY             | 21.10.2024                                  | VIJAY PRATAP      |           |
| APPROVED BY            | 21.10.2024                                  | PARASURAM KOTYADA |           |
| APPROVED BY            | DEUTSCHE BAHN ENGINEERING & CONSULTING GMBH |                   |           |
|                        | DATED                                       | NAME              | SIGNATURE |
| Sr. DE./CHIEF ENGINEER |                                             | SURESH K.YALANGI  |           |
| CHIEF TRACK ENGINEER   |                                             | RAJ PAL SINGH     |           |
| T.L.                   |                                             | H.D. VIDJAK       |           |

STAMP



A AS-BUILT DRAWING  
TR. Ref.:.....  
ENGINEER Sign.:.....

EMPLOYER (DFCCIL): DEDICATED FREIGHT CORRIDOR CORPORATION OF INDIA LTD.

AS BUILT DRAWING

|                                   |                           |
|-----------------------------------|---------------------------|
| TITLE                             | DFCC APPR. NO. -          |
| AS-BUILT PLAN AND PROFILE         | ENGG. APPR. NO. -         |
| FROM IR KM: 356.500 TO 357.000    | DRG. NO. :301-2/AL/A/1339 |
| FROM DFC KM: 1247.378 TO 1247.878 | SHEET NO. : 1 OF 1        |
|                                   | DATE : 21.10.2024         |
|                                   | STATUS                    |
|                                   | A                         |

TR.

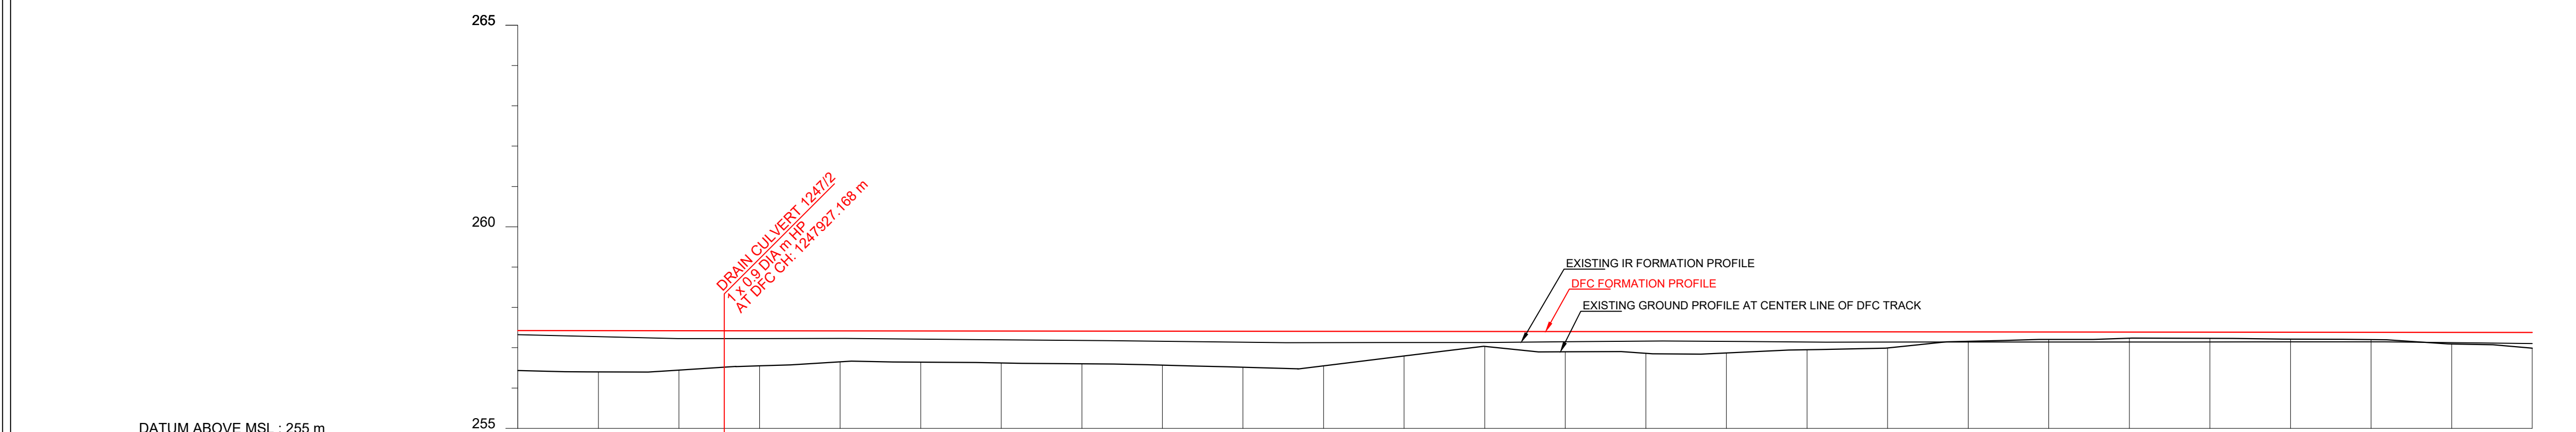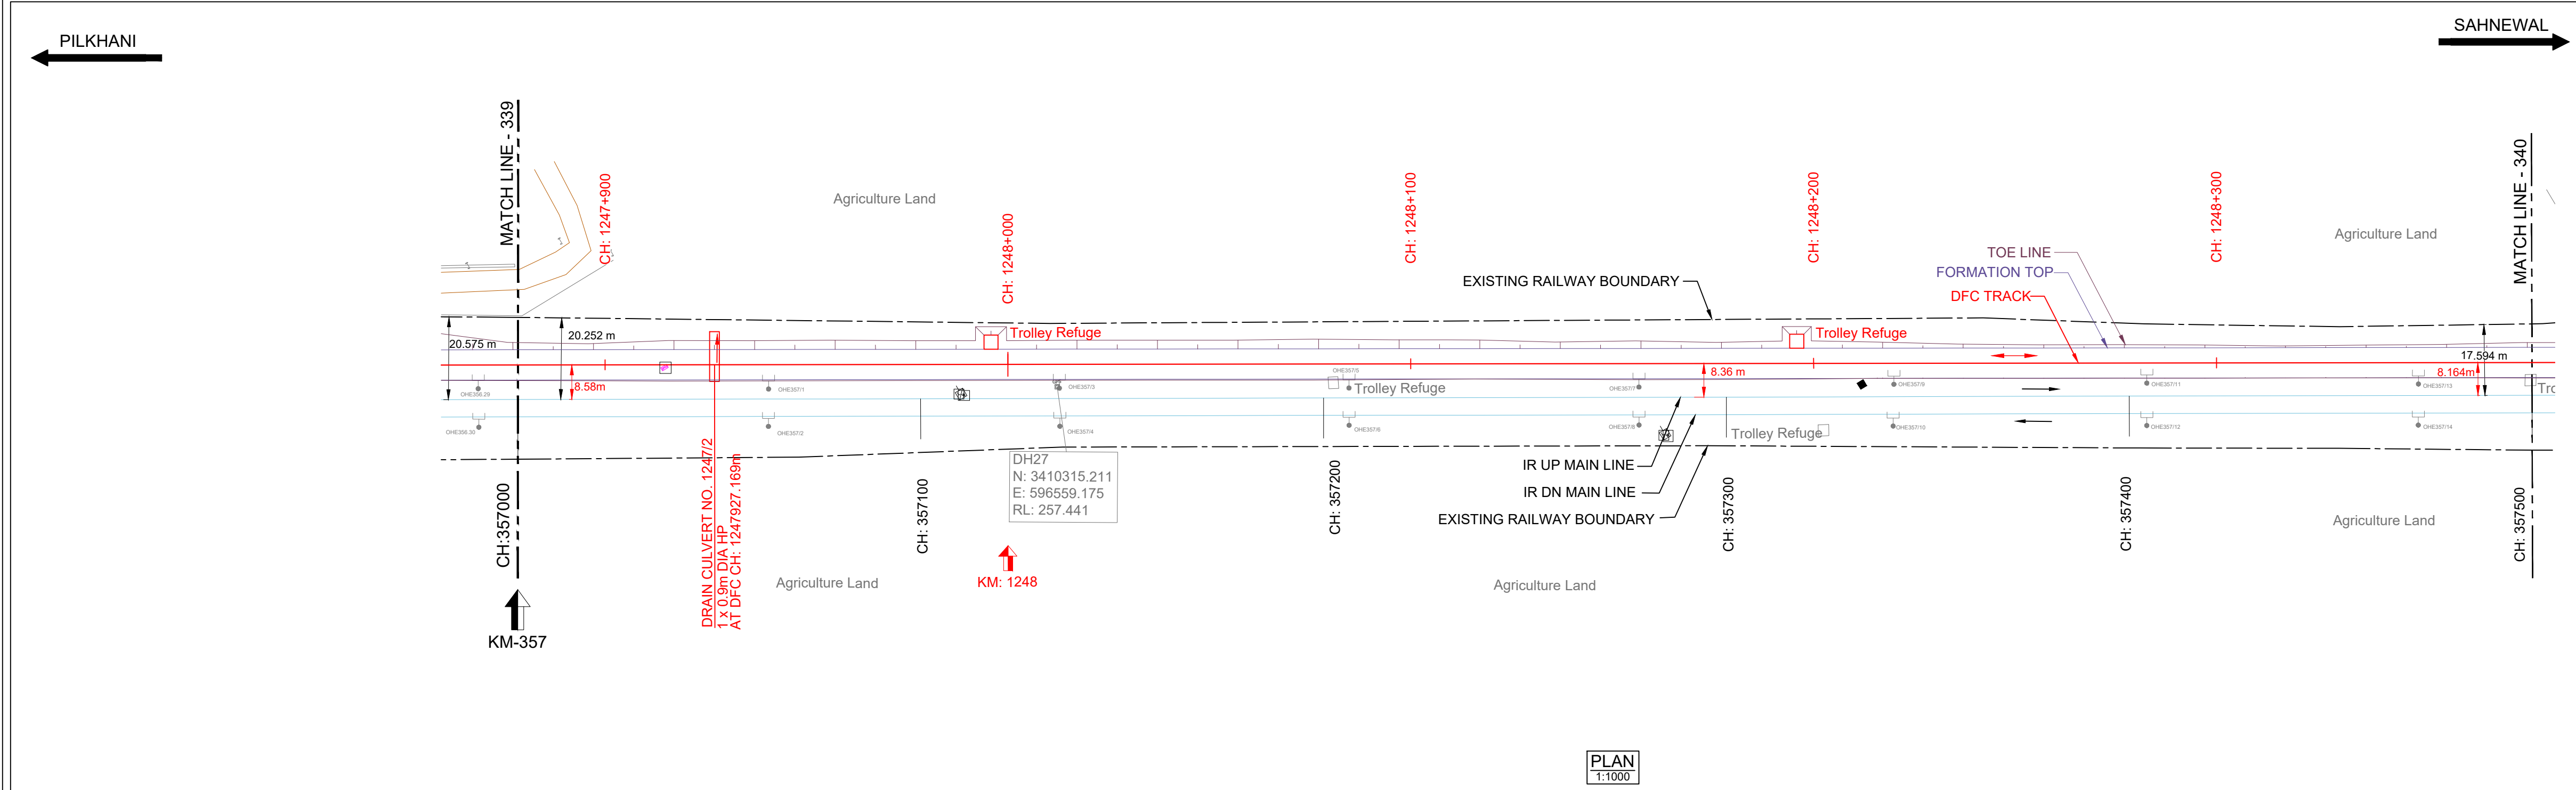

|                                                                          |                                    |--------------------------------------------------------------------------|------------------------------------|-----------|-----------|-----------|-----------|-----------|-----------|-----------|-----------|-----------|-----------|-----------|-----------|-----------|-----------|-----------|-----------|-----------|-----------|-----------|
| HORIZONTAL ALIGNMENT                                                     | L = 5018.785m                      |           |           |           |           |           |           |           |           |           |           |           |           |           |           |           |           |           |           |           |
| VERTICAL ALIGNMENT                                                       | L = 1490.145 m<br>1 IN 11127.847 F |           |           |           |           |           |           |           |           |           |           |           |           |           |           |           |           |           |           |           |
| TRACK DISTANCE FROM EXISTING NEAREST IR UP MAIN LINE TO DFC MAIN LINE    | 8.594                              | 8.572     | 8.551     | 8.552     | 8.554     | 8.544     | 8.535     | 8.526     | 8.498     | 8.461     | 8.438     | 8.429     | 8.420     | 8.396     | 8.372     | 8.353     | 8.335     | 8.307     | 8.279     | 8.253     |
| HEIGHT OF BANKING(+) / DEPTH OF CUTTING(-) (PFL-GL)                      | +0.989                             | +1.022    | +0.975    | +0.868    | +0.767    | +0.773    | +0.791    | +0.809    | +0.842    | +0.892    | +0.855    | +0.610    | +0.370    | +0.503    | +0.540    | +0.526    | +0.447    | +0.399    | +0.232    | +0.184    |
| EXG GROUND LEVEL AT CENTER LINE OF DFC TRACK (GL)                        | 256.436                            | 256.401   | 256.446   | 256.552   | 256.651   | 256.643   | 256.623   | 256.603   | 256.569   | 256.517   | 256.552   | 256.795   | 257.033   | 256.899   | 256.860   | 256.872   | 256.949   | 256.995   | 257.213   | 257.201   |
| EXG GROUND LEVEL AT TOE LOCATION OF DFC TRACK                            | 256.452                            | 256.490   | 256.188   | 256.225   | 256.188   | 256.252   | 256.255   | 256.200   | 256.213   | 256.209   | 256.056   | 256.192   | 256.229   | 256.513   | 256.376   | 256.552   | 256.345   | 256.563   | 257.044   | 257.018   |
| DIFFERENCE BETWEEN DFC FORMATION LEVEL AND EXG.FORMATION LEVEL (PFL-EFL) | 0.103                              | 0.150     | 0.196     | 0.193     | 0.189     | 0.202     | 0.217     | 0.231     | 0.250     | 0.271     | 0.280     | 0.276     | 0.272     | 0.255     | 0.238     | 0.243     | 0.253     | 0.254     | 0.252     | 0.239     |
| DFC FORMATION LEVEL (PFL)                                                | 257.425                            | 257.423   | 257.421   | 257.420   | 257.418   | 257.416   | 257.414   | 257.412   | 257.411   | 257.409   | 257.407   | 257.405   | 257.403   | 257.402   | 257.398   | 257.396   | 257.394   | 257.394   | 257.393   | 257.385   |
| EXG. FORMATION LEVEL OF EXG IR UP MAIN LINE (EFL)                        | 257.322                            | 257.273   | 257.225   | 257.227   | 257.229   | 257.214   | 257.197   | 257.181   | 257.161   | 257.138   | 257.127   | 257.129   | 257.131   | 257.147   | 257.162   | 257.155   | 257.143   | 257.140   | 257.141   | 257.146   |
| DIFFERENCE BETWEEN DFC RAIL LEVEL AND EXG. RAIL LEVEL (PRL - ERL)        | 0.144                              | 0.191     | 0.238     | 0.233     | 0.229     | 0.243     | 0.258     | 0.273     | 0.281     | 0.312     | 0.321     | 0.317     | 0.314     | 0.296     | 0.279     | 0.284     | 0.295     | 0.295     | 0.296     | 0.281     |
| DFC RAIL LEVEL (PRL)                                                     | 258.138                            | 258.136   | 258.134   | 258.133   | 258.131   | 258.129   | 258.127   | 258.125   | 258.124   | 258.122   | 258.120   | 258.118   | 258.116   | 258.115   | 258.113   | 258.111   | 258.109   | 258.107   | 258.106   | 258.098   |
| EXG.RAIL LEVEL OF NEAREST IR UP MAIN LINE(ERL)                           | 257.994                            | 257.945   | 257.897   | 257.899   | 257.901   | 257.886   | 257.889   | 257.853   | 257.833   | 257.810   | 257.799   | 257.801   | 257.803   | 257.819   | 257.834   | 257.827   | 257.815   | 257.812   | 257.813   | 257.818   |
| EQUIVALENT CHAINAGE ON DFC TRACK                                         | 1247877.8                          | 1247897.7 | 1247917.7 | 1247937.7 | 1247957.7 | 1247977.7 | 1247997.7 | 1248017.7 | 1248037.7 | 1248057.7 | 1248077.7 | 1248097.7 | 1248117.7 | 1248137.7 | 1248157.7 | 1248177.7 | 1248197.7 | 1248217.7 | 1248237.7 | 1248257.7 |
| EXISTING IR CHAINAGE                                                     | 357000.0                           | 357020.0  | 357040.0  | 357060.0  | 357080.0  | 357100.0  | 357120.0  | 357140.0  | 357160.0  | 357180.0  | 357200.0  | 357220.0  | 357240.0  | 357260.0  | 357280.0  | 357300.0  | 357320.0  | 357340.0  | 357360.0  | 357380.0  |

NOTE:-

- DFCC WORKS ARE SHOWN IN RED.
- IR NEW WORKS ARE SHOWN IN VIOLET.
- ALL DIMENSIONS ARE SHOWN IN METRES.
- THIS DRAWING IS PREPARED BASED ON LATEST SURVEY DATA HELD ON APRIL-2022. GTS BENCH MARK OF 261.850M CONSIDERED ON TOP OF CANAL BRIDGE ABUTMENT AT DORANA VILLAGE ALONG THE NH1.
- DFC NEW CHAINAGE OF 1075.950M IS WITH REFERENCE TO THE IR KM OF 187.500KM END OF KM OF CP-303(SECTION P-3 PILKHANI END) AGAINST THE EXISTING DFC CHAINAGE. 116277.742M ISSUED VIDE LETTER NO. COM/DFCC/UM/SURVEY/2021-301-230116-011173 DT. 17.01.2023.
- BALLAST PROFILE HAS BEEN PROVIDED ACCORDING TO THE CLAUSE 1.11.3 OF STANDARD SCHEDULE OF DIMENSION(EASTERN CORRIDOR) & THE BALLAST CUSHION DIMENSION SHOWN IN 35CM ON GE-14 PARA 17. SPECIFICATIONS & RECOMMENDATIONS 2. TWO LAYER SYSTEM FIG.10.

REFERENCE DRAWINGS :-

- FOR KEY PLAN REFER DRAWING NO. 301-2/AL/0001
- FOR LEGEND AND ABBREVIATIONS REFER DRAWING NO. 301-2/AL/1000
- FOR TYPICAL SECTION OF BALLAST PROFILE (FL-RL) REFER DRG. NO. 301-2/TK/TFDI-004 (TR.1952)

LEGEND:

IR TRACK  
DFCC TRACK  
DFCC FUTURE PROPOSALS  
STRUCTURE / BUILDING  
DFCC TOE LINE  
DFCC FORMATION  
RETAINING WALL  
ROAD  
STREAM, DRAIN, NALA, CANAL.  
FENCE  
POWER LINES  
TBM  
ELECTRIC POLE/OHE MAST  
IR RAILWAY BOUNDARY  
DFCC BOUNDARY

SCALE

HOR - 1:1000  
VER - 1:100  
SHEET SIZE : A1

TYPICAL SECTION

| TRACK STRUCTURE                                                                            |                                                |       |
|--------------------------------------------------------------------------------------------|------------------------------------------------|-------|
| RAIL SECTION: 60Kg/m (UIC 60Kg/m)<br>DFC LINE: 60Kg/m (UIC 60Kg/m)<br>IR MAIN LINE: 52Kg/m | Difference between<br>FL- RL (Below Rail Seat) |       |
|                                                                                            | IR Line                                        | DFC   |
|                                                                                            | 172mm                                          | 172mm |
| RUBBER PAD                                                                                 | 6mm                                            | 10mm  |
| SLEEPER DEPTH                                                                              | 210mm                                          | 210mm |
| BALLAST CUSHION                                                                            | 300mm                                          | 350mm |
| Total Depth (FL TO RL)                                                                     | 688mm                                          | 742mm |

OWNER

DEDICATED FREIGHT CORRIDOR CORPORATION OF INDIA LTD.  
(A GOVERNMENT OF INDIA ENTERPRISE)  
PROJECT OFFICE (AMBALA UNIT): OLD RAILWAY COLONY (NEAR ANAND MARKET), AMBALA CANTT-133001.  
CORPORATE IDENTITY NO. : U60232DL2006GGI155068

ENGINEER:

DB Engineering & Consulting GmbH  
Deutsche Bahn Engineering & Consulting GmbH

CONTRACTOR:

GIL - TPL JV  
GAR TATA

| SUBMITTED BY           | GIL - TPL JV                                |                   |           |
|------------------------|---------------------------------------------|-------------------|-----------|
|                        | DATED                                       | NAME              | SIGNATURE |
| PREPARED BY            |                                             |                   |           |
| CHECKED BY             | 21.10.2024                                  | VIJAY PRATAP      |           |
| APPROVED BY            | 21.10.2024                                  | PARASURAM KOTYADA |           |
| APPROVED BY            | DEUTSCHE BAHN ENGINEERING & CONSULTING GMBH |                   |           |
|                        | DATED                                       | NAME              | SIGNATURE |
| Sr. DE./CHIEF ENGINEER |                                             | SURESH K.YALANGI  |           |
| CHIEF TRACK ENGINEER   |                                             | RAJ PAL SINGH     |           |
| T.L.                   |                                             | H.D. VIDJAK       |           |

STAMP

A AS-BUILT DRAWING  
TR. Ref.:.....  
ENGINEER Sign.:.....

EMPLOYER (DFCCIL): DEDICATED FREIGHT CORRIDOR CORPORATION OF INDIA LTD.

AS BUILT DRAWING

TITLE



AS-BUILT PLAN AND PROFILE

FROM IR KM: 357.000 TO 357.500  
FROM DFC KM: 1247.878 TO 1248.378

DFCC APPR. NO. -  
ENGG. APPR. NO. -  
DRG. NO. :301-2/AL/A/1340  
SHEET NO. :1 OF 1  
DATE : 21.10.2024

STATUS  
A

TR.

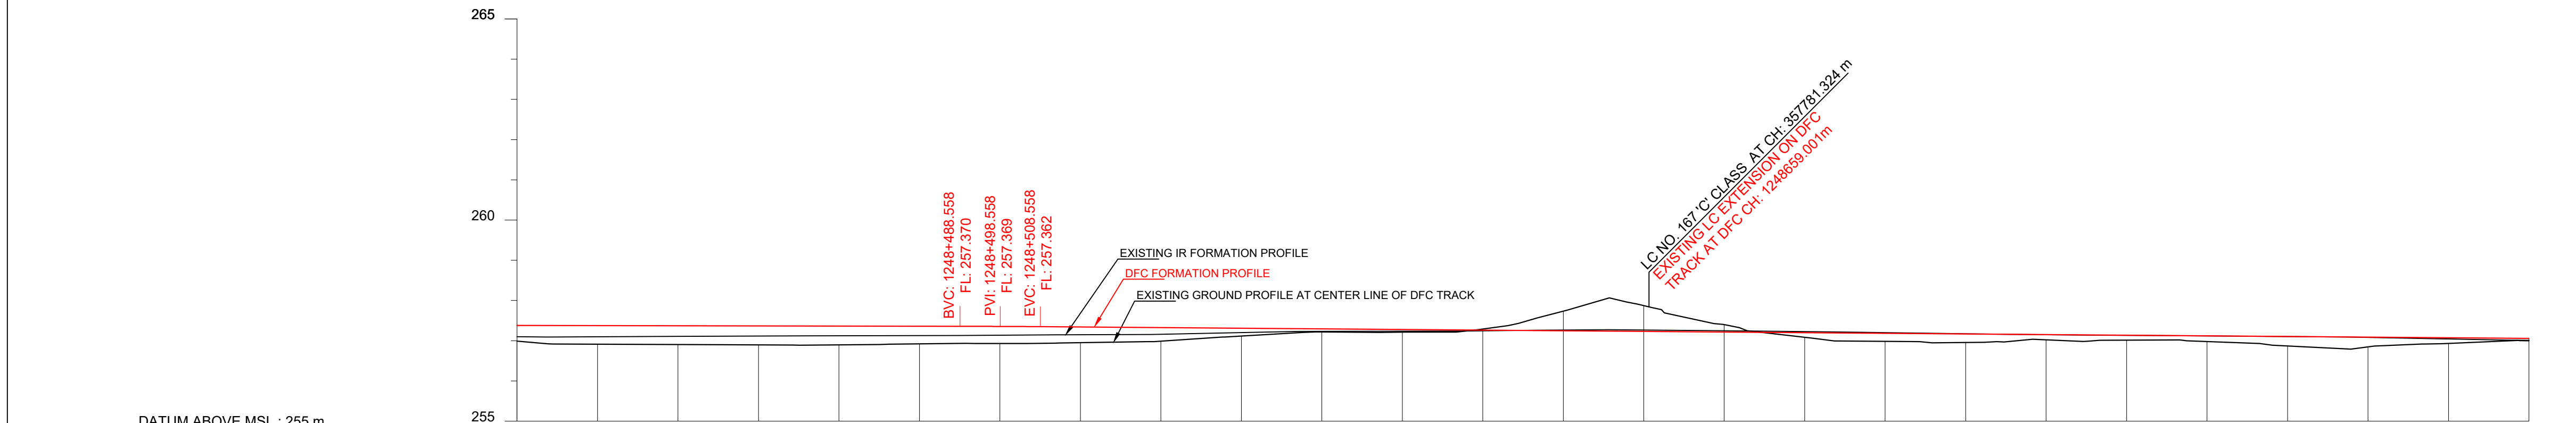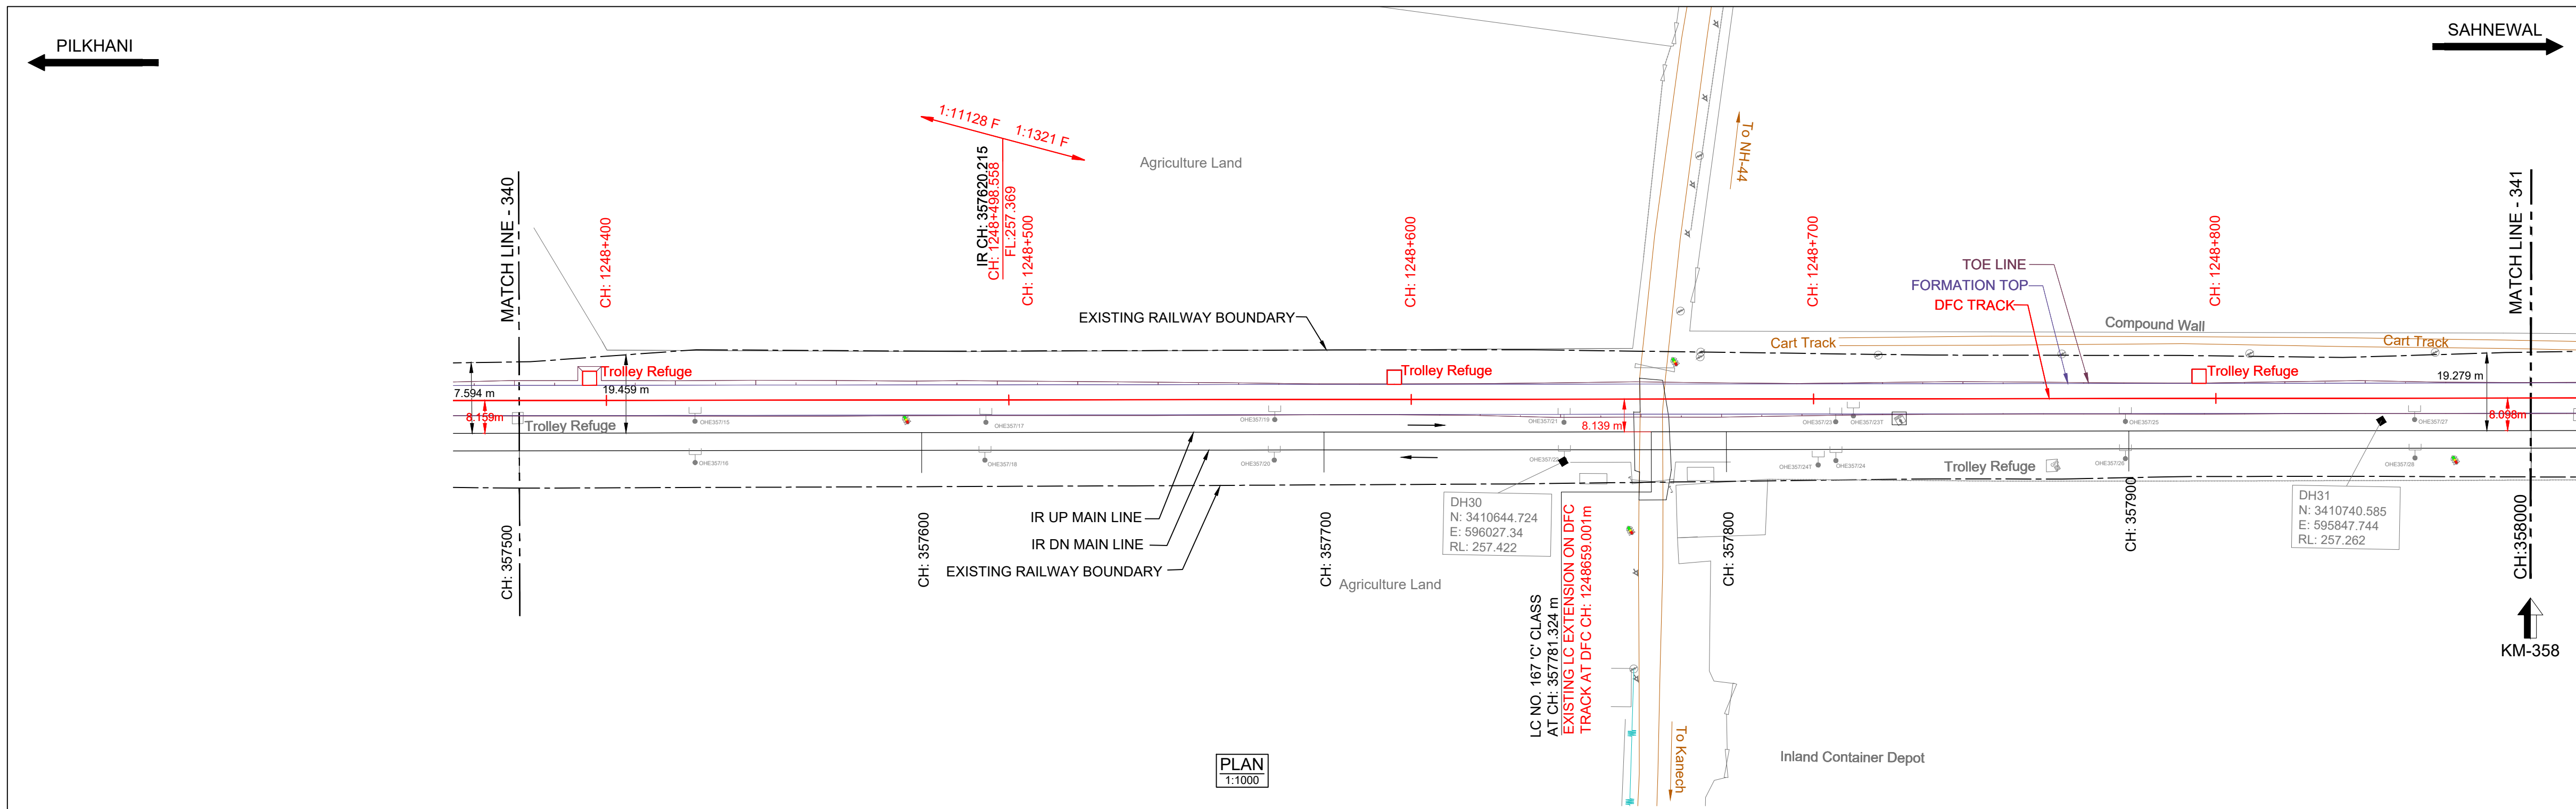

DATUM ABOVE MSL : 255 m

| HORIZONTAL ALIGNMENT                                                     | L = 5018.785m                                                                              |           |           |           |           |           |           |           |           |           |           |           |           |           |           |           |           |           |           |           |
|--------------------------------------------------------------------------|--------------------------------------------------------------------------------------------|-----------|-----------|-----------|-----------|-----------|-----------|-----------|-----------|-----------|-----------|-----------|-----------|-----------|-----------|-----------|-----------|-----------|-----------|-----------|
| VERTICAL ALIGNMENT                                                       | L=1480.145 m<br>1 IN 11127.847 F<br>L=20.0 m<br>R=32953 m<br>L=1180.0 m<br>1 IN 1321.389 F |           |           |           |           |           |           |           |           |           |           |           |           |           |           |           |           |           |           |           |
| TRACK DISTANCE FROM EXISTING NEAREST IR UP MAIN LINE TO DFC MAIN LINE    | 8.145                                                                                      | 8.131     | 8.123     | 8.115     | 8.107     | 8.098     | 8.091     | 8.086     | 8.082     | 8.089     | 8.096     | 8.106     | 8.118     | 8.137     | 8.140     | 8.122     | 8.104     | 8.091     | 8.082     | 8.074     |
| HEIGHT OF BANKING(+) / DEPTH OF CUTTING(-) (PFL-GL)                      | +0.391                                                                                     | +0.466    | +0.472    | +0.478    | +0.476    | +0.448    | +0.438    | +0.403    | +0.352    | +0.207    | +0.091    | +0.081    | +0.012    | -0.473    | -0.023    | -0.169    | -0.133    | +0.220    | +0.231    | +0.150    |
| EXG GROUND LEVEL AT CENTER LINE OF DFC TRACK (GL)                        | 256.989                                                                                    | 256.912   | 256.904   | 256.896   | 256.897   | 256.922   | 256.932   | 256.951   | 256.987   | 257.118   | 257.218   | 257.213   | 257.291   | 257.737   | 257.871   | 257.403   | 257.086   | 256.984   | 256.957   | 257.022   |
| EXG GROUND LEVEL AT TOE LOCATION OF DFC TRACK                            | 256.674                                                                                    | 256.666   | 256.734   | 256.672   | 256.721   | 256.790   | 256.800   | 256.867   | 256.950   | 257.042   | 257.143   | 257.140   | 257.333   | 257.495   | 257.732   | 257.334   | 257.072   | 256.966   | 256.945   | 256.960   |
| DIFFERENCE BETWEEN DFC FORMATION LEVEL AND EXG.FORMATION LEVEL.(PFL-EFL) | 0.278                                                                                      | 0.279     | 0.268     | 0.257     | 0.248     | 0.242     | 0.232     | 0.206     | 0.179     | 0.122     | 0.075     | 0.057     | 0.034     | -0.001    | -0.017    | -0.014    | -0.010    | 0.000     | 0.013     | 0.022     |
| DFC FORMATION LEVEL (PFL)                                                | 257.380                                                                                    | 257.378   | 257.376   | 257.375   | 257.373   | 257.371   | 257.369   | 257.355   | 257.339   | 257.324   | 257.309   | 257.294   | 257.279   | 257.264   | 257.249   | 257.233   | 257.218   | 257.203   | 257.188   | 257.173   |
| EXG. FORMATION LEVEL OF EXG IR UP MAIN LINE (EFL)                        | 257.102                                                                                    | 257.099   | 257.109   | 257.117   | 257.125   | 257.129   | 257.138   | 257.148   | 257.160   | 257.203   | 257.234   | 257.237   | 257.245   | 257.265   | 257.266   | 257.247   | 257.228   | 257.203   | 257.175   | 257.151   |
| DIFFERENCE BETWEEN DFC RAIL LEVEL AND EXG. RAIL LEVEL (PRL - ERL)        | 0.319                                                                                      | 0.320     | 0.309     | 0.298     | 0.289     | 0.283     | 0.273     | 0.247     | 0.220     | 0.163     | 0.116     | 0.098     | 0.075     | 0.040     | 0.024     | 0.027     | 0.031     | 0.041     | 0.054     | 0.063     |
| DFC RAIL LEVEL (PRL)                                                     | 257.774                                                                                    | 257.771   | 257.781   | 257.789   | 257.797   | 257.801   | 257.810   | 257.820   | 257.832   | 257.875   | 257.906   | 257.909   | 257.917   | 257.937   | 257.938   | 257.919   | 257.923   | 257.875   | 257.847   | 257.823   |
| EXG.RAIL LEVEL OF NEAREST IR UP MAIN LINE(ERL)                           | 257.455                                                                                    | 257.451   | 257.461   | 257.469   | 257.477   | 257.481   | 257.490   | 257.500   | 257.512   | 257.555   | 257.586   | 257.589   | 257.597   | 257.617   | 257.618   | 257.599   | 257.603   | 257.555   | 257.527   | 257.503   |
| EQUIVALENT CHAINAGE ON DFC TRACK                                         | 1248377.7                                                                                  | 1248397.7 | 1248417.7 | 1248437.7 | 1248457.7 | 1248477.7 | 1248497.7 | 1248517.7 | 1248537.7 | 1248557.7 | 1248577.7 | 1248597.7 | 1248617.7 | 1248637.7 | 1248657.7 | 1248677.7 | 1248697.7 | 1248717.7 | 1248737.7 | 1248757.7 |
| EXISTING IR CHAINAGE                                                     | 357500.0                                                                                   | 357520.0  | 357540.0  | 357560.0  | 357580.0  | 357600.0  | 357620.0  | 357640.0  | 357660.0  | 357680.0  | 357700.0  | 357720.0  | 357740.0  | 357760.0  | 357780.0  | 357800.0  | 357820.0  | 357840.0  | 357860.0  | 357880.0  |

L - SECTION

NOTE:-  
1. DFC WORKS ARE SHOWN IN RED.  
2. IR NEW WORKS ARE SHOWN IN VIOLET.  
3. ALL DIMENSIONS ARE SHOWN IN METRES.  
4. THIS DRAWING IS PREPARED BASED ON LATEST SURVEY DATA HELD ON APRIL-2022. GTS BENCH MARK OF 261.850M CONSIDERED ON TOP OF CANAL BRIDGE ABUTMENT AT DORANA VILLAGE ALONG THE NH1.  
5. DFC NEW CHAINAGE OF 1075.950M IS WITH REFERENCE TO THE IR KM OF 187.500KM END OF KM OF CP-303(SECTION P-3 PILKHANI END) AGAINST THE EXISTING DFC CHAINAGE. 116277.742M ISSUED VIDE LETTER NO. COM/DFCC/UMBSURVEY/2021-301-230116-011173 DT. 17.01.2023.  
6. BALLAST PROFILE HAS BEEN PROVIDED ACCORDING TO THE CLAUSE 1.11.3 OF STANDARD SCHEDULE OF DIMENSION(EASTERN CORRIDOR) & THE BALLAST CUSHION DIMENSION SHOWN IN 35CM ON GE-14 PARA 17. SPECIFICATIONS & RECOMMENDATIONS 2. TWO LAYER SYSTEM FIG.10.


REFERENCE DRAWINGS :-  
1. FOR KEY PLAN REFER DRAWING NO. 301-2/AL/0001  
2. FOR LEGEND AND ABBREVIATIONS REFER DRAWING NO. 301-2/AL/1000  
3. FOR TYPICAL SECTION OF BALLAST PROFILE (FL-RL) REFER DRG. NO. 301-2/TK/TFD/-004 (TR.1952)

| REV. | DATE       | REVISION DETAILS               | PURPOSE OF ISSUE |
|------|------------|--------------------------------|------------------|
| 0    | 21.10.2024 | SUBMISSION OF AS-BUILT DRAWING | FOR APPROVAL     |

LEGEND:

IR TRACK  
DFCC TRACK  
DFCC FUTURE PROPOSALS  
STRUCTURE / BUILDING  
DFCC TOE LINE  
DFCC FORMATION  
RETAINING WALL  
ROAD  
STREAM, DRAIN, NALA, CANAL.  
FENCE  
POWER LINES  
TBM  
ELECTRIC POLE/OHE MAST  
IR RAILWAY BOUNDARY  
DFCC BOUNDARY

SCALE  
HOR - 1:1000  
VER - 1:100  
SHEET SIZE - A1

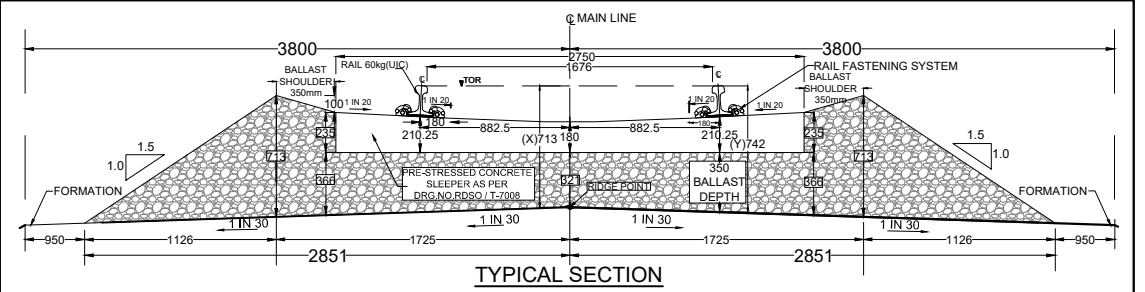

| TRACK STRUCTURE                                                                            |                                             |       |
|--------------------------------------------------------------------------------------------|---------------------------------------------|-------|
| RAIL SECTION: 60Kg/m (UIC 60Kg/m)<br>DFC LINE: 60Kg/m (UIC 60Kg/m)<br>IR MAIN LINE: 52Kg/m | Difference between FL- RL (Below Rail Seat) |       |
|                                                                                            | IR Line                                     | DFC   |
| RUBBER PAD                                                                                 | 172mm                                       | 172mm |
| SLEEPER DEPTH                                                                              | 6mm                                         | 10mm  |
| BALLAST CUSHION                                                                            | 210mm                                       | 210mm |
| Total Depth (FL TO RL)                                                                     | 300mm                                       | 350mm |

OWNER  
DEDICATED FREIGHT CORRIDOR CORPORATION OF INDIA LTD.  
(A GOVERNMENT OF INDIA ENTERPRISE)  
PROJECT OFFICE(AMBALA UNIT): OLD RAILWAY COLONY (NEAR ANAND MARKET),AMBALA CANTT.-133001.  
CORPORATE IDENTITY NO. : U60232DL2006GGI155068

ENGINEER:  
DB Engineering & Consulting GmbH  
Deutsche Bahn Engineering & Consulting GmbH

CONTRACTOR:  
GIL - TPL JV  
GAR TATA


| SUBMITTED BY | GIL - TPL JV                                |                   |           |
|--------------|---------------------------------------------|-------------------|-----------|
|              | DATED                                       | NAME              | SIGNATURE |
| PREPARED BY  | 21.10.2024                                  | VIJAY PRATAP      |           |
| CHECKED BY   | 21.10.2024                                  | PARASURAM KOTYADA |           |
| APPROVED BY  | DEUTSCHE BAHN ENGINEERING & CONSULTING GMBH |                   |           |


| APPROVED BY            | DATED | NAME             | SIGNATURE |
|------------------------|-------|------------------|-----------|
| Sr. DE./CHIEF ENGINEER |       | SURESH K.YALANGI |           |
| CHIEF TRACK ENGINEER   |       | RAJ PAL SINGH    |           |
| T.L.                   |       | H.D. VIDJAK      |           |

| STAMP              | A AS-BUILT DRAWING<br>TR. Ref.:.....<br>ENGINEER Sign.:..... |  |  |
|--------------------|--------------------------------------------------------------|--|--|
| EMPLOYER (DFCCIL): | DEDICATED FREIGHT CORRIDOR CORPORATION OF INDIA LTD.         |  |  |
|                    |                                                              |  |  |
|                    |                                                              |  |  |

| AS BUILT DRAWING                                                                                                  |                          |  |             |
|-------------------------------------------------------------------------------------------------------------------|--------------------------|--|-------------|
| TITLE<br><br>AS-BUILT PLAN AND PROFILE<br><br>FROM IR KM: 357.500 TO 358.000<br>FROM DFC KM: 1248.378 to 1248.878 | DFCC APPR. NO. -         |  |             |
|                                                                                                                   | ENGG APPR. NO. -         |  |             |
|                                                                                                                   | DRG. NO -301-2/AL/A/1341 |  |             |
|                                                                                                                   | SHEET NO. : 1 OF 1       |  |             |
|                                                                                                                   | DATE :21.10.2024         |  |             |
|                                                                                                                   |                          |  | STATUS<br>A |

TR.

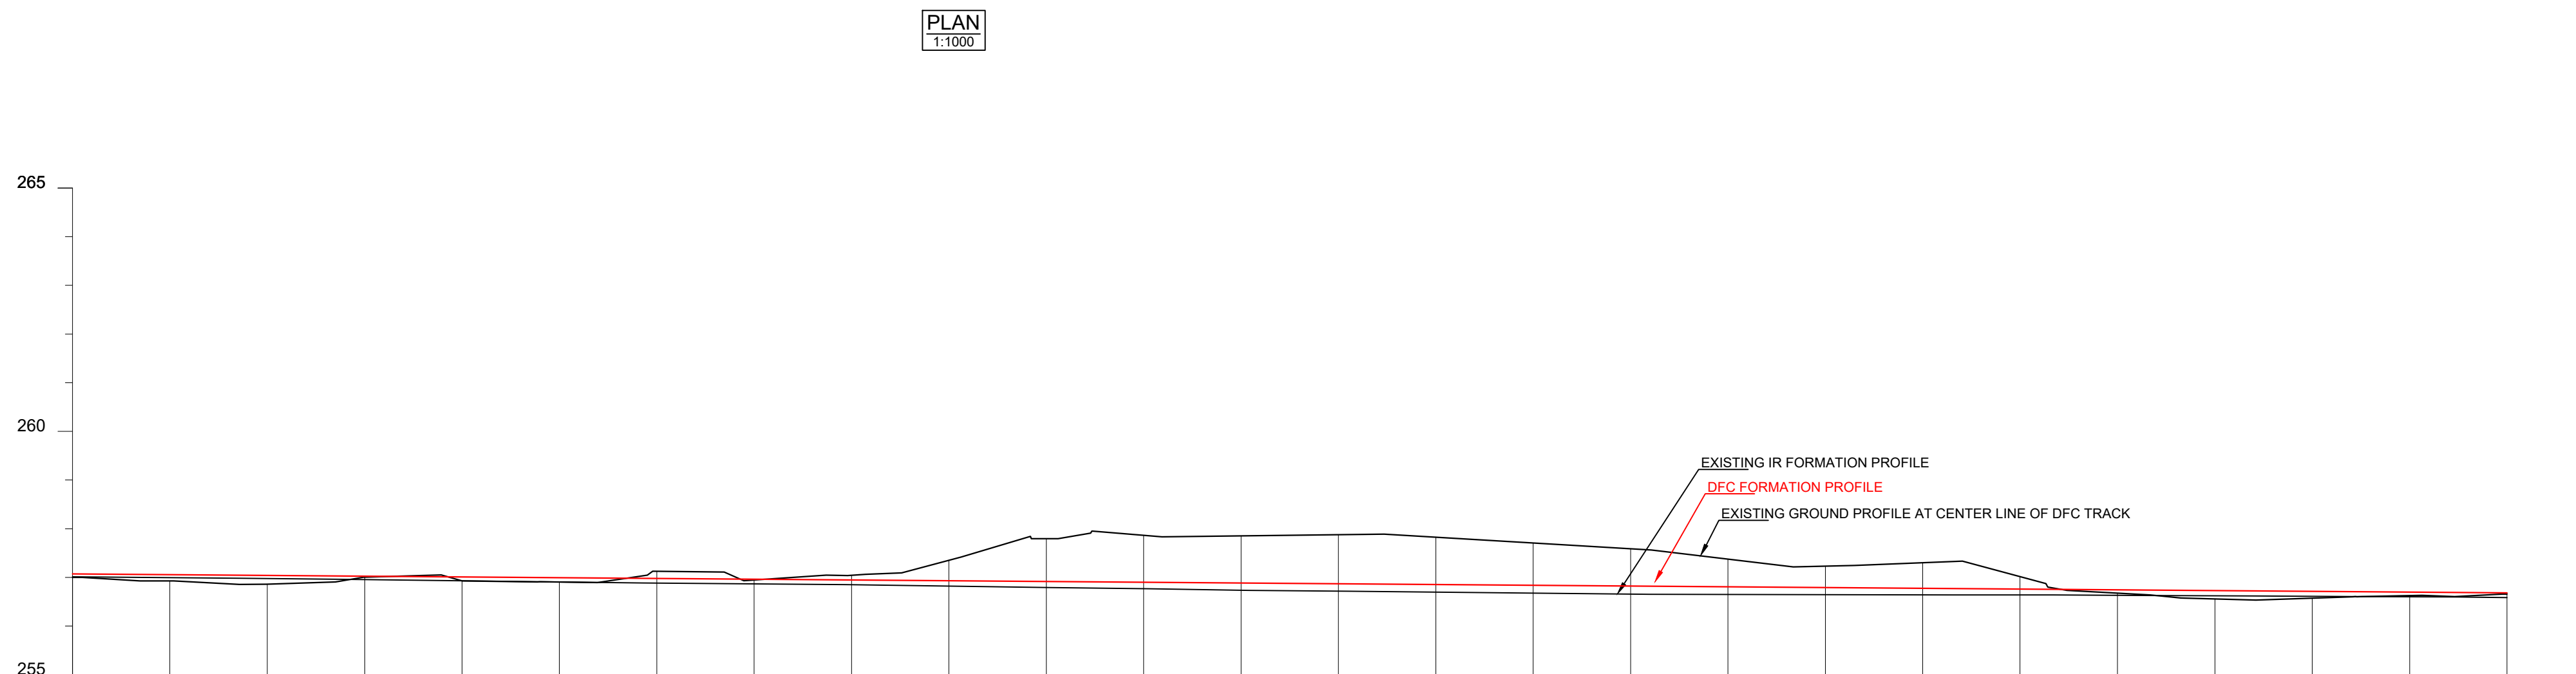
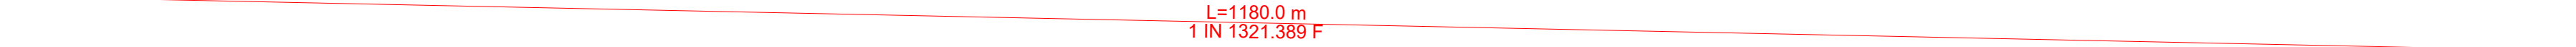
|                                                                         |                                                                                      |  |  |  |  |
|-------------------------------------------------------------------------|--------------------------------------------------------------------------------------|--|--|--|--|
| DATUM ABOVE MSL : 255 m                                                 |                                                                                      |  |  |  |  |
| 255                                                                     |                                                                                      |  |  |  |  |
| HORIZONTAL ALIGNMENT                                                    |  |  |  |  |  |
| VERTICAL ALIGNMENT                                                      |  |  |  |  |  |
| TRACK DISTANCE FROM EXISTING NEAREST IR UP MAIN LINE TO DFC MAIN LINE   | -8.097-                                                                              |  |  |  |  |
| HEIGHT OF BANKING(+) / DEPTH OF CUTTING(-) (PFL-GL)                     | +0.082-                                                                              |  |  |  |  |
| EXG GROUND LEVEL AT CENTER LINE OF DFC TRACK (GL)                       | 257.000-                                                                             |  |  |  |  |
| EXG GROUND LEVEL AT TOE LOCATION OF DFC TRACK                           | 256.949-                                                                             |  |  |  |  |
| DIFFERENCE BETWEEN DFC FORMATION LEVEL AND EXG FORMATION LEVEL(PFL-EFL) | 0.071-                                                                               |  |  |  |  |
| DFC FORMATION LEVEL (PFL)                                               | 257.082-                                                                             |  |  |  |  |
| EXG FORMATION LEVEL OF EXG IR UP MAIN LINE (EFL)                        | 257.011-                                                                             |  |  |  |  |
| DIFFERENCE BETWEEN DFC RAIL LEVEL AND EXG. RAIL LEVEL (PRL - ERL)       | -0.112-                                                                              |  |  |  |  |
| DFC RAIL LEVEL (PRL)                                                    | 257.795-                                                                             |  |  |  |  |
| EXG RAIL LEVEL OF NEAREST IR UP MAIN LINE(ERL)                          | 257.683-                                                                             |  |  |  |  |
| EQUIVALENT CHAINAGE ON DFC TRACK                                        | 1248897.6-                                                                           |  |  |  |  |
| EXISTING IR CHAINAGE                                                    | 358000.0-                                                                            |  |  |  |  |

|                                                                                                                                                                                                                                                                                                                                                                                                                                                                                                                                                                                                                                                                                                                                                                                                                                                                                                    |                          |
|----------------------------------------------------------------------------------------------------------------------------------------------------------------------------------------------------------------------------------------------------------------------------------------------------------------------------------------------------------------------------------------------------------------------------------------------------------------------------------------------------------------------------------------------------------------------------------------------------------------------------------------------------------------------------------------------------------------------------------------------------------------------------------------------------------------------------------------------------------------------------------------------------|--------------------------|
| NOTE:-                                                                                                                                                                                                                                                                                                                                                                                                                                                                                                                                                                                                                                                                                                                                                                                                                                                                                             | DRG NO - 301-2/AL/A/1342 |
| <p>1. DFFC WORKS ARE SHOWN IN <b>RED</b>.</p> <p>2. IR NEW WORKS ARE SHOWN IN <b>VIOLET</b>.</p> <p>3. ALL DIMENSIONS ARE SHOWN IN METRES.</p> <p>4. THIS DRAWING IS PREPARED BASED ON THE LATEST SURVEY DATA HELD ON APRIL-2022. GTS BENCH MARK OF 281.850M CONSIDERED ON TOP OF CANAL BRIDGE ABUTMENT AT DORAKA VILLAGE ALONG THE NH-1.</p> <p>5. PARALL PROFILE DIMENSION OF 1075.950M IS WITH REFERENCE TO THE IR KM OF 187.500 KM OF KM OF CP-303(SECTION 3 P.3)K/H/AND) AGAINST THE EXISTING DFC CHAINAGE 116277.742M (ISSUED VIDE LETTER NO. GM/CMDCC/CM/MB/SURVEY/2021-301-2301-16-011173 DT. 17.01.2023</p> <p>6. PARALL PROFILE HAS BEEN PROVIDED ACCORDING TO THE CLAUSE 111.3 OF STANDARD SCHEDULE OF CONDITIONS (EASTERN ZONE) OF THE NEW BAHAMUT CUSHION DIMENSION SHOWN IN 35CM ON GE-14.</p> <p>7. PARALL 177. SPECIFICATIONS &amp; RECOMMENDATIONS 2 TWO LAYER SYSTEM FIG.10.</p> |                          |

**REFERENCE DRAWINGS :-**

1. FOR KEY PLAN REFER DRAWING NO. 301-2/AL/0001
2. FOR LEGEND AND ABBREVIATIONS REFER DRAWING NO. 301-2/AL/1000
3. FOR TYPICAL SECTION OF BALLAST PROFILE (FL-RL) REFER DRG. NO. 301-2/TK/TFD/004 (TR.1952)

|      |            |                                |                  |
|------|------------|--------------------------------|------------------|
|      |            |                                |                  |
| 0    | 21.10.2024 | SUBMISSION OF AS-BUILT DRAWING | FOR APPROVAL     |
| REV. | DATE       | REVISION DETAILS               | PURPOSE OF ISSUE |

**SCALE**

HOR - 1:1000


VER - 1:100

SHEET SIZE : A1

**LEGEND:**

|                             |  |
|-----------------------------|--|
| IR TRACK                    |  |
| DFCC TRACK                  |  |
| DFCC FUTURE PROPOSALS       |  |
| STRUCTURE / BUILDING        |  |
| DFCC TOE LINE               |  |
| DFCC FORMATION              |  |
| RETAINING WALL              |  |
| ROAD                        |  |
| STREAM, DRAIN, NALA, CANAL, |  |
| FENCE                       |  |
| POWER LINES                 |  |
| TBM                         |  |
| ELECTRIC POLE/OHE MAST      |  |
| IR RAILWAY BOUNDARY         |  |
| DFCC BOUNDARY               |  |

NORTH  
DATE: 10/06/2020 BY: ARIYAN K

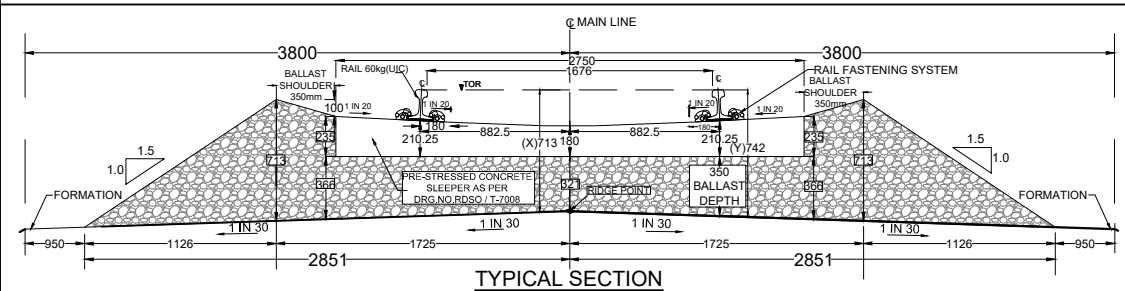

| TRACK STRUCTURE                                                                            |                                                |       |
|--------------------------------------------------------------------------------------------|------------------------------------------------|-------|
| RAIL SECTION: 60Kg/m (UIC 60Kg/m)<br>DFC LINE: 60kg/m (UIC 60Kg/m)<br>IR MAIN LINE: 52Kg/m | Difference between<br>FL- RL (Below Rail Seat) |       |
|                                                                                            | IR Line                                        | DFC   |
|                                                                                            | 172mm                                          | 172mm |
| RUBBER PAD                                                                                 | 6mm                                            | 10mm  |
| SLEEPER DEPTH                                                                              | 210mm                                          | 210mm |
| BALLAST CUSHION                                                                            | 300mm                                          | 350mm |
| Total Depth (FL TO RL)                                                                     | 688mm                                          | 742mm |

OWNER



डेडीकेड फ्रेट कोरिडोर

DEDICATED FREIGHT CORRIDOR CORPORATION OF INDIA LTD.  
(A GOVERNMENT OF INDIA ENTERPRISE)  
PROJECT OFFICE(AMBALA UNIT): OLD RAILWAY COLONY (NEAR  
ANAND MARKET),AMBALA CANTT-133001.  
CORPORATE IDENTITY No. : U60232DL2006GOI155068

ENGINEER:

 DB Engineering & Consulting GmbH  
Deutsche Bahn Engineering & Consulting GmbH

CONTRACTOR: GIL - TPL JV


|              |              |                   |           |
|--------------|--------------|-------------------|-----------|
| SUBMITTED BY | GIL - TPL JV |                   |           |
|              | DATED        | NAME              | SIGNATURE |
| PREPARED BY  |              |                   |           |
| CHECKED BY   | 21.10.2024   | VIJAY PRATAP      |           |
| APPROVED BY  | 21.10.2024   | PARASURAM KOTYADA |           |

| APPROVED BY            | DEUTSCHE BAHN ENGINEERING & CONSULTING GMBH |                  |           |
|------------------------|---------------------------------------------|------------------|-----------|
|                        | DATED                                       | NAME             | SIGNATURE |
| Sr. DE./CHIEF ENGINEER |                                             | SURESH K.YALANGI |           |
| CHIEF TRACK ENGINEER   |                                             | RAJ PAL SINGH    |           |
| T.L.                   |                                             | H.D. VIDJAK      |           |

|       |                                                                                                                                                                                                                                                                                                                                                                                                       |                                                     |  |
|-------|-------------------------------------------------------------------------------------------------------------------------------------------------------------------------------------------------------------------------------------------------------------------------------------------------------------------------------------------------------------------------------------------------------|-----------------------------------------------------|--|
| STAMP | <div style="border: 1px solid green; padding: 5px; display: inline-block;"> <div style="border: 1px solid green; padding: 5px; display: inline-block;"> <div style="border: 1px solid green; padding: 5px; display: inline-block;"> A </div> <div style="border: 1px solid green; padding: 5px; display: inline-block;"> AS-BUILT DRAWING<br/> TR. Ref.....<br/> ENGINEER Sign.: </div> </div> </div> |                                                     |  |
|       | EMPLOYER (DFCCIL):                                                                                                                                                                                                                                                                                                                                                                                    | DEDICATED FREIGHT CORRIDOR CORPORATION OF INDIA LTD |  |
|       |                                                                                                                                                                                                                                                                                                                                                                                                       |                                                     |  |

|                                                                                                                                                                                                                                     |                                                       |
|-------------------------------------------------------------------------------------------------------------------------------------------------------------------------------------------------------------------------------------|-------------------------------------------------------|
| <h1 style="text-align: center; border: 2px solid black; padding: 5px;">AS BUILT DRAWING</h1>                                                                                                                                        |                                                       |
| <p><b>TITLE</b></p> <p style="text-align: center;">AS-BUILT PLAN AND PROFILE</p> <p style="text-align: center;">FROM IR KM: 358.000 TO 358.500</p> <p style="text-align: center; color: red;">FROM DFC KM: 1248.878 to 1249.378</p> | DFCC APPR. NO. -                                      |
|                                                                                                                                                                                                                                     | ENGG. APPR. NO. -                                     |
|                                                                                                                                                                                                                                     | DRG. NO. -301-2/AL/A/1342                             |
|                                                                                                                                                                                                                                     | SHEET NO. : 1 of 1                                    |
|                                                                                                                                                                                                                                     | DATE : 21.10.2024                                     |
|                                                                                                                                                                                                                                     | <p><b>STATUS</b></p> <p style="font-size: 2em;">A</p> |

TR.

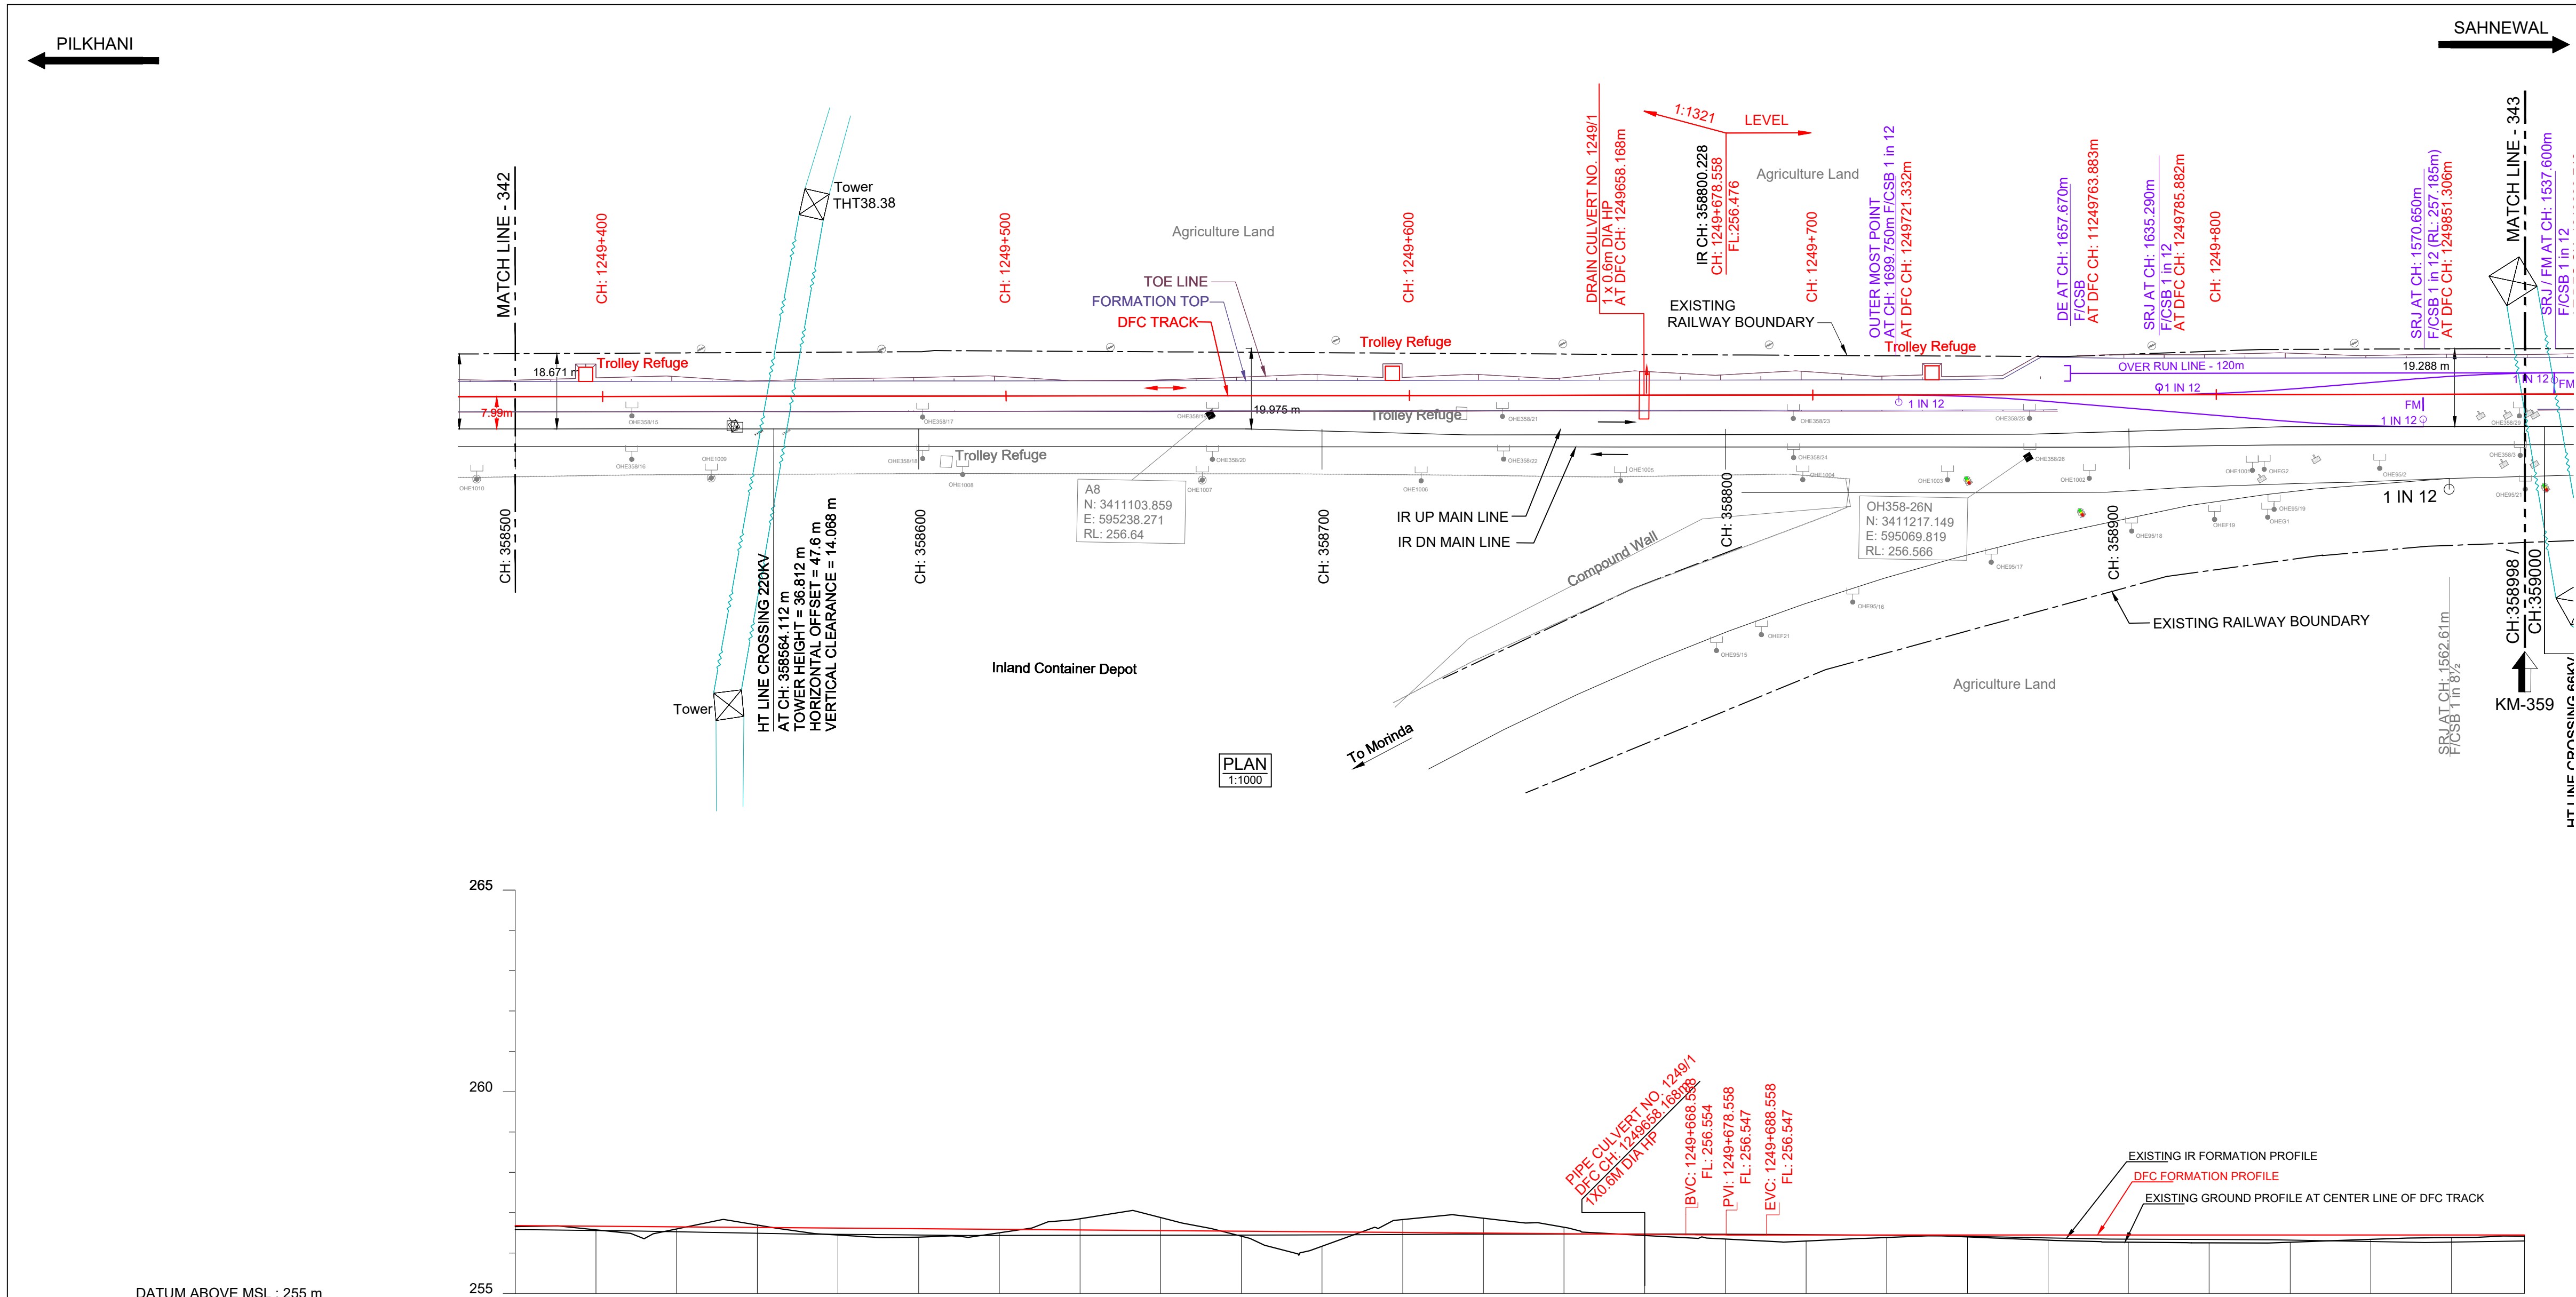

|                                                                          |  |--------------------------------------------------------------------------|--|-----------------------------------------------------------------------------------------|--|--|--|--|--|--|--|--|--|--|--|--|--|--|--|--|--|--|--|
| DRAINAGE                                                                 |  |                                                                                         | HORIZONTAL ALIGNMENT                                                     |  | L = 5018.785m                                                                           |  |  |  |  |  |  |  |  |  |  |  |  |  |  |  |  |  |  |  |
| VERTICAL ALIGNMENT                                                       |  | L=1180.0 m<br>1 IN 1321.389 F<br><br>L=20.0 m<br>R= :28703 m<br><br>L=447.272m<br>LEVEL |  |  |  |  |  |  |  |  |  |  |  |  |  |  |  |  |  |  |  |
| TRACK DISTANCE FROM EXISTING NEAREST IR UP MAIN LINE TO DFC MAIN LINE    |  | 7.994                                                                                   |  |  |  |  |  |  |  |  |  |  |  |  |  |  |  |  |  |  |  |
| HEIGHT OF BANKING(+) / DEPTH OF CUTTING(-) (PFL-GL)                      |  | +0.047                                                                                  |  |  |  |  |  |  |  |  |  |  |  |  |  |  |  |  |  |  |  |
| EXG GROUND LEVEL AT CENTER LINE OF DFC TRACK (GL)                        |  | 256.656                                                                                 |  |  |  |  |  |  |  |  |  |  |  |  |  |  |  |  |  |  |  |
| EXG GROUND LEVEL AT TOE LOCATION OF DFC TRACK                            |  | 256.559                                                                                 |  |  |  |  |  |  |  |  |  |  |  |  |  |  |  |  |  |  |  |
| DIFFERENCE BETWEEN DFC FORMATION LEVEL AND EXG.FORMATION LEVEL.(PFL-EFL) |  | 0.120                                                                                   |  |  |  |  |  |  |  |  |  |  |  |  |  |  |  |  |  |  |  |
| DFC FORMATION LEVEL (PFL)                                                |  | 256.704                                                                                 |  |  |  |  |  |  |  |  |  |  |  |  |  |  |  |  |  |  |  |
| EXG. FORMATION LEVEL OF EXG IR UP MAIN LINE (EFL)                        |  | 256.584                                                                                 |  |  |  |  |  |  |  |  |  |  |  |  |  |  |  |  |  |  |  |
| DIFFERENCE BETWEEN DFC RAIL LEVEL AND EXG. RAIL LEVEL (PRL - ERL)        |  | 0.161                                                                                   |  |  |  |  |  |  |  |  |  |  |  |  |  |  |  |  |  |  |  |
| DFC RAIL LEVEL (PRL)                                                     |  | 257.417                                                                                 |  |  |  |  |  |  |  |  |  |  |  |  |  |  |  |  |  |  |  |
| EXG.RAIL LEVEL OF NEAREST IR UP MAIN LINE(ERL)                           |  | 257.256                                                                                 |  |  |  |  |  |  |  |  |  |  |  |  |  |  |  |  |  |  |  |
| EQUIVALENT CHAINEGE ON DFC TRACK                                         |  | -1249377.7                                                                              |  |  |  |  |  |  |  |  |  |  |  |  |  |  |  |  |  |  |  |
| EXISTING IR CHAINEGE                                                     |  | 358500.0                                                                                |  |  |  |  |  |  |  |  |  |  |  |  |  |  |  |  |  |  |  |

L - SECTION

NOTE:-

- DFCC WORKS ARE SHOWN IN RED.
- IR NEW WORKS ARE SHOWN IN VIOLET.
- ALL DIMENSIONS ARE SHOWN IN METRES.
- THIS DRAWING IS PREPARED BASED ON LATEST SURVEY DATA HELD ON APRIL-2022. GTS BENCH MARK OF 261.850M CONSIDERED ON TOP OF CANAL BRIDGE ABUTMENT AT DORANA VILLAGE ALONG THE NH1.
- DFC NEW CHAINEGE OF 1075.950M IS WITH REFERENCE TO THE IR KM OF 187.500KM END OF KM OF CP-303(SECTION P-3 PILKHANI END) AGAINST THE EXISTING DFC CHAINEGE. 116277.742M ISSUED VIDE LETTER NO. COM/DFCC/UM/SURVEY/2021-301-230116-011173.DT. 17.01.2023.
- BALLAST PROFILE HAS BEEN PROVIDED ACCORDING TO THE CLAUSE 1.11.3 OF STANDARD SCHEDULE OF DIMENSION(EASTERN CORRIDOR) & THE BALLAST CUSHION DIMENSION SHOWN IN 35CM ON GE-14 PARA 17. SPECIFICATIONS & RECOMMENDATIONS 2. TWO LAYER SYSTEM FIG.10.

REFERENCE DRAWINGS :-

- FOR KEY PLAN REFER DRAWING NO. 301-2/AL/0001
- FOR LEGEND AND ABBREVIATIONS REFER DRAWING NO. 301-2/AL/1000
- FOR TYPICAL SECTION OF BALLAST PROFILE (FL-RL) REFER DRG. NO. 301-2/TK/TFD/004 (TR.1952)

LEGEND:

IR TRACK  
DFCC TRACK  
DFCC FUTURE PROPOSALS  
STRUCTURE / BUILDING  
DFCC TOE LINE  
DFCC FORMATION  
RETAINING WALL  
ROAD  
STREAM, DRAIN, NALA, CANAL.  
FENCE  
POWER LINES  
TBM  
ELECTRIC POLE/OHE MAST  
IR RAILWAY BOUNDARY  
DFCC BOUNDARY

SCALE

HOR - 1:1000

VER - 1:100

SHEET SIZE : A1

TYPICAL SECTION

| TRACK STRUCTURE                                                                            |                                                |       |
|--------------------------------------------------------------------------------------------|------------------------------------------------|-------|
| RAIL SECTION: 60Kg/m (UIC 60Kg/m)<br>DFC LINE: 60Kg/m (UIC 60Kg/m)<br>IR MAIN LINE: 52Kg/m | Difference between<br>FL- RL (Below Rail Seat) |       |
|                                                                                            | IR Line                                        | DFC   |
| RUBBER PAD                                                                                 | 172mm                                          | 172mm |
| SLEEPER DEPTH                                                                              | 6mm                                            | 10mm  |
| BALLAST CUSHION                                                                            | 210mm                                          | 210mm |
| Total Depth (FL TO RL)                                                                     | 300mm                                          | 350mm |

OWNER

DEDICATED FREIGHT CORRIDOR CORPORATION OF INDIA LTD.

(A GOVERNMENT OF INDIA ENTERPRISE)  
PROJECT OFFICE(AMBALA UNIT): OLD RAILWAY COLONY (NEAR ANAND MARKET),AMBALA CANTT-133001.  
CORPORATE IDENTITY NO. : U60232DL2006GGI155068

ENGINEER:

DB Engineering & Consulting GmbH  
Deutsche Bahn Engineering & Consulting GmbH

CONTRACTOR:

GIL - TPL JV

| SUBMITTED BY | GIL - TPL JV |                   |           |
|--------------|--------------|-------------------|-----------|
|              | DATED        | NAME              | SIGNATURE |
| PREPARED BY  |              |                   |           |
| CHECKED BY   | 21.10.2024   | VIJAY PRATAP      |           |
| APPROVED BY  | 21.10.2024   | PARASURAM KOTYADA |           |

| APPROVED BY            | DEUTSCHE BAHN ENGINEERING & CONSULTING GMBH |                  |           |
|------------------------|---------------------------------------------|------------------|-----------|
|                        | DATED                                       | NAME             | SIGNATURE |
| Sr. DE./CHIEF ENGINEER |                                             | SURESH K.YALANGI |           |
| CHIEF TRACK ENGINEER   |                                             | RAJ PAL SINGH    |           |
| T.L.                   |                                             | H.D. VIDJAK      |           |

STAMP


A AS-BUILT DRAWING  
TR. Ref.:.....  
ENGINEER Sign.:.....

EMPLOYER (DFCCIL): DEDICATED FREIGHT CORRIDOR CORPORATION OF INDIA LTD.

AS BUILT DRAWING

|                                   |                           |
|-----------------------------------|---------------------------|
| TITLE                             | DFCC APPR. NO. -          |
| AS-BUILT PLAN AND PROFILE         | ENG. APPR. NO. -          |
| FROM IR KM: 358.500 TO 359.000    | DRG. NO. -301-2/AL/A/1343 |
| FROM DFC KM: 1249.378 to 1249.876 | SHEET NO. : 1 OF 1        |
|                                   | DATE: 21.10.2024          |
|                                   | STATUS                    |
|                                   | A                         |

TR.

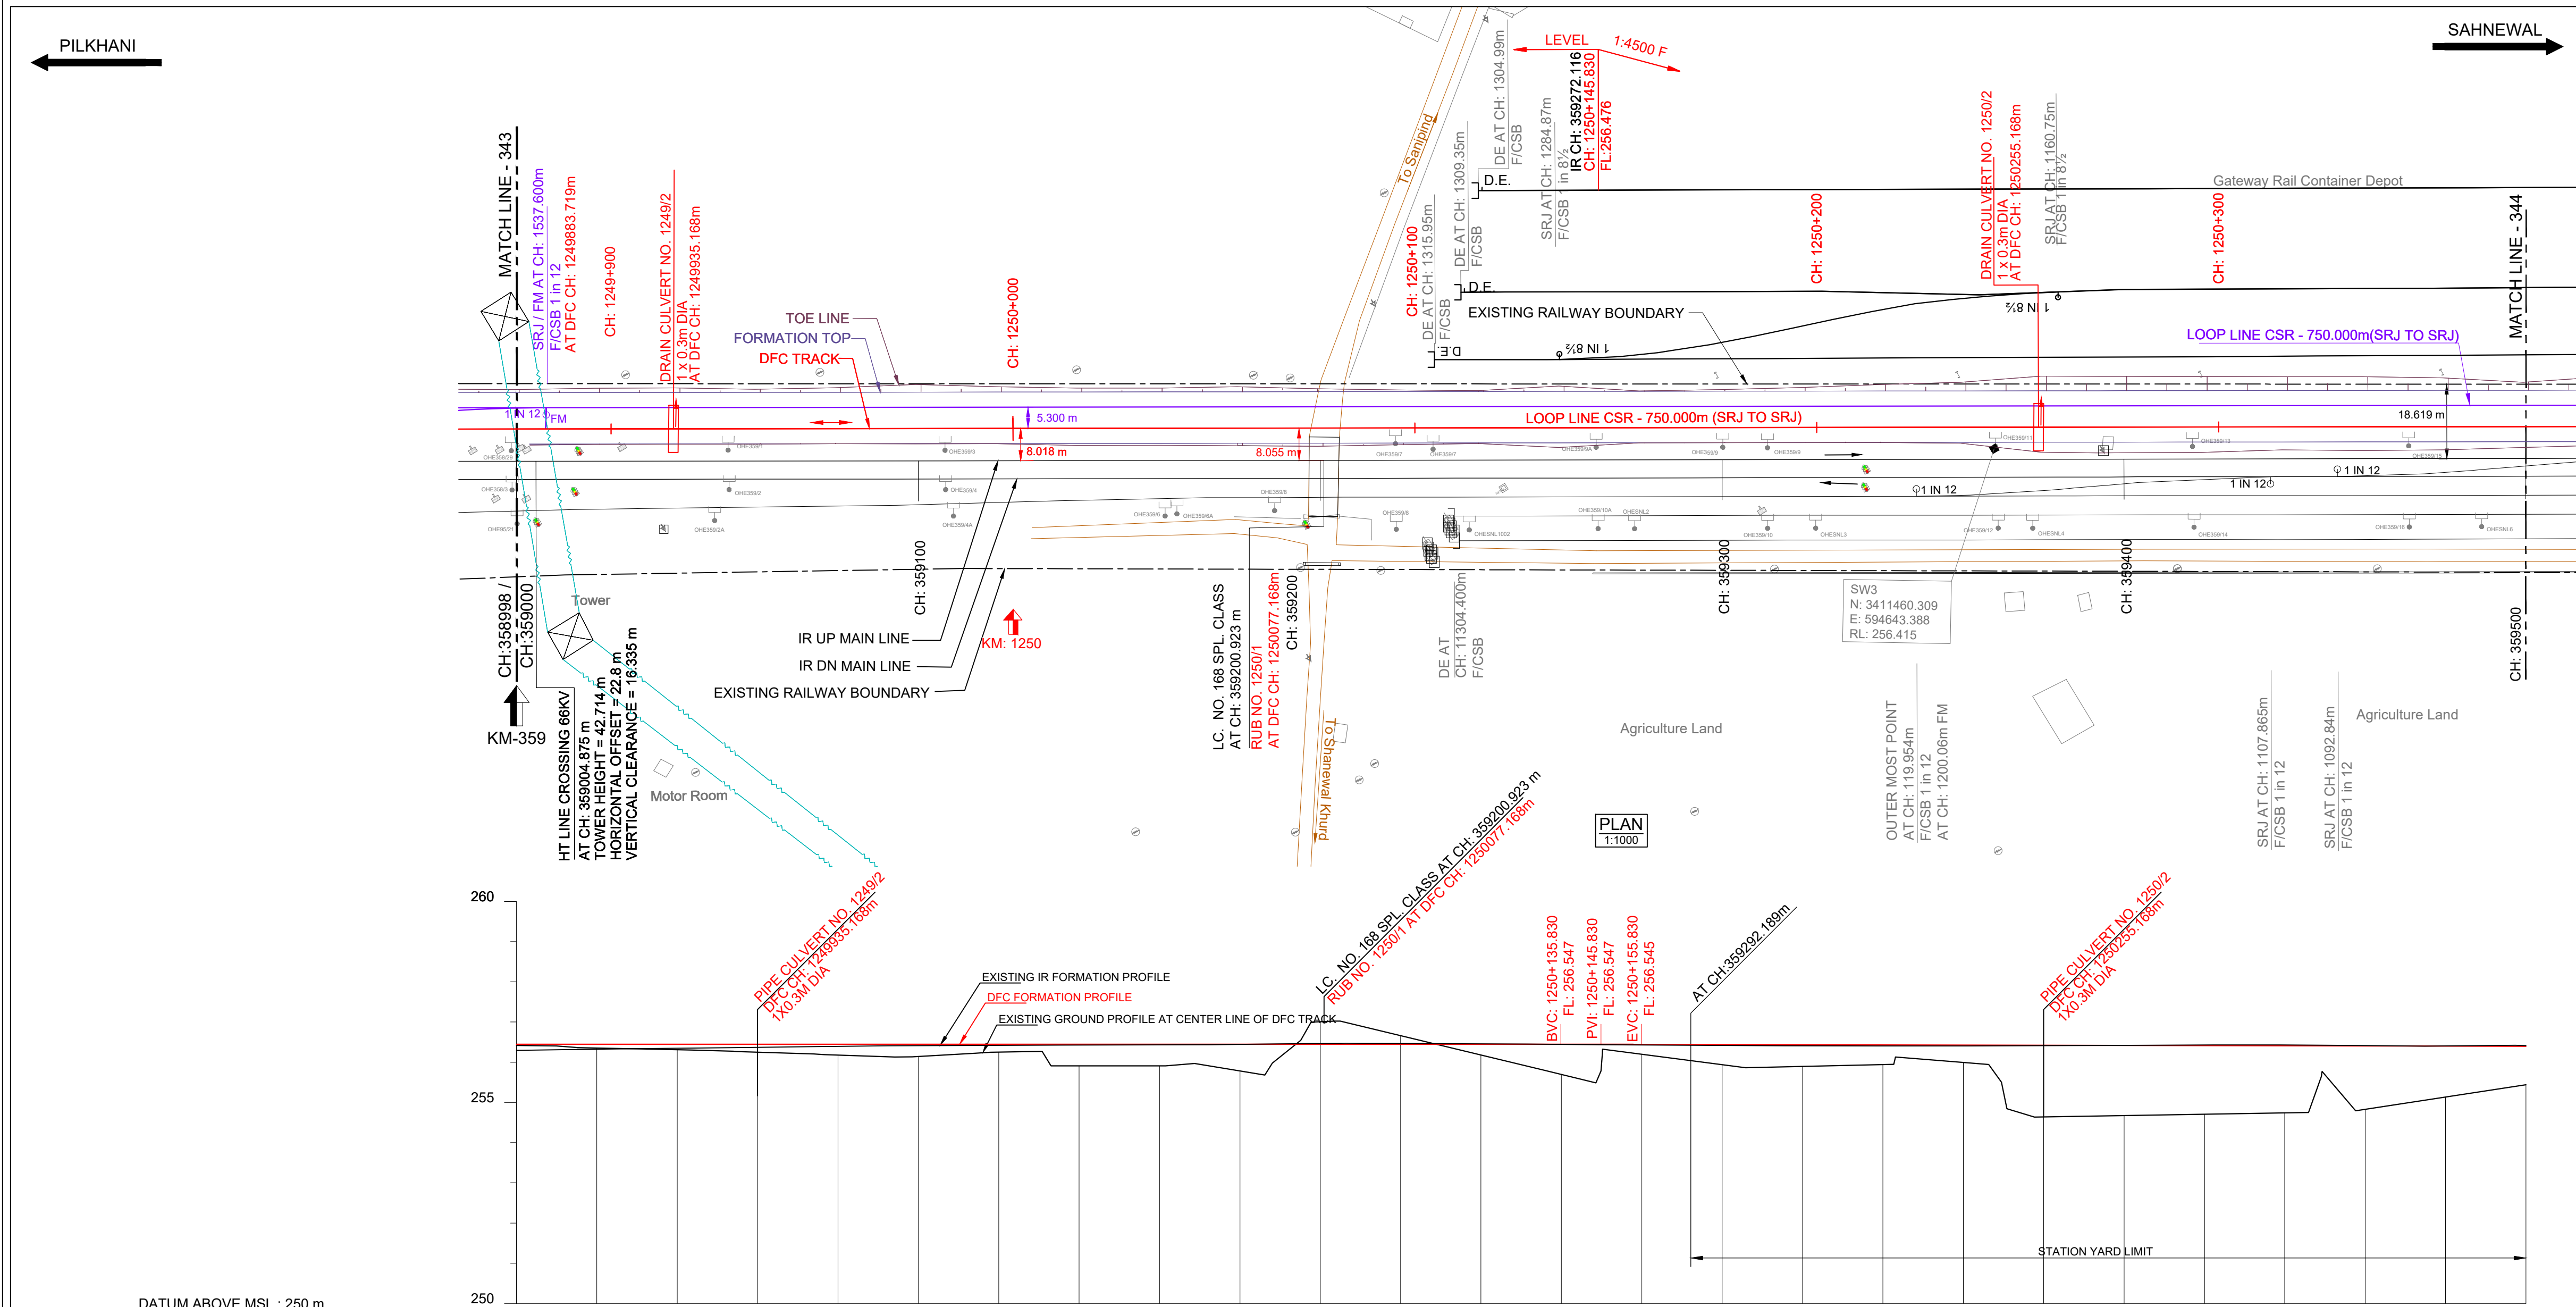

DATUM ABOVE MSL : 250 m

|                                                                          |                                                                    |--------------------------------------------------------------------------|--------------------------------------------------------------------|------------|------------|------------|------------|------------|------------|------------|------------|------------|------------|------------|------------|------------|------------|------------|------------|------------|------------|------------|
| HORIZONTAL ALIGNMENT                                                     | L = 5018.785m                                                      |            |            |            |            |            |            |            |            |            |            |            |            |            |            |            |            |            |            |            |
| VERTICAL ALIGNMENT                                                       | L=447.272m LEVEL<br>L=20.0m R=90631m<br>L=410.500m 1 IN 4531.579 F |            |            |            |            |            |            |            |            |            |            |            |            |            |            |            |            |            |            |            |
| TRACK DISTANCE FROM EXISTING NEAREST IR UP MAIN LINE TO DFC MAIN LINE    | 8.009                                                              | 8.015      | 8.016      | 8.017      | 8.018      | 8.023      | 8.036      | 8.042      | 8.016      | 8.014      | 8.054      | 8.057      | 8.038      | 8.004      | 8.002      | 7.999      | 7.996      | 7.993      | 7.990      | 7.987      |
| HEIGHT OF BANKING(+) / DEPTH OF CUTTING(-) (PFL-GL)                      | +0.058                                                             | +0.123     | +0.164     | +0.226     | +0.238     | +0.332     | +0.226     | +0.367     | +0.567     | +0.694     | -0.532     | -0.186     | +0.296     | +0.779     | +0.275     | +0.530     | +0.569     | +0.520     | +0.461     | +1.813     |
| EXG GROUND LEVEL AT CENTER LINE OF DFC TRACK (GL)                        | -255.949                                                           | -256.353   | -256.312   | -255.935   | -256.178   | -255.360   | -255.572   | -255.780   | -255.909   | -255.616   | -255.972   | -256.634   | -256.150   | -255.598   | -256.318   | -256.069   | -255.825   | -255.443   | -255.236   | -254.655   |
| EXG GROUND LEVEL AT TOE LOCATION OF DFC TRACK                            | -255.949                                                           | -256.353   | -256.312   | -255.935   | -256.178   | -255.360   | -255.572   | -255.780   | -255.909   | -255.616   | -255.972   | -256.634   | -256.150   | -255.598   | -256.318   | -256.069   | -255.825   | -255.443   | -255.236   | -254.655   |
| DIFFERENCE BETWEEN DFC FORMATION LEVEL AND EXG.FORMATION LEVEL (PFL-EFL) | -0.179                                                             | -0.152     | -0.128     | -0.104     | -0.08      | -0.062     | -0.054     | -0.048     | -0.042     | -0.031     | -0.008     | -0.007     | -0.020     | -0.033     | -0.045     | -0.052     | -0.057     | -0.054     | -0.051     | -0.040     |
| DFC FORMATION LEVEL (PFL)                                                | -256.476                                                           | -256.476   | -256.476   | -256.476   | -256.476   | -256.476   | -256.476   | -256.476   | -256.476   | -256.476   | -256.476   | -256.476   | -256.476   | -256.476   | -256.474   | -256.469   | -256.465   | -256.460   | -256.456   | -256.452   |
| EXG. FORMATION LEVEL OF EXG IR UP MAIN LINE (EFL)                        | -256.303                                                           | -256.313   | -256.323   | -256.338   | -256.338   | -256.338   | -256.370   | -256.400   | -256.432   | -256.472   | -256.520   | -256.495   | -256.470   | -256.445   | -256.420   | -256.417   | -256.408   | -256.407   | -256.405   | -256.411   |
| DIFFERENCE BETWEEN DFC RAIL LEVEL AND EXG. RAIL LEVEL (PRL - ERL)        | -0.220                                                             | -0.193     | -0.169     | -0.145     | -0.121     | -0.103     | -0.095     | -0.089     | -0.083     | -0.072     | -0.049     | -0.048     | -0.061     | -0.074     | -0.086     | -0.093     | -0.098     | -0.095     | -0.092     | -0.081     |
| DFC RAIL LEVEL (PRL)                                                     | -257.189                                                           | -257.189   | -257.189   | -257.189   | -257.189   | -257.189   | -257.189   | -257.189   | -257.189   | -257.189   | -257.189   | -257.189   | -257.189   | -257.189   | -257.187   | -257.182   | -257.178   | -257.173   | -257.169   | -257.165   |
| EXG.RAIL LEVEL OF NEAREST IR UP MAIN LINE(ERL)                           | -256.975                                                           | -256.985   | -256.995   | -257.010   | -257.010   | -257.010   | -257.042   | -257.072   | -257.104   | -257.144   | -257.197   | -257.167   | -257.142   | -257.117   | -257.092   | -257.089   | -257.080   | -257.079   | -257.077   | -257.083   |
| EQUIVALENT CHAINAGE ON DFC TRACK                                         | -1249875.9                                                         | -1249895.9 | -1249915.9 | -1249935.9 | -1249955.9 | -1249975.9 | -1249995.9 | -1250015.9 | -1250035.9 | -1250055.9 | -1250075.9 | -1250095.9 | -1250115.9 | -1250135.9 | -1250155.9 | -1250175.9 | -1250195.9 | -1250215.9 | -1250235.9 | -1250255.9 |
| EXISTING IR CHAINAGE                                                     | 359000.0                                                           | 359020.0   | 359040.0   | 359060.0   | 359080.0   | 359100.0   | 359120.0   | 359140.0   | 359160.0   | 359180.0   | 359200.0   | 359220.0   | 359240.0   | 359260.0   | 359280.0   | 359300.0   | 359320.0   | 359340.0   | 359360.0   | 359380.0   |

L - SECTION

- NOTE:-
- DFCC WORKS ARE SHOWN IN RED.
  - IR NEW WORKS ARE SHOWN IN VIOLET.
  - ALL DIMENSIONS ARE SHOWN IN METRES.
  - THIS DRAWING IS PREPARED BASED ON LATEST SURVEY DATA HELD ON APRIL-2022. GTS BENCH MARK OF 261.850M CONSIDERED ON TOP OF CANAL BRIDGE ABUTMENT AT DORANA VILLAGE ALONG THE NH1.
  - DFC NEW CHAINAGE OF 1075.950M IS WITH REFERENCE TO THE IR KM OF 187.500KM END OF KM OF CP-303(SECTION P-3 PILKHANI END) AGAINST THE EXISTING DFC CHAINAGE. 116277.742M ISSUED VIDE LETTER NO. COM/DFCC/CLUB/SURVEY/2021-301-230116-011173.DT. 17.01.2023.
  - BALLAST PROFILE HAS BEEN PROVIDED ACCORDING TO THE CLAUSE 1.11.3 OF STANDARD SCHEDULE OF DIMENSION(EASTERN CORRIDOR) & THE BALLAST CUSHION DIMENSION SHOWN IN 35CM ON GE-14 PARA 17. SPECIFICATIONS & RECOMMENDATIONS 2. TWO LAYER SYSTEM FIG.10.

- REFERENCE DRAWINGS :-
- FOR KEY PLAN REFER DRAWING NO. 301-2/AL/0001
  - FOR LEGEND AND ABBREVIATIONS REFER DRAWING NO. 301-2/AL/1000
  - FOR TYPICAL SECTION OF BALLAST PROFILE (FL-RL) REFFER DRG. NO. 301-2/TK/TFD/004 (TR.1952)

| REV. | DATE       | REVISION DETAILS               | PURPOSE OF ISSUE |
|------|------------|--------------------------------|------------------|
| 0    | 21.10.2024 | SUBMISSION OF AS-BUILT DRAWING | FOR APPROVAL     |

LEGEND:


SCALE

HOR - 1:1000

VER - 1:100

SHEET SIZE : A1

IR TRACK  
DFCC TRACK  
DFCC FUTURE PROPOSALS  
STRUCTURE / BUILDING  
DFCC TOE LINE  
DFCC FORMATION  
RETAINING WALL  
ROAD  
STREAM, DRAIN, NALA, CANAL.  
FENCE  
POWER LINES  
TBM  
ELECTRIC POLE/OHE MAST  
IR RAILWAY BOUNDARY  
DFCC BOUNDARY

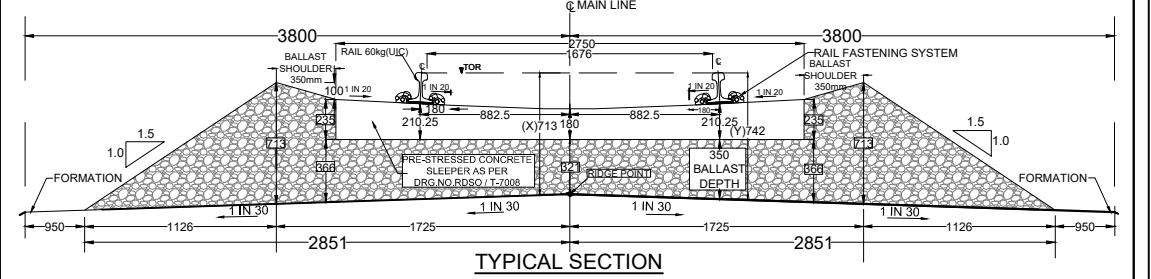

| TRACK STRUCTURE                                                                            |                                             |       |
|--------------------------------------------------------------------------------------------|---------------------------------------------|-------|
| RAIL SECTION: 60Kg/m (UIC 60Kg/m)<br>DFC LINE: 60Kg/m (UIC 60Kg/m)<br>IR MAIN LINE: 52Kg/m | Difference between FL- RL (Below Rail Seat) |       |
|                                                                                            | IR Line                                     | DFC   |
| RUBBER PAD                                                                                 | 172mm                                       | 172mm |
| SLEEPER DEPTH                                                                              | 6mm                                         | 10mm  |
| BALLAST CUSHION                                                                            | 210mm                                       | 210mm |
| Total Depth (FL TO RL)                                                                     | 300mm                                       | 350mm |
|                                                                                            | 688mm                                       | 742mm |

OWNER

DEDICATED FREIGHT CORRIDOR CORPORATION OF INDIA LTD.

(A GOVERNMENT OF INDIA ENTERPRISE)

PROJECT OFFICE(AMBALA UNIT): OLD RAILWAY COLONY (NEAR ANAND MARKET),AMBALA CANTT-133001.

CORPORATE IDENTITY NO. : U60232DL2006GGI155068

ENGINEER:

DB Engineering & Consulting GmbH

Deutsche Bahn Engineering & Consulting GmbH

CONTRACTOR:

GIL - TPL JV

GAR TATA


| SUBMITTED BY | GIL - TPL JV |                   |           |
|--------------|--------------|-------------------|-----------|
|              | DATED        | NAME              | SIGNATURE |
| PREPARED BY  | 21.10.2024   | VIJAY PRATAP      |           |
| CHECKED BY   | 21.10.2024   | PARASURAM KOTYADA |           |
| APPROVED BY  | 21.10.2024   | PARASURAM KOTYADA |           |

| APPROVED BY            | DEUTSCHE BAHN ENGINEERING & CONSULTING GMBH |                  |           |
|------------------------|---------------------------------------------|------------------|-----------|
|                        | DATED                                       | NAME             | SIGNATURE |
| Sr. DE./CHIEF ENGINEER |                                             | SURESH K.YALANGI |           |
| CHIEF TRACK ENGINEER   |                                             | RAJ PAL SINGH    |           |
| T.L.                   |                                             | H.D. VIDJAK      |           |

|                    |                                                      |  |  |
|--------------------|------------------------------------------------------|--|--|
| STAMP              | A AS-BUILT DRAWING TR. Ref.:..... ENGINEER Sign.:.   |  |  |
| EMPLOYER (DFCCIL): | DEDICATED FREIGHT CORRIDOR CORPORATION OF INDIA LTD. |  |  |
|                    |                                                      |  |  |
|                    |                                                      |  |  |
|                    |                                                      |  |  |

| AS BUILT DRAWING |                                   |   |  |
|------------------|-----------------------------------|---|--|
| TITLE            | AS-BUILT PLAN AND PROFILE         |   |  |
|                  | FROM IR KM: 359.000 TO 359.500    |   |  |
|                  | FROM DFC KM: 1249.876 TO 1250.376 |   |  |
|                  | DATE: 21.10.2024                  |   |  |
| STATUS           |                                   | A |  |

TR.

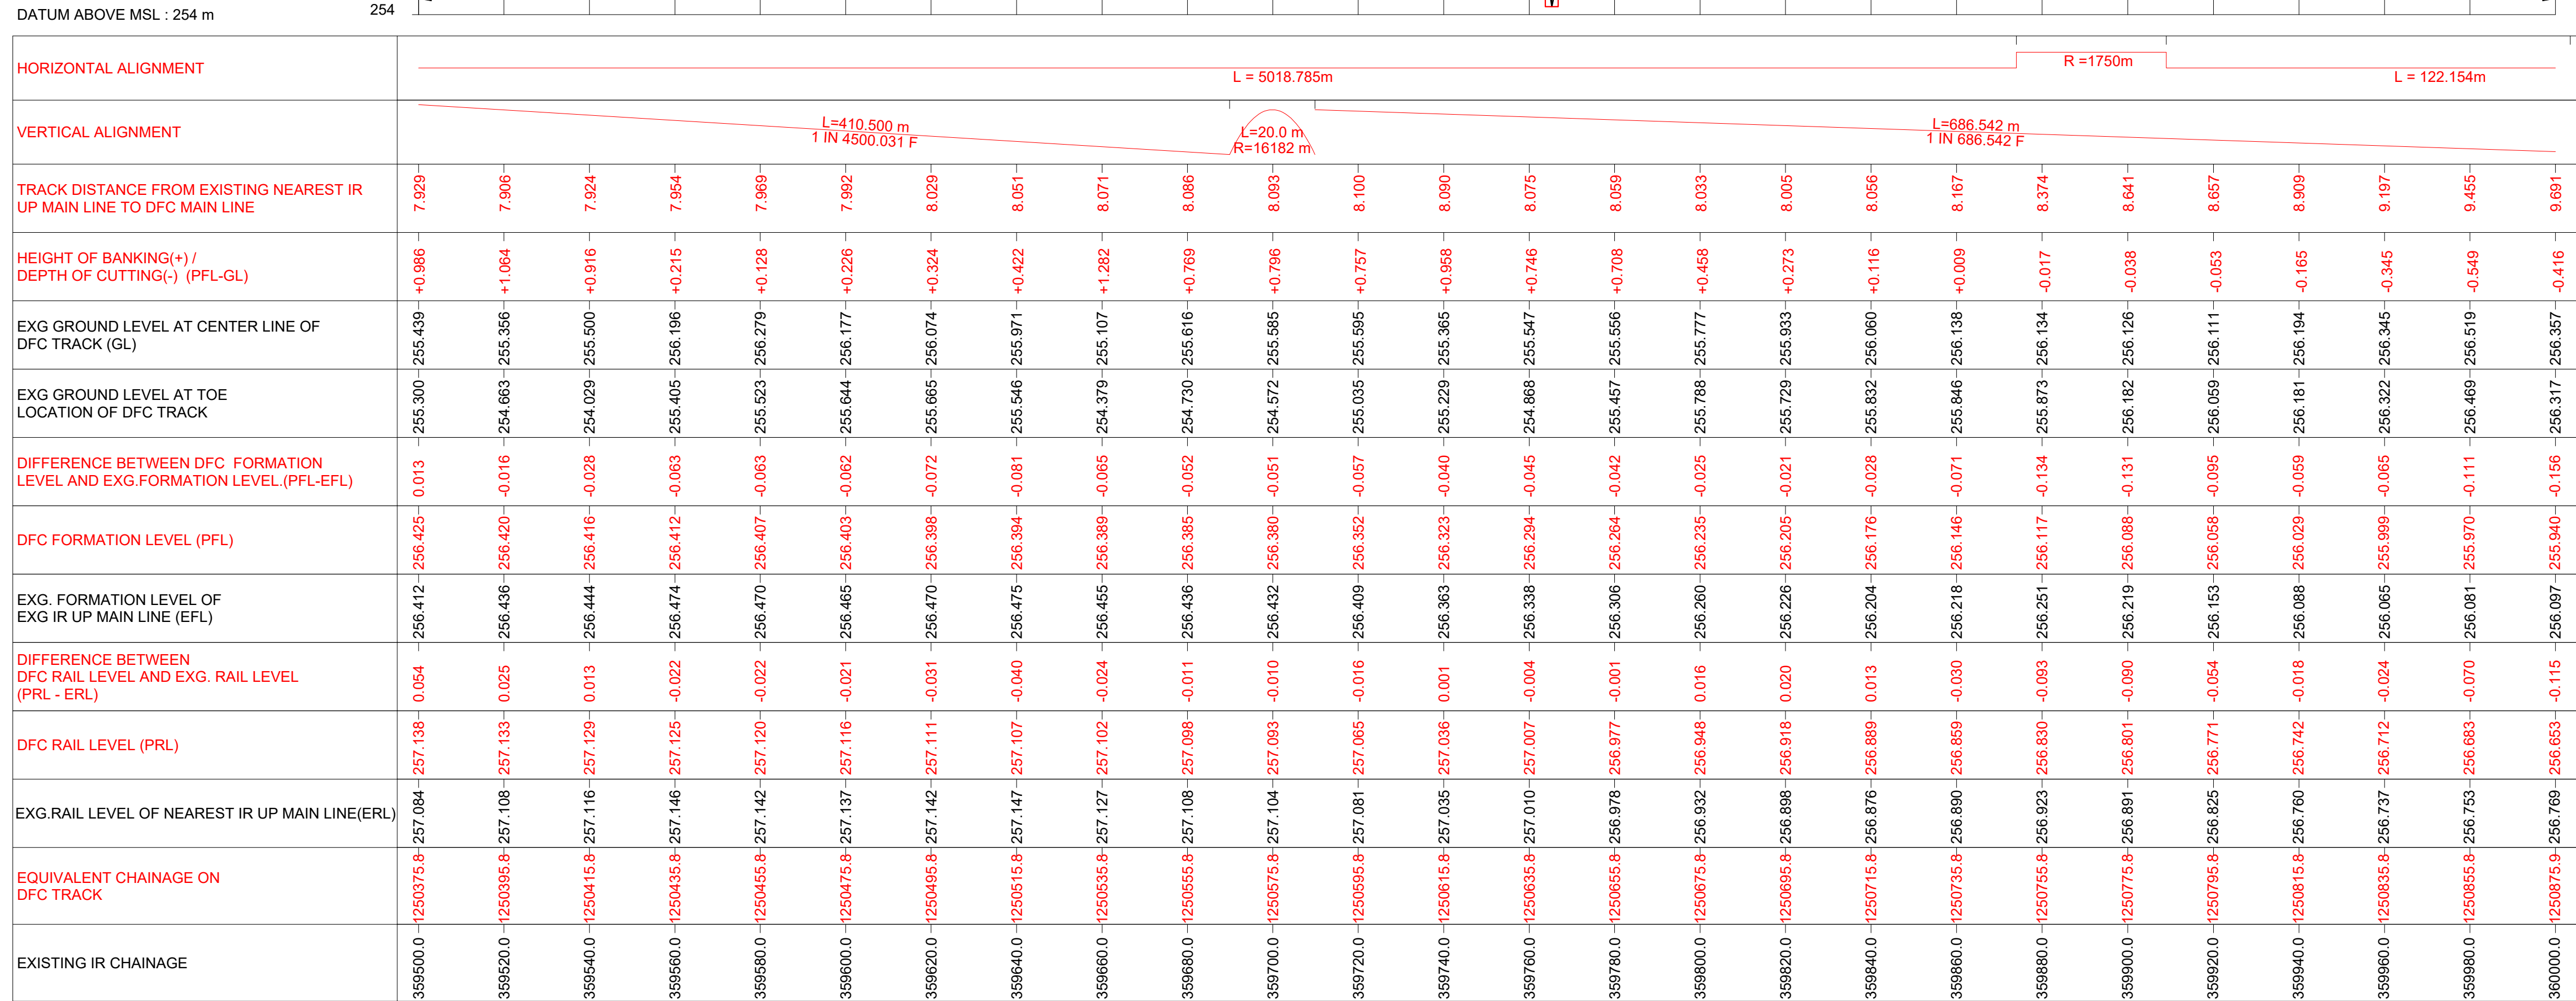


|                                                                                                                                                                                                                                                                                    |                                                    |
|------------------------------------------------------------------------------------------------------------------------------------------------------------------------------------------------------------------------------------------------------------------------------------|----------------------------------------------------|
| <h1 style="text-align: center; border: 1px solid black; padding: 5px;">AS BUILT DRAWING</h1>                                                                                                                                                                                       |                                                    |
| <p>TITLE</p> <p style="text-align: center; font-size: 1.2em;">AS-BUILT PLAN AND PROFILE</p> <p style="text-align: center; font-size: 1.2em;">FROM IR KM: 359.500 TO 360.000</p> <p style="text-align: center; color: red; font-size: 1.2em;">FROM DFC KM: 1250.376 to 1250.876</p> | DFCC APPR. NO. - _____                             |
|                                                                                                                                                                                                                                                                                    | ENGG. APPR. NO. - _____                            |
|                                                                                                                                                                                                                                                                                    | DRG. NO. - <b>301-2/AL/A/1345</b>                  |
|                                                                                                                                                                                                                                                                                    | SHEET NO. : 1 OF 1                                 |
| DATE : 21.10.2024                                                                                                                                                                                                                                                                  | STATUS<br><span style="font-size: 1.5em;">A</span> |

|    |
|----|
| TR |
|----|

PILKHANI

SAHNEWAL

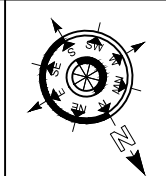

NOTE:-

1. DFC WORKS ARE SHOWN IN RED.
2. IR NEW WORKS ARE SHOWN IN VIOLET.
3. ALL DIMENSIONS ARE SHOWN IN METRES.
4. THIS DRAWING IS PREPARED BASED ON LATEST SURVEY DATA HELD ON APRIL-2022. GTS BENCH MARK OF 261.850M CONSIDERED ON TOP OF CANAL BRIDGE ABUTMENT AT DORANA VILLAGE ALONG THE NH1.
5. DFC NEW CHAINAGE OF 1075.950M IS WITH REFERENCE TO THE IR KM OF 187.500KM END OF KM OF CP-303(SECTION P-3 PILKHANI END) AGAINST THE EXISTING DFC CHAINAGE. 116277.742M ISSUED VIDE LETTER NO. COM/DFCC/UM/SURVEY/2021-301-230116-011173 DT. 17.01.2023.
6. BALLAST PROFILE HAS BEEN PROVIDED ACCORDING TO THE CLAUSE 1.11.3 OF STANDARD SCHEDULE OF DIMENSION(EASTERN CORRIDOR) & THE BALLAST CUSHION DIMESION SHOWN IN 35CM ON GE-14 PARA 17. SPECIFICATIONS & RECOMMENDATIONS 2. TWO LAYER SYSTEM FIG.10.


REFERENCE DRAWINGS:-

1. FOR KEY PLAN REFER DRAWING NO. 301-2/AL/0001
2. FOR LEGEND AND ABBREVIATIONS REFER DRAWING NO. 301-2/AL/1000
3. FOR TYPICAL SECTION OF BALLAST PROFILE (FL-RL) REFER DRG. NO. 301-2/TK/TFDI-004 (TR.1952)

| REV. | DATE       | REVISION DETAILS               | PURPOSE OF ISSUE |
|------|------------|--------------------------------|------------------|
| 0    | 21.10.2024 | SUBMISSION OF AS-BUILT DRAWING | FOR APPROVAL     |

LEGEND:

|                        |                     |                             |
|------------------------|---------------------|-----------------------------|
| IR TRACK               | DFCC TRACK          | DFCC FUTURE PROPOSALS       |
| STRUCTURE / BUILDING   | DFCC TOE LINE       | DFCC FORMATION              |
| RETAINING WALL         | ROAD                | STREAM, DRAIN, NALA, CANAL. |
| FENCE                  | POWER LINES         | TBM                         |
| ELECTRIC POLE/OHE MAST | IR RAILWAY BOUNDARY | DFCC BOUNDARY               |

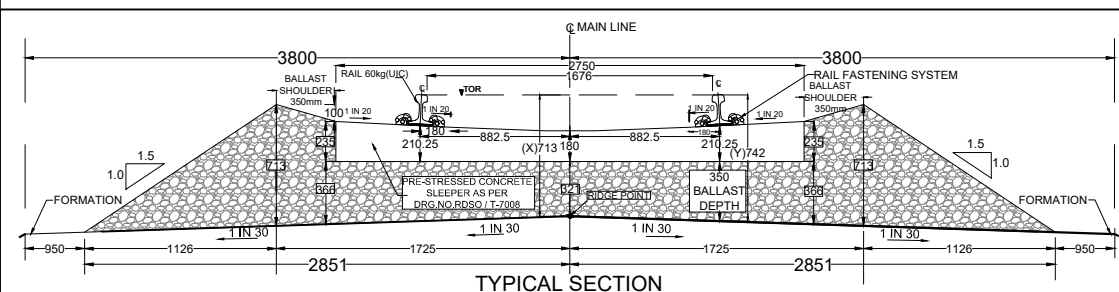

| TRACK STRUCTURE                                                                            |                                                |       |
|--------------------------------------------------------------------------------------------|------------------------------------------------|-------|
| RAIL SECTION: 60Kg/m (UIC 60Kg/m)<br>DFC LINE: 60Kg/m (UIC 60Kg/m)<br>IR MAIN LINE: 52Kg/m | Difference between<br>FL- RL (Below Rail Seat) |       |
|                                                                                            | IR Line                                        | DFC   |
| RUBBER PAD                                                                                 | 172mm                                          | 172mm |
| SLEEPER DEPTH                                                                              | 6mm                                            | 10mm  |
| BALLAST CUSHION                                                                            | 210mm                                          | 210mm |
|                                                                                            | 300mm                                          | 350mm |
| Total Depth (FL TO RL)                                                                     | 688mm                                          | 742mm |

OWNER: DEDICATED FREIGHT CORRIDOR CORPORATION OF INDIA LTD.  
(A GOVERNMENT OF INDIA ENTERPRISE)  
PROJECT OFFICE(AMBALA UNIT): OLD RAILWAY COLONY (NEAR ANAND MARKET),AMBALA CANTT-133001.  
CORPORATE IDENTITY NO. : U60232DL2006GGI155068

ENGINEER: DB Engineering & Consulting GmbH  
Deutsche Bahn Engineering & Consulting GmbH

CONTRACTOR: GIL - TPL JV  
GAR TATA



| SUBMITTED BY | GIL - TPL JV |                   |           |
|--------------|--------------|-------------------|-----------|
|              | DATED        | NAME              | SIGNATURE |
| PREPARED BY  |              |                   |           |
| CHECKED BY   | 21.10.2024   | VIJAY PRATAP      |           |
| APPROVED BY  | 21.10.2024   | PARASURAM KOTYADA |           |

| APPROVED BY            | DEUTSCHE BAHN ENGINEERING & CONSULTING GMBH |                  |           |
|------------------------|---------------------------------------------|------------------|-----------|
|                        | DATED                                       | NAME             | SIGNATURE |
| Sr. DE./CHIEF ENGINEER |                                             | SURESH K.YALANGI |           |
| CHIEF TRACK ENGINEER   |                                             | RAJ PAL SINGH    |           |
| T.L.                   |                                             | H.D. VIDJAK      |           |

|                    |                                                              |  |  |
|--------------------|--------------------------------------------------------------|--|--|
| STAMP              | A AS-BUILT DRAWING<br>TR. Ref.:.....<br>ENGINEER Sign.:..... |  |  |
| EMPLOYER (DFCCIL): | DEDICATED FREIGHT CORRIDOR CORPORATION OF INDIA LTD.         |  |  |
|                    |                                                              |  |  |
|                    |                                                              |  |  |

| AS BUILT DRAWING |                                   |                           |        |
|------------------|-----------------------------------|---------------------------|--------|
| TITLE            | AS-BUILT PLAN AND PROFILE         | DFCC APPR. NO. -          |        |
|                  | FROM IR KM: 360.000 TO 360.200    | ENGG. APPR. NO. -         |        |
|                  | FROM DFC KM: 1250.876 to 1251.031 | DRG. NO. :301-2/AL/A/1346 |        |
|                  |                                   | SHEET NO. :1 OF 1         | STATUS |
|                  |                                   | DATE :21.10.2024          | A      |

TR.

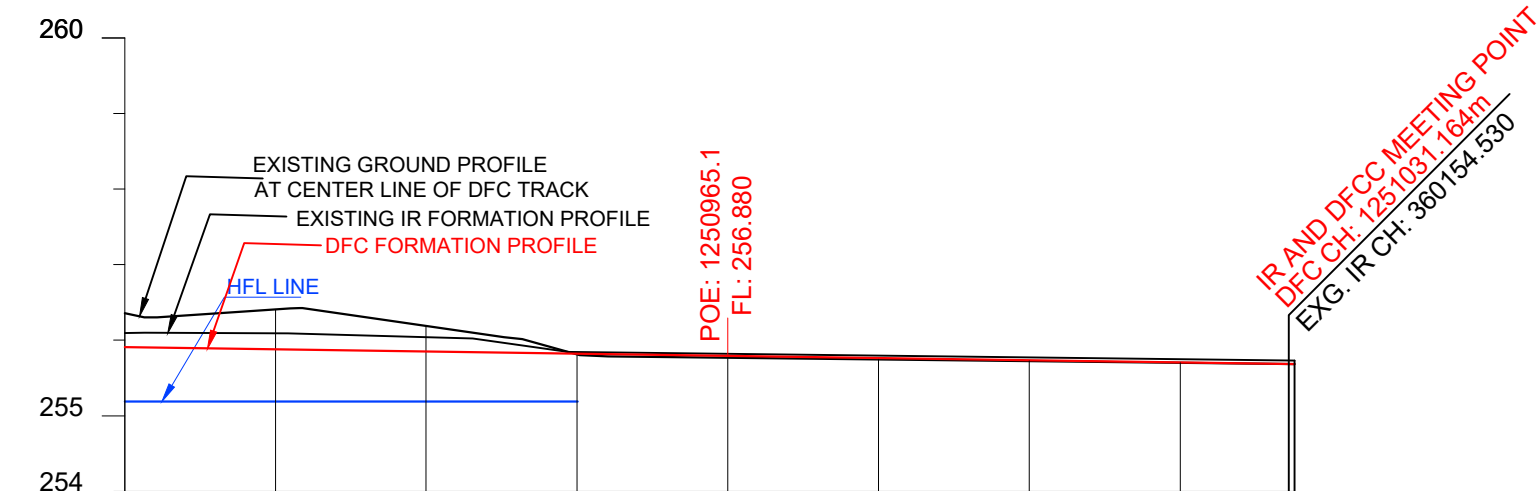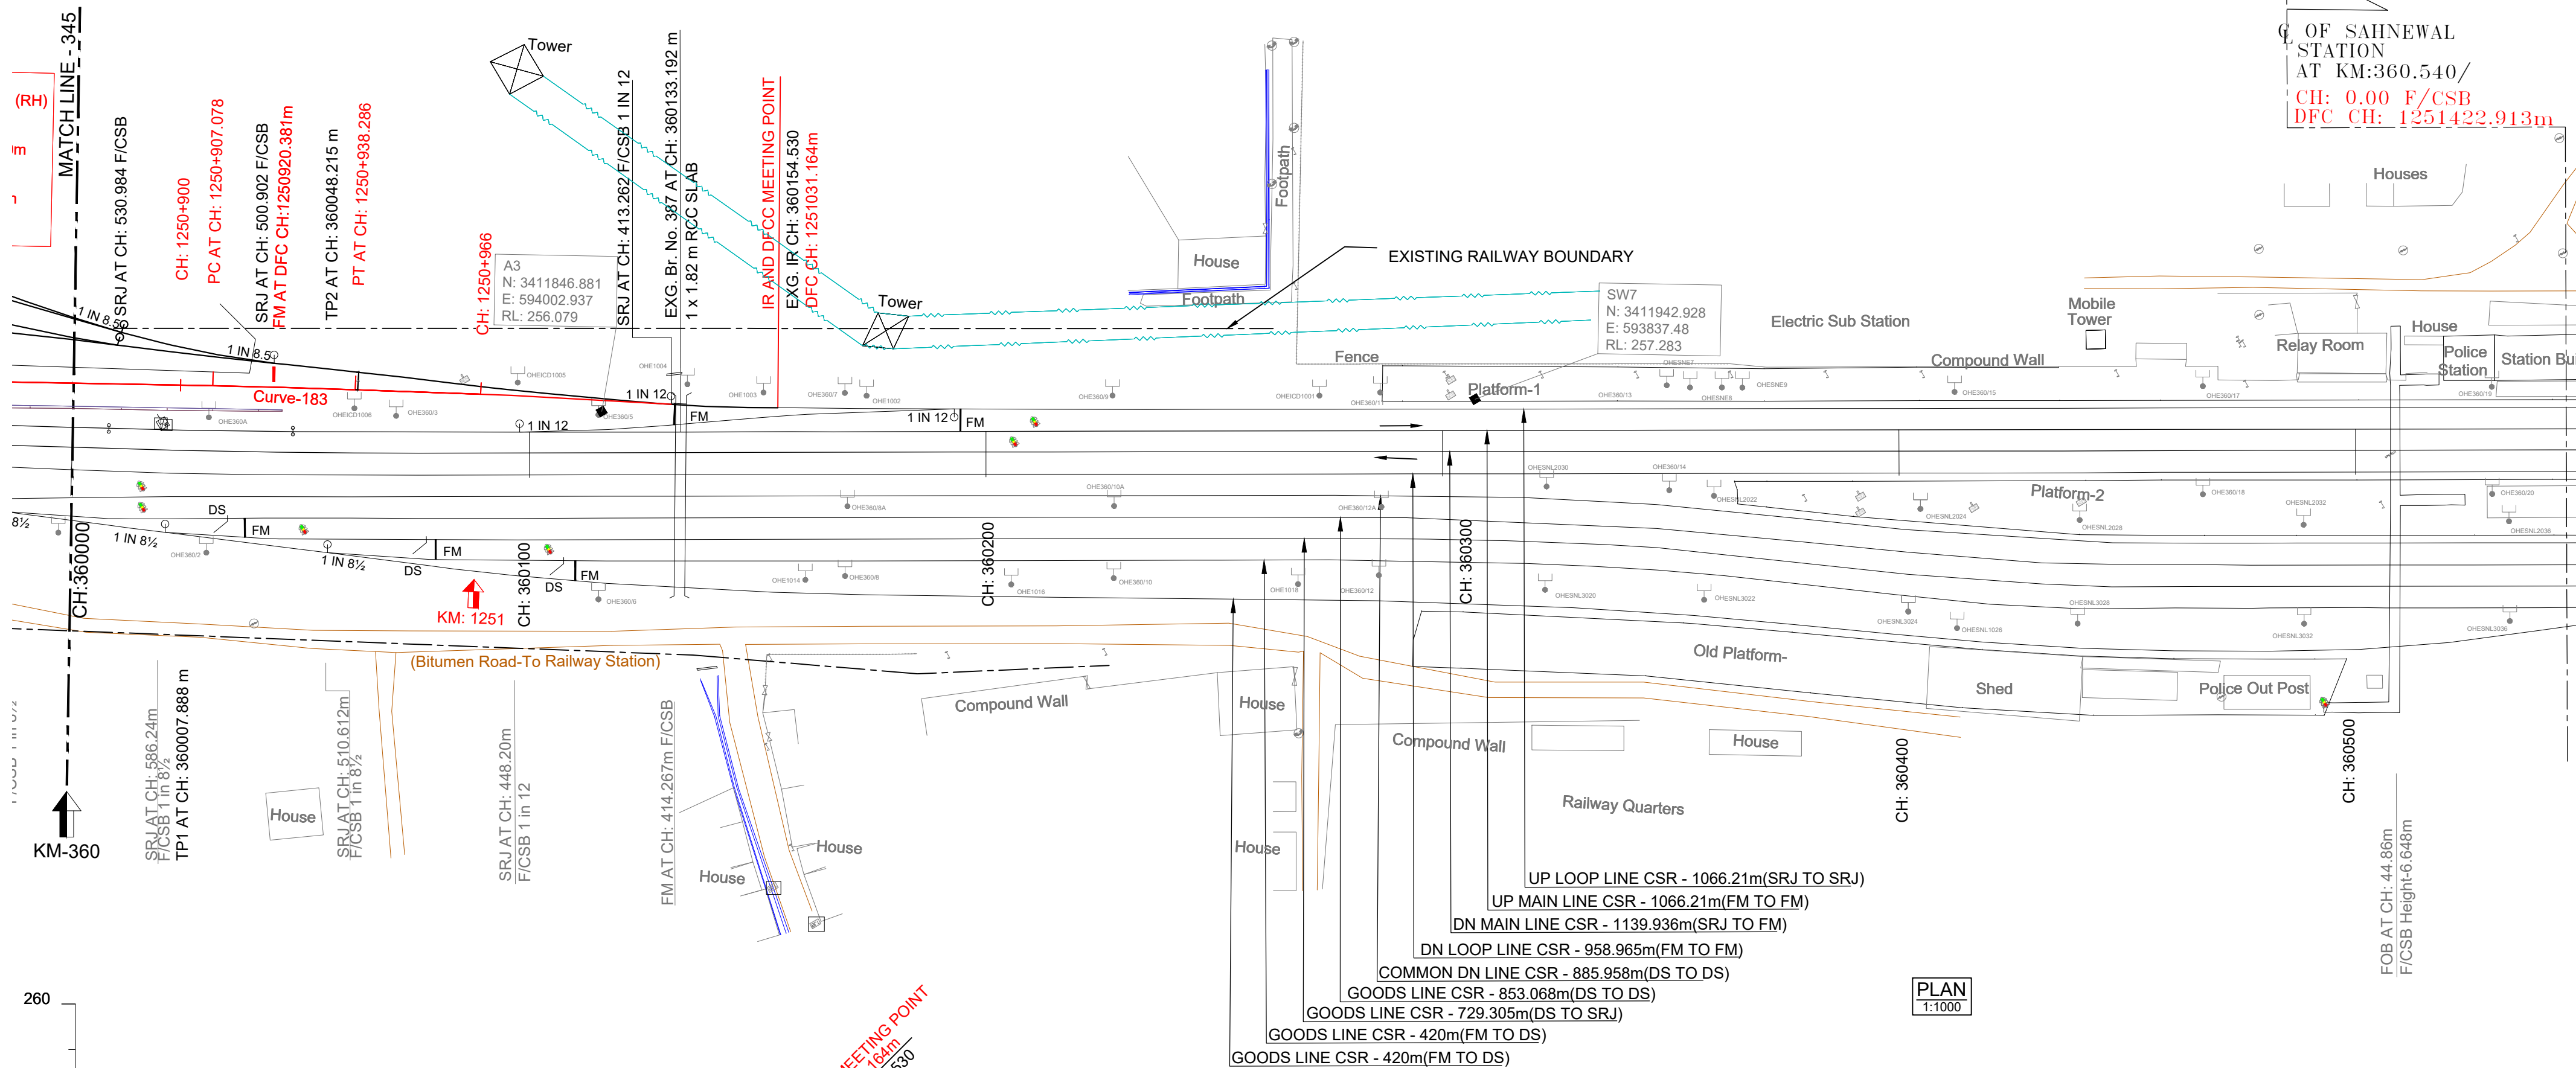

DATUM ABOVE MSL : 254 m

| HORIZONTAL ALIGNMENT                                                     | L = 122.154m R = 1750m        |          | L = 92.878m |          |
|--------------------------------------------------------------------------|-------------------------------|----------|-------------|----------|
| VERTICAL ALIGNMENT                                                       | L=686.542 m<br>1 IN 686.542 F |          | EXG. GRADE  |          |
| TRACK DISTANCE FROM EXISTING NEAREST IR UP MAIN LINE TO DFC MAIN LINE    | 9.691                         | 9.811    | 9.736       | 9.287    |
| HEIGHT OF BANKING(+) / DEPTH OF CUTTING(-) (PFL-GL)                      | -0.416                        | -0.497   | -0.307      | +0.039   |
| EXG GROUND LEVEL AT CENTER LINE OF DFC TRACK (GL)                        | 256.357                       | 256.408  | 256.189     | 255.814  |
| EXG GROUND LEVEL AT TOE LOCATION OF DFC TRACK                            | 256.317                       | 256.400  | 256.134     | 256.148  |
| DIFFERENCE BETWEEN DFC FORMATION LEVEL AND EXG.FORMATION LEVEL (PFL-EFL) | -0.156                        | -0.178   | -0.159      | -0.160   |
| DFC FORMATION LEVEL (PFL)                                                | 256.94                        | 255.911  | 255.882     | 255.852  |
| EXG. FORMATION LEVEL OF EXG IR UP MAIN LINE (EFL)                        | 256.097                       | 256.090  | 256.041     | 256.012  |
| DIFFERENCE BETWEEN DFC RAIL LEVEL AND EXG. RAIL LEVEL (PRL - ERL)        | -0.115                        | -0.137   | -0.118      | -0.119   |
| DFC RAIL LEVEL (PRL)                                                     | 256.653                       | 256.624  | 256.595     | 256.665  |
| EXG.RAIL LEVEL OF NEAREST IR UP MAIN LINE(ERL)                           | 256.769                       | 256.762  | 256.713     | 256.684  |
| EQUIVALENT CHAINAGE ON DFC TRACK                                         | 360000.0                      | 360020.0 | 360040.0    | 360060.0 |
| EXISTING IR CHAINAGE                                                     | 360000.0                      | 360020.0 | 360040.0    | 360060.0 |

EXG. IR LOOP LINE LEVELS

L - SECTION