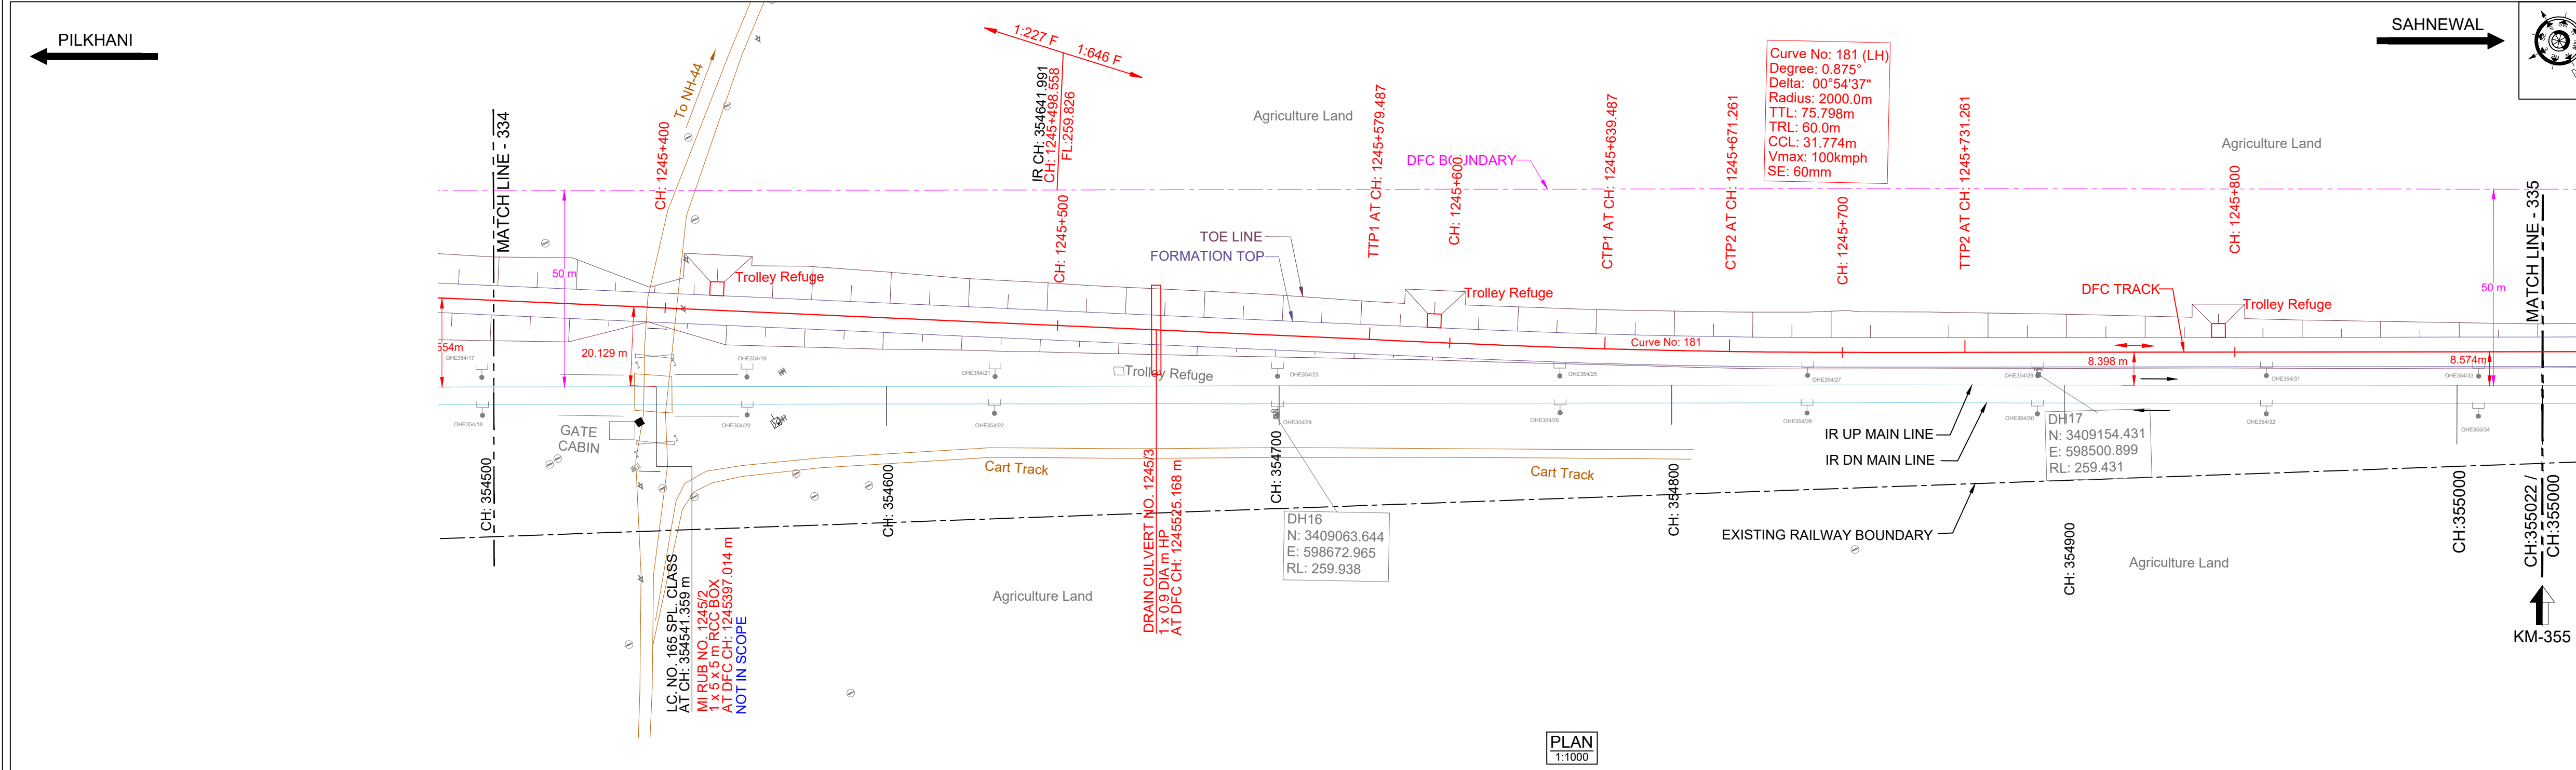


HORIZONTAL ALIGNMENT	L = 289.490m TL = 60m R = -2000m TL = 60m L = 5018.785m																																																										
VERTICAL ALIGNMENT	L=427.680 m 1 IN 227.307 F L=20.0 m R=-7014 m L=1479.855m 1 IN 646.028 F																																																										
TRACK DISTANCE FROM EXISTING NEAREST IR UP MAIN LINE TO DFC MAIN LINE	22.065			21.137		20.214		19.291		18.374			15.642		14.716		13.770		12.819		11.892		10.970		10.121		9.407		8.846		8.484		8.313		8.263		8.309		8.360		8.411		8.460		8.486		8.518		8.558		8.598		8.601						
HEIGHT OF BANKING(+) / DEPTH OF CUTTING(-) (PFL-GL)	+4.251			+4.264		+0.396		+4.134		+4.265			+3.930		+3.467		+3.027		+2.585		+2.168		+1.778		+1.599		+1.377		+1.148		+0.987		+0.728		+0.588		+0.468		+0.376		+0.302		+0.247		+0.197		+0.147		+0.097		+0.047		+0.001						
EXG GROUND LEVEL AT CENTER LINE OF DFC TRACK (GL)	-256.200			-256.099		-259.879		-256.053		-255.834			-255.909		-256.331		-256.740		-257.151		-257.537		-257.896		-258.044		-258.235		-258.433		-258.563		-257.791		-257.600		-257.536		-257.450		-257.373		-257.285		-257.272		-257.175		-257.029		-256.952		-256.875						
EXG GROUND LEVEL AT TOE LOCATION OF DFC TRACK	-256.692			-256.257		-259.496		-256.153		-255.766			-256.237		-256.316		-256.314		-256.370		-256.603		-256.572		-256.462		-256.433		-256.268		-256.268		-256.052		-255.791		-255.624		-255.450		-255.285		-255.120		-254.955		-254.790		-254.625		-254.460		-254.295		-254.130				
DIFFERENCE BETWEEN DFC FORMATION LEVEL AND EXG.FORMATION LEVEL (PFL-EFL)	0.177			0.116		0.092		0.077		0.087			0.010		0.024		0.024		0.020		0.033		0.049		0.061		0.074		0.090		0.106		0.126		0.144		0.145		0.145		0.147		0.171		0.203		0.240		0.279		0.317		0.355						
DFC FORMATION LEVEL (PFL)	-260.451			-260.363		-260.275		-260.187		-260.099			-259.839		-259.798		-259.767		-259.736		-259.705		-259.674		-259.581		-259.550		-259.519		-259.488		-259.393		-259.319		-259.245		-259.171		-259.097		-259.023		-258.949		-258.875		-258.801		-258.727		-258.653						
EXG. FORMATION LEVEL OF EXG IR UP MAIN LINE (EFL)	-260.274			-260.247		-260.183		-260.110		-260.012			-259.824		-259.774		-259.743		-259.716		-259.672		-259.625		-259.491		-259.444		-259.383		-259.344		-259.312		-259.281		-259.250		-259.217		-259.186		-259.155		-259.124		-259.093		-259.062		-259.031		-258.999		-258.968				
DIFFERENCE BETWEEN DFC RAIL LEVEL AND EXG. RAIL LEVEL (PRL - ERL)	-0.221			-0.161		-0.136		-0.121		-0.131			-0.055		-0.067		-0.067		-0.063		-0.076		-0.091		-0.103		-0.117		-0.168		-0.187		-0.187		-0.167		-0.167		-0.187		-0.214		-0.246		-0.283		-0.326		-0.368		-0.410		-0.452						
DFC RAIL LEVEL (PRL)	-261.167			-261.079		-260.991		-260.903		-260.815			-260.551		-260.512		-260.481		-260.450		-260.419		-260.388		-260.295		-260.264		-260.233		-260.203		-260.172		-260.141		-260.111		-260.079		-260.048		-260.017		-259.986		-259.955		-259.924		-259.893		-259.862		-259.831				
EXG.RAIL LEVEL OF NEAREST IR UP MAIN LINE(ERL)	-260.946			-260.919		-260.855		-260.782		-260.684			-260.496		-260.446		-260.415		-260.388		-260.344		-260.297		-260.254		-260.210		-260.165		-260.116		-260.065		-259.984		-259.953		-259.880		-259.834		-259.771		-259.703		-259.633		-259.562		-259.491		-259.420		-259.349				
EQUIVALENT CHAINAGE ON DFC TRACK	-1245355.6			-1245375.6		-1245395.7		-1245415.7		-1245435.7			-1245495.8		-1245515.8		-1245535.8		-1245555.8		-1245575.9		-1245595.9		-1246015.9		-1246035.9		-1246055.9		-1246075.9		-1246095.9		-1246115.9		-1246135.9		-1246155.9		-1246175.9		-1246195.9		-1246215.9		-1246235.9		-1246255.9		-1246275.9		-1246295.9		-1246315.9				
EXISTING IR CHAINAGE	354500.0			354520.0		354540.0		354560.0		354580.0			354600.0		354620.0		354640.0		354660.0		354680.0		354700.0		354720.0		354740.0		354760.0		354780.0		354800.0		354820.0		354840.0		354860.0		354880.0		354900.0		354920.0		354940.0		354960.0		354980.0		355000.0		355020.0		355040.0		355060.0

L - SECTION

NOTE:-
1. DFC WORKS ARE SHOWN IN RED.
2. IR NEW WORKS ARE SHOWN IN VIOLET.
3. ALL DIMENSIONS ARE SHOWN IN METRES.
4. THIS DRAWING IS PREPARED BASED ON LATEST SURVEY DATA HELD ON APRIL-2022. GTS BENCH MARK OF 261.850M CONSIDERED ON TOP OF CANAL BRIDGE ABUTMENT AT DORAH VILLAGE ALONG THE NH1.
5. DFC NEW CHAINAGE OF 1075.950M IS WITH REFERENCE TO THE IR KM OF 187.500KM END OF KM OF CP-303(SECTION P-3 PILKHANI END) AGAINST THE EXISTING DFC CHAINAGE. 116277.742M ISSUED VIDE LETTER NO. COM/DFCC/CH/MS/SURVEY/2021-301-230116-01173 DT. 17.01.2023.
6. BALLAST PROFILE HAS BEEN PROVIDED ACCORDING TO THE CLAUSE 1.11.3 OF STANDARD SCHEDULE OF DIMENSION(EASTERN CORRIDOR) & THE BALLAST CUSHION DIMENSION SHOWN IN 35CM ON GE-14 PARA 17. SPECIFICATIONS & RECOMMENDATIONS 2. TWO LAYER SYSTEM FIG.10.

DRG NO. - 301-2/AL/A/1335


REFERENCE DRAWINGS :-
1. FOR KEY PLAN REFER DRAWING NO. 301-2/AL/0001
2. FOR LEGEND AND ABBREVIATIONS REFER DRAWING NO. 301-2/AL/1000
3. FOR TYPICAL SECTION OF BALLAST PROFILE (FL-RL) REFER DRG. NO. 301-2/TK/TFD/-004 (TR.1952)

REV.	DATE	REVISION DETAILS	PURPOSE OF ISSUE
0	21.10.2024	SUBMISSION OF AS-BUILT DRAWING	FOR APPROVAL

LEGEND:

- IR TRACK
- DFCC TRACK
- DFCC FUTURE PROPOSALS
- STRUCTURE / BUILDING
- DFCC TOE LINE
- DFCC FORMATION
- RETAINING WALL
- ROAD
- STREAM, DRAIN, NALA, CANAL
- FENCE
- POWER LINES
- TBM
- ELECTRIC POLE/OHE MAST
- IR RAILWAY BOUNDARY
- DFCC BOUNDARY

SCALE
HOR - 1:1000
VER - 1:100
SHEET SIZE : A1

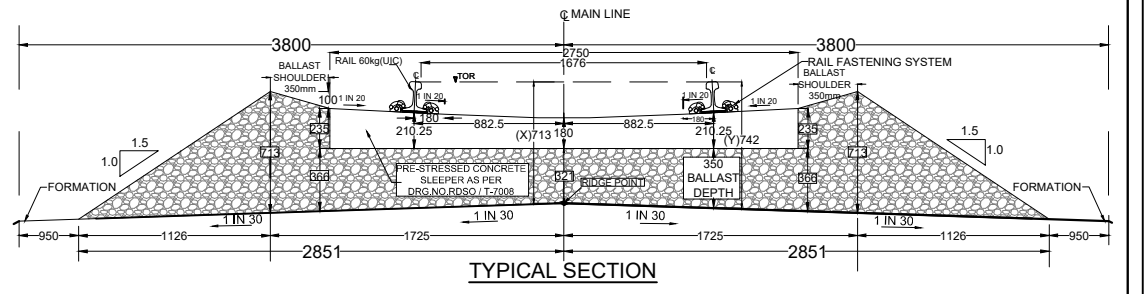

TRACK STRUCTURE		
RAIL SECTION: 60Kg/m (UIC 60Kg/m) DFC LINE: 60Kg/m (UIC 60Kg/m) IR MAIN LINE: 52Kg/m	Difference between FL- RL (Below Rail Seat)	
	IR Line	DFC
RUBBER PAD	172mm	172mm
SLEEPER DEPTH	210mm	210mm
BALLAST CUSHION	300mm	350mm
Total Depth (FL TO RL)	688mm	742mm

OWNER: DEDICATED FREIGHT CORRIDOR CORPORATION OF INDIA LTD.
(A GOVERNMENT OF INDIA ENTERPRISE)
PROJECT OFFICE(AMBALA UNIT): OLD RAILWAY COLONY (NEAR ANAND MARKET),AMBALA CANTT-133001.
CORPORATE IDENTITY NO. : U60232DL2006GGI155068

ENGINEER: DB Engineering & Consulting GmbH
Deutsche Bahn Engineering & Consulting GmbH

CONTRACTOR: GIL - TPL JV
GAR TATA

SUBMITTED BY	GIL - TPL JV		
	DATED	NAME	SIGNATURE
PREPARED BY	21.10.2024	VIJAY PRATAP	
CHECKED BY	21.10.2024	PARASURAM KOTYADA	
APPROVED BY	21.10.2024	PARASURAM KOTYADA	

APPROVED BY	DEUTSCHE BAHN ENGINEERING & CONSULTING GMBH		
	DATED	NAME	SIGNATURE
Sr. DE./CHIEF ENGINEER		SURESH K.YALANGI	
CHIEF TRACK ENGINEER		RAJ PAL SINGH	
T.L.		H.D. VIDJAK	

STAMP: A AS-BUILT DRAWING TR. Ref.: ENGINEER Sign.:

EMPLOYER (DFCCIL):	DEDICATED FREIGHT CORRIDOR CORPORATION OF INDIA LTD.		

AS BUILT DRAWING

TITLE: AS-BUILT PLAN AND PROFILE

FROM IR KM: 354.500 TO 355.000
FROM DFC KM: 1245.356 TO 1245.878

DFCC APPR. NO. -
ENGG. APPR. NO. -
DRG. NO. - 301-2/AL/A/1335
SHEET NO. : 1 OF 1
DATE : 21.10.2024

STATUS: A