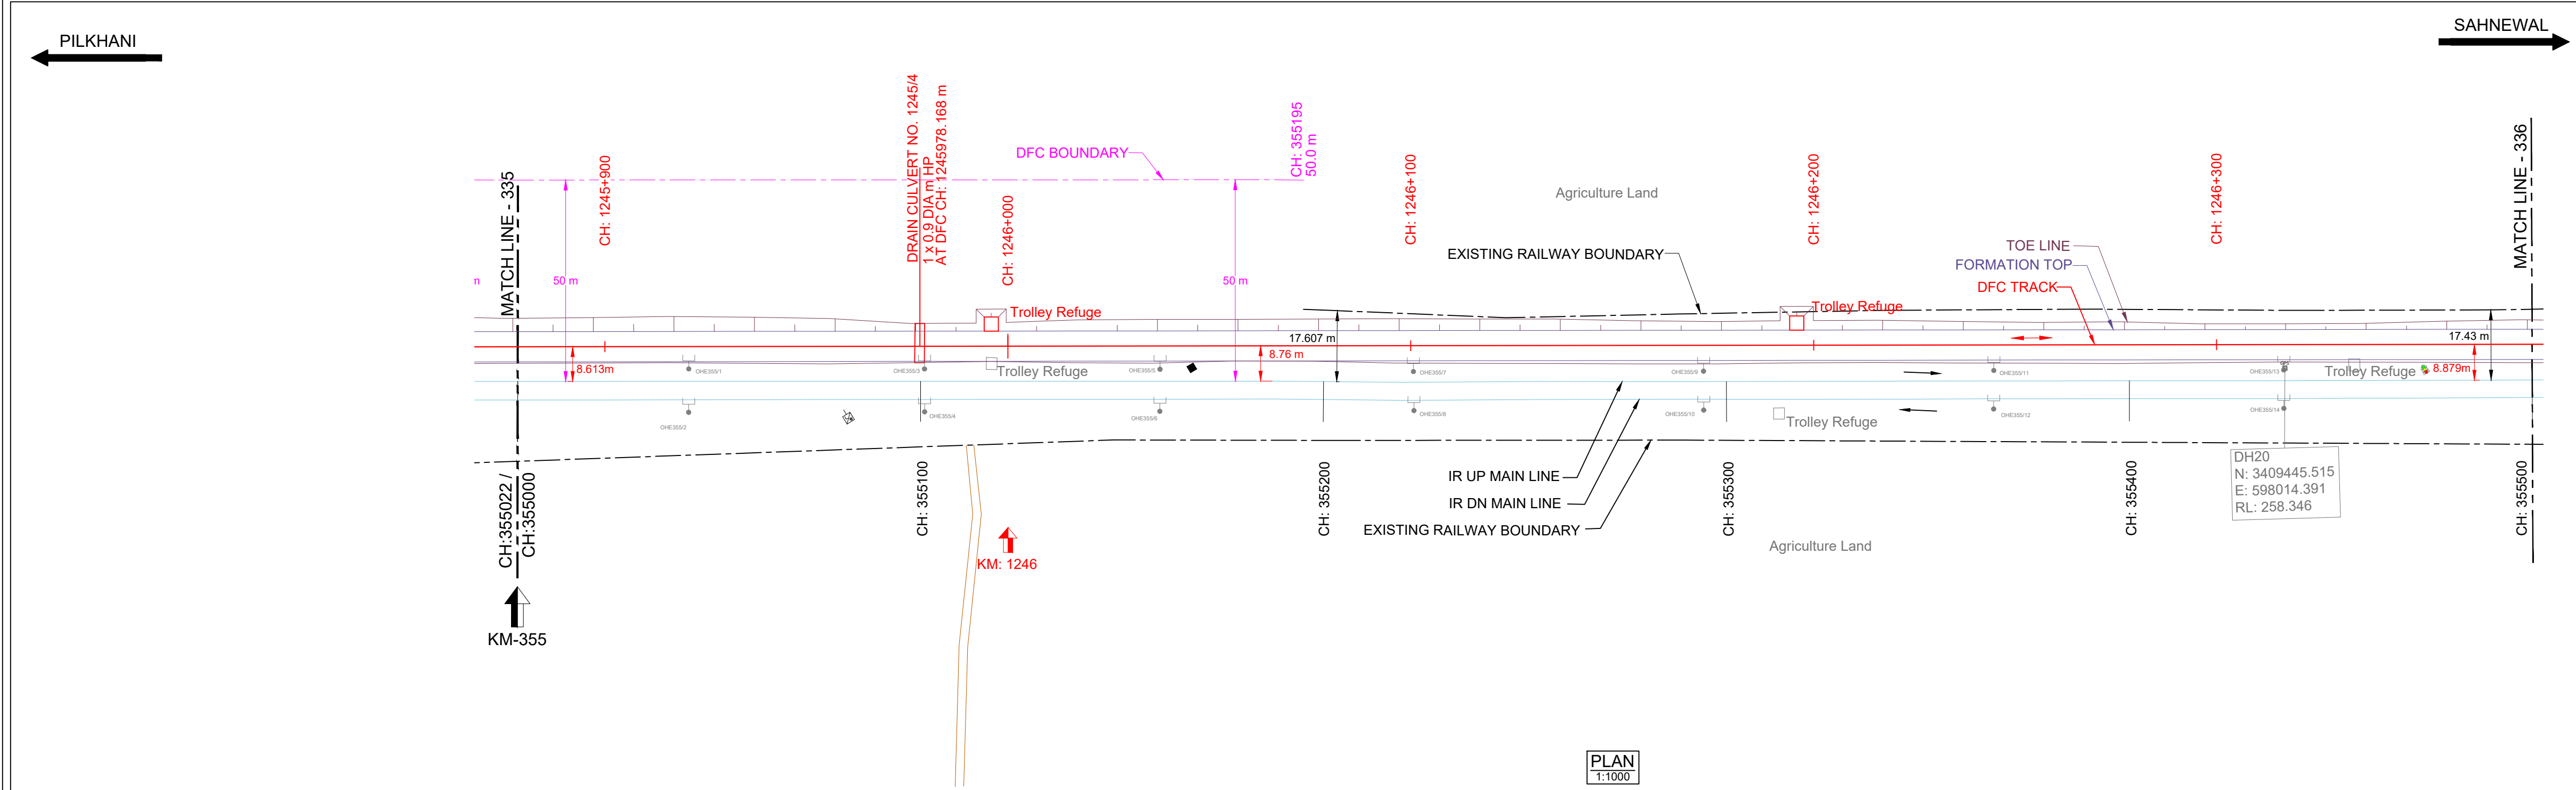


HORIZONTAL ALIGNMENT	L = 5018.785m																			
VERTICAL ALIGNMENT	L = 1479.859m 1 IN 646.026 F																			
TRACK DISTANCE FROM EXISTING NEAREST IR UP MAIN LINE TO DFC MAIN LINE	8.601	8.618	8.632	8.645	8.657	8.694	8.726	8.739	8.744	8.755	8.883	9.071	8.990	8.931	8.991	9.001	8.974	8.950	8.928	8.933
HEIGHT OF BANKING(+) / DEPTH OF CUTTING(-) (PFL-GL)	+1.474	+1.659	+1.873	+1.676	+1.373	+0.441	+0.305	+0.655	+0.876	+0.564	+1.117	+1.405	+1.357	+1.249	+0.930	+0.659	+0.841	+1.050	+0.958	+0.783
EXG GROUND LEVEL AT CENTER LINE OF DFC TRACK (GL)	257.764	257.548	257.303	257.469	257.741	258.642	258.747	258.366	258.114	258.395	257.811	257.492	257.509	257.586	257.874	257.629	257.902	257.662	257.723	257.867
EXG GROUND LEVEL AT TOE LOCATION OF DFC TRACK	257.487	257.383	257.212	257.286	257.457	258.034	257.915	257.519	257.486	257.417	257.390	257.294	257.344	257.376	257.471	257.629	257.417	257.424	257.535	257.600
DIFFERENCE BETWEEN DFC FORMATION LEVEL AND EXG.FORMATION LEVEL (PFL-EFL)	0.284	0.264	0.250	0.278	0.308	0.321	0.349	0.429	0.478	0.485	0.494	0.506	0.537	0.563	0.570	0.567	0.554	0.533	0.524	0.477
DFC FORMATION LEVEL (PFL)	259.238	259.207	259.176	259.145	259.114	259.083	259.052	259.021	258.990	258.959	258.928	258.897	258.866	258.835	258.804	258.773	258.743	258.712	258.681	258.650
EXG. FORMATION LEVEL OF EXG IR UP MAIN LINE (EFL)	258.954	258.943	258.926	258.867	258.806	258.762	258.703	258.592	258.512	258.474	258.434	258.391	258.329	258.272	258.234	258.206	258.189	258.179	258.157	258.173
DIFFERENCE BETWEEN DFC RAIL LEVEL AND EXG. RAIL LEVEL (PRL - ERL)	0.326	0.306	0.292	0.320	0.350	0.363	0.392	0.472	0.521	0.527	0.537	0.549	0.580	0.606	0.612	0.610	0.596	0.575	0.566	0.519
DFC RAIL LEVEL (PRL)	259.952	259.921	259.890	259.859	259.828	259.797	259.766	259.735	259.704	259.673	259.642	259.612	259.581	259.550	259.519	259.488	259.457	259.426	259.395	259.364
EXG.RAIL LEVEL OF NEAREST IR UP MAIN LINE(ERL)	259.626	259.615	259.598	259.539	259.478	259.434	259.375	259.264	259.184	259.146	259.106	259.063	259.001	258.944	258.906	258.878	258.861	258.851	258.829	258.845
EQUIVALENT CHAINAGE ON DFC TRACK	1245887.7	1245897.7	1245917.7	1245937.7	1245957.7	1245977.7	1245997.7	1246017.7	1246037.7	1246057.7	1246077.7	1246097.7	1246117.7	1246137.7	1246157.7	1246177.7	1246197.7	1246217.7	1246237.7	1246257.7
EXISTING IR CHAINAGE	355000.0	355020.0	355040.0	355060.0	355080.0	355100.0	355120.0	355140.0	355160.0	355180.0	355200.0	355220.0	355240.0	355260.0	355280.0	355300.0	355320.0	355340.0	355360.0	355380.0

NOTE:-

- DFCC WORKS ARE SHOWN IN RED.
- IR NEW WORKS ARE SHOWN IN VIOLET.
- ALL DIMENSIONS ARE SHOWN IN METRES.
- THIS DRAWING IS PREPARED BASED ON LATEST SURVEY DATA HELD ON APRIL-2022. GTS BENCH MARK OF 261.850M CONSIDERED ON TOP OF CANAL BRIDGE ABUTMENT AT DORANA VILLAGE ALONG THE NH1.
- DFC NEW CHAINAGE OF 1075.950M IS WITH REFERENCE TO THE IR KM OF 187.500KM END OF KM OF CP-303(SECTION P-3 PILKHANI END) AGAINST THE EXISTING DFC CHAINAGE. 116277.742M ISSUED VIDE LETTER NO. COM/DFCC/UMS/SURVEY/2021-301-230116-011173 DT. 17.01.2023.
- BALLAST PROFILE HAS BEEN PROVIDED ACCORDING TO THE CLAUSE 1.11.3 OF STANDARD SCHEDULE OF DIMENSION(EASTERN CORRIDOR) & THE BALLAST CUSHION DIMENSION SHOWN IN 35CM ON GE-14 PARA 17. SPECIFICATIONS & RECOMMENDATIONS 2. TWO LAYER SYSTEM FIG.10.

REFERENCE DRAWINGS :-

- FOR KEY PLAN REFER DRAWING NO. 301-2/AL/0001
- FOR LEGEND AND ABBREVIATIONS REFER DRAWING NO. 301-2/AL/1000
- FOR TYPICAL SECTION OF BALLAST PROFILE (FL-RL) REFER DRG. NO. 301-2/TK/TFD/004 (TR.1952)

LEGEND:

IR TRACK
DFCC TRACK
DFCC FUTURE PROPOSALS
STRUCTURE / BUILDING
DFCC TOE LINE
DFCC FORMATION
RETAINING WALL
ROAD
STREAM, DRAIN, NALA, CANAL.
FENCE
POWER LINES
TBM
ELECTRIC POLE/OHE MAST
IR RAILWAY BOUNDARY
DFCC BOUNDARY

SCALE

HOR - 1:1000
VER - 1:100
SHEET SIZE : A1

TYPICAL SECTION

TRACK STRUCTURE		
RAIL SECTION: 60Kg/m (UIC 60Kg/m) DFC LINE: 60Kg/m (UIC 60Kg/m) IR MAIN LINE: 52Kg/m	Difference between FL- RL (Below Rail Seat)	
	IR Line	DFC
	172mm	172mm
RUBBER PAD	6mm	10mm
SLEEPER DEPTH	210mm	210mm
BALLAST CUSHION	300mm	350mm
Total Depth (FL TO RL)		688mm 742mm

OWNER

DEDICATED FREIGHT CORRIDOR CORPORATION OF INDIA LTD.
(A GOVERNMENT OF INDIA ENTERPRISE)
PROJECT OFFICE/AMBALA UNIT: OLD RAILWAY COLONY (NEAR ANAND MARKET),AMBALA CANTT-133001.
CORPORATE IDENTITY NO. : U60232DL2006GGI155068

ENGINEER:

DB Engineering & Consulting GmbH
Deutsche Bahn Engineering & Consulting GmbH

CONTRACTOR:

GIL - TPL JV
GAR TATA

SUBMITTED BY	GIL - TPL JV		
	DATED	NAME	SIGNATURE
PREPARED BY			
CHECKED BY	21.10.2024	VIJAY PRATAP	
APPROVED BY	21.10.2024	PARASURAM KOTYADA	
APPROVED BY	DEUTSCHE BAHN ENGINEERING & CONSULTING GMBH		
	DATED	NAME	SIGNATURE
Sr. DE./CHIEF ENGINEER		SURESH K.YALANGI	
CHIEF TRACK ENGINEER		RAJ PAL SINGH	
T.L.		H.D. VIDJAK	

STAMP

A AS-BUILT DRAWING
TR. Ref.:.....
ENGINEER Sign.:.....

EMPLOYER (DFCCIL): DEDICATED FREIGHT CORRIDOR CORPORATION OF INDIA LTD.

AS BUILT DRAWING

TITLE

AS-BUILT PLAN AND PROFILE

FROM IR KM: 355.000 TO 355.500
FROM DFC KM: 1245.878 to 1246.378

DFCC APPR. NO. -
ENG. APPR. NO. -
DRG. NO. :301-2/AL/A/1336
SHEET NO. :1 OF 1
DATE : 21.10.2024

STATUS

A

TR.