


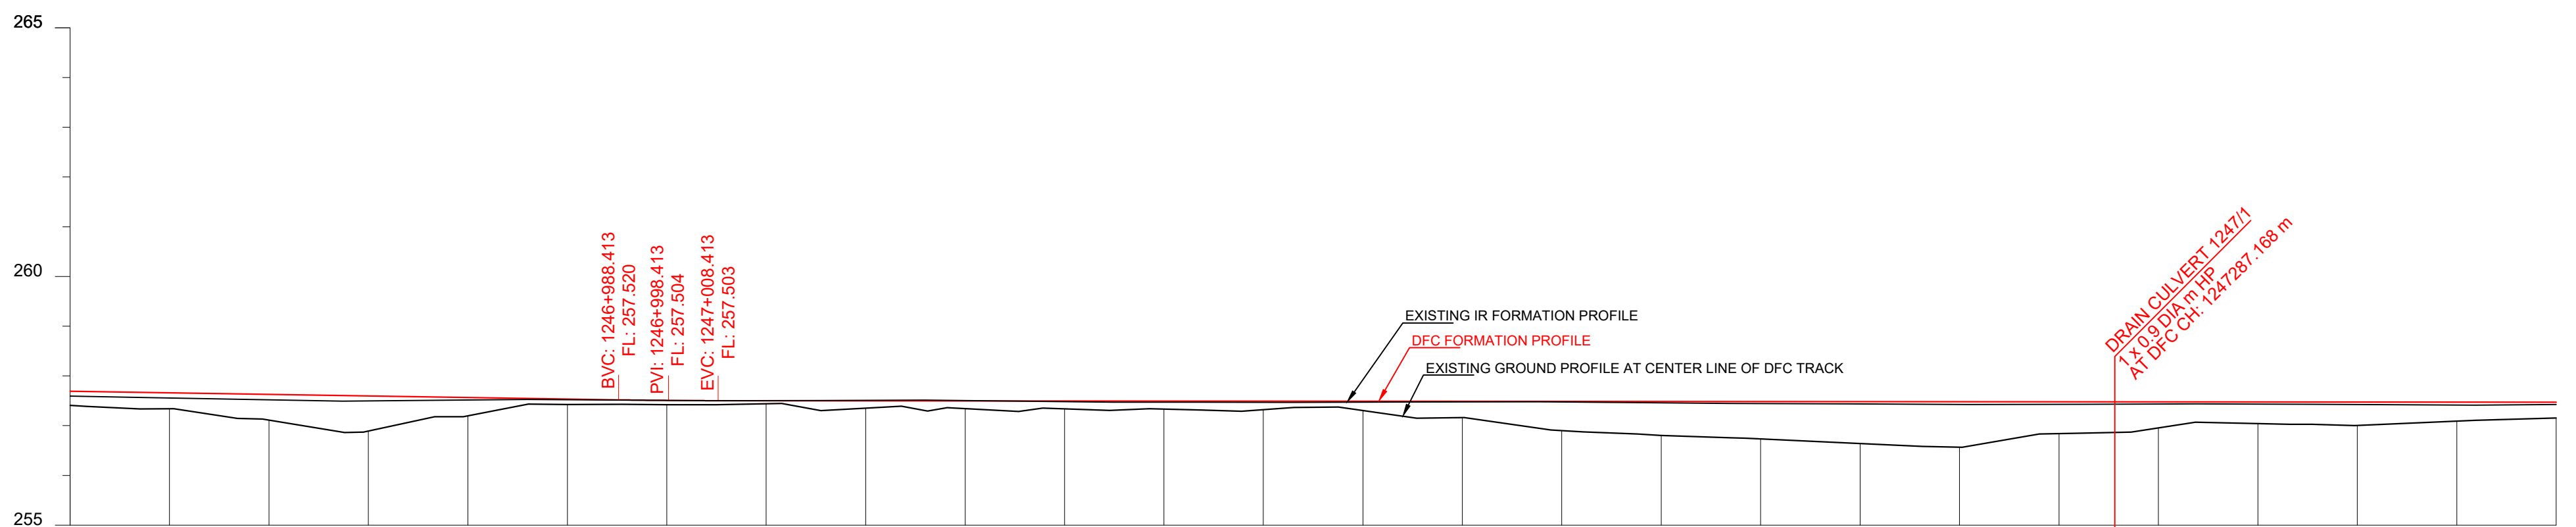

L - SECTION

DRG NO.- 301-2/AL/A/1338

0	21.10.2024	SUBMISSION OF AS-BUILT DRAWING	FOR APPROVAL
REV.	DATE	REVISION DETAILS	PURPOSE OF ISSUE

The diagram shows a cross-section of a bridge with a central main span and two side approach spans. The main span is 1725 units wide at the base and is supported by two large piers, each 3800 units high. The approach spans are 1120 units wide at the base. The bridge is supported by foundations. The main span is labeled 'TYPICAL SECTION'.

TRACK STRUCTURE		
RAIL SECTION: 60Kg/m (UIC 60Kg/m) DFC LINE: 60Kg/m (UIC 60Kg/m) IR MAIN LINE: 52Kg/m	Difference between FL- RL (Below Rail Seat)	
	IR Line	DFC
	172mm	172mm
RUBBER PAD	6mm	10mm
SLEEPER DEPTH	210mm	210mm
BALLAST CUSHION	300mm	350mm
Total Depth (FL TO RL)	688mm	742mm

OWNER



डेडीकेड फ्रेट कोरिडोर

DEDICATED FREIGHT CORRIDOR CORPORATION OF INDIA LTD.
(A GOVERNMENT OF INDIA ENTERPRISE)
PROJECT OFFICE (AMBALA UNIT): OLD RAILWAY COLONY (NEAR
ANAND MARKET), AMBALA CANTT-133001.
CORPORATE IDENTITY NO. : U60232DL2006GOI155068

ENGINEER:

 DB Engineering & Consulting GmbH
Deutsche Bahn Engineering & Consulting GmbH

CONTRACTOR: GIL - TPL JV

SUBMITTED BY	GIL - TPL JV		
	DATED	NAME	SIGNATURE
PREPARED BY			
CHECKED BY	21.10.2024	VIJAY PRATAP	
APPROVED BY	21.10.2024	PARASURAM KOTYADA	

APPROVED BY	DEUTSCHE BAHN ENGINEERING & CONSULTING GMBH		
	DATED	NAME	SIGNATURE
Sr. DE/CHIEF ENGINEER		SURESH K.YALANGI	
CHIEF TRACK ENGINEER		RAJ PAL SINGH	
T.L.		H.D. VIDJAK	

STAMP	A AS-BUILT DRAWING TR. Ref.:..... ENGINEER Sign.:		
EMPLOYER (DFCCIL);	DEDICATED FREIGHT CORRIDOR CORPORATION OF INDIA LTD		

AS BUILT DRAWING	
TITLE AS-BUILT PLAN AND PROFILE FROM IR KM: 356.000 TO 356.500 FROM DFC KM: 1246.878 TO 1247.378	DFCC APPR. NO. - ENGG. APPR. NO. - DRG. NO. -301-2/AL/A/1338 SHEET NO. : 1 OF 1 DATE : 21.10.2024
	STATUS A

TR.