
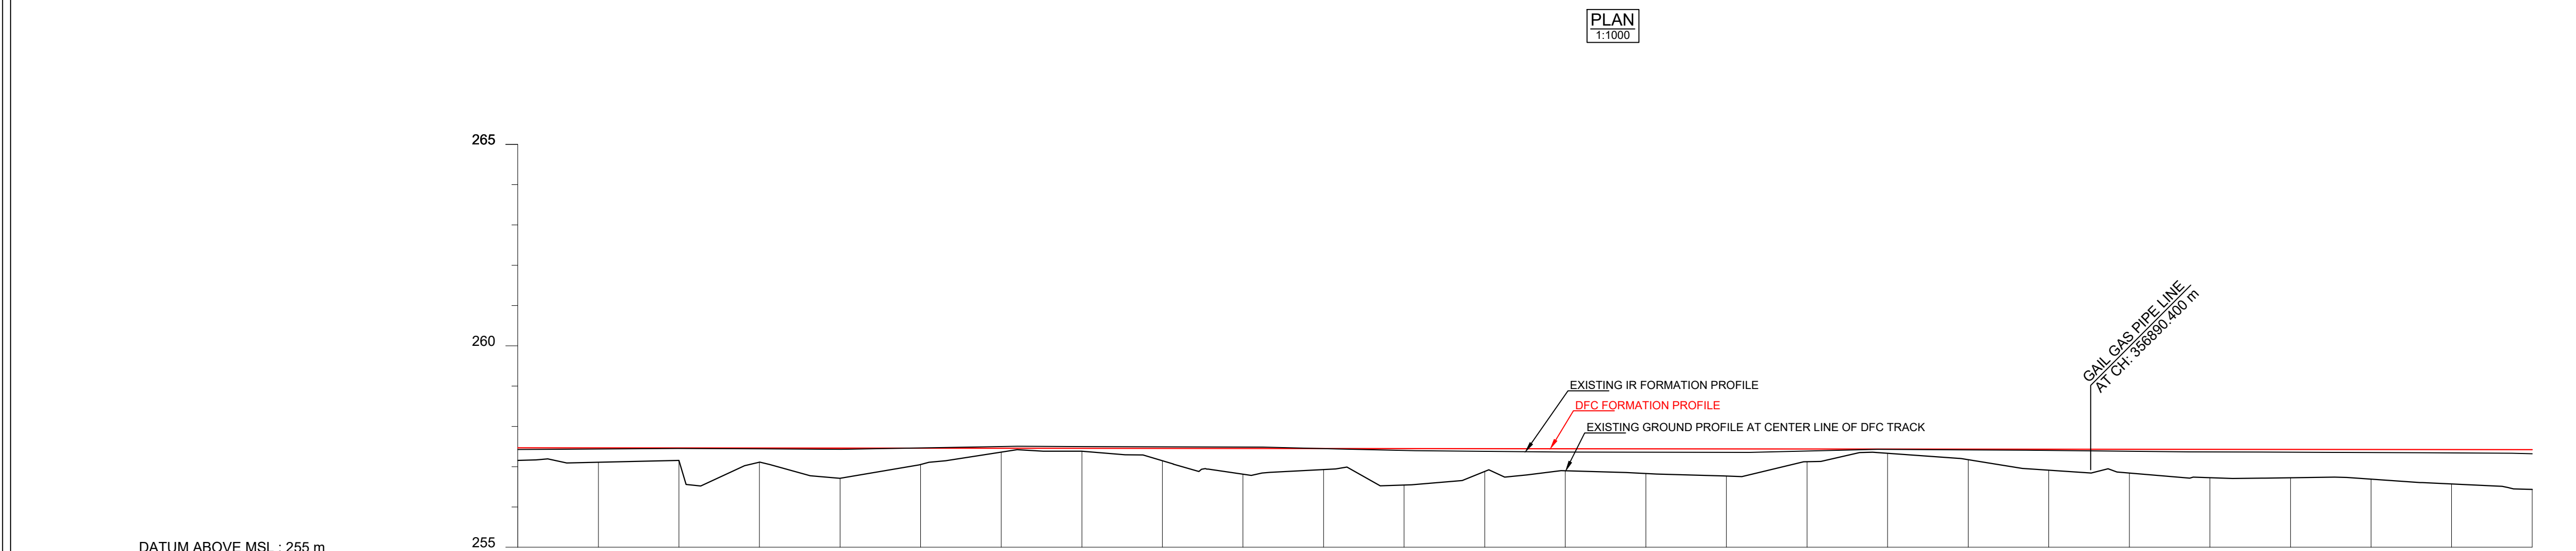


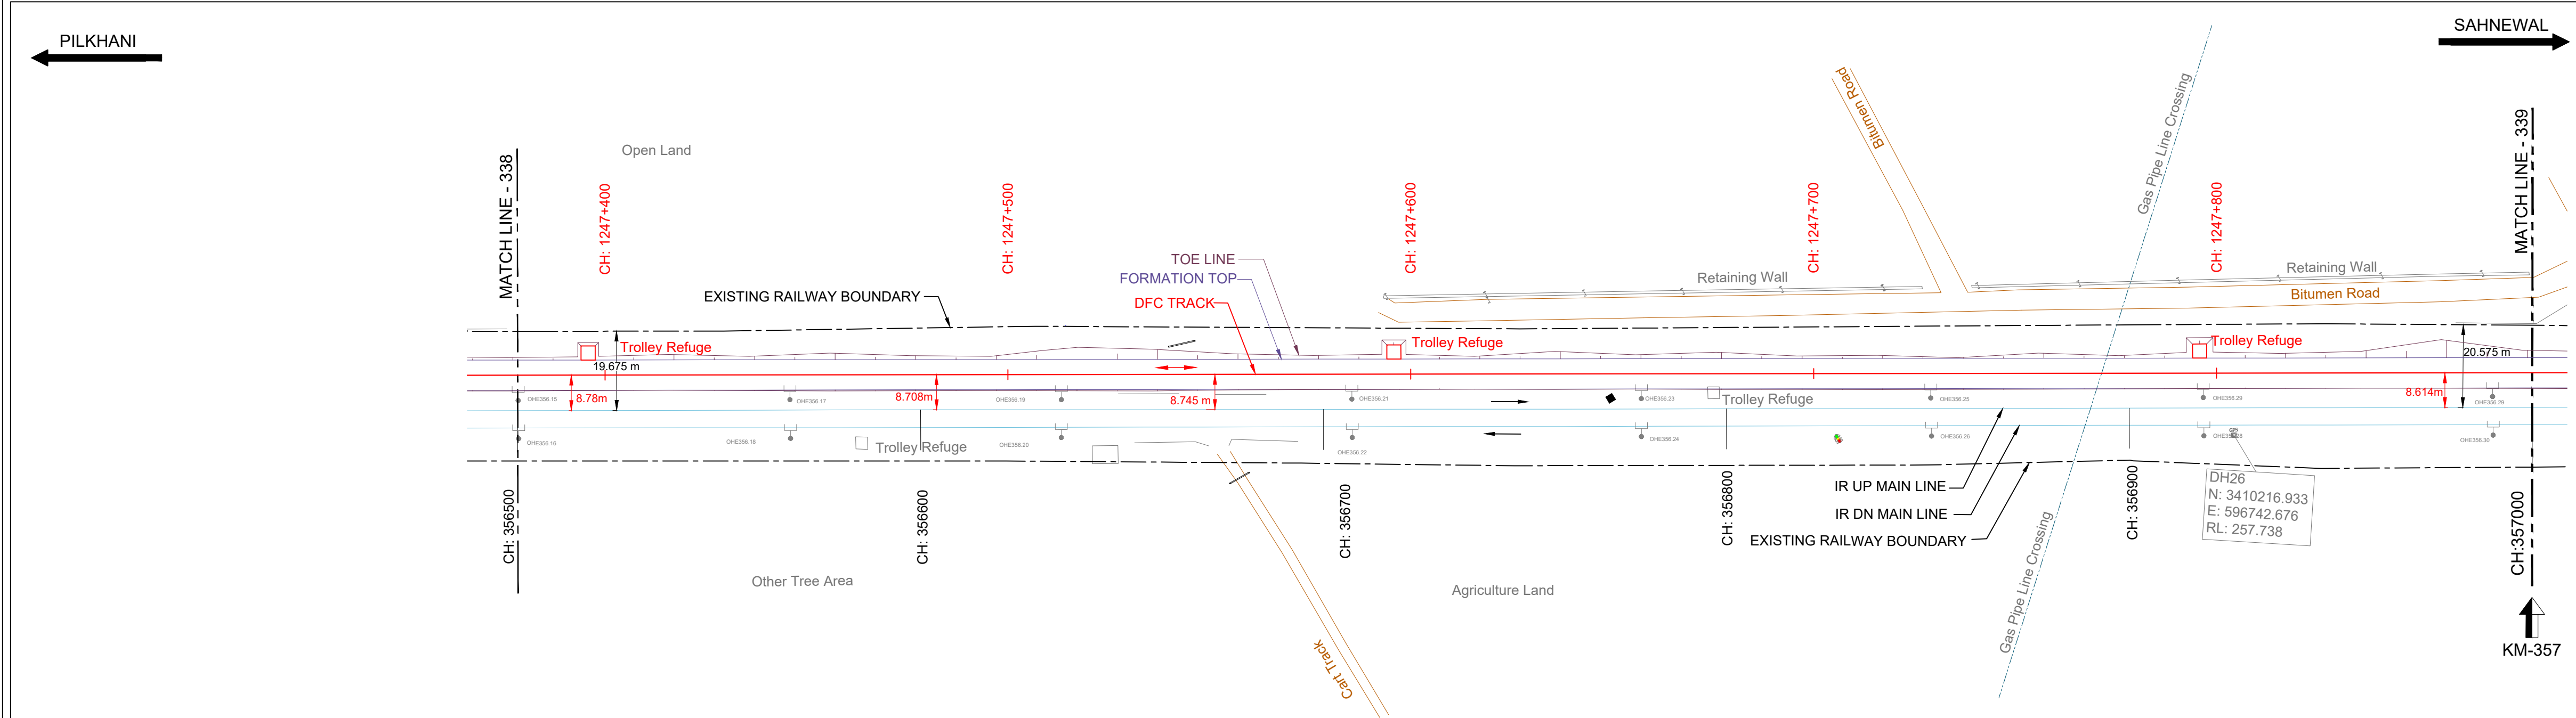

HORIZONTAL ALIGNMENT	L = 5018.785m																			
VERTICAL ALIGNMENT	L = 1490.145 m 1 IN 11127.847 F																			
TRACK DISTANCE FROM EXISTING NEAREST IR UP MAIN LINE TO DFC MAIN LINE	8.787	8.776	8.764	8.745	8.724	8.710	8.697	8.679	8.657	8.633	8.613	8.594								
HEIGHT OF BANKING(+) / DEPTH OF CUTTING(-) (PFL-GL)	+0.315	+0.357	+0.310	+0.353	+0.752	+0.404	+0.097	+0.072	+0.309	+0.641	+0.523	+0.904	+0.584	+0.548	+0.613	+0.673	+0.316	+0.106	+0.282	+0.522
EXG GROUND LEVEL AT CENTER LINE OF DFC TRACK (GL)	257.155	257.111	257.156	257.112	256.986	257.112	256.986	257.112	256.986	257.112	256.986	257.112	256.986	257.112	256.986	257.112	256.986	257.112	256.986	257.112
EXG GROUND LEVEL AT TOE LOCATION OF DFC TRACK	257.071	256.896	257.156	257.112	256.986	257.112	256.986	257.112	256.986	257.112	256.986	257.112	256.986	257.112	256.986	257.112	256.986	257.112	256.986	257.112
DIFFERENCE BETWEEN DFC FORMATION LEVEL AND EXG.FORMATION LEVEL (PFL-EFL)	0.045	0.029	0.015	0.023	0.029	-0.007	-0.042	-0.043	-0.037	-0.034	0.002	0.047	0.066	0.082	0.084	0.086	0.051	0.009	0.020	0.033
DFC FORMATION LEVEL (PFL)	257.470	257.468	257.466	257.465	257.463	257.461	257.459	257.457	257.456	257.454	257.452	257.450	257.448	257.447	257.445	257.443	257.441	257.439	257.438	257.436
EXG. FORMATION LEVEL OF EXG IR UP MAIN LINE (EFL)	257.425	257.439	257.451	257.442	257.434	257.468	257.501	257.500	257.493	257.488	257.450	257.403	257.382	257.365	257.361	257.357	257.390	257.430	257.418	257.403
DIFFERENCE BETWEEN DFC RAIL LEVEL AND EXG. RAIL LEVEL (PRL - ERL)	0.086	0.070	0.056	0.063	0.070	0.034	-0.001	-0.002	0.004	0.007	0.043	0.088	0.107	0.122	0.125	0.127	0.092	0.050	0.081	0.074
DFC RAIL LEVEL (PRL)	258.163	258.181	258.179	258.178	258.176	258.174	258.172	258.170	258.165	258.167	258.165	258.163	258.161	258.160	258.158	258.156	258.154	258.152	258.151	258.149
EXG.RAIL LEVEL OF NEAREST IR UP MAIN LINE(ERL)	258.097	258.111	258.123	258.114	258.106	258.140	258.173	258.172	258.165	258.160	258.122	258.075	258.054	258.037	258.033	258.029	258.062	258.102	258.090	258.075
EQUIVALENT CHAINE ON DFC TRACK	1247377.7	1247397.7	1247417.7	1247437.7	1247457.7	1247477.7	1247497.7	1247517.7	1247537.7	1247557.7	1247577.7	1247597.7	1247617.7	1247637.7	1247657.7	1247677.7	1247697.7	1247717.7	1247737.7	1247757.7
EXISTING IR CHAINE	356900.0	356920.0	356940.0	356960.0	356980.0	356990.0	357000.0	357010.0	357020.0	357030.0	357040.0	357050.0	357060.0	357070.0	357080.0	357090.0	357100.0	357110.0	357120.0	357130.0

L - SECTION

NOTE:-

- DFCC WORKS ARE SHOWN IN RED.
- IR NEW WORKS ARE SHOWN IN VIOLET.
- ALL DIMENSIONS ARE SHOWN IN METRES.
- THIS DRAWING IS PREPARED BASED ON LATEST SURVEY DATA HELD ON APRIL-2022. GTS BENCH MARK OF 261.850M CONSIDERED ON TOP OF CANAL BRIDGE ABUTMENT AT DORAHA VILLAGE ALONG THE NH1.
- DFC NEW CHAINE OF 1075.950M IS WITH REFERENCE TO THE IR KM OF 187.500KM END OF KM OF CP-303(SECTION P-3 PILKHANI END) AGAINST THE EXISTING DFC CHAINE. 116277.742M ISSUED VIDE LETTER NO. COM/DFCC/UMS/SURVEY/2021-301-230116-011173 DT. 17.01.2023.
- BALLAST PROFILE HAS BEEN PROVIDED ACCORDING TO THE CLAUSE 1.11.3 OF STANDARD SCHEDULE OF DIMENSION(EASTERN CORRIDOR) & THE BALLAST CUSHION DIMENSION SHOWN IN 35CM ON GE-14 PARA 17. SPECIFICATIONS & RECOMMENDATIONS 2. TWO LAYER SYSTEM FIG.10.

REFERENCE DRAWINGS :-

- FOR KEY PLAN REFER DRAWING NO. 301-2/AL/0001
- FOR LEGEND AND ABBREVIATIONS REFER DRAWING NO. 301-2/AL/1000
- FOR TYPICAL SECTION OF BALLAST PROFILE (FL-RL) REFER DRG. NO. 301-2/TK/TFD/004 (TR.1952)

SCALE
HOR - 1:1000
VER - 1:100
SHEET SIZE : A1

LEGEND:

- IR TRACK
- DFCC TRACK
- DFCC FUTURE PROPOSALS
- STRUCTURE / BUILDING
- DFCC TOE LINE
- DFCC FORMATION
- RETAINING WALL
- ROAD
- STREAM, DRAIN, NALA, CANAL.
- POWER LINES
- TBM
- ELECTRIC POLE/OHE MAST
- IR RAILWAY BOUNDARY
- DFCC BOUNDARY

TYPICAL SECTION

TRACK STRUCTURE

RAIL SECTION: 60Kg/m (UIC 60Kg/m)	Difference between FL- RL (Below Rail Seat)	
DFC LINE: 60Kg/m (UIC 60Kg/m)	IR Line	DFC
IR MAIN LINE: 52Kg/m	172mm	172mm
RUBBER PAD	6mm	10mm
SLEEPER DEPTH	210mm	210mm
BALLAST CUSHION	300mm	350mm
Total Depth (FL TO RL)	688mm	742mm

OWNER
DEDICATED FREIGHT CORRIDOR CORPORATION OF INDIA LTD.
(A GOVERNMENT OF INDIA ENTERPRISE)
PROJECT OFFICE/AMBALA UNIT: OLD RAILWAY COLONY (NEAR ANAND MARKET),AMBALA CANTT-133001.
CORPORATE IDENTITY NO. : U60232DL2006GGI155068

ENGINEER:
DB Engineering & Consulting GmbH
Deutsche Bahn Engineering & Consulting GmbH

CONTRACTOR:
GIL - TPL JV
GAR TATA

SUBMITTED BY	GIL - TPL JV		
	DATED	NAME	SIGNATURE
PREPARED BY			
CHECKED BY	21.10.2024	VIJAY PRATAP	
APPROVED BY	21.10.2024	PARASURAM KOTYADA	
APPROVED BY	DEUTSCHE BAHN ENGINEERING & CONSULTING GMBH		
	DATED	NAME	SIGNATURE
Sr. DE./CHIEF ENGINEER		SURESH K.YALANGI	
CHIEF TRACK ENGINEER		RAJ PAL SINGH	
T.L.		H.D. VIDJAK	

STAMP
A AS-BUILT DRAWING
TR. Ref.:.....
ENGINEER Sign.:.....

EMPLOYER (DFCCIL): DEDICATED FREIGHT CORRIDOR CORPORATION OF INDIA LTD.

AS BUILT DRAWING

TITLE
AS-BUILT PLAN AND PROFILE
FROM IR KM: 356.500 TO 357.000
FROM DFC KM: 1247.378 TO 1247.878

DFCC APPR. NO. -
ENGG. APPR. NO. -
DRG. NO. :301-2/AL/A/1339
SHEET NO. : 1 OF 1
DATE : 21.10.2024

STATUS
A

TR.