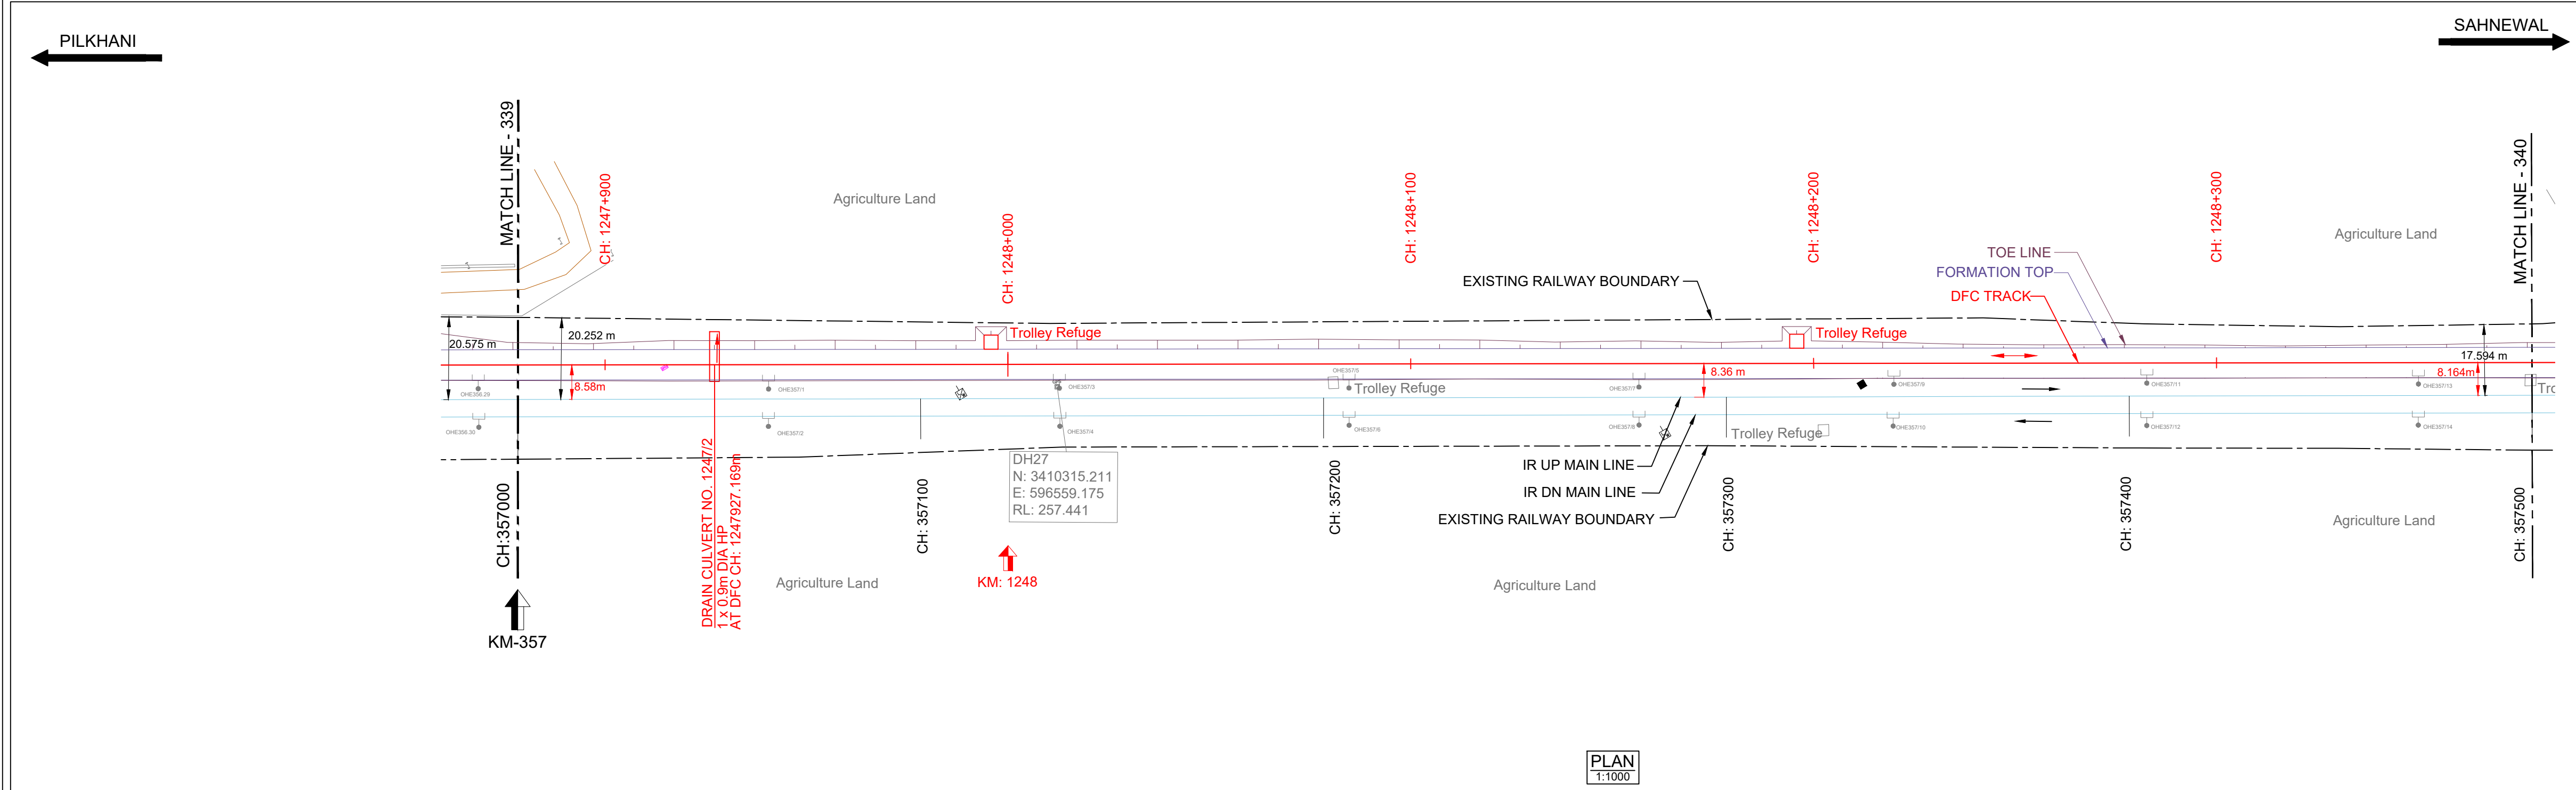


HORIZONTAL ALIGNMENT	L = 5018.785m																			
VERTICAL ALIGNMENT	L = 1490.145 m 1 IN 11127.847 F																			
TRACK DISTANCE FROM EXISTING NEAREST IR UP MAIN LINE TO DFC MAIN LINE	8.594	8.572	8.551	8.552	8.554	8.544	8.535	8.526	8.498	8.461	8.438	8.429	8.420	8.396	8.372	8.353	8.335	8.307	8.279	8.253
HEIGHT OF BANKING(+) / DEPTH OF CUTTING(-) (PFL-GL)	+0.989	+1.022	+0.975	+0.868	+0.767	+0.773	+0.791	+0.809	+0.842	+0.892	+0.855	+0.610	+0.370	+0.503	+0.540	+0.526	+0.447	+0.399	+0.232	+0.184
EXG GROUND LEVEL AT CENTER LINE OF DFC TRACK (GL)	256.436	256.401	256.446	256.552	256.651	256.643	256.623	256.603	256.569	256.517	256.552	256.795	257.033	256.899	256.860	256.872	256.949	256.995	257.161	257.207
EXG GROUND LEVEL AT TOE LOCATION OF DFC TRACK	256.452	256.490	256.188	256.225	256.188	256.252	256.255	256.200	256.213	256.209	256.056	256.192	256.229	256.513	256.376	256.552	256.345	256.563	256.818	256.910
DIFFERENCE BETWEEN DFC FORMATION LEVEL AND EXG.FORMATION LEVEL.(PFL-EFL)	0.103	0.150	0.196	0.193	0.189	0.202	0.217	0.231	0.250	0.271	0.280	0.276	0.272	0.255	0.238	0.243	0.253	0.254	0.252	0.250
DFC FORMATION LEVEL (PFL)	257.425	257.423	257.421	257.420	257.418	257.416	257.414	257.412	257.411	257.409	257.407	257.405	257.403	257.402	257.398	257.400	257.396	257.394	257.393	257.391
EXG. FORMATION LEVEL OF EXG IR UP MAIN LINE (EFL)	257.322	257.273	257.225	257.227	257.229	257.214	257.197	257.181	257.161	257.138	257.127	257.129	257.131	257.147	257.162	257.155	257.143	257.140	257.141	257.141
DIFFERENCE BETWEEN DFC RAIL LEVEL AND EXG. RAIL LEVEL (PRL - ERL)	0.144	0.191	0.238	0.233	0.229	0.243	0.258	0.273	0.281	0.312	0.321	0.317	0.314	0.296	0.279	0.284	0.295	0.295	0.293	0.291
DFC RAIL LEVEL (PRL)	258.138	258.136	258.134	258.133	258.131	258.129	258.127	258.125	258.124	258.122	258.120	258.118	258.116	258.115	258.113	258.111	258.109	258.107	258.106	258.104
EXG.RAIL LEVEL OF NEAREST IR UP MAIN LINE(ERL)	257.994	257.945	257.897	257.899	257.901	257.886	257.889	257.853	257.833	257.810	257.799	257.801	257.803	257.819	257.834	257.827	257.815	257.812	257.813	257.813
EQUIVALENT CHAINAGE ON DFC TRACK	-1247877.8	-1247897.7	-1247917.7	-1247937.7	-1247957.7	-1247977.7	-1247997.7	-1248017.7	-1248037.7	-1248057.7	-1248077.7	-1248097.7	-1248117.7	-1248137.7	-1248157.7	-1248177.7	-1248197.7	-1248217.7	-1248237.7	-1248257.7
EXISTING IR CHAINAGE	357000.0	357020.0	357040.0	357060.0	357080.0	357100.0	357120.0	357140.0	357160.0	357180.0	357200.0	357220.0	357240.0	357260.0	357280.0	357300.0	357320.0	357340.0	357360.0	357380.0

NOTE:-

- DFCC WORKS ARE SHOWN IN RED.
- IR NEW WORKS ARE SHOWN IN VIOLET.
- ALL DIMENSIONS ARE SHOWN IN METRES.
- THIS DRAWING IS PREPARED BASED ON LATEST SURVEY DATA HELD ON APRIL-2022. GTS BENCH MARK OF 261.850M CONSIDERED ON TOP OF CANAL BRIDGE ABUTMENT AT DORANA VILLAGE ALONG THE NH1.
- DFC NEW CHAINAGE OF 1075.950M IS WITH REFERENCE TO THE IR KM OF 187.500KM END OF KM OF CP-303(SECTION P-3 PILKHANI END) AGAINST THE EXISTING DFC CHAINAGE. 116277.742M ISSUED VIDE LETTER NO. COM/DFCC/UM/SURVEY/2021-301-230116-011173 DT. 17.01.2023.
- BALLAST PROFILE HAS BEEN PROVIDED ACCORDING TO THE CLAUSE 1.11.3 OF STANDARD SCHEDULE OF DIMENSION(EASTERN CORRIDOR) & THE BALLAST CUSHION DIMENSION SHOWN IN 35CM ON GE-14 PARA 17. SPECIFICATIONS & RECOMMENDATIONS 2. TWO LAYER SYSTEM FIG.10.

REFERENCE DRAWINGS :-

- FOR KEY PLAN REFER DRAWING NO. 301-2/AL/0001
- FOR LEGEND AND ABBREVIATIONS REFER DRAWING NO. 301-2/AL/1000
- FOR TYPICAL SECTION OF BALLAST PROFILE (FL-RL) REFER DRG. NO. 301-2/TK/TFD/-004 (TR.1952)

LEGEND:

IR TRACK
DFCC TRACK
DFCC FUTURE PROPOSALS
STRUCTURE / BUILDING
DFCC TOE LINE
DFCC FORMATION
RETAINING WALL
ROAD
STREAM, DRAIN, NALA, CANAL.
FENCE
POWER LINES
TBM
ELECTRIC POLE/OHE MAST
IR RAILWAY BOUNDARY
DFCC BOUNDARY

SCALE

HOR - 1:1000
VER - 1:100
SHEET SIZE : A1

TYPICAL SECTION

TRACK STRUCTURE		
RAIL SECTION: 60Kg/m (UIC 60Kg/m) DFC LINE: 60Kg/m (UIC 60Kg/m) IR MAIN LINE: 52Kg/m	Difference between FL- RL (Below Rail Seat)	
	IR Line	DFC
	172mm	172mm
RUBBER PAD	6mm	10mm
SLEEPER DEPTH	210mm	210mm
BALLAST CUSHION	300mm	350mm
Total Depth (FL TO RL)	688mm	742mm

OWNER

DEDICATED FREIGHT CORRIDOR CORPORATION OF INDIA LTD.
(A GOVERNMENT OF INDIA ENTERPRISE)
PROJECT OFFICE(AMBALA UNIT): OLD RAILWAY COLONY (NEAR ANAND MARKET),AMBALA CANTT.-133001.
CORPORATE IDENTITY NO. : U60232DL2006GGI155068

ENGINEER:

DB Engineering & Consulting GmbH
Deutsche Bahn Engineering & Consulting GmbH

CONTRACTOR:

GIL - TPL JV
GAR TATA

SUBMITTED BY	GIL - TPL JV		
	DATED	NAME	SIGNATURE
PREPARED BY			
CHECKED BY	21.10.2024	VIJAY PRATAP	
APPROVED BY	21.10.2024	PARASURAM KOTYADA	
APPROVED BY	DEUTSCHE BAHN ENGINEERING & CONSULTING GMBH		
	DATED	NAME	SIGNATURE
Sr. DE./CHIEF ENGINEER		SURESH K.YALANGI	
CHIEF TRACK ENGINEER		RAJ PAL SINGH	
T.L.		H.D. VIDJAK	

STAMP

A AS-BUILT DRAWING
TR. Ref.:.....
ENGINEER Sign.:.....

EMPLOYER (DFCCIL): DEDICATED FREIGHT CORRIDOR CORPORATION OF INDIA LTD.

AS BUILT DRAWING

TITLE

AS-BUILT PLAN AND PROFILE

FROM IR KM: 357.000 TO 357.500
FROM DFC KM: 1247.878 TO 1248.378

DFCC APPR. NO. -
ENGG. APPR. NO. -
DRG. NO. :301-2/AL/A/1340
SHEET NO. :1 OF 1
DATE : 21.10.2024

STATUS
A