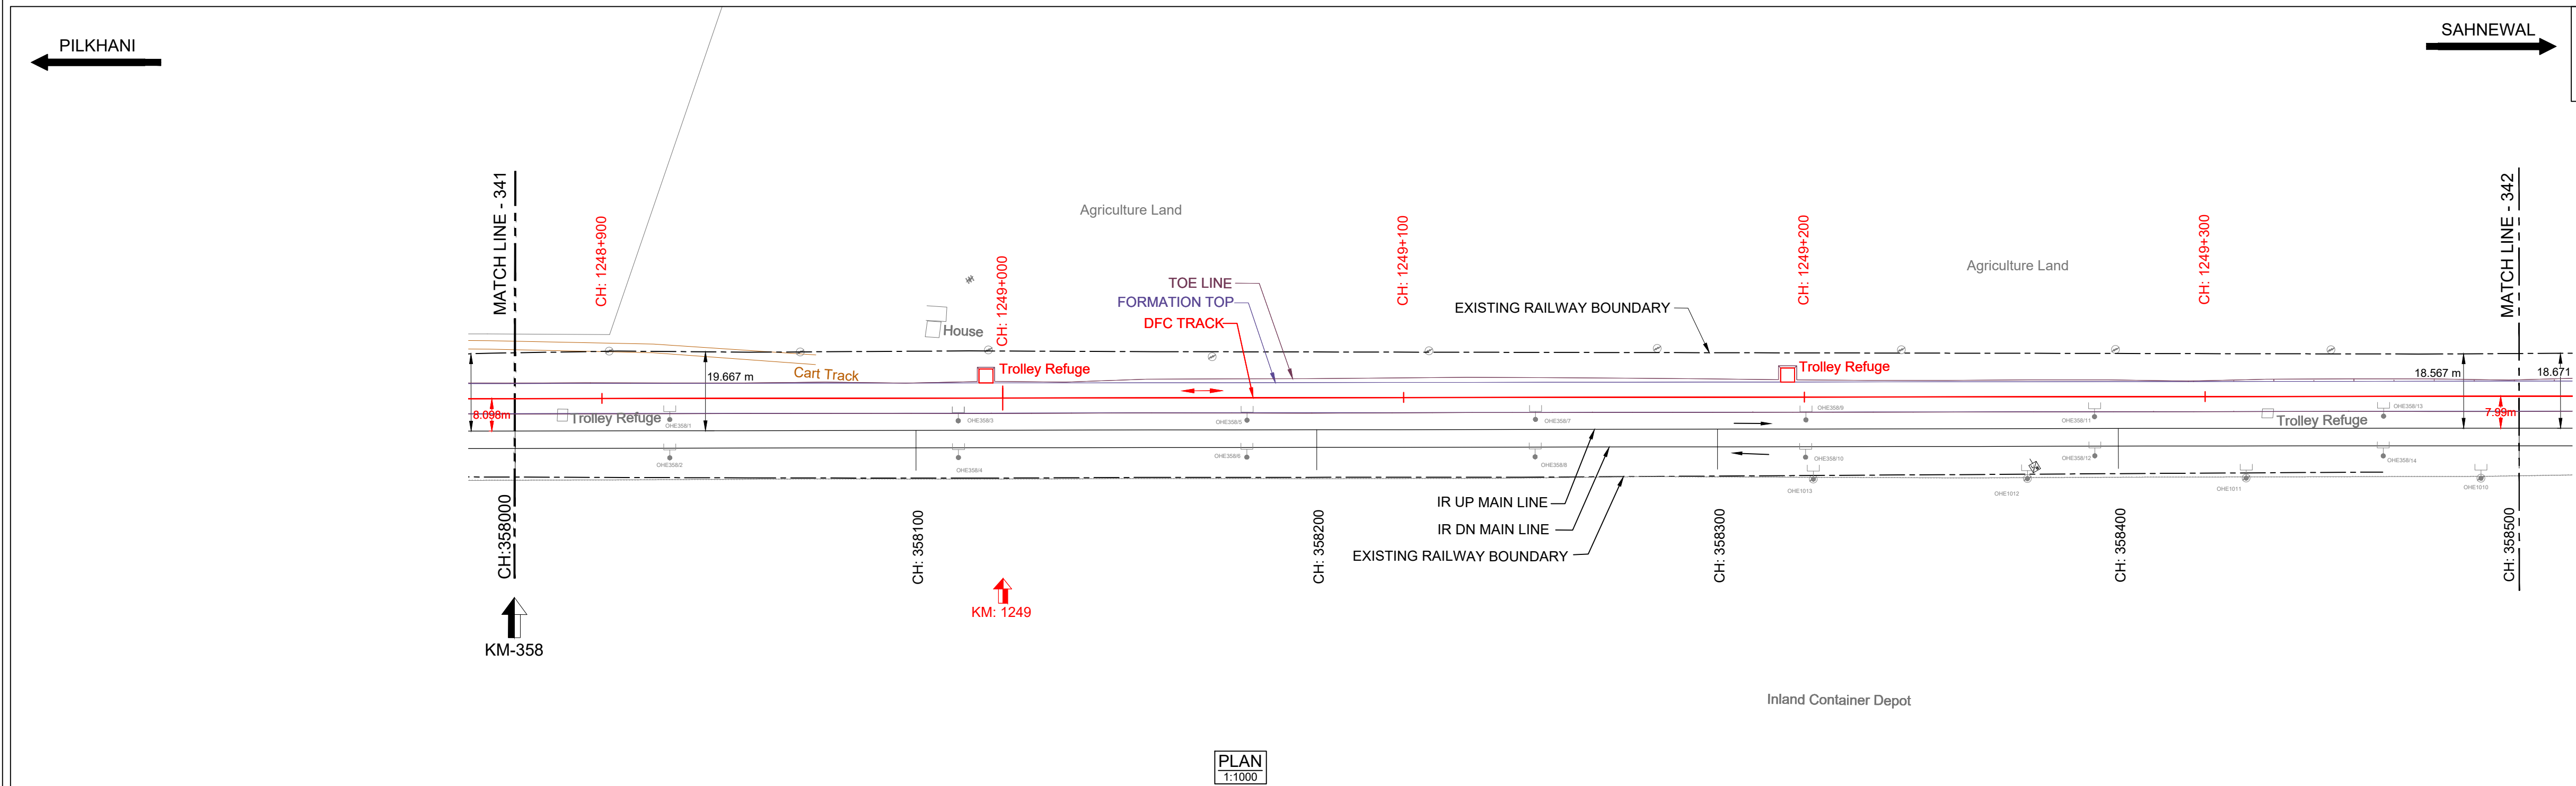


DATUM ABOVE MSL : 255 m

HORIZONTAL ALIGNMENT	L = 5018.785m																			
VERTICAL ALIGNMENT	L=1180.0 m 1 IN 1321.389 F																			
TRACK DISTANCE FROM EXISTING NEAREST IR UP MAIN LINE TO DFC MAIN LINE	8.097																			
HEIGHT OF BANKING(+) / DEPTH OF CUTTING(-) (PFL-GL)	+0.082																			
EXG GROUND LEVEL AT CENTER LINE OF DFC TRACK (GL)	-256.949	-257.000	-256.928	-256.860	-257.005	-257.134	-256.930	-257.016	-256.906	-257.451	-257.125	-257.155	-256.944	-257.843	-257.044	-257.638	-257.350	-257.863	-257.796	-257.983
EXG GROUND LEVEL AT TOE LOCATION OF DFC TRACK	-256.949	-257.000	-256.928	-256.860	-257.005	-257.134	-256.930	-257.016	-256.906	-257.451	-257.125	-257.155	-256.944	-257.843	-257.044	-257.638	-257.350	-257.863	-257.796	-257.983
DIFFERENCE BETWEEN DFC FORMATION LEVEL AND EXG.FORMATION LEVEL (PFL-EFL)	0.071		0.073	0.077	0.083	0.081	0.078	0.087	0.086	0.056	0.043	0.032	0.032	0.083	0.031	0.031	0.030	0.023	0.016	0.004
DFC FORMATION LEVEL (PFL)	-257.011	-257.082	-257.067	-257.052	-257.037	-257.022	-257.006	-257.006	-257.006	-256.882	-256.991	-256.887	-256.976	-256.961	-256.961	-256.882	-256.931	-256.855	-256.870	-256.855
EXG. FORMATION LEVEL OF EXG IR UP MAIN LINE (EFL)	-257.011	-257.082	-257.067	-257.052	-257.037	-257.022	-257.006	-257.006	-257.006	-256.882	-256.991	-256.887	-256.976	-256.961	-256.961	-256.882	-256.931	-256.855	-256.870	-256.855
DIFFERENCE BETWEEN DFC RAIL LEVEL AND EXG. RAIL LEVEL (PRL - ERL)	0.112		0.114	0.118	0.124	0.132	0.142	0.150	0.150	0.150	0.151	0.150	0.149	0.149	0.149	0.149	0.149	0.149	0.149	0.149
DFC RAIL LEVEL (PRL)	-257.795	-257.683	-257.780	-257.765	-257.750	-257.735	-257.719	-257.704	-257.704	-257.554	-257.704	-257.559	-257.689	-257.674	-257.674	-257.559	-257.644	-257.568	-257.668	-257.583
EXG.RAIL LEVEL OF NEAREST IR UP MAIN LINE(ERL)	-257.683	-257.683	-257.686	-257.647	-257.625	-257.602	-257.578	-257.554	-257.554	-257.389	-257.554	-257.389	-257.559	-257.544	-257.544	-257.389	-257.465	-257.389	-257.488	-257.387
EQUIVALENT CHAINAGE ON DFC TRACK	-1248877.6	-1248897.7	-1248917.7	-1248937.7	-1248957.7	-1248977.7	-1248997.7	-1249017.7	-1249037.7	-1249057.7	-1249077.7	-1249097.7	-1249117.7	-1249137.7	-1249157.7	-1249177.7	-1249197.7	-1249217.7	-1249237.7	-1249257.7
EXISTING IR CHAINAGE	358000.0	358020.0	358040.0	358060.0	358080.0	358100.0	358120.0	358140.0	358160.0	358180.0	358200.0	358220.0	358240.0	358260.0	358280.0	358300.0	358320.0	358340.0	358360.0	358380.0

L - SECTION


- NOTE:-
- DFCC WORKS ARE SHOWN IN RED.
 - IR NEW WORKS ARE SHOWN IN VIOLET.
 - ALL DIMENSIONS ARE SHOWN IN METRES.
 - THIS DRAWING IS PREPARED BASED ON LATEST SURVEY DATA HELD ON APRIL-2022. GTS BENCH MARK OF 261.850M CONSIDERED ON TOP OF CANAL BRIDGE ABUTMENT AT DORANA VILLAGE ALONG THE NH1.
 - DFC NEW CHAINAGE OF 1075.950M IS WITH REFERENCE TO THE IR KM OF 187.500KM END OF KM OF CP-303(SECTION P-3 PILKHANI END) AGAINST THE EXISTING DFC CHAINAGE. 116277.742M ISSUED VIDE LETTER NO. COM/DFCC/MB/SURVEY/2021-301-230116-011173 DT. 17.01.2023.
 - BALLAST PROFILE HAS BEEN PROVIDED ACCORDING TO THE CLAUSE 1.11.3 OF STANDARD SCHEDULE OF DIMENSION(EASTERN CORRIDOR) & THE BALLAST CUSHION DIMENSION SHOWN IN 35CM ON GE-14 PARA 17. SPECIFICATIONS & RECOMMENDATIONS 2. TWO LAYER SYSTEM FIG.10.

REFERENCE DRAWINGS :-

- FOR KEY PLAN REFER DRAWING NO. 301-2/AL/0001
- FOR LEGEND AND ABBREVIATIONS REFER DRAWING NO. 301-2/AL/1000
- FOR TYPICAL SECTION OF BALLAST PROFILE (FL-RL) REFER DRG. NO. 301-2/TK/TFDI-004 (TR.1952)

0	21.10.2024	SUBMISSION OF AS-BUILT DRAWING	FOR APPROVAL
REV.	DATE	REVISION DETAILS	PURPOSE OF ISSUE

SCALE	HOR - 1:1000 VER - 1:100 SHEET SIZE - A1	LEGEND:
IR TRACK		IR TRACK
DFCC TRACK		DFCC TRACK
DFCC FUTURE PROPOSALS		DFCC FUTURE PROPOSALS
STRUCTURE / BUILDING		STRUCTURE / BUILDING
DFCC TOE LINE		DFCC TOE LINE
DFCC FORMATION		DFCC FORMATION
RETAINING WALL		RETAINING WALL
ROAD		ROAD
STREAM, DRAIN, NALA, CANAL		STREAM, DRAIN, NALA, CANAL
FENCE		FENCE
POWER LINES		POWER LINES
TBM		TBM
ELECTRIC POLE/OHE MAST		ELECTRIC POLE/OHE MAST
IR RAILWAY BOUNDARY		IR RAILWAY BOUNDARY
DFCC BOUNDARY		DFCC BOUNDARY

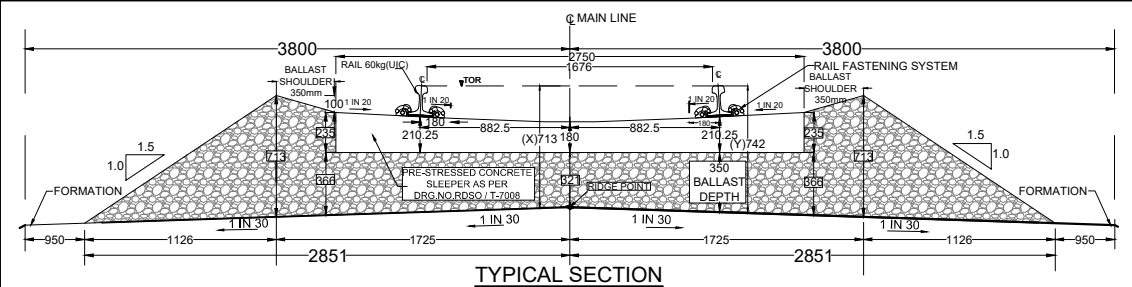

TRACK STRUCTURE		
RAIL SECTION: 60Kg/m (UIC 60Kg/m) DFC LINE: 60Kg/m (UIC 60Kg/m) IR MAIN LINE: 52Kg/m	Difference between FL - RL (Below Rail Seat)	
	IR Line	DFC
RUBBER PAD	172mm	172mm
SLEEPER DEPTH	210mm	210mm
BALLAST CUSHION	300mm	350mm
Total Depth (FL TO RL)	688mm	742mm

OWNER: DEDICATED FREIGHT CORRIDOR CORPORATION OF INDIA LTD.
(A GOVERNMENT OF INDIA ENTERPRISE)
PROJECT OFFICE(AMBALA UNIT): OLD RAILWAY COLONY (NEAR ANAND MARKET),AMBALA CANTT.-133001.
CORPORATE IDENTITY NO. : U60232DL2006GGI155068

ENGINEER: DB Engineering & Consulting GmbH
Deutsche Bahn Engineering & Consulting GmbH

CONTRACTOR: GIL - TPL JV
GAR TATA

SUBMITTED BY	GIL - TPL JV		
	DATED	NAME	SIGNATURE
PREPARED BY	21.10.2024	VIJAY PRATAP	
CHECKED BY	21.10.2024	PARASURAM KOTYADA	
APPROVED BY	DEUTSCHE BAHN ENGINEERING & CONSULTING GMBH		

	DATED	NAME	SIGNATURE
Sr. DE./CHIEF ENGINEER		SURESH K.YALANGI	
CHIEF TRACK ENGINEER		RAJ PAL SINGH	
T.L.		H.D. VIDJAK	

STAMP	A AS-BUILT DRAWING TR. Ref.:..... ENGINEER Sign.:.....		
EMPLOYER (DFCCIL):	DEDICATED FREIGHT CORRIDOR CORPORATION OF INDIA LTD.		

AS BUILT DRAWING			
TITLE	AS-BUILT PLAN AND PROFILE	DFCC APPR. NO. -	
	FROM IR KM: 358.000 TO 358.500	ENGG. APPR. NO. -	
	FROM DFC KM: 1248.878 TO 1249.378	DRG. NO. -301-2/AL/A/1342	
		SHEET NO. : 1 OF 1	STATUS
		DATE: 21.10.2024	A

TR.