



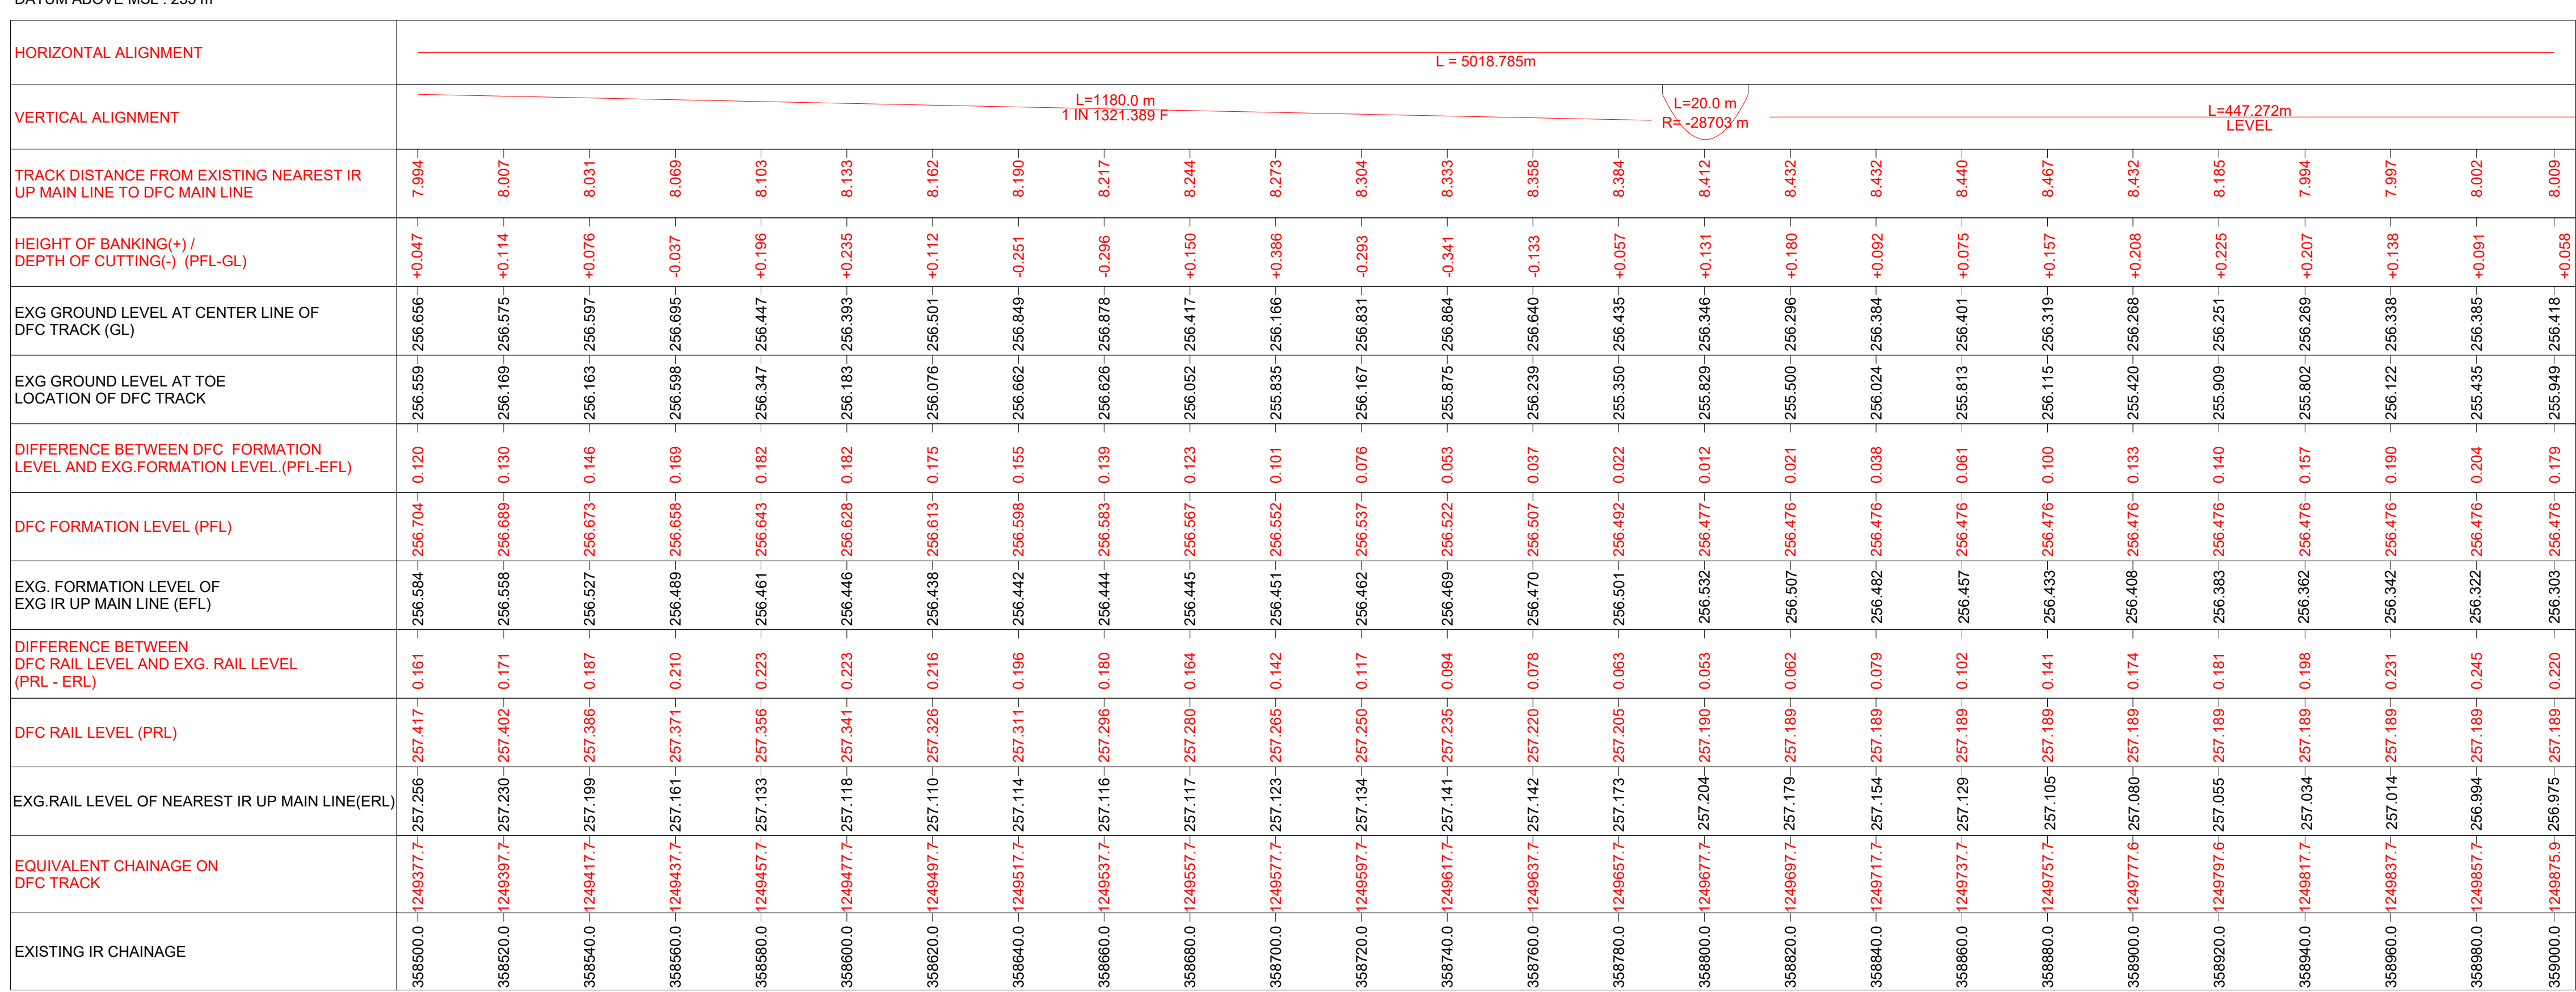

L - SECTION

				DRG NO. - 301-2/AL/A/1343		
NOTE:- 1. DFCO WORKS ARE SHOWN IN RED. 2. IR NEW WORKS ARE SHOWN IN VIOLET. 3. ALL DIMENSIONS ARE SHOWN IN METRES. 4. THIS DRAWING IS PREPARED BASED ON LATEST SURVEY DATA HELD ON APRIL-2022. GTS BENCH MARK OF 261.850M CONSIDERED ON TOP OF CANAL BRIDGE ABUTMENT AT DORAHA VILLAGE ALONG THE NH1. 5. DFCO NEW CHAINGE OF 1075.950M IS WITH REFERENCE TO THE IR KM OF 187.500KM END OF KM OF CP-303 (SECTION P-3 PILKHANI END) AGAINST THE EXISTING DFC CHAINGE 116277.742M ISSUED VIDE LETTER NO. CGM/DFCO/JMB/SURVEY/2021-301-230/116-01/1173 DT. 17.01.2023 6. BALLAST PROFILE HAS BEEN PROVIDED ACCORDING TO THE CLAUSE 1.11.3 OF STANDARD SCHEDULE OF DIMENSION(EASTERN CORRIDOR) & THE BALLAST CUSHION DIMENSION SHOWN IN 35CM ON GE-14 PARA 17. SPECIFICATIONS & RECOMMENDATIONS 2. TWO LAYER SYSTEM FIG.10.						
REFERENCE DRAWINGS :- 1. FOR KEY PLAN REFER DRAWING NO. 301-2/AL/0001 2. FOR LEGEND AND ABBREVIATIONS REFER DRAWING NO. 301-2/AL/1000 3. FOR TYPICAL SECTION OF BALLAST PROFILE (FL-RL) REFER DRG. NO. 301-2/TK/TFD/-004 (TR 1952)						
0	21.10.2024	SUBMISSION OF AS-BUILT DRAWING		FOR APPROVAL		
REV.	DATE	REVISION DETAILS		PURPOSE OF ISSUE		
SCALE HOR - 1:1000 VER - 1:100 SHEET SIZE : A1 LEGEND: <table border="0" style="width: 100%;"> <tr> <td style="vertical-align: top;"> IR TRACK DFCO TRACK DFCO FUTURE PROPOSALS STRUCTURE / BUILDING DFCO TOE LINE DFCO FORMAL RETAINING WALL ROAD STREAM, DRAIN, NALA, CANAL FENCE POWER LINES TBM ELECTRIC POLE/OHE MAST IR RAILWAY BOUNDARY DFCO BOUNDARY </td> <td style="vertical-align: top; text-align: center;"> </td> </tr> </table>					IR TRACK DFCO TRACK DFCO FUTURE PROPOSALS STRUCTURE / BUILDING DFCO TOE LINE DFCO FORMAL RETAINING WALL ROAD STREAM, DRAIN, NALA, CANAL FENCE POWER LINES TBM ELECTRIC POLE/OHE MAST IR RAILWAY BOUNDARY DFCO BOUNDARY	
IR TRACK DFCO TRACK DFCO FUTURE PROPOSALS STRUCTURE / BUILDING DFCO TOE LINE DFCO FORMAL RETAINING WALL ROAD STREAM, DRAIN, NALA, CANAL FENCE POWER LINES TBM ELECTRIC POLE/OHE MAST IR RAILWAY BOUNDARY DFCO BOUNDARY						

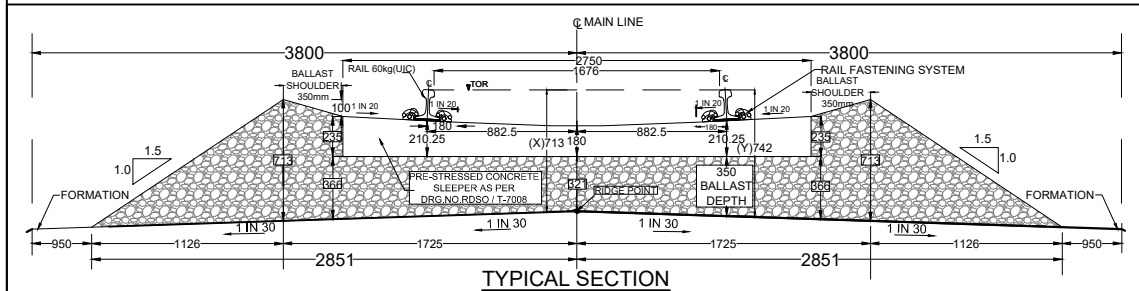

TRACK STRUCTURE		
RAIL SECTION: 60Kg/m (UIC 60Kg/m) DFC LINE: 60Kg/m (UIC 60Kg/m) IR MAIN LINE: 52Kg/m	Difference between FL- RL (Below Rail Seat)	
	IR Line	DFC
	172mm	172mm
RUBBER PAD	6mm	10mm
SLEEPER DEPTH	210mm	210mm
BALLAST CUSHION	300mm	350mm
Total Depth (FL TO RL)	688mm	742mm

OWNER



डेडीकेटेड फ्रीट कोरीडोर

DEDICATED FREIGHT CORRIDOR CORPORATION OF INDIA LTD.

(A GOVERNMENT OF INDIA ENTERPRISE)

PROJECT OFFICE (AMBALA UNIT): OLD RAILWAY COLONY (NEAR ANAND MARKET), AMBALA CANTT-133001.

CORPORATE IDENTITY NO.: U60232DL2006G0155068

ENGINEER:

 DB Engineering &
Consulting GmbH
Deutsche Bahn Engineering & Consulting GmbH

CONTRACTOR: GIL - TPL JV

SUBMITTED BY	GIL - TPL JV		
	DATED	NAME	SIGNATURE
PREPARED BY			
CHECKED BY	21.10.2024	VIJAY PRATAP	
APPROVED BY	21.10.2024	PARASURAM KOTYADA	

APPROVED BY	DEUTSCHE BAHN ENGINEERING & CONSULTING GMBH		
	DATED	NAME	SIGNATURE
Sr. DE/CHIEF ENGINEER		SURESH K.YALANGI	
CHIEF TRACK ENGINEER		RAJ PAL SINGH	
T.L.		H.D. VIDJAK	

	AS BUILT DRAWING
--	------------------

STAMP A AS-BUILT DRAWING
TR. Ref.....

ENGINEER Sign.: _____

EMPLOYER (DFCCIL):	DEDICATED FREIGHT CORRIDOR CORPORATION OF INDIA L
--------------------	---

--	--	--	--

--	--	--	--

--	--	--	--

--	--	--	--

AS BUILT DRAWING

TITLE	DFCC APPR. NO. -
-------	------------------

AS-BUILT PLAN AND PROFILE	ENGG. APPR. NO. -
	DES. NO. - 001-01A1/A/1010

FROM IR KM: 358.500 TO 359.000	DRG. NO.: 501-Z/A/A/1343	STATUS
FROM DFC KM: 1249.378 TO 1249.876	SHEET NO.: 1 OF 1	

	DATE :21.10.2024	A
--	------------------	---

IR.