


PILKHANI

SAHNEWAL

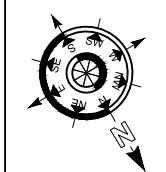

NOTE:-

- DFCC WORKS ARE SHOWN IN RED.
- IR NEW WORKS ARE SHOWN IN VIOLET.
- ALL DIMENSIONS ARE SHOWN IN METRES.
- THIS DRAWING IS PREPARED BASED ON LATEST SURVEY DATA HELD ON APRIL-2022. GTS BENCH MARK OF 261.850M CONSIDERED ON TOP OF CANAL BRIDGE ABUTMENT AT DORANA VILLAGE ALONG THE NH1.
- DFC NEW CHAINAGE OF 1075.950M IS WITH REFERENCE TO THE IR KM OF 187.500KM END OF KM OF CP-303(SECTION P-3 PILKHANI END) AGAINST THE EXISTING DFC CHAINAGE. 116277.742M ISSUED VIDE LETTER NO. COM/DFCC/UM/SURVEY/2021-301-230116-01173.DT. 17.01.2023.
- BALLAST PROFILE HAS BEEN PROVIDED ACCORDING TO THE CLAUSE 1.11.3 OF STANDARD SCHEDULE OF DIMENSION(EASTERN CORRIDOR) & THE BALLAST CUSHION DIMESION SHOWN IN 35CM ON GE-14 PARA 17. SPECIFICATIONS & RECOMMENDATIONS 2. TWO LAYER SYSTEM FIG.10.

DRG NO. - 301-2/AL/A/1346


REFERENCE DRAWINGS :-

- FOR KEY PLAN REFER DRAWING NO. 301-2/AL/0001
- FOR LEGEND AND ABBREVIATIONS REFER DRAWING NO. 301-2/AL/1000
- FOR TYPICAL SECTION OF BALLAST PROFILE (FL-RL) REFER DRG. NO. 301-2/TK/TFDI-004 (TR.1952)

REV.	DATE	REVISION DETAILS	PURPOSE OF ISSUE
0	21.10.2024	SUBMISSION OF AS-BUILT DRAWING	FOR APPROVAL

LEGEND:

SCALE	HOR - 1:1000 VER - 1:100 SHEET SIZE : A1	IR TRACK DFCC TRACK DFCC FUTURE PROPOSALS STRUCTURE / BUILDING DFCC TOE LINE DFCC FORMATION RETAINING WALL ROAD STREAM, DRAIN, NALA, CANAL. FENCE POWER LINES TBM ELECTRIC POLE/OHE MAST IR RAILWAY BOUNDARY DFCC BOUNDARY
-------	--	--

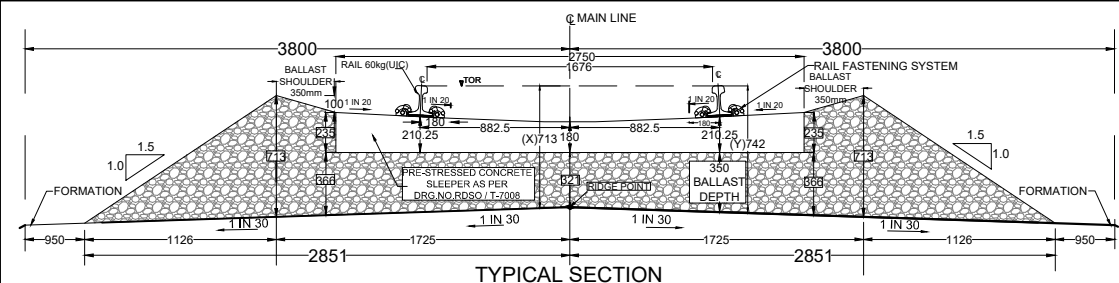

TRACK STRUCTURE		
RAIL SECTION: 60Kg/m (UIC 60Kg/m) DFC LINE: 60Kg/m (UIC 60Kg/m) IR MAIN LINE: 52Kg/m	Difference between FL - RL (Below Rail Seat)	
	IR Line	DFC
RUBBER PAD	172mm	172mm
SLEEPER DEPTH	6mm	10mm
SLEEPER DEPTH	210mm	210mm
BALLAST CUSHION	300mm	350mm
Total Depth (FL TO RL)	688mm	742mm

OWNER
dedicated freight corridor corporation of india ltd.
(A GOVERNMENT OF INDIA ENTERPRISE)
PROJECT OFFICE (AMBALA UNIT): OLD RAILWAY COLONY (NEAR ANAND MARKET), AMBALA CANTT-133001.
CORPORATE IDENTITY NO. : U60232DL2006GGI155068

ENGINEER:
DB Engineering & Consulting GmbH
Deutsche Bahn Engineering & Consulting GmbH

CONTRACTOR:
GIL - TPL JV
GAR TATA

SUBMITTED BY	GIL - TPL JV		
	DATED	NAME	SIGNATURE
PREPARED BY			
CHECKED BY	21.10.2024	VIJAY PRATAP	
APPROVED BY	21.10.2024	PARASURAM KOTYADA	



APPROVED BY	DEUTSCHE BAHN ENGINEERING & CONSULTING GMBH		
	DATED	NAME	SIGNATURE
Sr. DE./CHIEF ENGINEER		SURESH K.YALANGI	
CHIEF TRACK ENGINEER		RAJ PAL SINGH	
T.L.		H.D. VIDJAK	

STAMP	A AS-BUILT DRAWING TR. Ref.:..... ENGINEER Sign.:.....
EMPLOYER (DFCCIL):	DEDICATED FREIGHT CORRIDOR CORPORATION OF INDIA LTD.

AS BUILT DRAWING

TITLE	DFCC APPR. NO. -	STATUS A
AS-BUILT PLAN AND PROFILE	ENGG. APPR. NO. -	
FROM IR KM: 360.000 TO 360.200	DRG. NO. -301-2/AL/A/1346	
FROM DFC KM: 1250.876 to 1251.031	SHEET NO. : 1 OF 1	
	DATE: 21.10.2024	

TR.

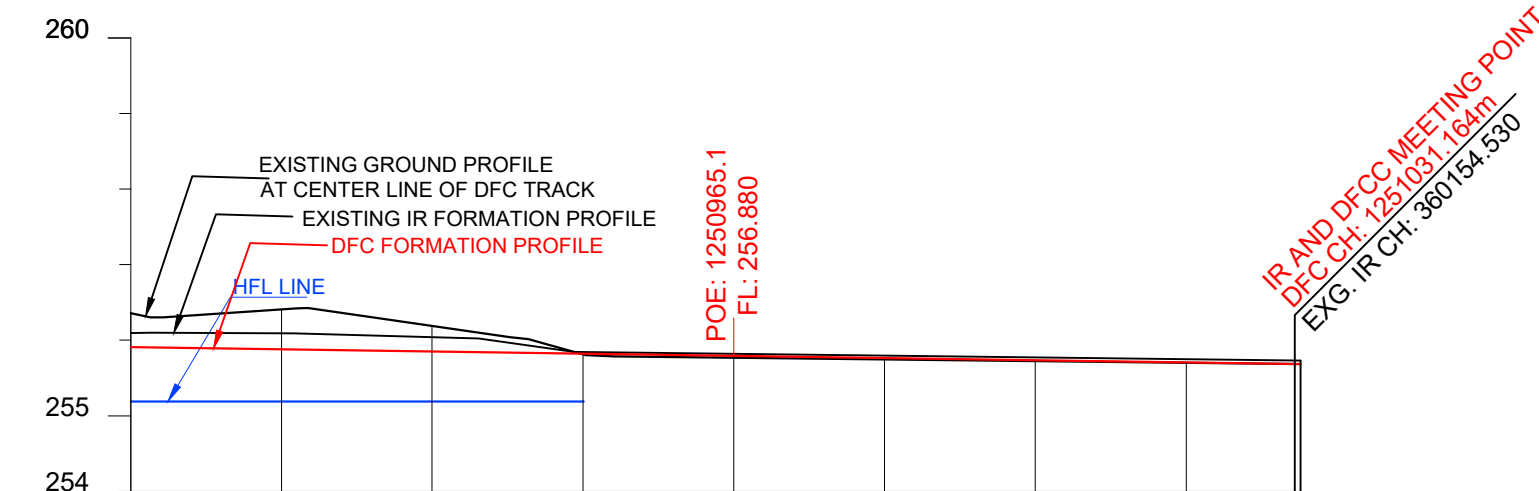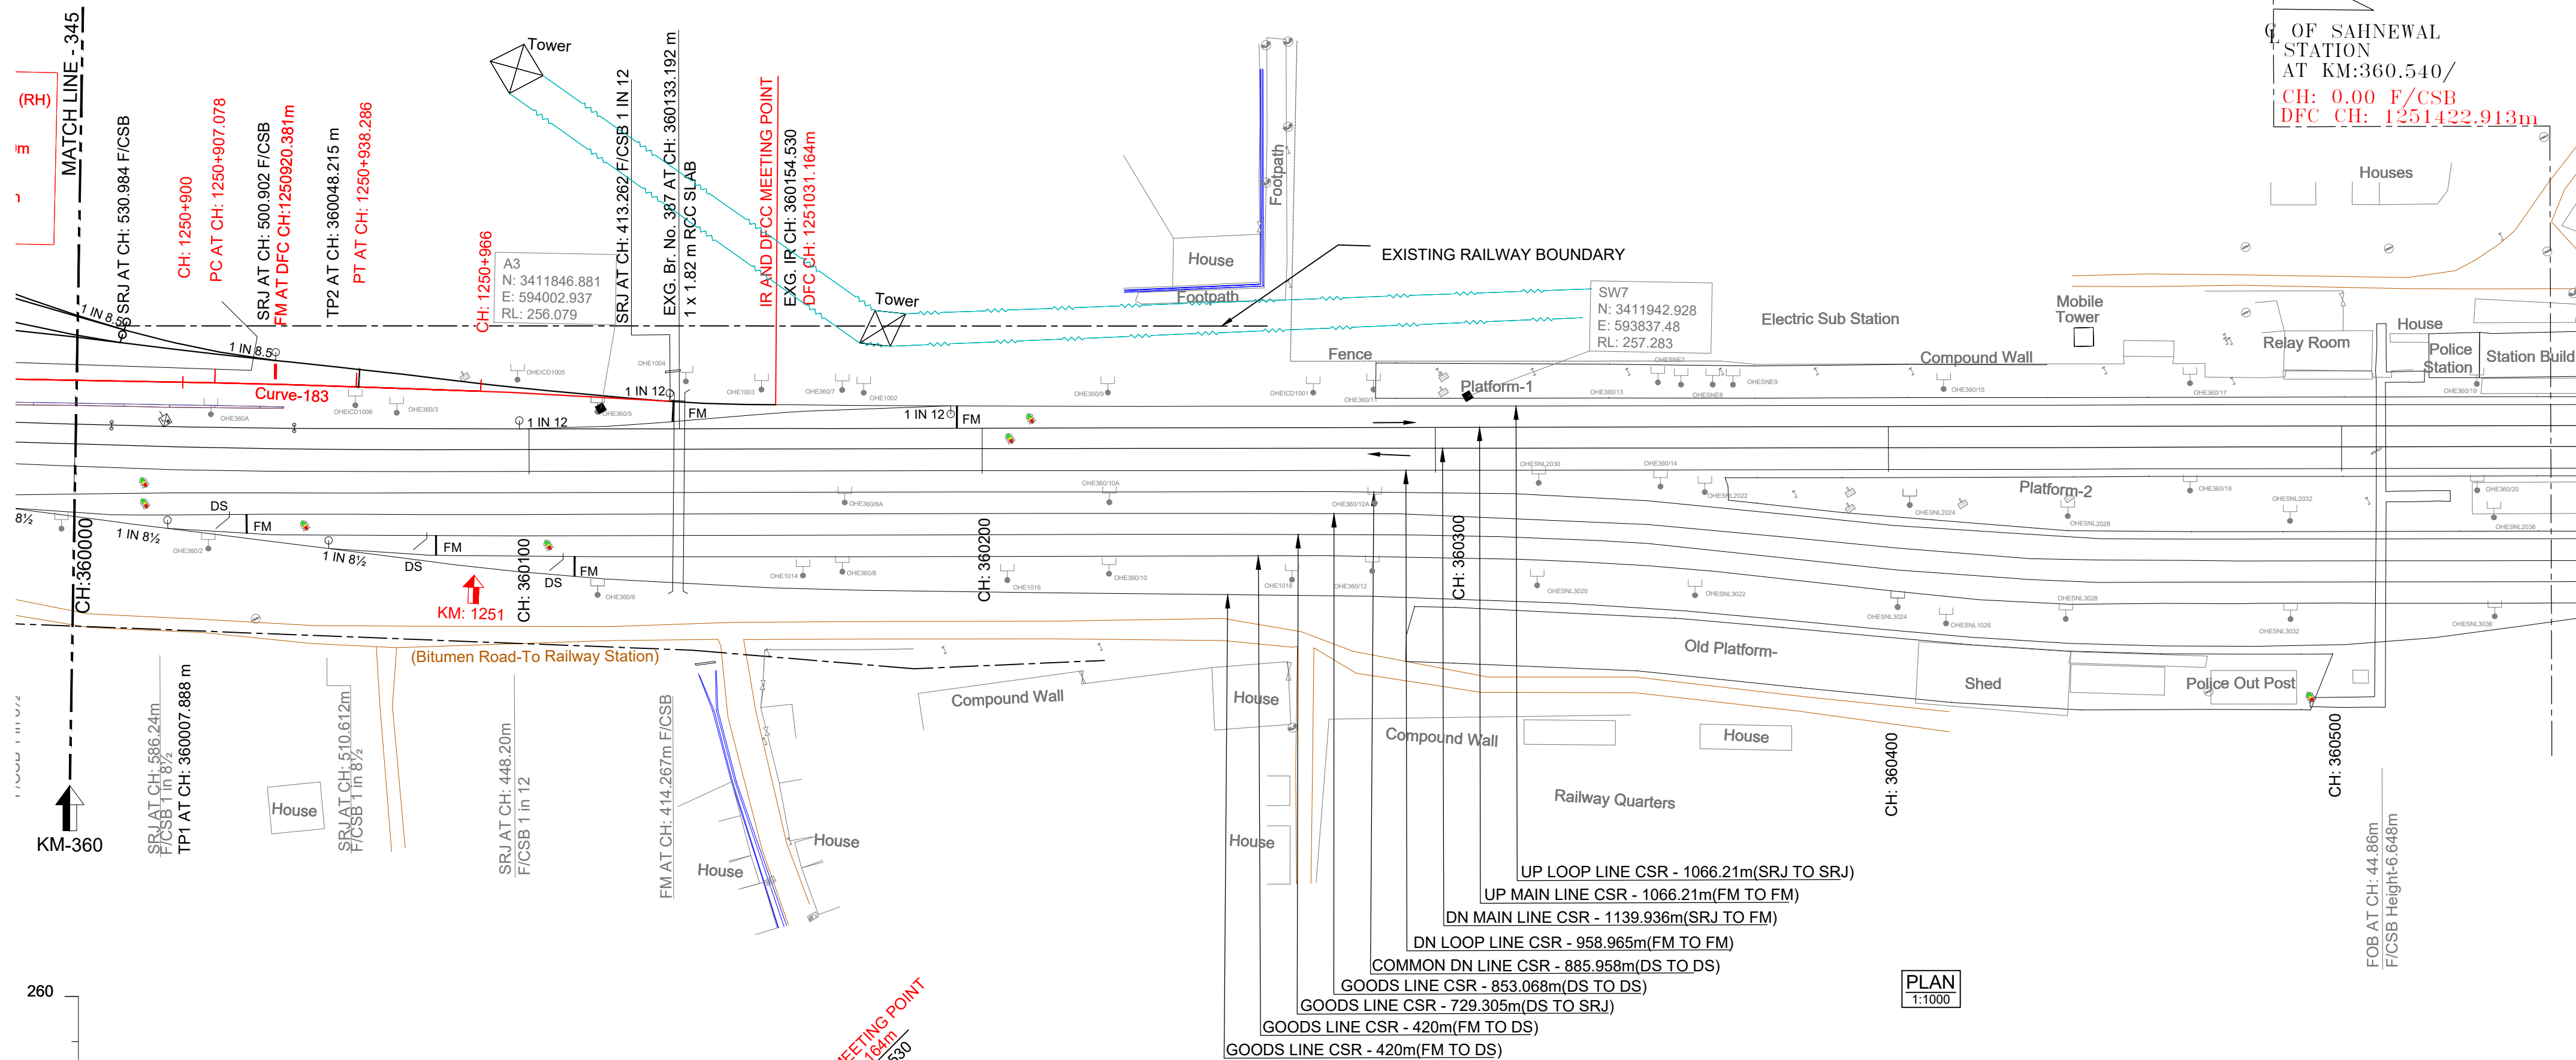

DATUM ABOVE MSL : 254 m

HORIZONTAL ALIGNMENT	L = 122.154m R = 1750m		L = 92.878m	
VERTICAL ALIGNMENT	L=686.542 m 1 IN 686.542 F		EXG. GRADE	
TRACK DISTANCE FROM EXISTING NEAREST IR UP MAIN LINE TO DFC MAIN LINE	9.691	9.811	9.736	9.287
HEIGHT OF BANKING(+) / DEPTH OF CUTTING(-) (PFL-GL)	-0.416	-0.497	-0.307	+0.039
EXG GROUND LEVEL AT CENTER LINE OF DFC TRACK (GL)	256.357	256.408	256.189	255.814
EXG GROUND LEVEL AT TOE LOCATION OF DFC TRACK	256.317	256.400	256.134	255.176
DIFFERENCE BETWEEN DFC FORMATION LEVEL AND EXG.FORMATION LEVEL (PFL-EFL)	-0.156	-0.178	-0.159	-0.160
DFC FORMATION LEVEL (PFL)	255.94	255.911	255.882	255.852
EXG. FORMATION LEVEL OF EXG IR UP MAIN LINE (EFL)	256.097	256.090	256.041	255.971
DIFFERENCE BETWEEN DFC RAIL LEVEL AND EXG. RAIL LEVEL (PRL - ERL)	-0.115	-0.137	-0.118	-0.119
DFC RAIL LEVEL (PRL)	256.653	256.624	256.595	256.565
EXG.RAIL LEVEL OF NEAREST IR UP MAIN LINE(ERL)	256.769	256.762	256.713	256.684
EQUIVALENT CHAINAGE ON DFC TRACK	360000.0	360020.0	360040.0	360060.0
EXISTING IR CHAINAGE	360000.0	360020.0	360040.0	360060.0

EXG. IR LOOP LINE LEVELS

L - SECTION