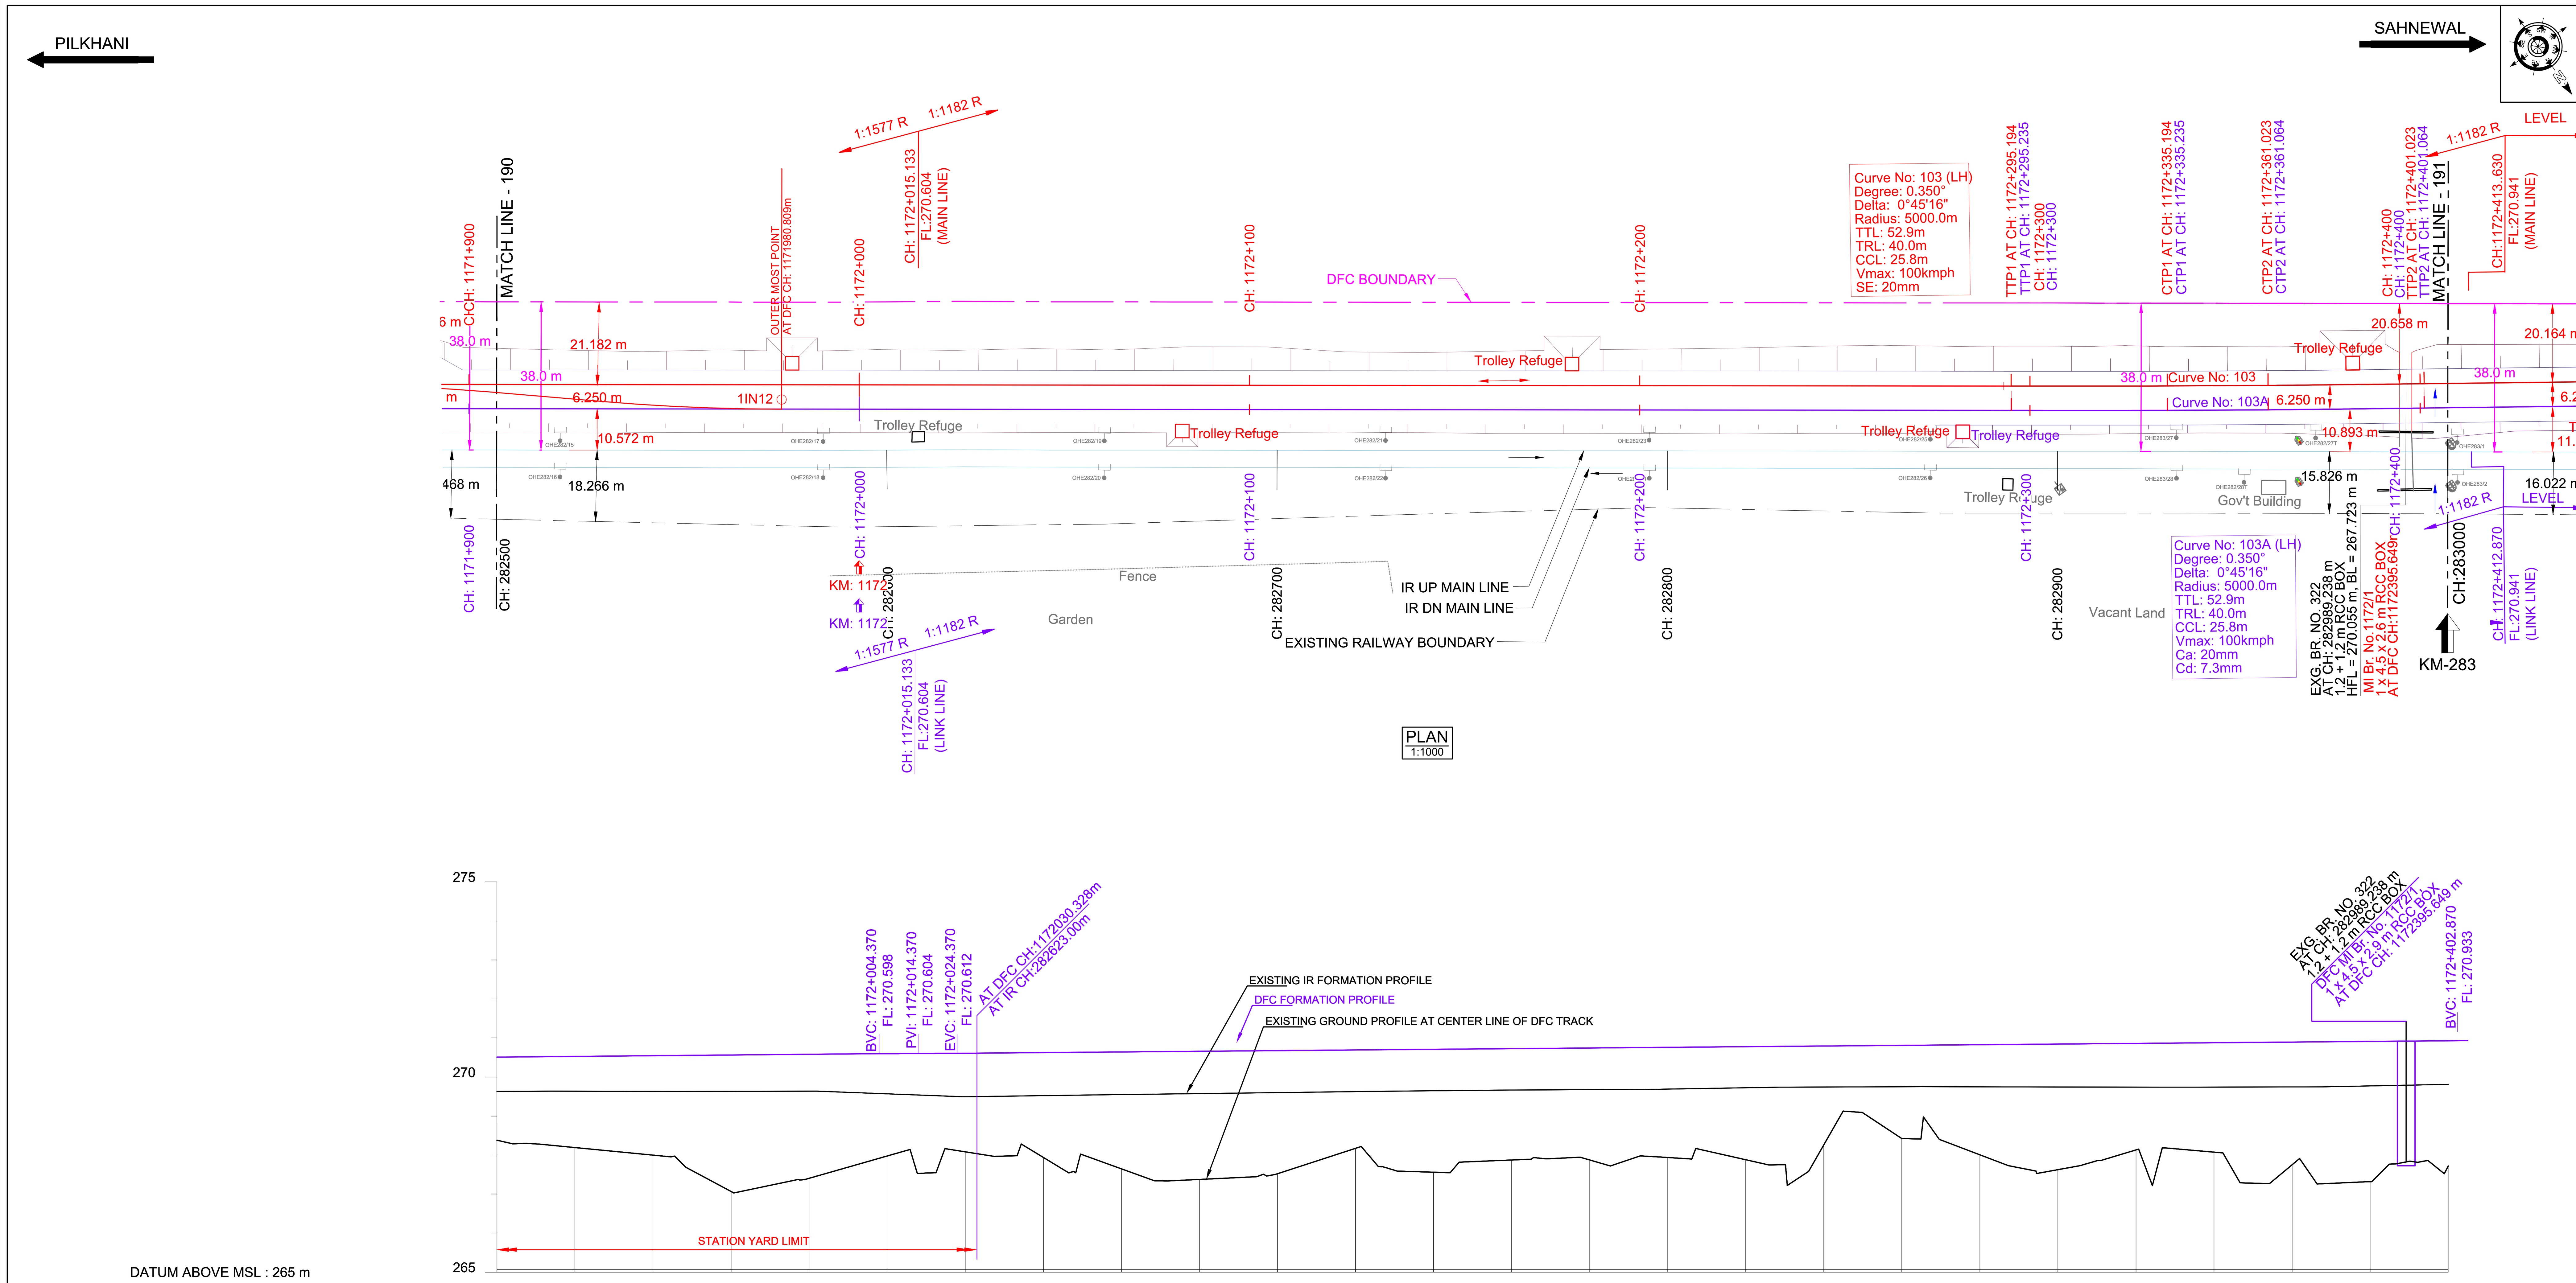


DATUM ABOVE MSL : 265 m

HORIZONTAL ALIGNMENT: L = 634.819m; TL= 40m; R =-5000m; TL= 40m; L = 143.631m

VERTICAL ALIGNMENT: L=547.300m 1 IN 1577.335 R; L=20.0 m R=94477 m; L=378.500m 1 IN 1182.493

EXISTING IR CHAINAGE	282500.0	282520.0	282540.0	282560.0	282580.0	282600.0	282620.0	282640.0	282660.0	282680.0	282700.0	282720.0	282740.0
TRACK DISTANCE FROM EXISTING NEAREST IR UP MAIN LINE TO DFC LINKED LINE	10.564	10.572	10.568	10.579	10.596	10.470	10.331	10.380	10.420	10.425	10.438	10.458	10.457
HEIGHT OF BANKING(+) / DEPTH OF CUTTING(-) (PFL-GL)	+2.345	+2.552	+2.763	+3.715	+3.394	+2.842	+2.750	+2.914	+3.221	+3.511	+3.384	+2.749	+3.380
EXG GROUND LEVEL AT CENTER LINE OF DFC TRACK (GL)	268.191	267.997	267.799	266.859	267.193	267.757	267.865	267.718	267.428	267.154	267.299	267.950	267.336
EXG GROUND LEVEL AT TOE LOCATION OF DFC TRACK	267.113	267.606	267.879	267.321	267.210	267.391	267.224	267.052	267.124	267.282	267.503	267.637	267.700
DIFFERENCE BETWEEN DFC FORMATION LEVEL AND EXG.FORMATION LEVEL.(PFL-EFL)	1.095	1.105	1.129	1.146	1.161	1.247	1.340	1.331	1.321	1.314	1.306	1.297	1.294
DFC FORMATION LEVEL (PFL)	270.536	270.549	270.561	270.574	270.587	270.599	270.615	270.632	270.649	270.666	270.683	270.699	270.716
EXG. FORMATION LEVEL OF EXG IR UP MAIN LINE (EFL)	269.442	269.444	269.433	269.428	269.426	269.352	269.275	269.301	269.327	269.352	269.377	269.403	269.423
DIFFERENCE BETWEEN DFC RAIL LEVEL AND EXG. RAIL LEVEL (PRL - ERL)	1.120	1.130	1.154	1.171	1.186	1.272	1.365	1.356	1.346	1.339	1.331	1.322	1.319
DFC RAIL LEVEL (PRL)	271.249	271.262	271.274	271.287	271.300	271.312	271.328	271.345	271.362	271.379	271.396	271.412	271.429
EXG.RAIL LEVEL OF NEAREST IR UP MAIN LINE(ERL)	270.130	270.132	270.121	270.116	270.114	270.040	269.963	269.989	270.015	270.040	270.065	270.091	270.111
EQUIVALENT CHAINAGE ON DFC TRACK	1171907.3	1171927.3	1171947.3	1171967.3	1171987.3	1172007.2	1172027.3	1172047.3	1172067.3	1172087.3	1172107.3	1172127.3	1172147.3

EXISTING IR CHAINAGE	282760.0	282780.0	282800.0	282820.0	282840.0	282860.0	282880.0	282900.0	282920.0	282940.0	282960.0	282980.0	283000.0
TRACK DISTANCE FROM EXISTING NEAREST IR UP MAIN LINE TO DFC LINKED LINE	10.448	10.462	10.473	10.473	10.477	10.485	10.482	10.478	10.503	10.597	10.780	11.022	11.289
HEIGHT OF BANKING(+) / DEPTH OF CUTTING(-) (PFL-GL)	+3.086	+3.106	+3.059	+3.135	+2.771	+2.627	+3.048	+3.428	+2.920	+2.974	+3.301	+3.737	+3.335
EXG GROUND LEVEL AT CENTER LINE OF DFC TRACK (GL)	267.648	267.645	267.708	267.649	268.029	268.191	267.787	267.423	267.948	267.912	267.601	267.183	267.601
EXG GROUND LEVEL AT TOE LOCATION OF DFC TRACK	267.585	267.750	267.436	267.174	267.312	267.068	267.048	267.050	267.085	267.336	267.294	267.173	267.378
DIFFERENCE BETWEEN DFC FORMATION LEVEL AND EXG.FORMATION LEVEL.(PFL-EFL)	1.293	1.302	1.304	1.288	1.287	1.298	1.304	1.309	1.314	1.315	1.310	1.283	1.242
DFC FORMATION LEVEL (PFL)	270.733	270.750	270.767	270.784	270.801	270.818	270.835	270.852	270.869	270.886	270.902	270.919	270.936
EXG. FORMATION LEVEL OF EXG IR UP MAIN LINE (EFL)	269.440	269.448	269.463	269.496	269.514	269.520	269.531	269.543	269.555	269.571	269.593	269.637	269.695
DIFFERENCE BETWEEN DFC RAIL LEVEL AND EXG. RAIL LEVEL (PRL - ERL)	1.318	1.327	1.329	1.313	1.312	1.323	1.329	1.334	1.339	1.340	1.335	1.308	1.267
DFC RAIL LEVEL (PRL)	271.446	271.463	271.480	271.497	271.514	271.531	271.548	271.565	271.582	271.599	271.615	271.632	271.649
EXG.RAIL LEVEL OF NEAREST IR UP MAIN LINE(ERL)	270.128	270.136	270.151	270.184	270.202	270.208	270.219	270.231	270.243	270.259	270.281	270.325	270.383
EQUIVALENT CHAINAGE ON DFC TRACK	1172167.3	1172187.3	1172207.3	1172227.3	1172247.3	1172267.3	1172287.3	1172307.3	1172327.3	1172347.3	1172367.3	1172387.3	1172407.3

L - SECTION

DRG NO.-301-2/AL/A/1191A

NOTE:-

1. DFCC WORKS ARE SHOWN IN RED.
2. DFC LINK LINE WORKS ARE SHOWN IN VIOLET.
3. ALL DIMENSIONS ARE SHOWN IN METRES.
4. THIS DRAWING IS PREPARED BASED ON LATEST SURVEY DATA HELD ON APRIL-2022. GTS BENCH MARK OF 261.850M CONSIDERED ON TOP OF CANAL BRIDGE ABUTMENT AT DORAHA VILLAGE ALONG THE NH1.
5. DFC NEW CHAINAGE OF 1075.950M IS WITH REFERENCE TO THE IR KM OF 187.500KM END OF KM OF CP-303(SECTION P-3 PILKHANI END) AGAINST THE EXISTING DFC CHAINAGE. 116277.742M ISSUED VIDE LETTER NO. CGM/DFCC/UMB/SURVEY/2021-301-230116-011173 DT. 17.01.2023
6. BALLAST PROFILE HAS BEEN PROVIDED ACCORDING TO THE CLAUSE 1.11.3 OF STANDARD SCHEDULE OF DIMESION(EASTERN CORRIDOR) & THE BALLAST CUSHION DIMESION SHOWN IN 35CM ON GE-14 PARA 17. SPECIFICATIONS & RECOMMENDATIONS 2. TWO LAYER SYSTEM FIG.10.

REFERENCE DRAWINGS :-

1. FOR KEY PLAN REFER DRAWING NO. 301-2/AL/0001
2. FOR LEGEND AND ABBREVIATIONS REFER DRAWING NO. 301-2/AL1000
3. FOR TYPICAL SECTION OF BALLAST PROFILE (FL-RL) REFFER DRG. NO. 301-2/TK/TFD/-004 (TR.1952)

REV.	DATE	REVISION DETAILS	PURPOSE OF ISSUE
0	30.10.2024	SUBMISSION OF AS-BUILT DRAWING	FOR APPROVAL

SCALE


HOR - 1:1000 (0, 10, 20, 30, 40m)

VER - 1:100 (0, 1, 2, 3, 4m)

SHEET SIZE : A1

LEGEND:

- IR TRACK
- DFCC TRACK
- LINK LINE (SMUN-RPJ)
- DFCC FUTURE PROPOSALS
- STRUCTURE / BUILDING
- DFCC TOE LINE
- DFCC FORMATION
- RETAINING WALL
- ROAD
- STREAM, DRAIN, NALA, CANAL.
- FENCE
- POWER LINES
- TBM
- ELECTRIC POLE/OHE MAST
- IR RAILWAY BOUNDARY
- DFCC BOUNDARY

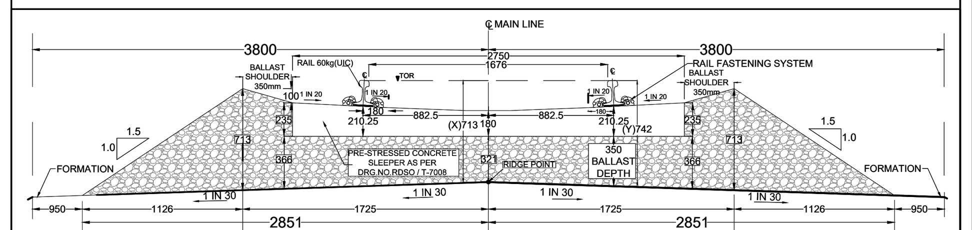
TYPICAL SECTION

TRACK STRUCTURE

	Difference between FL- RL (Below Rail Seat)	
RAIL SECTION: 60Kg/m (UIC 60Kg/m) DFC LINE: 60Kg/m (UIC 60Kg/m) IR MAIN LINE:52Kg/m	IR Line	DFC
	172mm	172mm
RUBBER PAD	6mm	10mm
SLEEPER DEPTH	210mm	210mm
BALLAST CUSHION	300mm	350mm
Total Depth (FL TO RL)	688mm	742mm

OWNER

DEDICATED FREIGHT CORRIDOR CORPORATION OF INDIA LTD.
(A GOVERNMENT OF INDIA ENTERPRISE)
PROJECT OFFICE(AMBALA UNIT): OLD RAILWAY COLONY (NEAR ANAND MARKET),AMBALA CANTT-133001.
CORPORATE IDENTITY NO. : U60232DL2006GOI155068

ENGINEER:

DB Engineering & Consulting GmbH
Deutsche Bahn Engineering & Consulting GmbH

CONTRACTOR:

GIL - TPL JV

SUBMITTED BY	GIL - TPL JV		
	DATED	NAME	SIGNATURE
PREPARED BY			
CHECKED BY	30.10.2024	VIJAY PRATAP	
APPROVED BY	30.10.2024	PARASURAM KOTYADA	

APPROVED BY	DEUTSCHE BAHN ENGINEERING & CONSULTING GMBH		
	DATED	NAME	SIGNATURE
Sr. DE./CHIEF ENGINEER		SURESH K.YALANGI	
CHIEF TRACK ENGINEER		RAJ PAL SINGH	
T.L.		H.D. VIDJAK	

STAMP: A — AS-BUILT DRAWING, TR. Ref...................., ENGINEER Sign.:

EMPLOYER (DFCCIL): DEDICATED FREIGHT CORRIDOR CORPORATION OF INDIA LTD.

AS BUILT DRAWING

TITLE

AS-BUILT PLAN AND PROFILE
DFC LINK LINE
FROM IR KM: 282.500 TO 283.000
DFC KM: 1171.907 TO 1172.407

DFCC APPR. NO. -	
ENGG. APPR. NO. -	
DRG. NO. - 301-2/AL/A/1191A	
SHEET NO. : 1 OF 1	STATUS
DATE : 30.10.2024	A

TR.