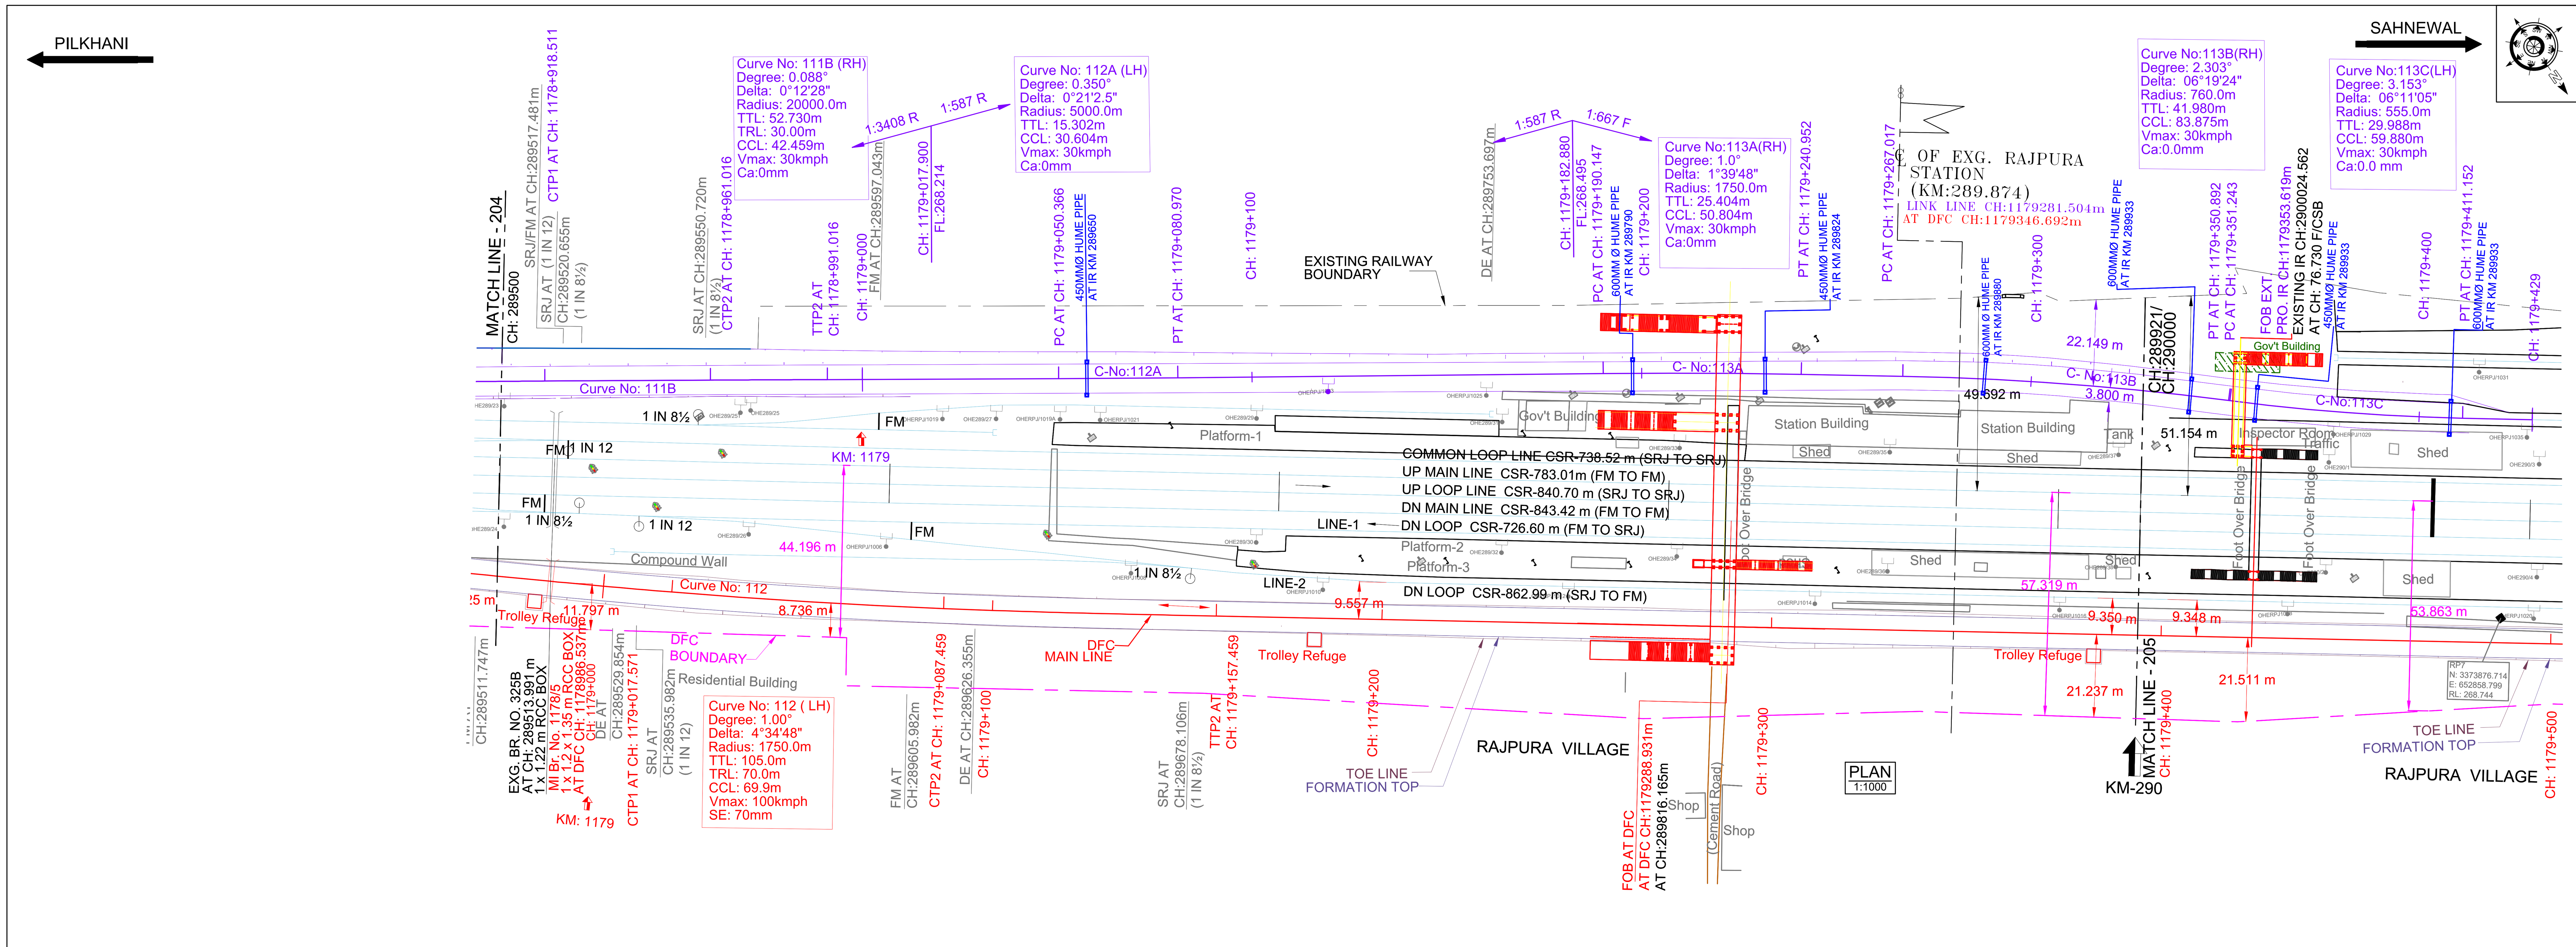
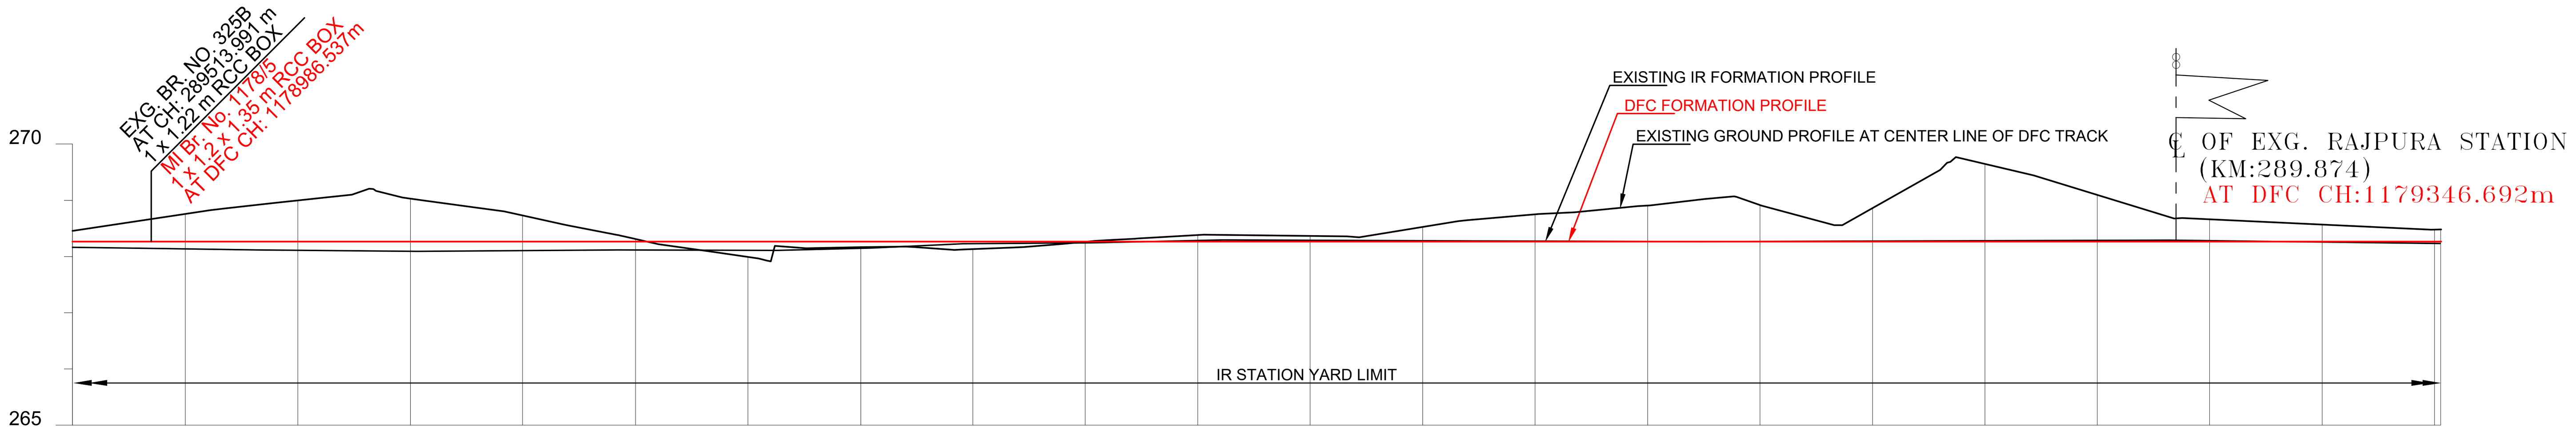



DATUM ABOVE MSL : 265 m

HORIZONTAL ALIGNMENT: TL= 70m, R =-1750m, TL= 70m, L = 627.553m

VERTICAL ALIGNMENT: L=1572.113 m LEVEL

| | | | | | | | | | | | |
|---|---|---|---|---|---|---|---|---|---|---|---|
| TRACK DISTANCE FROM EXISTING NEAREST IR DN MAIN LINE TO DFC MAIN LINE | 21.198 | 22.647 | 23.951 | 25.054 | 25.871 | 26.473 | 26.910 | 27.175 | 27.322 | 27.315 | 27.305 |
| HEIGHT OF BANKING(+) / DEPTH OF CUTTING(-) (PFL-GL) | -0.187 | -0.492 | -0.733 | -0.763 | -0.463 | -0.043 | +0.275 | +0.099 | +0.136 | +0.003 | -0.117 |
| EXG GROUND LEVEL AT CENTER LINE OF DFC TRACK (GL) | 268.317 | 268.622 | 268.863 | 268.893 | 268.593 | 268.173 | 267.855 | 268.031 | 267.994 | 268.127 | 268.247 |
| EXG GROUND LEVEL AT TOE LOCATION OF DFC TRACK | 268.288 | 268.270 | 268.542 | 268.662 | 268.575 | 268.164 | 268.152 | 268.177 | 268.017 | 268.186 | 268.176 |
| DIFFERENCE BETWEEN DFC FORMATION LEVEL AND EXG.FORMATION LEVEL.(PFL-EFL) | 0.088 | 0.114 | 0.141 | 0.159 | 0.146 | 0.135 | 0.139 | 0.105 | 0.023 | 0.009 | -0.034 |
| DFC FORMATION LEVEL (PFL) | 268.130 | 268.130 | 268.130 | 268.130 | 268.130 | 268.130 | 268.130 | 268.130 | 268.130 | 268.130 | 268.130 |
| EXG. FORMATION LEVEL OF EXG IR DN MAIN LINE (EFL) | 268.042 | 268.016 | 267.989 | 267.971 | 267.984 | 267.995 | 267.991 | 268.025 | 268.107 | 268.121 | 268.164 |
| DIFFERENCE BETWEEN DFC RAIL LEVEL AND EXG. RAIL LEVEL (PRL - ERL) | 0.129 | 0.155 | 0.182 | 0.200 | 0.187 | 0.176 | 0.180 | 0.146 | 0.064 | 0.050 | 0.007 |
| DFC RAIL LEVEL (PRL) | 268.843 | 268.843 | 268.843 | 268.843 | 268.843 | 268.843 | 268.843 | 268.843 | 268.843 | 268.843 | 268.843 |
| EXG.RAIL LEVEL OF NEAREST IR DN MAIN LINE(ERL) | 268.714 | 268.688 | 268.661 | 268.643 | 268.656 | 268.667 | 268.663 | 268.697 | 268.779 | 268.793 | 268.836 |
| EQUIVALENT CHAINAGE ON DFC TRACK | 1178972.8 | 1178992.9 | 1179013 | 1179033 | 1179053 | 1179073.1 | 1179093.1 | 1179113.1 | 1179133.1 | 1179153.1 | 1179173.1 |
| EXISTING IR CHAINAGE | 289500.0 | 289520.0 | 289540.0 | 289560.0 | 289580.0 | 289600.0 | 289620.0 | 289640.0 | 289660.0 | 289680.0 | 289700.0 |

| | | | | | | | | | | | |
|---|---|---|---|---|---|---|---|---|---|---|---|
| TRACK DISTANCE FROM EXISTING NEAREST IR DN MAIN LINE TO DFC MAIN LINE | 27.284 | 27.259 | 27.234 | 27.207 | 27.183 | 27.161 | 27.129 | 27.088 | 27.046 | 27.001 | 26.956 / 26.954 |
| HEIGHT OF BANKING(+) / DEPTH OF CUTTING(-) (PFL-GL) | -0.100 | -0.261 | -0.486 | -0.641 | -0.646 | -0.597 | -1.379 | -0.827 | -0.395 | -0.302 | -0.213 / -0.214 |
| EXG GROUND LEVEL AT CENTER LINE OF DFC TRACK (GL) | 268.230 | 268.391 | 268.616 | 268.771 | 268.776 | 268.727 | 269.509 | 268.957 | 268.525 | 268.432 | 268.343 / 268.344 |
| EXG GROUND LEVEL AT TOE LOCATION OF DFC TRACK | 268.159 | 268.296 | 268.475 | 268.576 | 268.592 | 268.649 | 269.026 | 269.009 | 268.727 | 268.577 | 268.440 / 268.435 |
| DIFFERENCE BETWEEN DFC FORMATION LEVEL AND EXG.FORMATION LEVEL.(PFL-EFL) | -0.039 | -0.032 | -0.025 | -0.017 | -0.017 | -0.023 | -0.029 | -0.036 | -0.031 | -0.006 | 0.018 / 0.020 |
| DFC FORMATION LEVEL (PFL) | 268.130 | 268.130 | 268.130 | 268.130 | 268.130 | 268.130 | 268.130 | 268.130 | 268.130 | 268.130 | 268.130 / 268.130 |
| EXG. FORMATION LEVEL OF EXG IR DN MAIN LINE (EFL) | 268.169 | 268.162 | 268.155 | 268.147 | 268.147 | 268.153 | 268.159 | 268.166 | 268.161 | 268.136 | 268.112 / 268.110 |
| DIFFERENCE BETWEEN DFC RAIL LEVEL AND EXG. RAIL LEVEL (PRL - ERL) | 0.002 | 0.009 | 0.016 | 0.024 | 0.024 | 0.018 | 0.012 | 0.005 | 0.01 | 0.035 | 0.059 / 0.061 |
| DFC RAIL LEVEL (PRL) | 268.843 | 268.843 | 268.843 | 268.843 | 268.843 | 268.843 | 268.843 | 268.843 | 268.843 | 268.843 | 268.843 / 268.843 |
| EXG.RAIL LEVEL OF NEAREST IR DN MAIN LINE(ERL) | 268.841 | 268.834 | 268.827 | 268.819 | 268.819 | 268.825 | 268.831 | 268.838 | 268.833 | 268.808 | 268.784 / 268.782 |
| EQUIVALENT CHAINAGE ON DFC TRACK | 1179193.1 | 1179213.1 | 1179233.1 | 1179253.1 | 1179273.1 | 1179293.1 | 1179313.0 | 1179333.0 | 1179353.0 | 1179373.0 | 1179393.0 / 1179394.1 |
| EXISTING IR CHAINAGE | 289720.0 | 289740.0 | 289760.0 | 289780.0 | 289800.0 | 289820.0 | 289840.0 | 289860.0 | 289880.0 | 289900.0 | 289920.0 / 289921.1/ 290000.0 |

L - SECTION

DRG NO.- 301-2/AL/A/1205

NOTE:-

1. DFCC WORKS ARE SHOWN IN RED.
2. IR NEW WORKS ARE SHOWN IN VIOLET.
3. ALL DIMENSIONS ARE SHOWN IN METRES.
4. THIS DRAWING IS PREPARED BASED ON LATEST SURVEY DATA HELD ON APRIL-2022. GTS BENCH MARK OF 261.850M CONSIDERED ON TOP OF CANAL BRIDGE ABUTMENT AT DORAHA VILLAGE ALONG THE NH1.
5. DFC NEW CHAINAGE OF 1075.950M IS WITH REFERENCE TO THE IR KM OF 187.500KM END OF KM OF CP-303(SECTION P-3 PILKHANI END) AGAINST THE EXISTING DFC CHAINAGE. 116277.742M ISSUED VIDE LETTER NO. CGM/DFCC/UMB/SURVEY/2021-301-230116-011173 DT. 17.01.2023
6. BALLAST PROFILE HAS BEEN PROVIDED ACCORDING TO THE CLAUSE 1.11.3 OF STANDARD SCHEDULE OF DIMESION(EASTERN CORRIDOR) & THE BALLAST CUSHION DIMESION SHOWN IN 35CM ON GE-14 PARA 17. SPECIFICATIONS & RECOMMENDATIONS 2. TWO LAYER SYSTEM FIG.10.

REFERENCE DRAWINGS :-

1. FOR KEY PLAN REFER DRAWING NO. 301-2/AL/0001
2. FOR LEGEND AND ABBREVIATIONS REFER DRAWING NO. 301-2/AL1000
3. FOR TYPICAL SECTION OF BALLAST PROFILE (FL-RL) REFFER DRG. NO. 301-2/TK/TFD/-004 (TR.1952)

| REV. | DATE | REVISION DETAILS | PURPOSE OF ISSUE |
|---|---|---|---|
| | | | |
| 0 | 27.08.2024 | SUBMISSION OF AS-BUILT DRAWING | FOR APPROVAL |

SCALE


HOR - 1:1000 (0, 10, 20, 30, 40m)

VER - 1:100 (0, 1, 2, 3, 4m)

SHEET SIZE : A1

LEGEND:

- IR TRACK
- DFCC TRACK
- LINK LINE ( SMUN-RPJ)
- DFCC FUTURE PROPOSALS
- STRUCTURE / BUILDING
- DFCC TOE LINE
- DFCC FORMATION
- RETAINING WALL
- ROAD
- STREAM, DRAIN, NALA, CANAL.
- FENCE
- POWER LINES
- TBM
- ELECTRIC POLE/OHE MAST
- IR RAILWAY BOUNDARY
- DFCC BOUNDARY

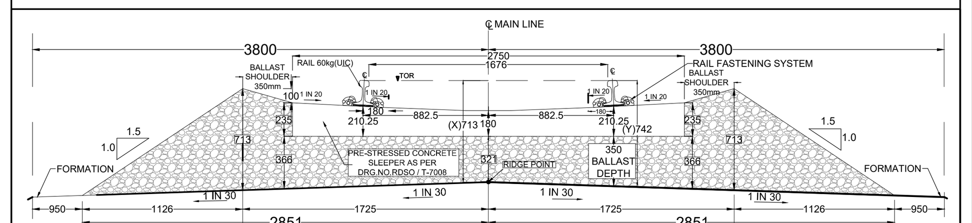


TYPICAL SECTION

TRACK STRUCTURE

| | Difference between FL- RL (Below Rail Seat) | |
|---|---|---|
| RAIL SECTION: 60Kg/m (UIC 60Kg/m)<br>DFC LINE: 60Kg/m (UIC 60Kg/m)<br>IR MAIN LINE:52Kg/m | IR Line | DFC |
| | 172mm | 172mm |
| RUBBER PAD | 6mm | 10mm |
| SLEEPER DEPTH | 210mm | 210mm |
| BALLAST CUSHION | 300mm | 350mm |
| Total Depth (FL TO RL) | 688mm | 742mm |

OWNER

DEDICATED FREIGHT CORRIDOR CORPORATION OF INDIA LTD.
(A GOVERNMENT OF INDIA ENTERPRISE)
PROJECT OFFICE(AMBALA UNIT): OLD RAILWAY COLONY (NEAR ANAND MARKET),AMBALA CANTT-133001.
CORPORATE IDENTITY NO. : U60232DL2006GOI155068

ENGINEER:

DB Engineering & Consulting GmbH
Deutsche Bahn Engineering & Consulting GmbH

CONTRACTOR: GIL - TPL JV

| SUBMITTED BY | GIL - TPL JV | | |
|---|---|---|---|
| | DATED | NAME | SIGNATURE |
| PREPARED BY | | | |
| CHECKED BY | 27.08.2024 | VIJAY PRATAP | |
| APPROVED BY | 27.08.2024 | PARASURAM KOTYADA | |

| APPROVED BY | DEUTSCHE BAHN ENGINEERING & CONSULTING GMBH | | |
|---|---|---|---|
| | DATED | NAME | SIGNATURE |
| Sr. DE./CHIEF ENGINEER | | SURESH K.YALANGI | |
| CHIEF TRACK ENGINEER | | RAJ PAL SINGH | |
| T.L. | | H.D. VIDJAK | |

STAMP: A — AS-BUILT DRAWING, TR. Ref....................., ENGINEER Sign.:

EMPLOYER (DFCCIL): DEDICATED FREIGHT CORRIDOR CORPORATION OF INDIA LTD.

**AS BUILT DRAWING**

TITLE

AS-BUILT PLAN AND PROFILE

FROM IR KM: 289.500 TO 290.000

DFC KM: 1178.973 TO 1179.394

DFCC APPR. NO. -

ENGG. APPR. NO. -

DRG. NO. - 301-2/AL/A/1205

SHEET NO. : 1 OF 1

DATE : 27.08.2024

STATUS: A

TR.