
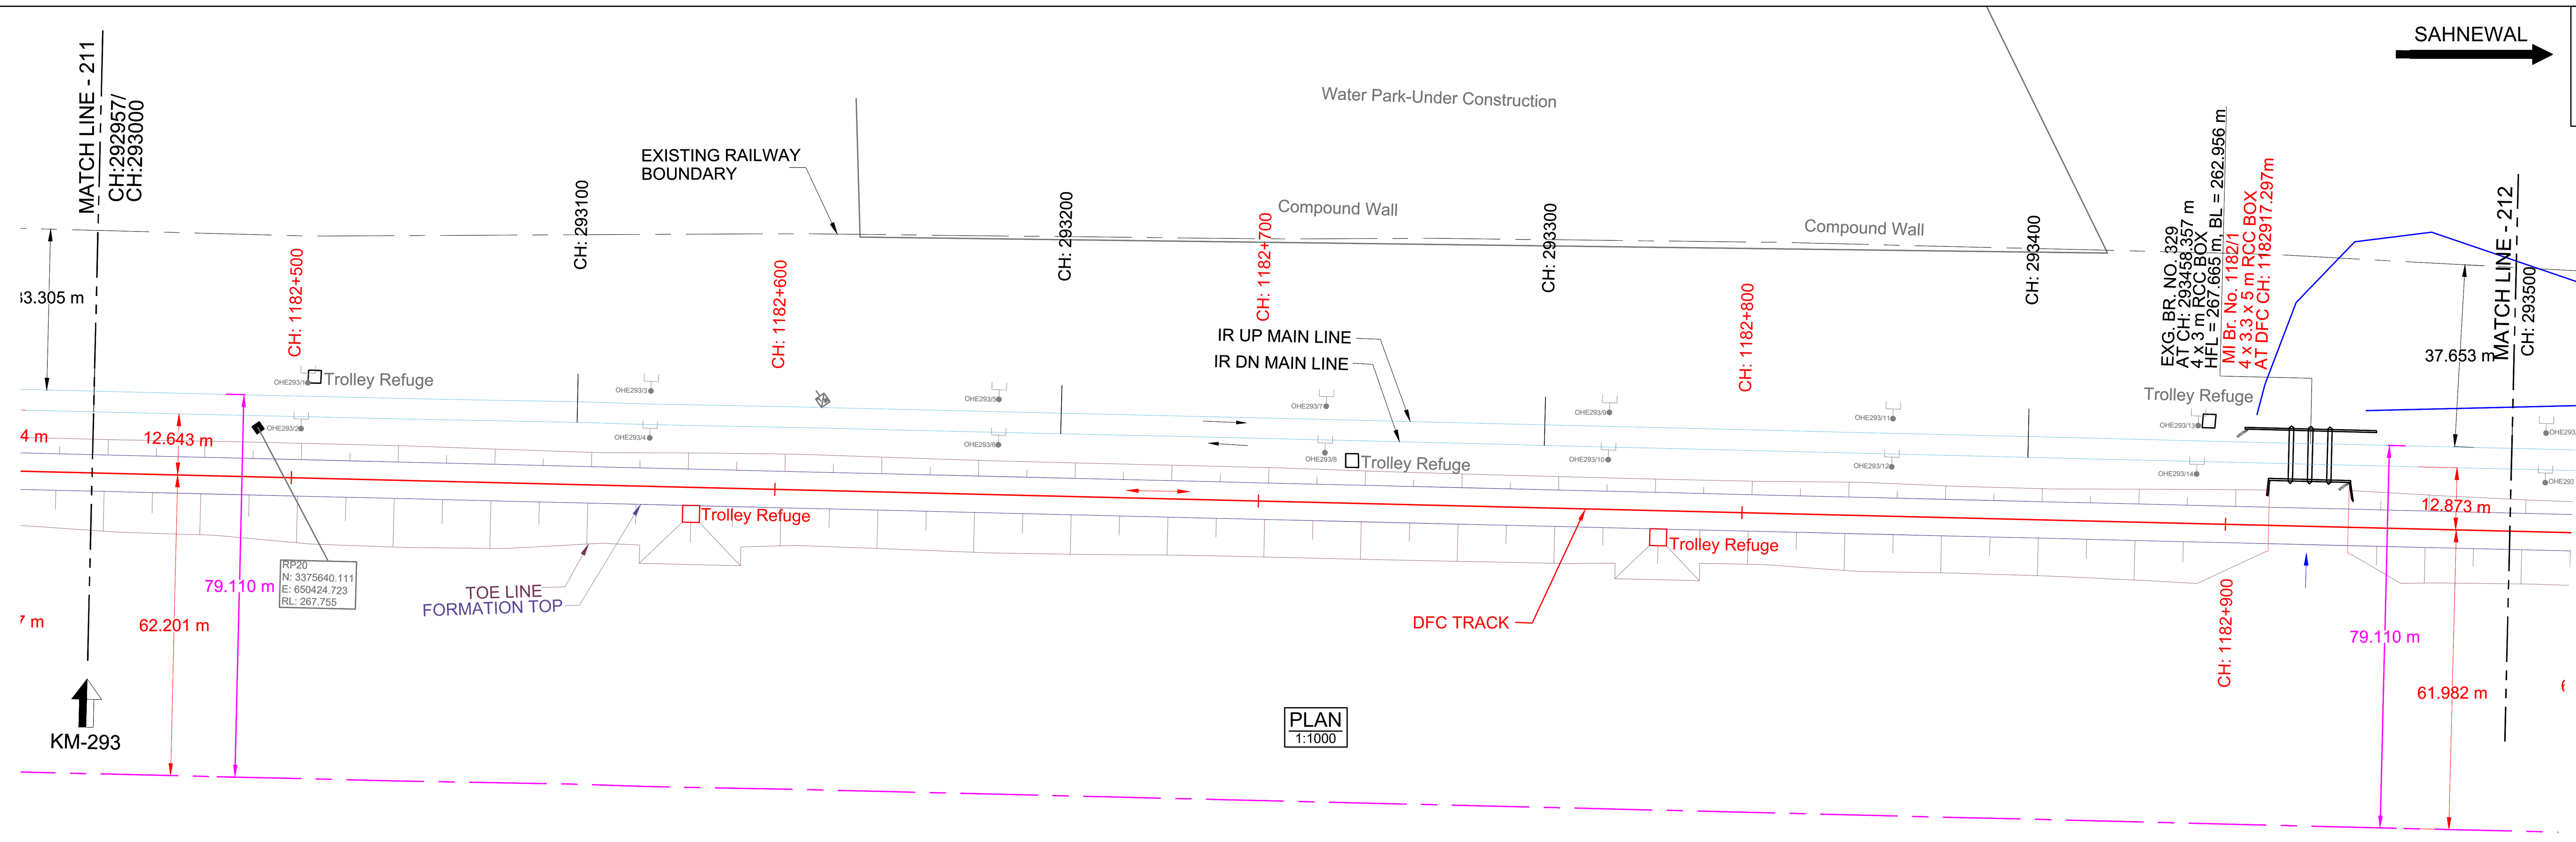


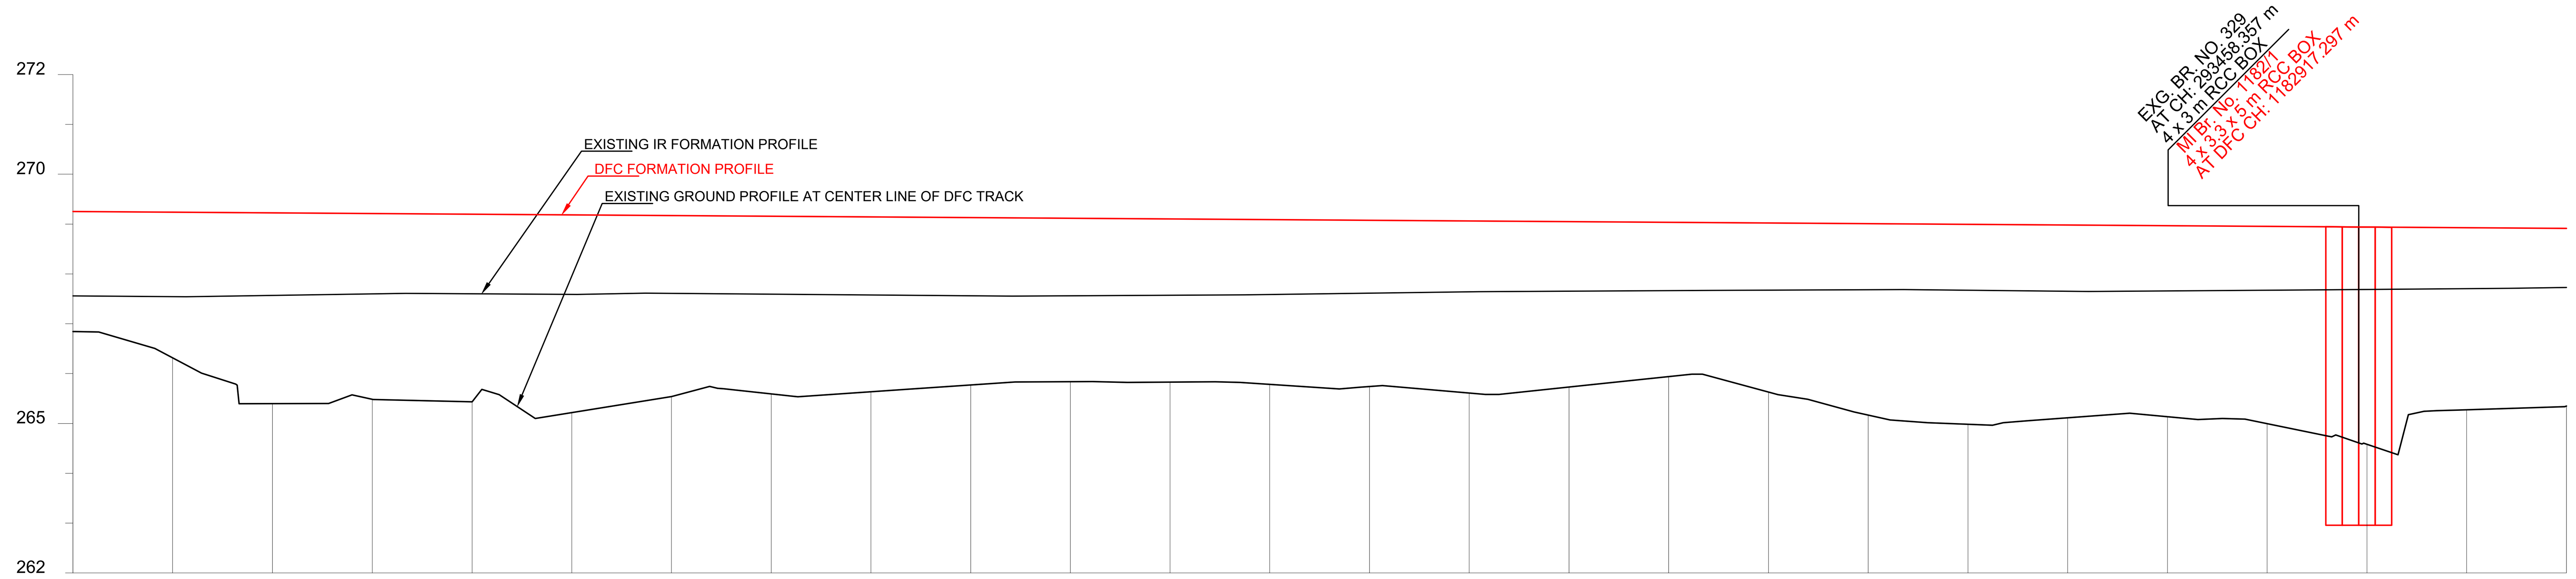

DATUM ABOVE MSL : 262 m

HORIZONTAL ALIGNMENT	L = 5898.430m												
VERTICAL ALIGNMENT	L=1742.5 m 1 IN 1392.188 F												
TRACK DISTANCE FROM EXISTING NEAREST IR DN MAIN LINE TO DFC MAIN LINE	12.643	12.643	12.670	12.702	12.776	12.870	12.770	12.813	12.857	12.900	12.931	12.953	12.966
HEIGHT OF BANKING(+) / DEPTH OF CUTTING(-) (PFL-GL)	+2.408	+2.919	+3.825	+3.724	+3.760	+3.965	+3.631	+3.564	+3.507	+3.357	+3.277	+3.272	+3.303
EXG GROUND LEVEL AT CENTER LINE OF DFC TRACK (GL)	266.879	266.353	265.433	265.520	265.469	265.250	265.569	265.622	265.665	265.801	265.866	265.857	265.812
EXG GROUND LEVEL AT TOE LOCATION OF DFC TRACK	267.571	267.492	267.452	267.438	267.519	267.615	267.458	267.298	267.327	267.416	267.432	267.405	267.401
DIFFERENCE BETWEEN DFC FORMATION LEVEL AND EXG.FORMATION LEVEL.(PFL-EFL)	1.677	1.678	1.639	1.594	1.578	1.578	1.542	1.545	1.549	1.552	1.539	1.513	1.484
DFC FORMATION LEVEL (PFL)	269.286	269.272	269.258	269.243	269.229	269.215	269.200	269.186	269.172	269.157	269.143	269.128	269.114
EXG. FORMATION LEVEL OF EXG IR DN MAIN LINE (EFL)	267.609	267.594	267.619	267.650	267.651	267.637	267.659	267.641	267.623	267.605	267.604	267.615	267.630
DIFFERENCE BETWEEN DFC RAIL LEVEL AND EXG. RAIL LEVEL (PRL - ERL)	1.718	1.719	1.680	1.635	1.619	1.619	1.583	1.586	1.590	1.593	1.580	1.554	1.525
DFC RAIL LEVEL (PRL)	269.999	269.985	269.971	269.956	269.942	269.928	269.913	269.899	269.885	269.870	269.856	269.841	269.827
EXG.RAIL LEVEL OF NEAREST IR DN MAIN LINE(ERL)	268.281	268.266	268.291	268.322	268.323	268.309	268.331	268.313	268.295	268.277	268.276	268.287	268.302
EQUIVALENT CHAINAGE ON DFC TRACK	1182459.0	1182479.0	1182499.0	1182519.0	1182539.0	1182559.0	1182579.0	1182599.0	1182619.0	1182639.0	1182659.0	1182679.0	1182699.0
EXISTING IR CHAINAGE	292957.5/ 293000.0	293020.0	293040.0	293060.0	293080.0	293100.0	293120.0	293140.0	293160.0	293180.0	293200.0	293220.0	293240.0

TRACK DISTANCE FROM EXISTING NEAREST IR DN MAIN LINE TO DFC MAIN LINE	12.956	12.946	12.935	12.923	12.913	12.903	12.887	12.868	12.865	12.866	12.869	12.873	12.871
HEIGHT OF BANKING(+) / DEPTH OF CUTTING(-) (PFL-GL)	+3.334	+3.449	+3.318	+3.094	+3.392	+3.840	+4.011	+3.867	+3.831	+3.957		+3.650	+3.561
EXG GROUND LEVEL AT CENTER LINE OF DFC TRACK (GL)	265.766	265.636	265.753	265.963	265.650	265.188	265.003	265.133	265.154	265.013	264.600	265.291	265.366
EXG GROUND LEVEL AT TOE LOCATION OF DFC TRACK	267.475	267.542	267.565	267.563	267.538	267.396	267.469	267.531	267.368	267.171	266.959	267.118	267.370
DIFFERENCE BETWEEN DFC FORMATION LEVEL AND EXG.FORMATION LEVEL.(PFL-EFL)	1.445	1.406	1.379	1.354	1.331	1.309	1.304	1.310	1.290	1.263	1.234	1.204	1.169
DFC FORMATION LEVEL (PFL)	269.100	269.085	269.071	269.057	269.042	269.028	269.014	268.999	268.985	268.970	268.956	268.942	268.927
EXG. FORMATION LEVEL OF EXG IR DN MAIN LINE (EFL)	267.655	267.680	267.692	267.703	267.712	267.719	267.709	267.689	267.695	267.708	267.722	267.738	267.759
DIFFERENCE BETWEEN DFC RAIL LEVEL AND EXG. RAIL LEVEL (PRL - ERL)	1.486	1.447	0.420	1.395	1.372	1.350	1.345	1.351	1.331	1.304	1.275	1.245	1.210
DFC RAIL LEVEL (PRL)	269.813	269.798	269.784	269.770	269.755	269.741	269.727	269.712	269.698	269.683	269.669	269.655	269.640
EXG.RAIL LEVEL OF NEAREST IR DN MAIN LINE(ERL)	268.327	268.352	268.364	268.375	268.384	268.391	268.381	268.361	268.367	268.38	268.394	268.410	268.431
EQUIVALENT CHAINAGE ON DFC TRACK	1182719.0	1182739.0	1182759.0	1182779.0	1182799.0	1182819.0	1182839.0	1182859.0	1182879.0	1182899.0	1182919.0	1182939.0	1182959.0
EXISTING IR CHAINAGE	293260.0	293280.0	293300.0	293320.0	293340.0	293360.0	293380.0	293400.0	293420.0	293440.0	293460.0	293480.0	293500.0

L - SECTION

DRG NO.- 301-2/AL/A/1212

NOTE:-

1. DFCC WORKS ARE SHOWN IN RED.
2. IR NEW WORKS ARE SHOWN IN VIOLET.
3. ALL DIMENSIONS ARE SHOWN IN METRES.
4. THIS DRAWING IS PREPARED BASED ON LATEST SURVEY DATA HELD ON APRIL-2022. GTS BENCH MARK OF 261.850M CONSIDERED ON TOP OF CANAL BRIDGE ABUTMENT AT DORAHA VILLAGE ALONG THE NH1.
5. DFC NEW CHAINAGE OF 1075.950M IS WITH REFERENCE TO THE IR KM OF 187.500KM END OF KM OF CP-303(SECTION P-3 PILKHANI END) AGAINST THE EXISTING DFC CHAINAGE. 116277.742M ISSUED VIDE LETTER NO. CGM/DFCC/UMB/SURVEY/2021-301-230116-011173 DT. 17.01.2023
6. BALLAST PROFILE HAS BEEN PROVIDED ACCORDING TO THE CLAUSE 1.11.3 OF STANDARD SCHEDULE OF DIMESION(EASTERN CORRIDOR) & THE BALLAST CUSHION DIMESION SHOWN IN 35CM ON GE-14 PARA 17. SPECIFICATIONS & RECOMMENDATIONS 2. TWO LAYER SYSTEM FIG.10.

REFERENCE DRAWINGS :-


1. FOR KEY PLAN REFER DRAWING NO. 301-2/AL/0001
2. FOR LEGEND AND ABBREVIATIONS REFER DRAWING NO. 301-2/AL1000
3. FOR TYPICAL SECTION OF BALLAST PROFILE (FL-RL) REFFER DRG. NO. 301-2/TK/TFD/-004 (TR.1952)

REV.	DATE	REVISION DETAILS	PURPOSE OF ISSUE
0	27.08.2024	SUBMISSION OF AS-BUILT DRAWING	FOR APPROVAL

SCALE
HOR - 1:1000 (0 10 20 30 40m)
VER - 1:100 (0 1 2 3 4m)
SHEET SIZE : A1

LEGEND:

- IR TRACK
- DFCC TRACK
- LINK LINE (SMUN-RPJ)
- DFCC FUTURE PROPOSALS
- STRUCTURE / BUILDING
- DFCC TOE LINE
- DFCC FORMATION
- RETAINING WALL
- ROAD
- STREAM, DRAIN, NALA, CANAL.
- FENCE
- POWER LINES
- TBM
- ELECTRIC POLE/OHE MAST
- IR RAILWAY BOUNDARY
- DFCC BOUNDARY

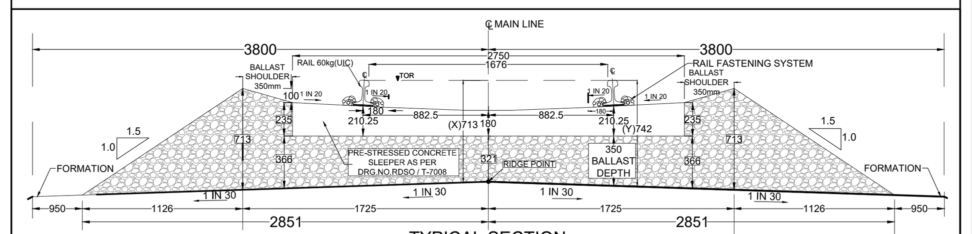

TYPICAL SECTION

TRACK STRUCTURE		
RAIL SECTION: 60Kg/m (UIC 60Kg/m) DFC LINE: 60Kg/m (UIC 60Kg/m) IR MAIN LINE:52Kg/m	Difference between FL- RL (Below Rail Seat)	
	IR Line	DFC
	172mm	172mm
RUBBER PAD	6mm	10mm
SLEEPER DEPTH	210mm	210mm
BALLAST CUSHION	300mm	350mm
Total Depth (FL TO RL)	688mm	742mm

OWNER
DEDICATED FREIGHT CORRIDOR CORPORATION OF INDIA LTD.
(A GOVERNMENT OF INDIA ENTERPRISE)
PROJECT OFFICE(AMBALA UNIT): OLD RAILWAY COLONY (NEAR ANAND MARKET),AMBALA CANTT-133001.
CORPORATE IDENTITY NO. : U60232DL2006GOI155068

ENGINEER:
DB Engineering & Consulting GmbH
Deutsche Bahn Engineering & Consulting GmbH

CONTRACTOR:
GIL - TPL JV

SUBMITTED BY	GIL - TPL JV		
	DATED	NAME	SIGNATURE
PREPARED BY			
CHECKED BY	27.08.2024	VIJAY PRATAP	
APPROVED BY	27.08.2024	PARASURAM KOTYADA	

APPROVED BY	DEUTSCHE BAHN ENGINEERING & CONSULTING GMBH		
	DATED	NAME	SIGNATURE
Sr. DE./CHIEF ENGINEER		SURESH K.YALANGI	
CHIEF TRACK ENGINEER		RAJ PAL SINGH	
T.L.		H.D. VIDJAK	

STAMP
A
AS-BUILT DRAWING
TR. Ref......................
ENGINEER Sign.:

EMPLOYER (DFCCIL): DEDICATED FREIGHT CORRIDOR CORPORATION OF INDIA LTD.

AS BUILT DRAWING

TITLE
AS-BUILT PLAN AND PROFILE
FROM IR KM: 293.000 TO 293.500
DFC KM: 1182.459 TO 1182.959

DFCC APPR. NO. -
ENGG. APPR. NO. -
DRG. NO. - 301-2/AL/A/1212
SHEET NO. : 1 OF 1
DATE : 27.08.2024
STATUS A

TR.