
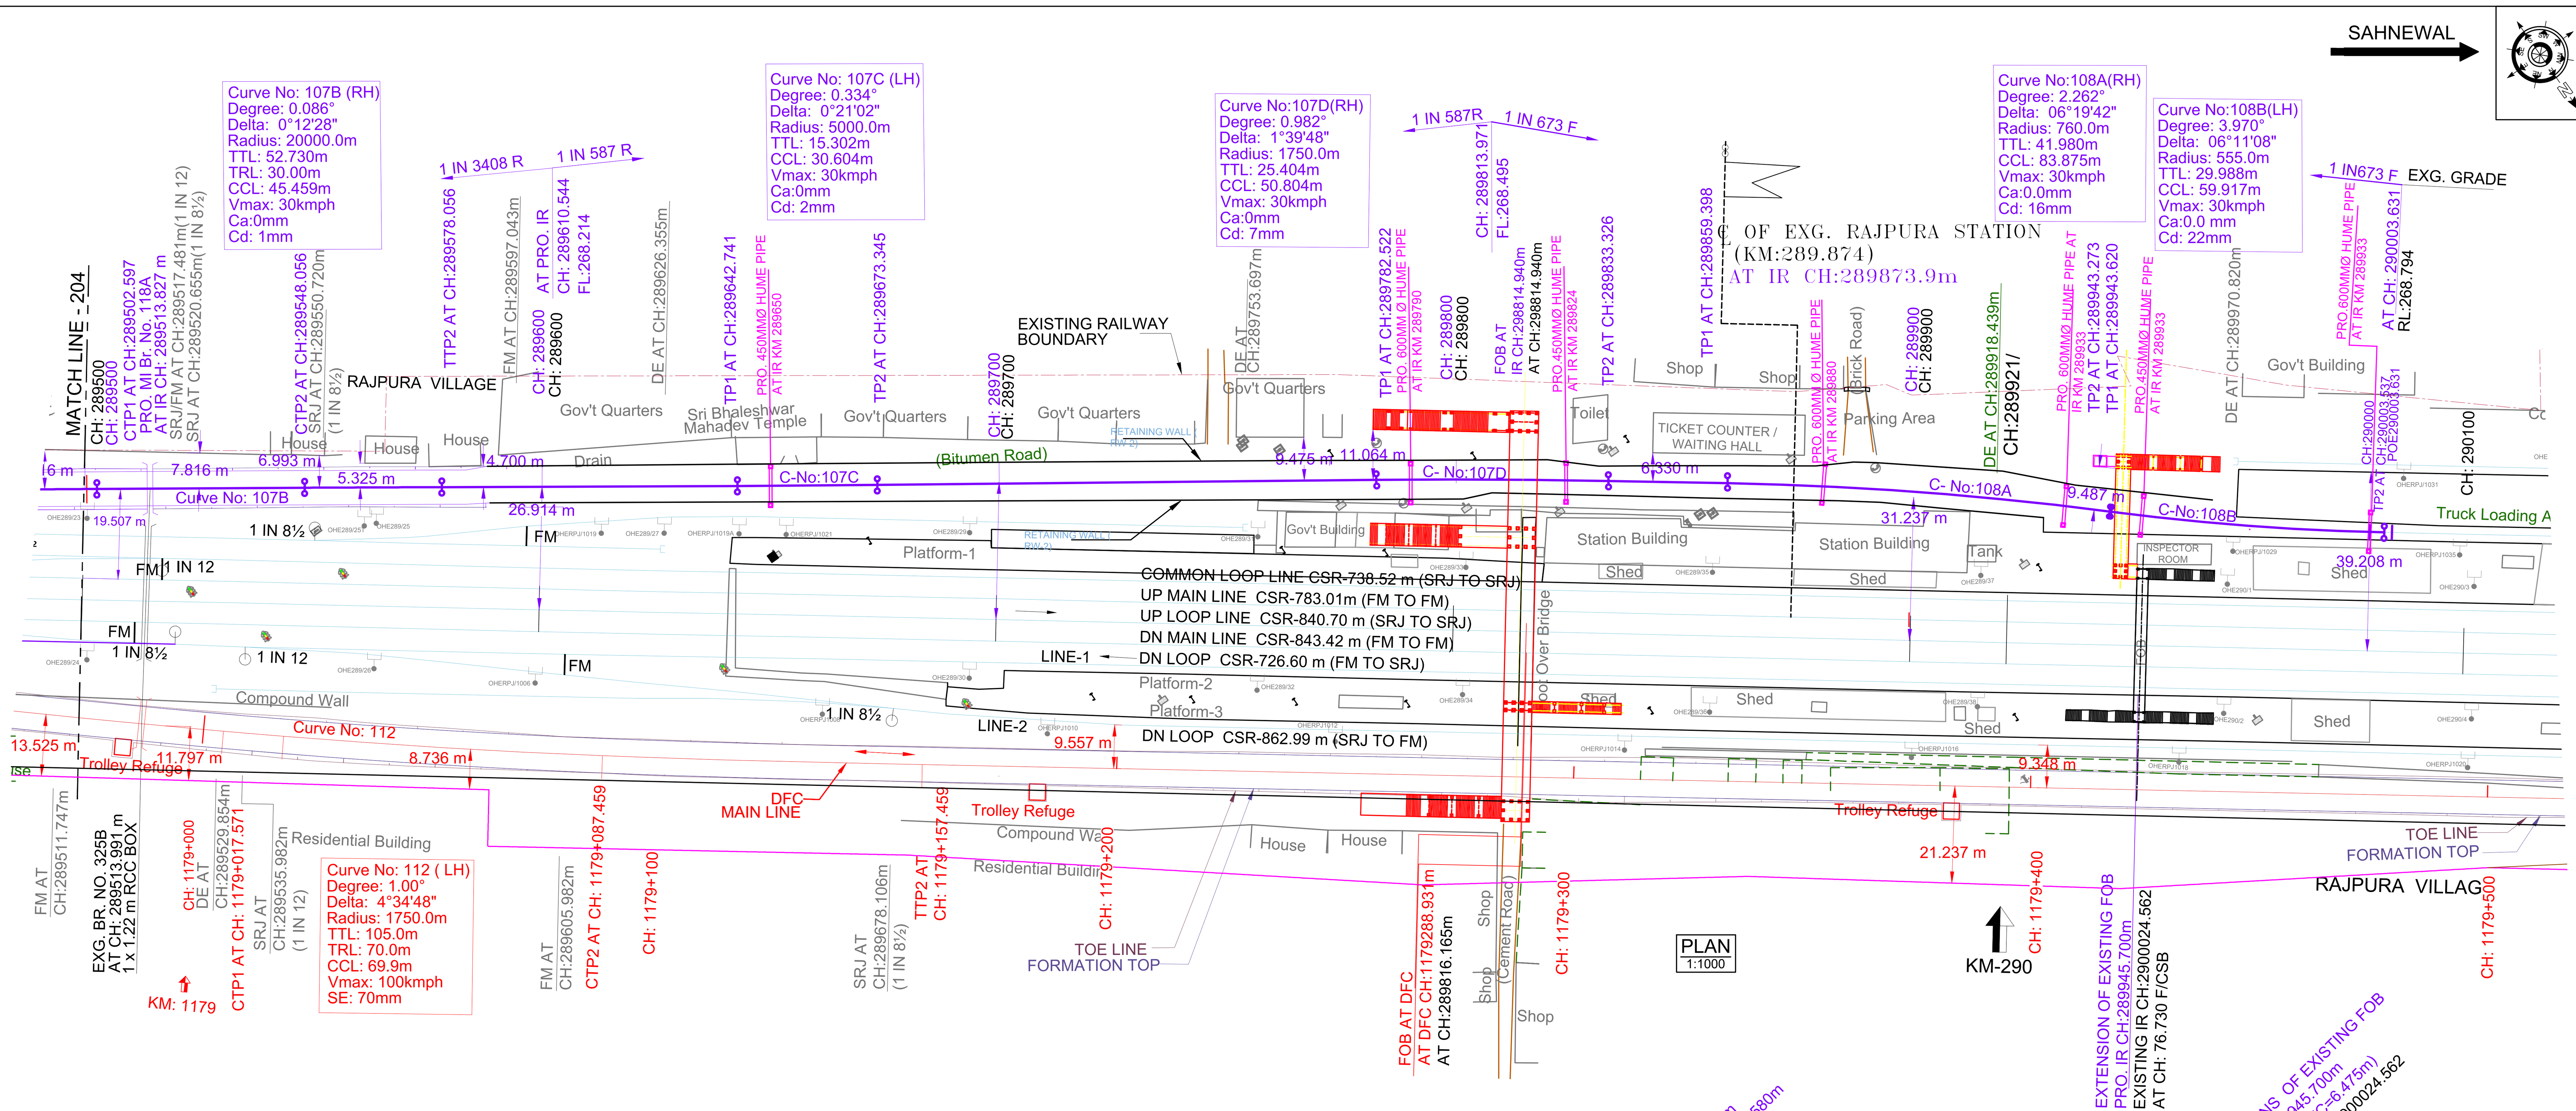


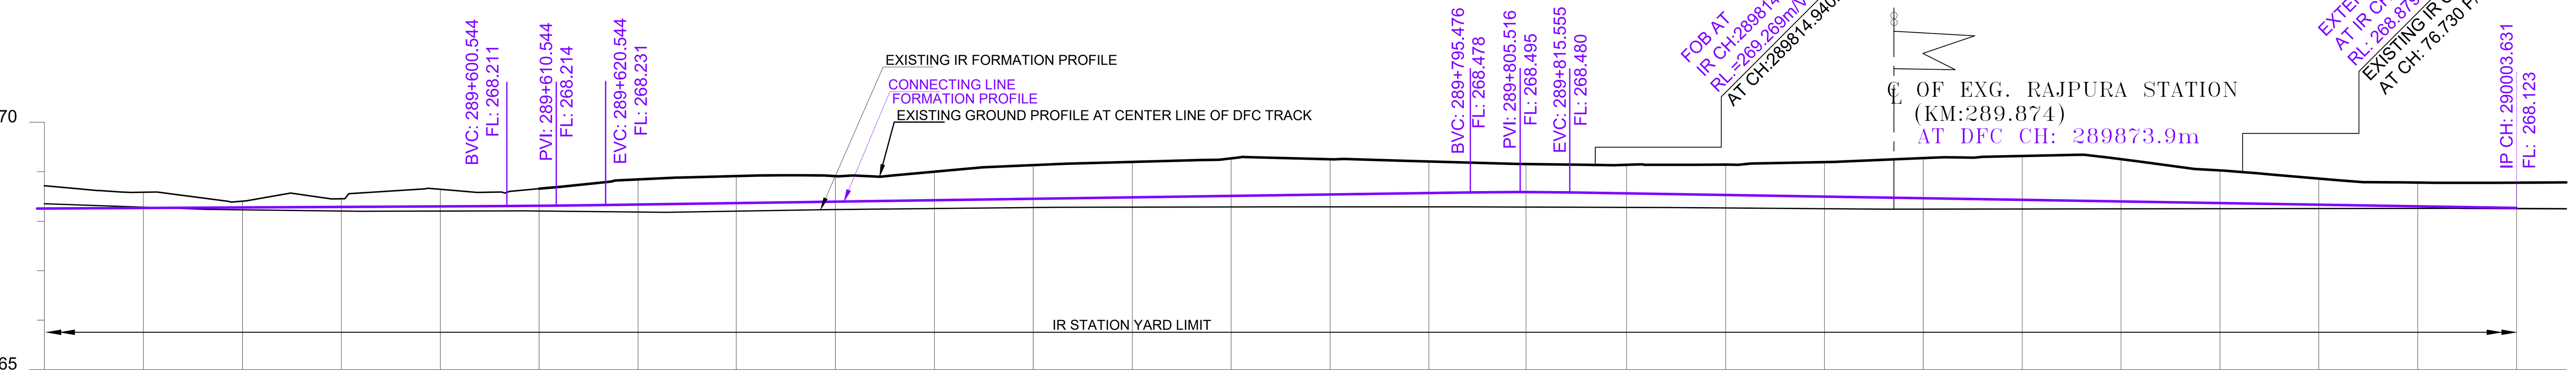

HORIZONTAL ALIGNMENT: TRL=30.0m | CCL=45.459 R=20000 | TRL=30.0m | SL=64.685m | CCL=30.604 R=5000 | SL=109.177m | CCL=50.804 R=1750 | SL= 26.065 | CCL=83.875 R=760 | SL= 0.347 | CCL=59.917R=555 | SL= 1.694

VERTICAL ALIGNMENT: G=1:3407.501 L=542.040m | L=20.000m R=21383.92 | G=1:587.127 L=144.980m | L=20.080m R=6481.21 | G=-1:673.203 L=198.115m

EXISTING IR CHAINAGE	EQUIVALENT CHAINAGE ON IR UP TRACK	TRACK DISTANCE FROM EXISTING NEAREST IR UP MAIN LINE TO IR UP MAIN LINE	HEIGHT OF BANKING(+) / DEPTH OF CUTTING(-) (PFL-GL)	EXG GROUND LEVEL AT CENTER LINE OF IR TRACK (GL)	EXG GROUND LEVEL AT TOE LOCATION OF IR TRACK	DIFFERENCE BETWEEN PRO IR FORMATION LEVEL AND EXG. IR FORMATION LEVEL.(PFL-EFL)	IR FORMATION LEVEL (PFL)	EXG. FORMATION LEVEL OF EXG IR UP MAIN LINE (EFL)	DIFFERENCE BETWEEN IR RAIL LEVEL AND EXG. RAIL LEVEL (PRL - ERL)	IR RAIL LEVEL (PRL)	EXG.RAIL LEVEL OF NEAREST IR UP MAIN LINE(ERL)
289500.0	289499.8	19.478	-0.440	268.628	268.585	-0.076	268.188	268.264	-0.093	268.859	268.952
289520.0	289519.8	20.049	-0.302	268.496	268.438	-0.001	268.194	268.195	-0.018	268.865	268.883
289540.0	289539.8	20.620	-0.114	268.314	268.56	0.059	268.200	268.141	0.042	268.871	268.829
289560.0	289559.8	21.204	-0.156	268.362	268.687	0.091	268.206	268.115	0.074	268.877	268.803
289580.0	289579.8	21.770	-0.339	268.551	268.608	0.098	268.212	268.114	0.081	268.883	268.802
289600.0	289599.9	22.333	-0.344	268.578	268.545	0.103	268.234	268.131	0.086	268.905	268.819
289620.0	289619.9	22.897	-0.515	268.783	268.705	0.143	268.268	268.125	0.126	268.939	268.813
289640.0	289639.8	23.387	-0.552	268.854	268.835	0.154	268.302	268.148	0.137	268.973	268.836
289660.0	289659.8	23.854	-0.528	268.864	268.945	0.150	268.336	268.186	0.133	269.007	268.874
289680.0	289679.8	24.375	-0.579	268.949	268.96	0.159	268.370	268.211	0.142	269.041	268.899
289700.0	289699.8	24.896	-0.687	269.092	269.051	0.168	268.405	268.237	0.151	269.076	268.925
289720.0	289719.9	25.441	-0.723	269.162	269.143	0.190	268.439	268.249	0.173	269.11	268.937
289740.0	289739.9	25.991	-0.762	269.235	269.211	0.215	268.473	268.258	0.198	269.144	268.946
289760.0	289759.9	26.536	-0.720	269.227	269.188	0.243	268.507	268.264	0.226	269.178	268.952
289780.0	289779.9	27.077	-0.645	269.186	269.146	0.273	268.541	268.268	0.256	269.212	268.956
289800.0	289799.9	27.605	-0.564	269.139	269.119	0.307	268.575	268.268	0.290	269.246	268.956
289820.0	289819.9	28.126	-0.563	269.172	269.171	0.297	268.609	268.312	0.280	269.280	269.000
289840.0	289839.9	28.662	-0.602	269.245	269.236	0.275	268.643	268.368	0.258	269.314	269.056
289860.0	289859.9	29.206	-0.685	269.021	269.006	0.257	268.336	268.079	0.240	269.007	268.767
289880.0	289879.9	29.296	-0.798	269.104	269.095	0.239	268.306	268.067	0.222	268.977	268.755
289900.0	289899.9	28.575	-0.882	269.159	269.187	0.221	268.277	268.056	0.204	268.948	268.744
289921.2/ 290000.0	289921.2	27.050	-0.966	269.211	269.233	0.203	268.245	268.042	0.186	268.916	268.730
290020.0	289941.2	24.986	-1.023	269.238	269.245	0.144	268.215	268.071	0.153	268.886	268.733
290040.0	289961.2	23.117	-0.776	268.962	269.099	0.089	268.186	268.097	0.121	268.857	268.736
290060.0	289981.2	21.928	-0.556	268.712	268.803	0.040	268.156	268.116	0.065	268.827	268.762
290080.0	290001.3	21.460	-0.581	268.707	268.798	-0.009	268.126	268.135	0.010	268.797	268.787
290081.7	290003.6	21.460	-0.558	268.681	268.824	-0.060	268.123	268.183	-0.019	268.794	268.813

L - SECTION (CONNECTING LINE)

DRG NO.-301-2/AL/A/1205A

NOTE:-

1. DFCC WORKS ARE SHOWN IN RED.
2. DFC LINK/ IR CONNECTING/MODIFICATION LINE WORKS ARE SHOWN IN VIOLET.
3. ALL DIMENSIONS ARE SHOWN IN METRES.
4. THIS DRAWING IS PREPARED BASED ON LATEST SURVEY DATA HELD ON APRIL-2022. GTS BENCH MARK OF 261.850M CONSIDERED ON TOP OF CANAL BRIDGE ABUTMENT AT DORAHA VILLAGE ALONG THE NH1.
5. DFC NEW CHAINAGE OF 1075.950M IS WITH REFERENCE TO THE IR KM OF 187.500KM END OF KM OF CP-303(SECTION P-3 PILKHANI END) AGAINST THE EXISTING DFC CHAINAGE. 116277.742M ISSUED VIDE LETTER NO. CGM/DFCC/UMB/SURVEY/2021-301-230116-011173 DT. 17.01.2023
6. BALLAST PROFILE HAS BEEN PROVIDED ACCORDING TO THE CLAUSE 1.11.3 OF STANDARD SCHEDULE OF DIMESION(EASTERN CORRIDOR) & THE BALLAST CUSHION DIMESION SHOWN IN 35CM ON GE-14 PARA 17. SPECIFICATIONS & RECOMMENDATIONS 2. TWO LAYER SYSTEM FIG.10.


REFERENCE DRAWINGS :-

1. FOR KEY PLAN REFER DRAWING NO. 301-2/AL/0001
2. FOR LEGEND AND ABBREVIATIONS REFER DRAWING NO. 301-2/AL1000
3. FOR TYPICAL SECTION OF BALLAST PROFILE (FL-RL) REFFER DRG. NO. 301-2/TK/TFD/-004 (TR.1952)

REV.	DATE	REVISION DETAILS	PURPOSE OF ISSUE
0	04.11.2024	SUBMISSION OF AS-BUILT DRAWING OF CONNECTING LINE AT RAJPURA YARD	FOR APPROVAL

SCALE
HOR - 1:1000
VER - 1:100
SHEET SIZE : A1

LEGEND:
EXISTING IR TRACK
DFCC TRACK
CONNECTING LINE
DFCC FUTURE PROPOSALS
STRUCTURE / BUILDING
DFCC TOE LINE
DFCC FORMATION
RETAINING WALL
ROAD
STREAM, DRAIN, NALA, CANAL.
FENCE
POWER LINES
TBM
ELECTRIC POLE/OHE MAST
IR RAILWAY BOUNDARY
DFCC BOUNDARY

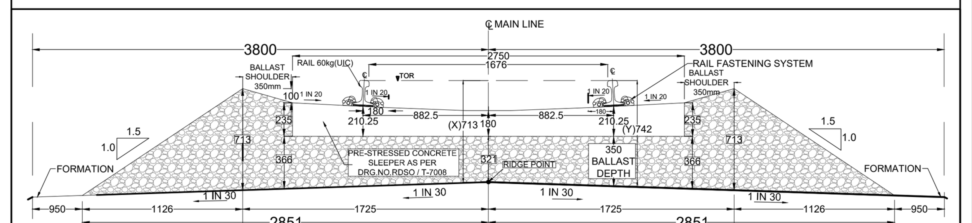

TYPICAL SECTION

TRACK STRUCTURE		
RAIL SECTION: 60Kg/m (UIC 60Kg/m) DFC LINE: 60Kg/m (UIC 60Kg/m) IR MAIN LINE:52Kg/m	Difference between FL- RL (Below Rail Seat)	
	IR Line	DFC
	172mm	172mm
RUBBER PAD	6mm	10mm
SLEEPER DEPTH	210mm	210mm
BALLAST CUSHION	300mm	350mm
Total Depth (FL TO RL)	688mm	742mm

OWNER
DEDICATED FREIGHT CORRIDOR CORPORATION OF INDIA LTD.
(A GOVERNMENT OF INDIA ENTERPRISE)
PROJECT OFFICE(AMBALA UNIT): OLD RAILWAY COLONY (NEAR ANAND MARKET),AMBALA CANTT-133001.
CORPORATE IDENTITY NO. : U60232DL2006GOI155068

ENGINEER:
DB Engineering & Consulting GmbH
Deutsche Bahn Engineering & Consulting GmbH

CONTRACTOR:
GIL - TPL JV

SUBMITTED BY	GIL - TPL JV		
	DATED	NAME	SIGNATURE
PREPARED BY			
CHECKED BY	04.11.2024	VIJAY PRATAP	
APPROVED BY	04.11.2024	PARASURAM KOTYADA	

APPROVED BY	DEUTSCHE BAHN ENGINEERING & CONSULTING GMBH		
	DATED	NAME	SIGNATURE
Sr. DE./CHIEF ENGINEER		SURESH K.YALANGI	
CHIEF TRACK ENGINEER		RAJ PAL SINGH	
T.L.		H.D. VIDJAK	

STAMP
A AS-BUILT DRAWING
TR. Ref.......................
ENGINEER Sign.:

EMPLOYER (DFCCIL): DEDICATED FREIGHT CORRIDOR CORPORATION OF INDIA LTD.

AS BUILT DRAWING

TITLE
AS-BUILT PLAN AND PROFILE
FROM IR KM: 289500 TO 290081.7
IR DESIGN KM: 289499.8 TO 290003.6
(CONNECTING LINE)

DFCC APPR. NO. -
ENGG. APPR. NO. -
DRG. NO. - 301-2/AL/A/1205A
SHEET NO. : 1 OF 1
DATE : 04.11.2024
STATUS A

TR.