
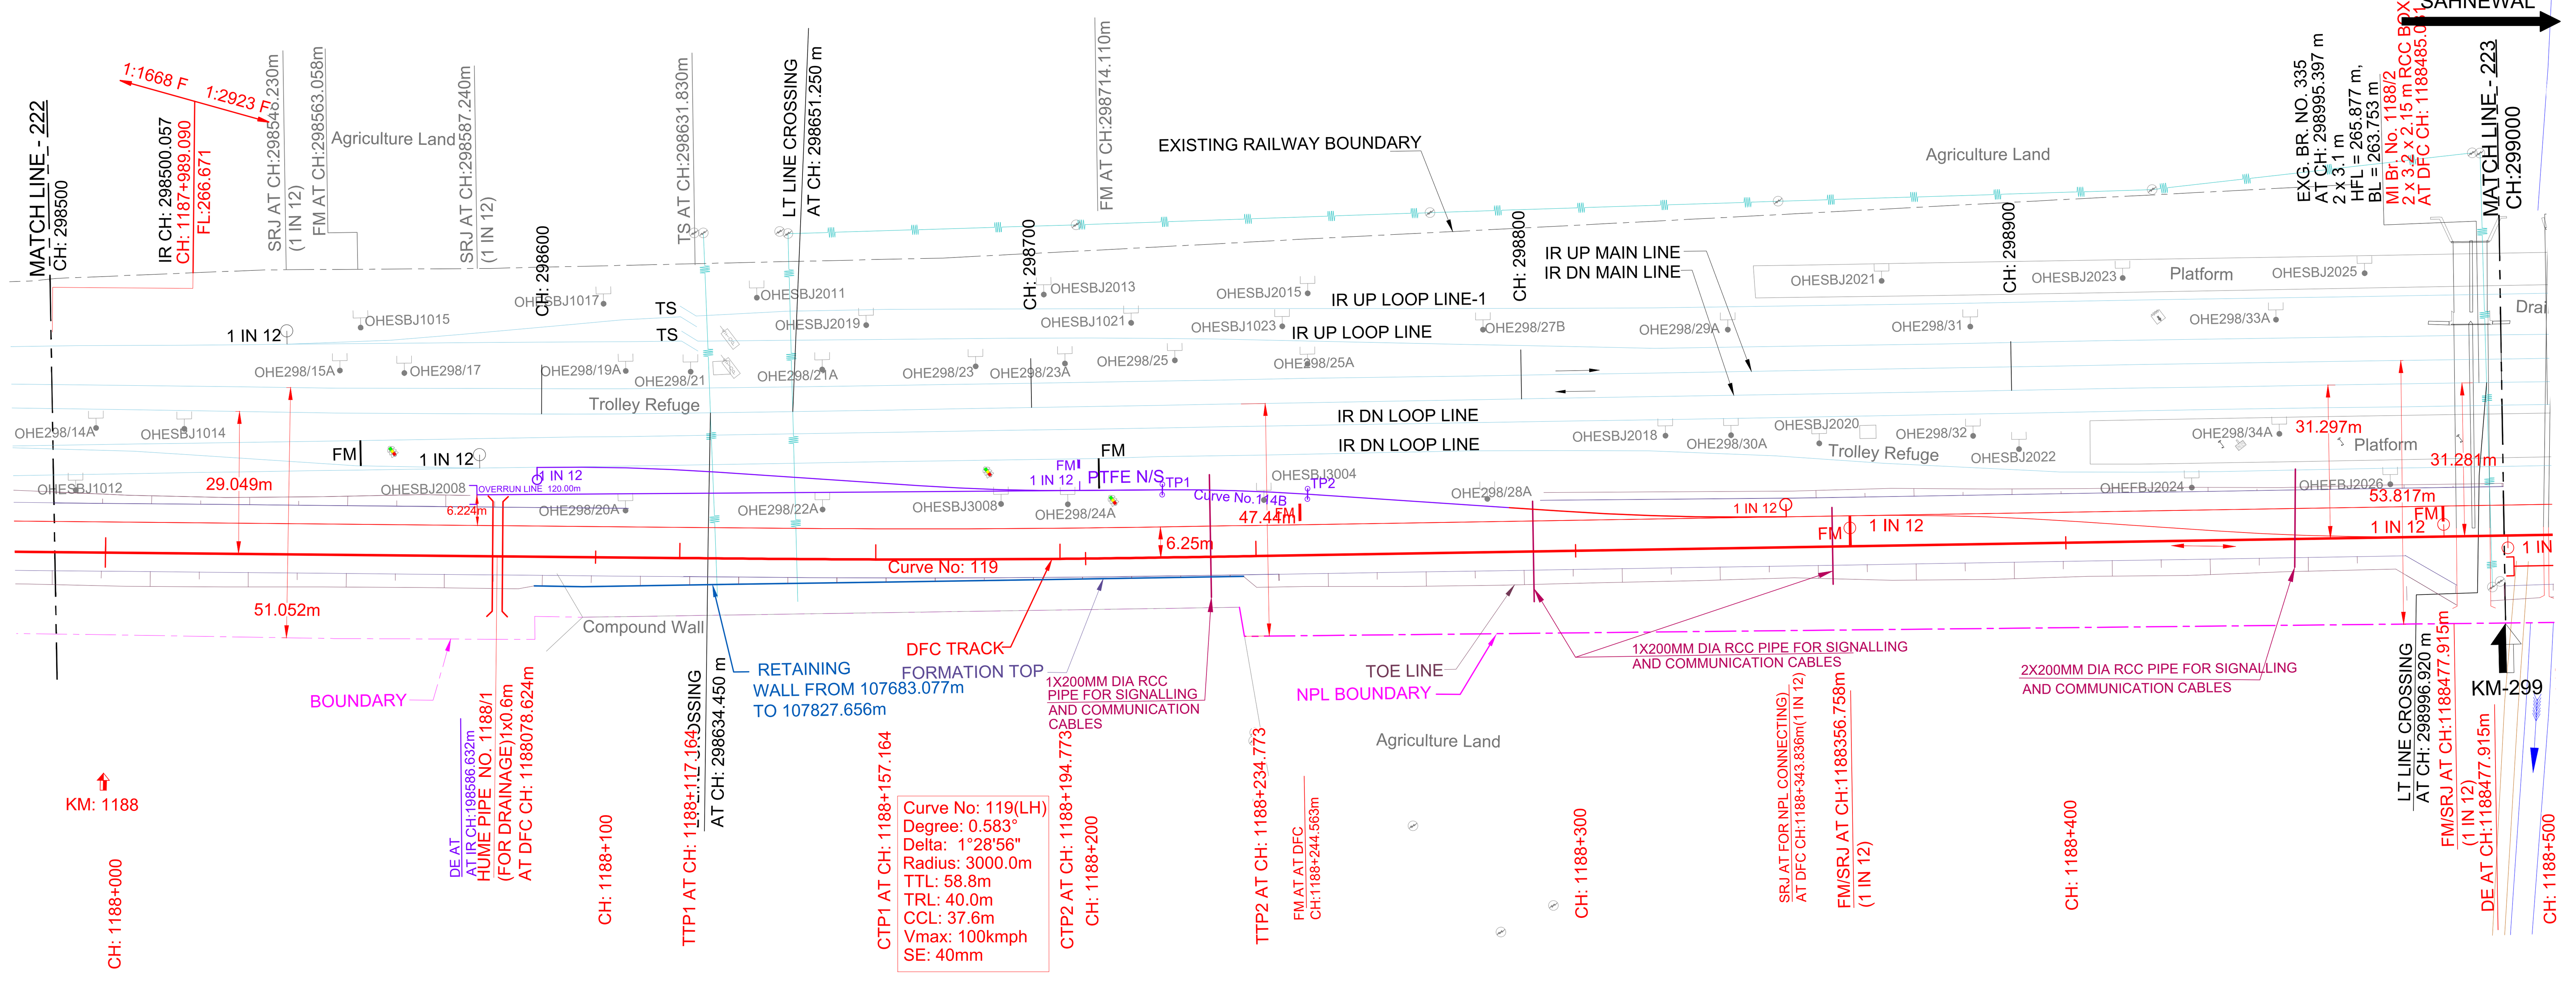


PLAN
1:1000

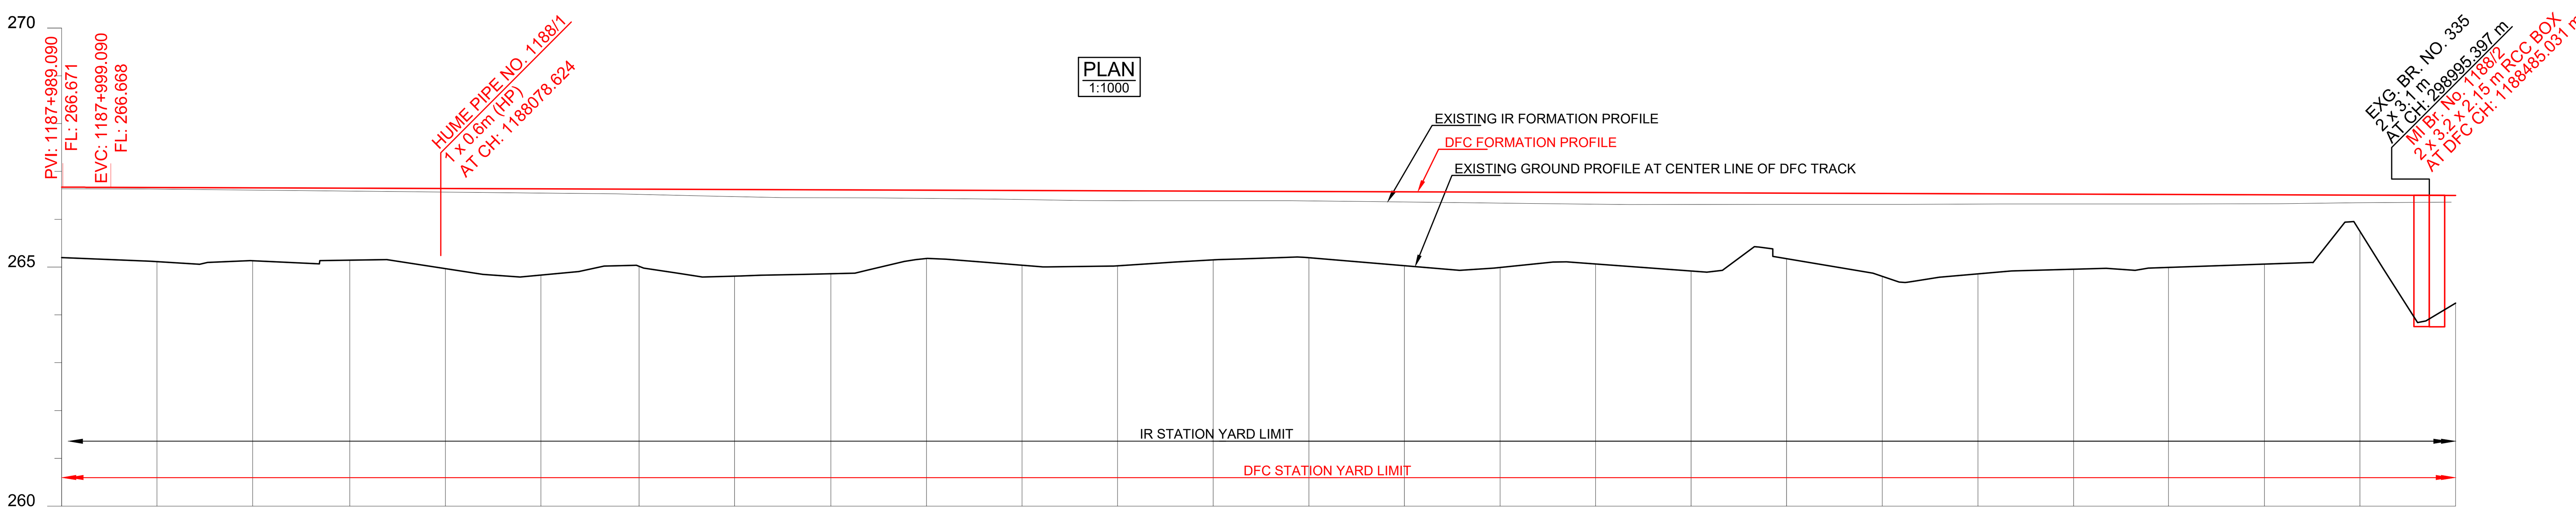

DATUM ABOVE MSL : 260 m

HORIZONTAL ALIGNMENT: L = 818.516m; TL= 40m; R =-3000m; TL= 40m; L = 1484.776m

VERTICAL ALIGNMENT: L=20.0 m, R=-77693 m; L=1002.957 m, 1 IN 2923.294 F

EXISTING IR CHAINAGE	298500.0	298520.0	298540.0	298560.0	298580.0	298600.0	298620.0	298640.0	298660.0	298680.0	298700.0	298720.0	298740.0
TRACK DISTANCE FROM EXISTING NEAREST IR DN MAIN LINE TO DFC MAIN LINE	29.277	29.173	29.032	28.912	29.013	29.115	29.368	29.817	30.263	30.657	30.925	31.051	31.091
HEIGHT OF BANKING(+) / DEPTH OF CUTTING(-) (PFL-GL)	+1.472	+1.549	+1.525	+1.507	+1.675	+1.804	+1.613	+1.811	+1.755	+1.430	+1.562	+1.567	+1.438
EXG GROUND LEVEL AT CENTER LINE OF DFC TRACK (GL)	265.200	265.115	265.133	265.144	264.969	264.833	265.017	264.812	264.861	265.179	265.040	265.029	265.151
EXG GROUND LEVEL AT TOE LOCATION OF DFC TRACK	265.125	265.024	265.058	265.139	265.156	265.106	264.959	264.800	264.916	265.045	265.002	264.957	265.079
DIFFERENCE BETWEEN DFC FORMATION LEVEL AND EXG.FORMATION LEVEL.(PFL-EFL)	0.036	0.034	0.049	0.062	0.076	0.090	0.109	0.147	0.168	0.173	0.189	0.205	0.201
DFC FORMATION LEVEL (PFL)	266.672	266.664	266.658	266.651	266.644	266.637	266.630	266.623	266.616	266.609	266.602	266.596	266.589
EXG. FORMATION LEVEL OF EXG IR DN MAIN LINE (EFL)	266.636	266.630	266.609	266.589	266.568	266.547	266.521	266.476	266.448	266.436	266.413	266.391	266.388
DIFFERENCE BETWEEN DFC RAIL LEVEL AND EXG. RAIL LEVEL (PRL - ERL)	0.076	0.075	0.089	0.102	0.117	0.131	0.150	0.188	0.209	0.214	0.230	0.246	0.242
DFC RAIL LEVEL (PRL)	267.384	267.377	267.370	267.363	267.356	267.350	267.343	267.336	267.329	267.322	267.315	267.309	267.302
EXG.RAIL LEVEL OF NEAREST IR DN MAIN LINE(ERL)	267.308	267.302	267.281	267.261	267.240	267.219	267.193	267.148	267.120	267.108	267.085	267.063	267.060
EQUIVALENT CHAINAGE ON DFC TRACK	1187989.8	1188009.5	1188029.5	1188049.5	1188069.5	1188089.5	1188109.5	1188129.5	1188149.5	1188169.5	1188189.5	1188209.5	1188229.5

EXISTING IR CHAINAGE	298760.0	298780.0	298800.0	298820.0	298840.0	298860.0	298880.0	298900.0	298920.0	298940.0	298960.0	298980.0	299000.0
TRACK DISTANCE FROM EXISTING NEAREST IR DN MAIN LINE TO DFC MAIN LINE	31.109	31.143	31.174	31.204	31.220	31.227	31.234	31.265	31.314	31.303	31.299	31.285	31.280
HEIGHT OF BANKING(+) / DEPTH OF CUTTING(-) (PFL-GL)	+1.386	+1.545	+1.575	+1.497	+1.637	+1.374	+1.735	+1.676	+1.571	+1.527	+1.452	+0.761	+2.255
EXG GROUND LEVEL AT CENTER LINE OF DFC TRACK (GL)	265.196	265.030	264.993	265.064	264.918	265.174	264.806	264.858	264.956	264.993	265.062	265.746	264.245
EXG GROUND LEVEL AT TOE LOCATION OF DFC TRACK	265.122	264.995	264.976	265.055	265.113	265.109	264.767	264.734	264.827	264.812	264.980	264.960	264.840
DIFFERENCE BETWEEN DFC FORMATION LEVEL AND EXG.FORMATION LEVEL.(PFL-EFL)	0.198	0.213	0.228	0.243	0.245	0.237	0.231	0.218	0.207	0.198	0.190	0.163	0.139
DFC FORMATION LEVEL (PFL)	266.582	266.575	266.568	266.561	266.555	266.548	266.541	266.534	266.527	266.520	266.514	266.507	266.500
EXG. FORMATION LEVEL OF EXG IR DN MAIN LINE (EFL)	266.384	266.362	266.340	266.318	266.310	266.311	266.310	266.316	266.320	266.322	266.324	266.344	266.361
DIFFERENCE BETWEEN DFC RAIL LEVEL AND EXG. RAIL LEVEL (PRL - ERL)	0.239	0.254	0.269	0.285	0.286	0.278	0.272	0.259	0.248	0.240	0.231	0.204	0.180
DFC RAIL LEVEL (PRL)	267.295	267.288	267.281	267.274	267.268	267.261	267.254	267.247	267.240	267.233	267.227	267.220	267.213
EXG.RAIL LEVEL OF NEAREST IR DN MAIN LINE(ERL)	267.056	267.034	267.012	266.990	266.982	266.983	266.982	266.988	266.992	266.994	266.996	267.016	267.033
EQUIVALENT CHAINAGE ON DFC TRACK	1188249.5	1188269.5	1188289.5	1188309.5	1188329.5	1188349.5	1188369.5	1188389.5	1188409.5	1188429.5	1188449.5	1188469.5	1188489.7

L - SECTION

DRG NO.- 301-2/AL/A/1223


NOTE:-
1. DFCC WORKS ARE SHOWN IN RED.
2. IR NEW WORKS ARE SHOWN IN VIOLET.
3. ALL DIMENSIONS ARE SHOWN IN METRES.
4. THIS DRAWING IS PREPARED BASED ON LATEST SURVEY DATA HELD ON APRIL-2022. GTS BENCH MARK OF 261.850M CONSIDERED ON TOP OF CANAL BRIDGE ABUTMENT AT DORAHA VILLAGE ALONG THE NH1.
5. DFC NEW CHAINAGE OF 1075.950M IS WITH REFERENCE TO THE IR KM OF 187.500KM END OF KM OF CP-303(SECTION P-3 PILKHANI END) AGAINST THE EXISTING DFC CHAINAGE. 116277.742M ISSUED VIDE LETTER NO. CGM/DFCC/UMB/SURVEY/2021-301-230116-011173 DT. 17.01.2023
6. BALLAST PROFILE HAS BEEN PROVIDED ACCORDING TO THE CLAUSE 1.11.3 OF STANDARD SCHEDULE OF DIMESION(EASTERN CORRIDOR) & THE BALLAST CUSHION DIMESION SHOWN IN 35CM ON GE-14 PARA 17. SPECIFICATIONS & RECOMMENDATIONS 2. TWO LAYER SYSTEM FIG.10.

REFERENCE DRAWINGS :-
1. FOR KEY PLAN REFER DRAWING NO. 301-2/AL/0001
2. FOR LEGEND AND ABBREVIATIONS REFER DRAWING NO. 301-2/AL1000
3. FOR TYPICAL SECTION OF BALLAST PROFILE (FL-RL) REFFER DRG. NO. 301-2/TK/TFD/-004 (TR.1952)

REV.	DATE	REVISION DETAILS	PURPOSE OF ISSUE
0	09.09.2024	SUBMISSION OF AS-BUILT DRAWING	FOR APPROVAL

SCALE
HOR - 1:1000 (0, 10, 20, 30, 40m)
VER - 1:100 (0, 1, 2, 3, 4m)
SHEET SIZE : A1

LEGEND:
- IR TRACK
- DFCC TRACK
- DFCC FUTURE PROPOSALS
- STRUCTURE / BUILDING
- DFCC TOE LINE
- DFCC FORMATION
- RETAINING WALL
- ROAD
- STREAM, DRAIN, NALA, CANAL.
- FENCE
- POWER LINES
- TBM
- ELECTRIC POLE/OHE MAST
- IR RAILWAY BOUNDARY
- DFCC BOUNDARY

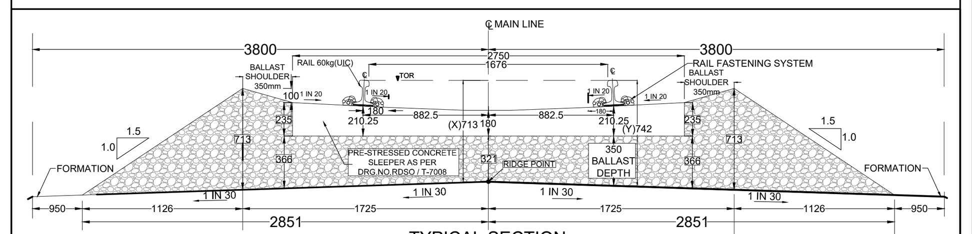

TYPICAL SECTION

TRACK STRUCTURE		
RAIL SECTION: 60Kg/m (UIC 60Kg/m) DFC LINE: 60Kg/m (UIC 60Kg/m) IR MAIN LINE:52Kg/m	Difference between FL- RL (Below Rail Seat)	
	IR Line	DFC
	172mm	172mm
RUBBER PAD	6mm	10mm
SLEEPER DEPTH	210mm	210mm
BALLAST CUSHION	300mm	350mm
Total Depth (FL TO RL)	688mm	742mm

OWNER
DEDICATED FREIGHT CORRIDOR CORPORATION OF INDIA LTD.
(A GOVERNMENT OF INDIA ENTERPRISE)
PROJECT OFFICE(AMBALA UNIT): OLD RAILWAY COLONY (NEAR ANAND MARKET),AMBALA CANTT-133001.
CORPORATE IDENTITY NO. : U60232DL2006GOI155068

ENGINEER:
DB Engineering & Consulting GmbH
Deutsche Bahn Engineering & Consulting GmbH

CONTRACTOR:
GIL - TPL JV

SUBMITTED BY	GIL - TPL JV		
	DATED	NAME	SIGNATURE
PREPARED BY			
CHECKED BY	09.09.2024	VIJAY PRATAP	
APPROVED BY	09.09.2024	PARASURAM KOTYADA	

APPROVED BY	DEUTSCHE BAHN ENGINEERING & CONSULTING GMBH		
	DATED	NAME	SIGNATURE
Sr. DE./CHIEF ENGINEER		SURESH K.YALANGI	
CHIEF TRACK ENGINEER		RAJ PAL SINGH	
T.L.		H.D. VIDJAK	

STAMP
A — AS-BUILT DRAWING
TR. Ref......................
ENGINEER Sign.:

EMPLOYER (DFCCIL): DEDICATED FREIGHT CORRIDOR CORPORATION OF INDIA LTD.

AS BUILT DRAWING

TITLE
AS-BUILT PLAN AND PROFILE
FROM IR KM: 298.500 TO 299.000
DFC KM: 1187.990 TO 1188.490

DFCC APPR. NO. -
ENGG. APPR. NO. -
DRG. NO. - 301-2/AL/A/1223
SHEET NO. : 1 OF 1
DATE : 09.09.2024
STATUS
A

TR.