

DRG NO.- 301-2/AL/A/1226

PILKHANI ← → SAHNEWAL

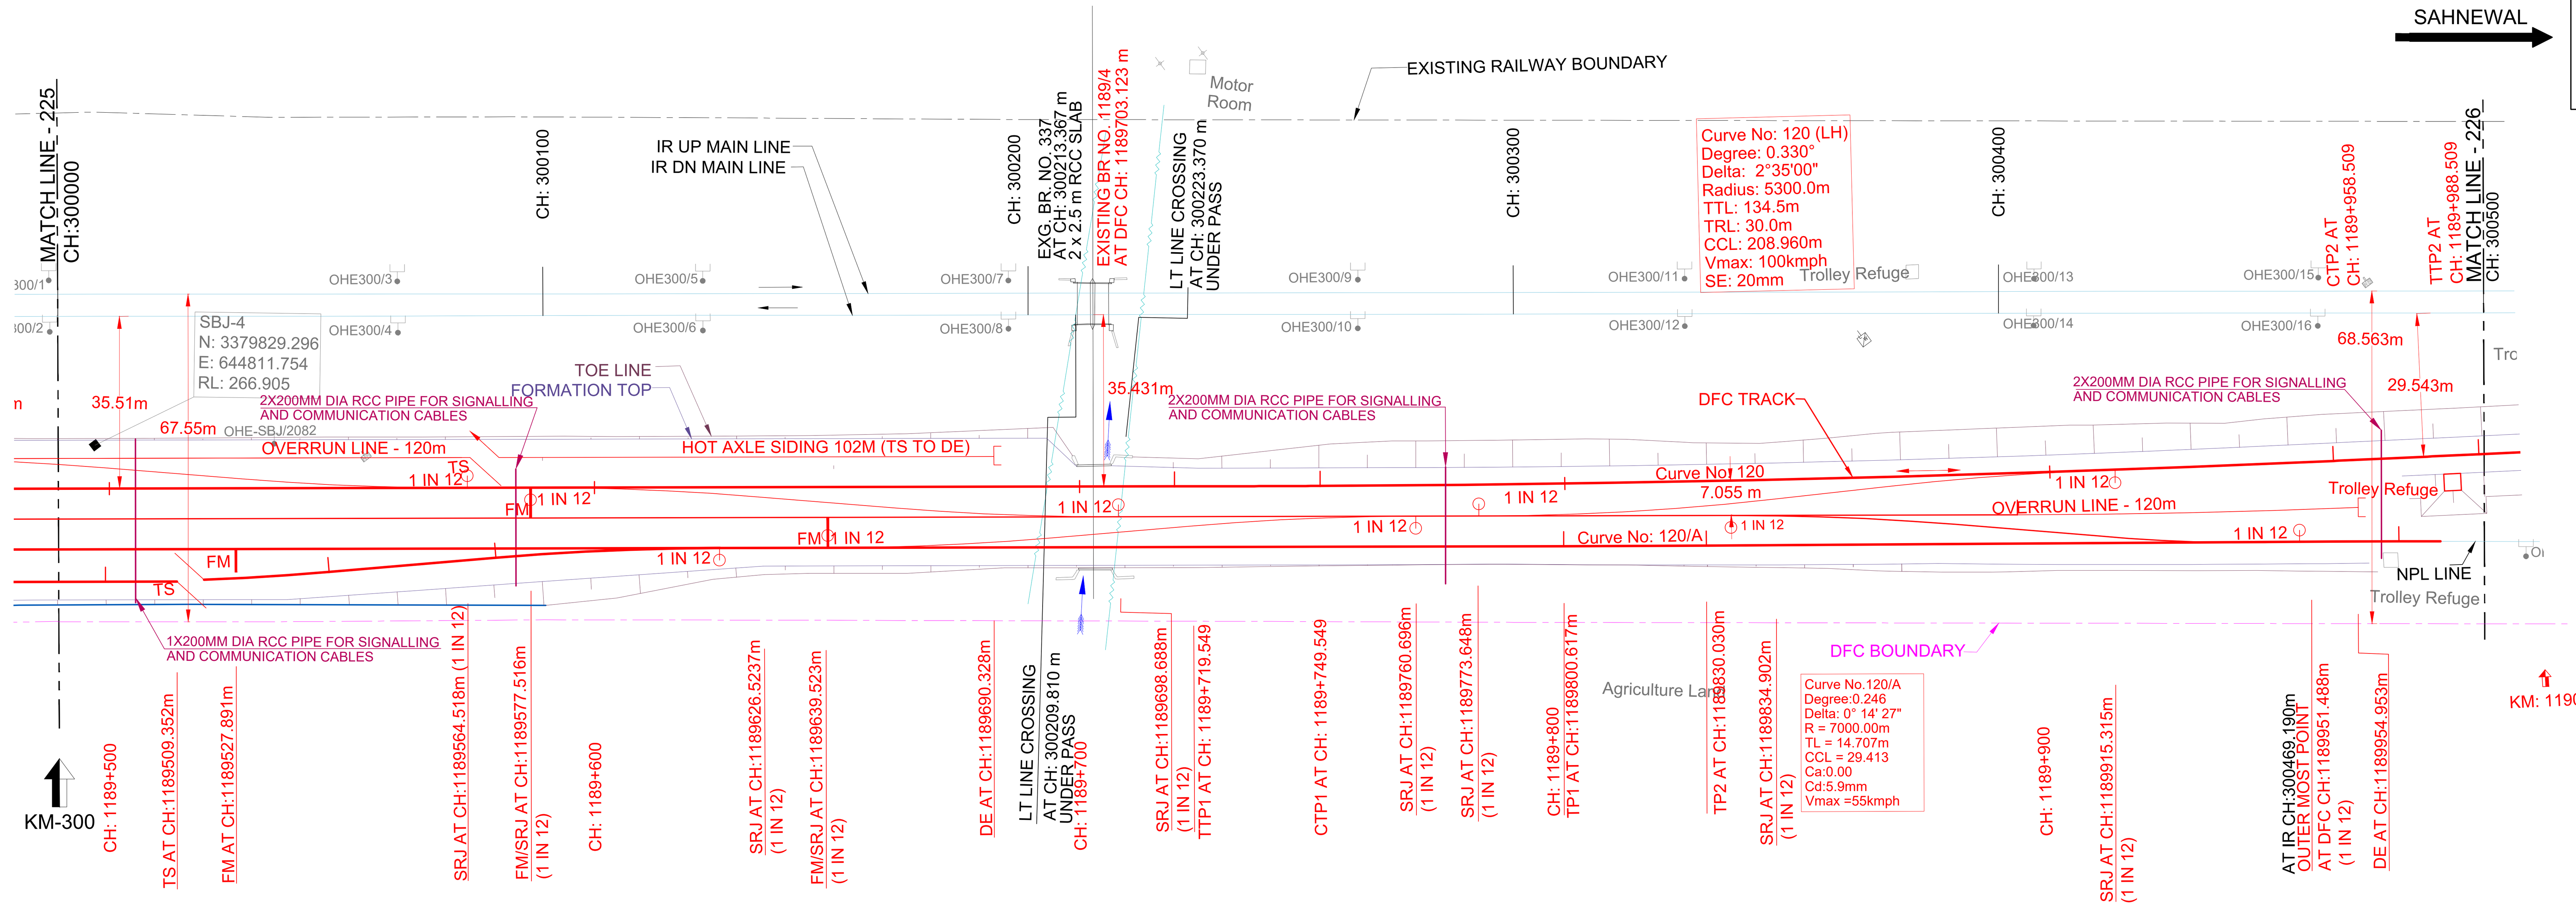

PLAN
1:1000

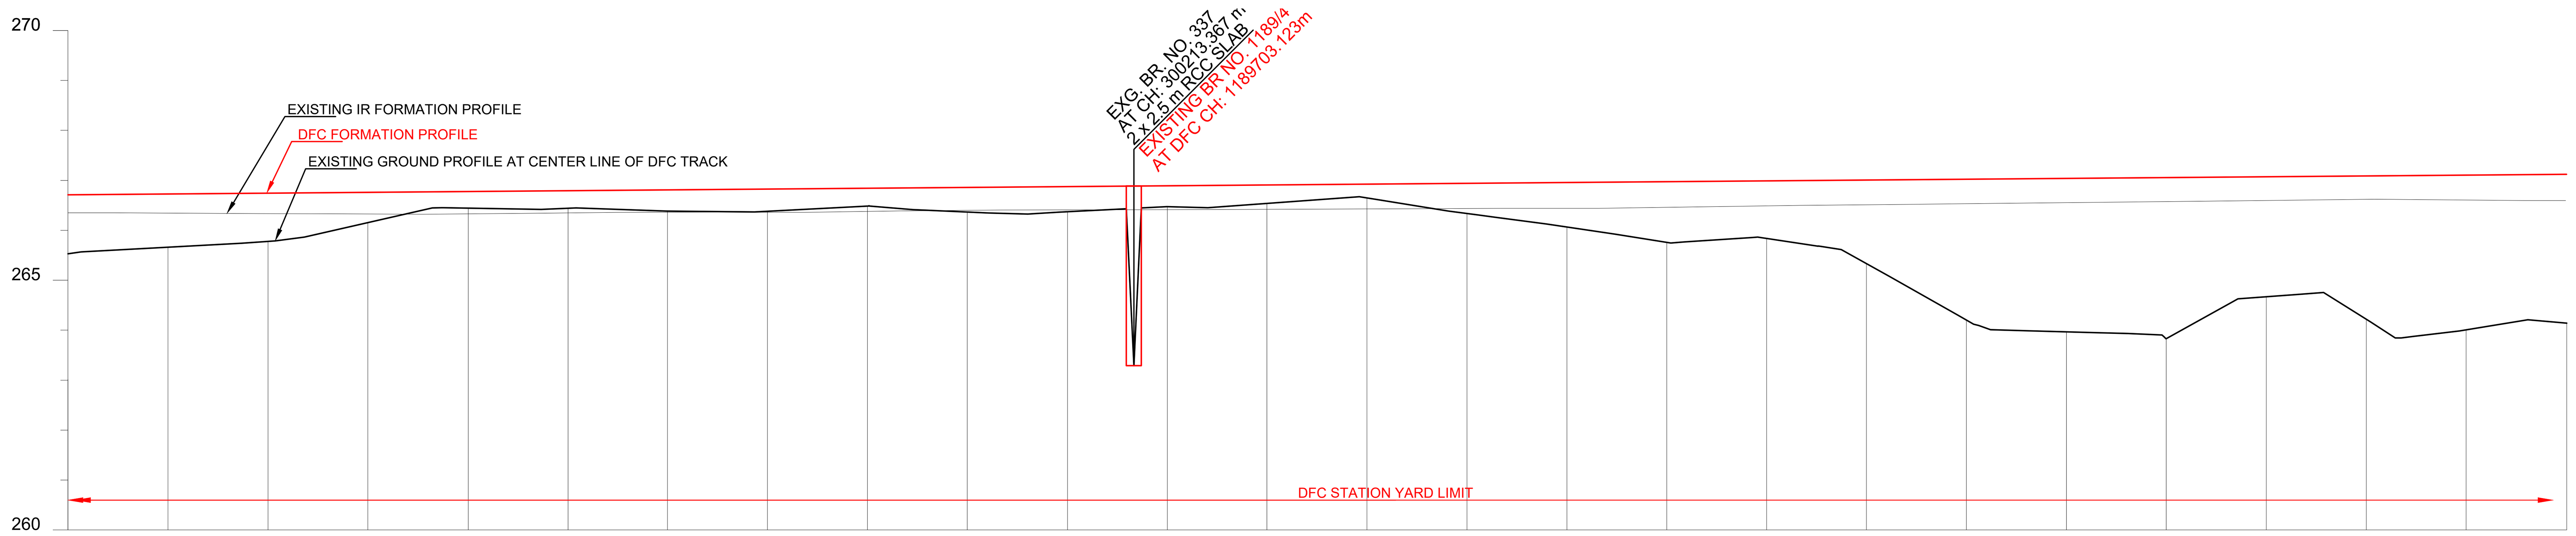

DATUM ABOVE MSL : 260 m

HORIZONTAL ALIGNMENT: L = 1484.776m; TL= 30m; R =-5300m; TL= 30m; L = 291.884m

VERTICAL ALIGNMENT: L=1107.832 m, 1 IN 1219.493 R

EXISTING IR CHAINAGE	TRACK DISTANCE FROM EXISTING NEAREST IR DN MAIN LINE TO DFC MAIN LINE	HEIGHT OF BANKING(+) / DEPTH OF CUTTING(-) (PFL-GL)	EXG GROUND LEVEL AT CENTER LINE OF DFC TRACK (GL)	EXG GROUND LEVEL AT TOE LOCATION OF DFC TRACK	DIFFERENCE BETWEEN DFC FORMATION LEVEL AND EXG.FORMATION LEVEL.(PFL-EFL)	DFC FORMATION LEVEL (PFL)	EXG. FORMATION LEVEL OF EXG IR DN MAIN LINE (EFL)	DIFFERENCE BETWEEN DFC RAIL LEVEL AND EXG. RAIL LEVEL (PRL - ERL)	DFC RAIL LEVEL (PRL)	EXG.RAIL LEVEL OF NEAREST IR DN MAIN LINE(ERL)	EQUIVALENT CHAINAGE ON DFC TRACK
300000.0	35.536	+1.183	265.530	263.831	0.363	266.713	266.350	0.404	267.426	267.022	1189489.7
300020.0	35.501	+1.067	265.662	263.776	0.385	266.729	266.344	0.426	267.442	267.016	1189509.6
300040.0	35.468	+0.969	265.777	263.785	0.412	266.746	266.334	0.453	267.458	267.006	1189529.6
300060.0	35.454	+0.606	266.156	263.845	0.436	266.762	266.326	0.477	267.475	266.998	1189549.6
300080.0	35.459	+0.335	266.443	263.930	0.448	266.778	266.330	0.490	267.491	267.002	1189569.7
300100.0	35.488	+0.352	266.443	264.220	0.447	266.795	266.348	0.488	267.508	267.020	1189589.7
300120.0	35.488	+0.427	266.384	264.786	0.451	266.811	266.360	0.492	267.524	267.032	1189609.6
300140.0	35.458	+0.448	266.380	265.781	0.467	266.828	266.361	0.507	267.540	267.033	1189629.6
300160.0	35.437	+0.357	266.487	265.976	0.466	266.844	266.378	0.506	267.557	267.050	1189649.6
300180.0	35.422	+0.496	266.364	266.107	0.460	266.860	266.400	0.501	267.573	267.072	1189669.6
300200.0	35.424	+0.504	266.373	266.533	0.468	266.877	266.409	0.509	267.590	267.081	1189689.6
300220.0	35.435	+0.420	266.473	266.538	0.481	266.893	266.412	0.522	267.606	267.084	1189709.6
300240.0	35.421	+0.372	266.538	266.585	0.492	266.910	266.418	0.532	267.622	267.090	1189729.6
300260.0	35.373	+0.288	266.638	266.715	0.498	266.926	266.428	0.539	267.639	267.100	1189749.6
300280.0	35.269	+0.646	266.296	266.815	0.504	266.942	266.438	0.545	267.655	267.110	1189769.6
300300.0	35.099	+0.967	265.992	266.873	0.518	266.959	266.441	0.558	267.672	267.113	1189789.6
300320.0	34.852	+1.312	265.663	266.874	0.514	266.975	266.461	0.555	267.688	267.133	1189809.6
300340.0	34.528	+1.229	265.763	266.729	0.504	266.992	266.488	0.544	267.704	267.160	1189829.6
300360.0	34.121	+1.770	265.238	266.562	0.496	267.008	266.512	0.537	267.721	267.184	1189849.6
300380.0	33.633	+2.916	264.108	266.165	0.491	267.024	266.533	0.532	267.737	267.205	1189869.6
300400.0	33.067	+3.072	263.969	265.858	0.487	267.041	266.554	0.528	267.754	267.226	1189889.6
300420.0	32.424	+3.235	263.822	265.463	0.482	267.057	266.575	0.523	267.770	267.247	1189909.6
300440.0	31.697	+2.374	264.700	265.200	0.477	267.074	266.597	0.518	267.786	267.269	1189929.6
300460.0	30.890	+2.867	264.223	264.939	0.470	267.090	266.620	0.510	267.803	267.292	1189949.6
300480.0	30.002	+3.100	264.006	264.698	0.501	267.106	266.605	0.542	267.819	267.277	1189969.6
300500.0	29.088	+2.982	264.141	264.498	0.527	267.123	266.596	0.568	267.836	267.268	1189989.7

L - SECTION


NOTE:-
1. DFCC WORKS ARE SHOWN IN RED.
2. IR NEW WORKS ARE SHOWN IN VIOLET.
3. ALL DIMENSIONS ARE SHOWN IN METRES.
4. THIS DRAWING IS PREPARED BASED ON LATEST SURVEY DATA HELD ON APRIL-2022. GTS BENCH MARK OF 261.850M CONSIDERED ON TOP OF CANAL BRIDGE ABUTMENT AT DORAHA VILLAGE ALONG THE NH1.
5. DFC NEW CHAINAGE OF 1075.950M IS WITH REFERENCE TO THE IR KM OF 187.500KM END OF KM OF CP-303(SECTION P-3 PILKHANI END) AGAINST THE EXISTING DFC CHAINAGE. 116277.742M ISSUED VIDE LETTER NO. CGM/DFCC/UMB/SURVEY/2021-301-230116-011173 DT. 17.01.2023
6. BALLAST PROFILE HAS BEEN PROVIDED ACCORDING TO THE CLAUSE 1.11.3 OF STANDARD SCHEDULE OF DIMESION(EASTERN CORRIDOR) & THE BALLAST CUSHION DIMESION SHOWN IN 35CM ON GE-14 PARA 17. SPECIFICATIONS & RECOMMENDATIONS 2. TWO LAYER SYSTEM FIG.10.

REFERENCE DRAWINGS :-
1. FOR KEY PLAN REFER DRAWING NO. 301-2/AL/0001
2. FOR LEGEND AND ABBREVIATIONS REFER DRAWING NO. 301-2/AL1000
3. FOR TYPICAL SECTION OF BALLAST PROFILE (FL-RL) REFFER DRG. NO. 301-2/TK/TFD/-004 (TR.1952)

REV.	DATE	REVISION DETAILS	PURPOSE OF ISSUE
0	09.09.2024	SUBMISSION OF AS-BUILT DRAWING	FOR APPROVAL

SCALE
HOR - 1:1000 (0, 10, 20, 30, 40m)
VER - 1:100 (0, 1, 2, 3, 4m)
SHEET SIZE : A1

LEGEND:
- IR TRACK
- DFCC TRACK
- DFCC FUTURE PROPOSALS
- STRUCTURE / BUILDING
- DFCC TOE LINE
- DFCC FORMATION
- RETAINING WALL
- ROAD
- STREAM, DRAIN, NALA, CANAL.
- FENCE
- POWER LINES
- TBM
- ELECTRIC POLE/OHE MAST
- IR RAILWAY BOUNDARY
- DFCC BOUNDARY

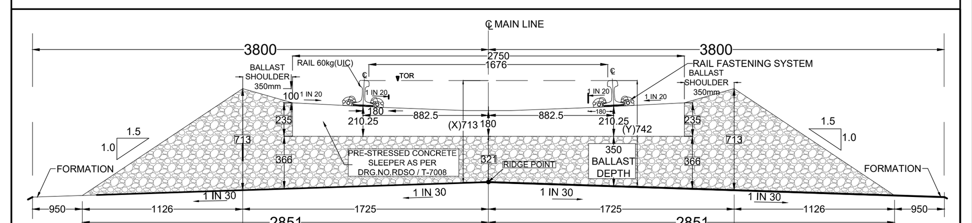

TYPICAL SECTION

TRACK STRUCTURE	Difference between FL- RL (Below Rail Seat)	
RAIL SECTION: 60Kg/m (UIC 60Kg/m) DFC LINE: 60Kg/m (UIC 60Kg/m) IR MAIN LINE:52Kg/m	IR Line	DFC
	172mm	172mm
RUBBER PAD	6mm	10mm
SLEEPER DEPTH	210mm	210mm
BALLAST CUSHION	300mm	350mm
Total Depth (FL TO RL)	688mm	742mm

OWNER
DEDICATED FREIGHT CORRIDOR CORPORATION OF INDIA LTD.
(A GOVERNMENT OF INDIA ENTERPRISE)
PROJECT OFFICE(AMBALA UNIT): OLD RAILWAY COLONY (NEAR ANAND MARKET),AMBALA CANTT-133001.
CORPORATE IDENTITY NO. : U60232DL2006GOI155068

ENGINEER:
DB Engineering & Consulting GmbH
Deutsche Bahn Engineering & Consulting GmbH

CONTRACTOR:
GIL - TPL JV

SUBMITTED BY	GIL - TPL JV		
	DATED	NAME	SIGNATURE
PREPARED BY			
CHECKED BY	09.09.2024	VIJAY PRATAP	
APPROVED BY	09.09.2024	PARASURAM KOTYADA	

APPROVED BY	DEUTSCHE BAHN ENGINEERING & CONSULTING GMBH		
	DATED	NAME	SIGNATURE
Sr. DE./CHIEF ENGINEER		SURESH K.YALANGI	
CHIEF TRACK ENGINEER		RAJ PAL SINGH	
T.L.		H.D. VIDJAK	

STAMP
A
AS-BUILT DRAWING
TR. Ref......................
ENGINEER Sign.:

EMPLOYER (DFCCIL): DEDICATED FREIGHT CORRIDOR CORPORATION OF INDIA LTD.

AS BUILT DRAWING

TITLE
AS-BUILT PLAN AND PROFILE
FROM IR KM: 300.000 TO 300.500
DFC KM: 1189.490 TO 1189.990

DFCC APPR. NO. -
ENGG. APPR. NO. -
DRG. NO. - 301-2/AL/A/1226
SHEET NO. : 1 OF 1
DATE : 09.09.2024
STATUS A

TR.