

PILKHANI ← → SAHNEWAL

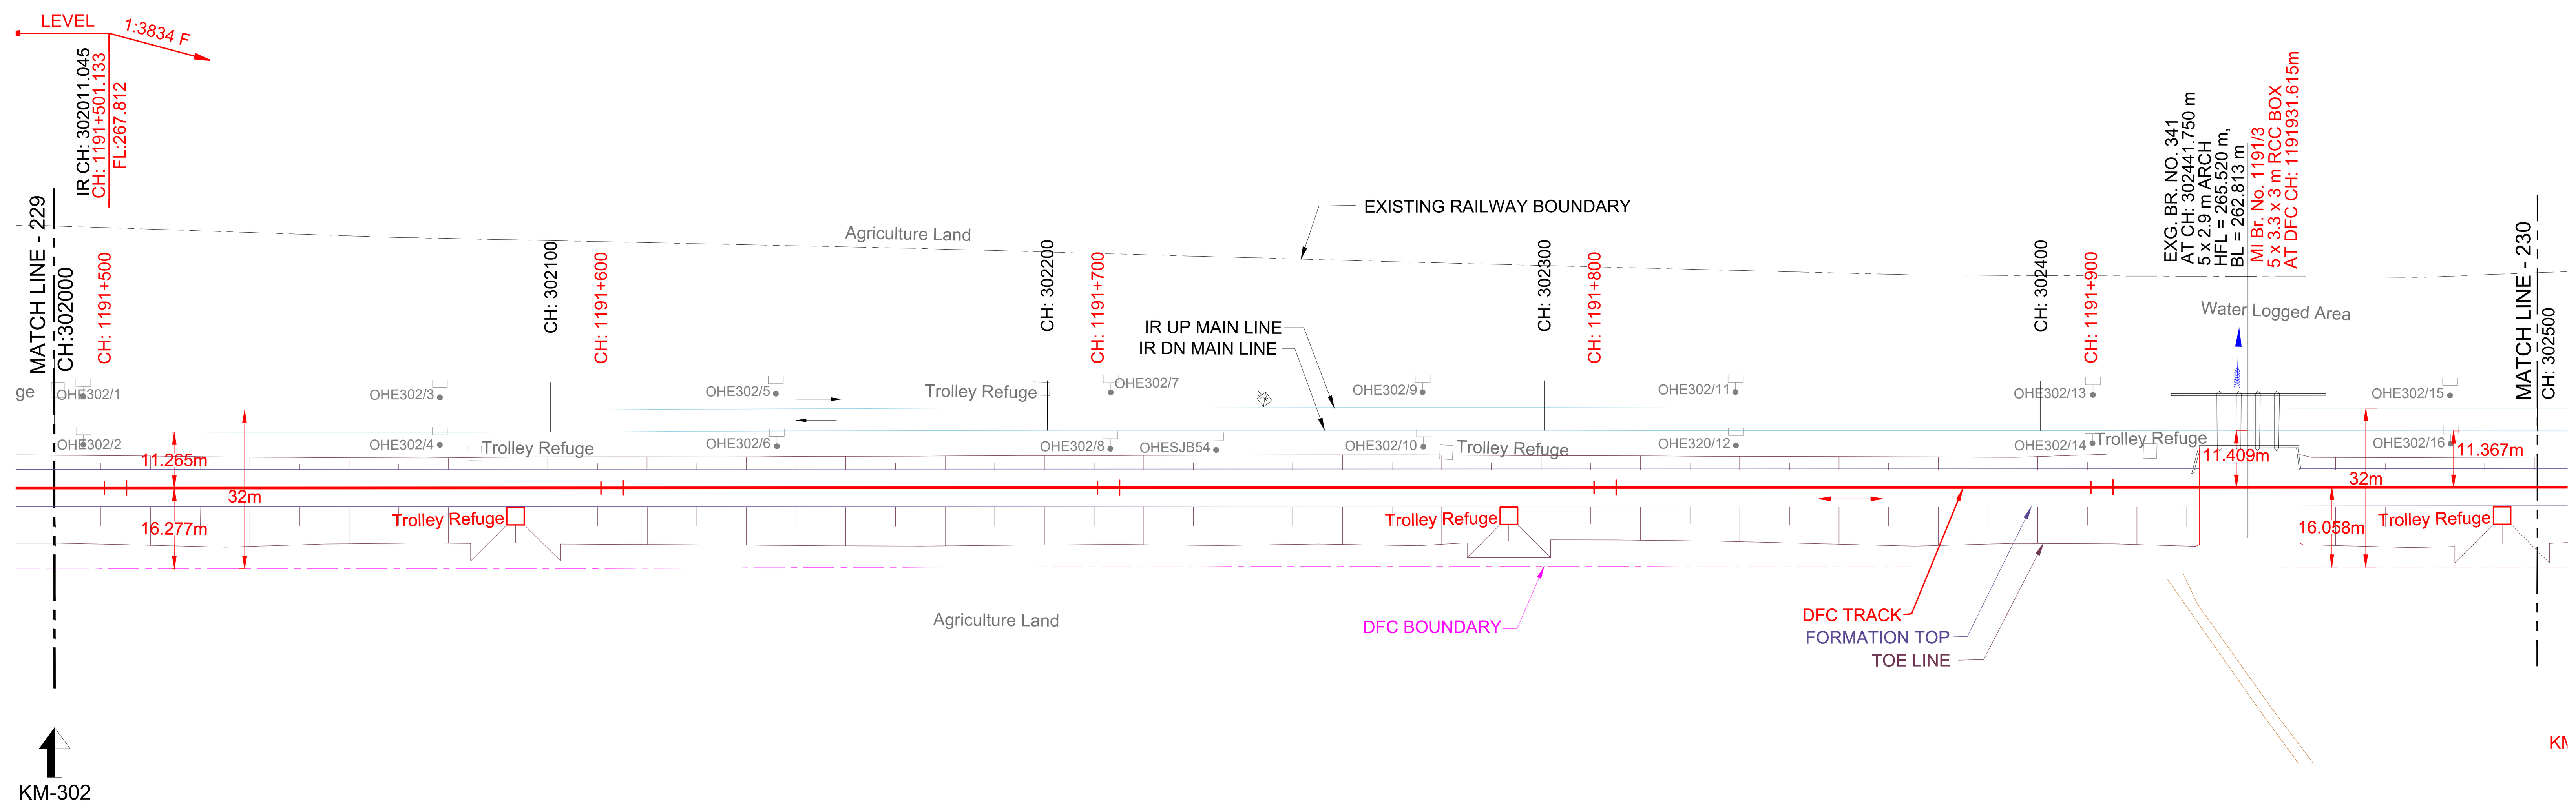

PLAN
1:1000

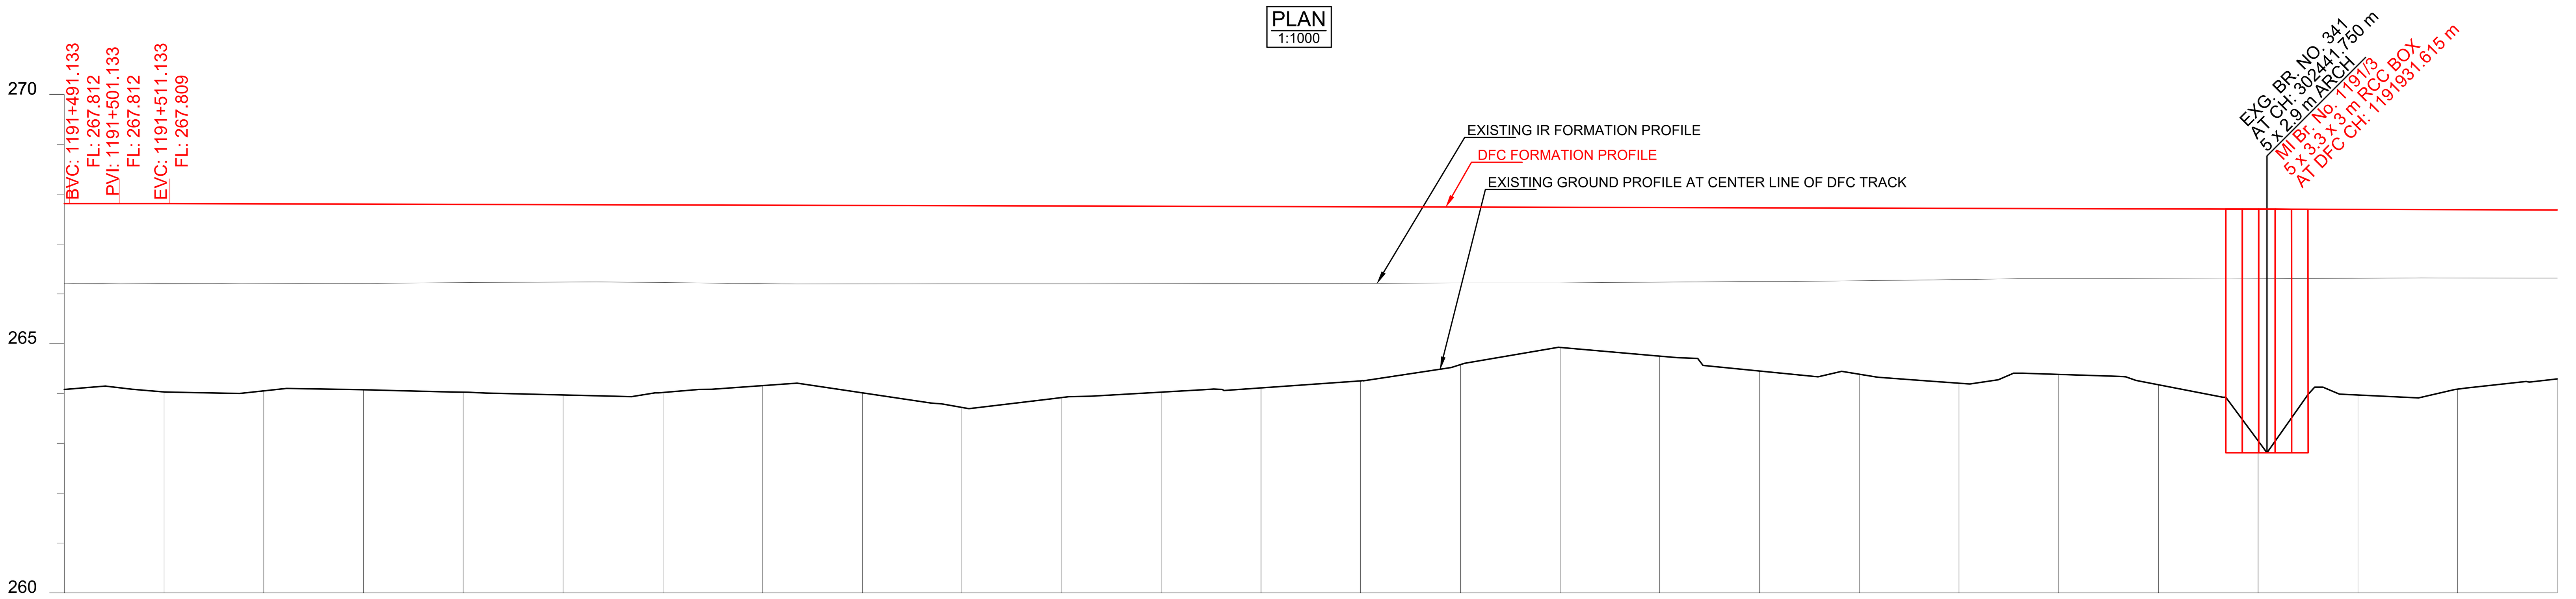

DATUM ABOVE MSL : 260 m

HORIZONTAL ALIGNMENT: L = 1896.657m

VERTICAL ALIGNMENT: L=221.496m LEVEL; L=20.0 m R=76681 m; L=1820.969 m 1 IN 3834.074 F

EXISTING IR CHAINAGE	302000.0	302020.0	302040.0	302060.0	302080.0	302100.0	302120.0	302140.0	302160.0	302180.0	302200.0	302220.0	302240.0
TRACK DISTANCE FROM EXISTING NEAREST IR DN MAIN LINE TO DFC MAIN LINE	11.280	11.268	11.249	11.231	11.244	11.256	11.330	11.434	11.494	11.532	11.569	11.569	11.556
HEIGHT OF BANKING(+) / DEPTH OF CUTTING(-) (PFL-GL)	+3.730	+3.777	+3.748	+3.724	+3.767	+3.817	+3.761	+3.619	+3.759	+4.046	+3.844	+3.728	+3.639
EXG GROUND LEVEL AT CENTER LINE OF DFC TRACK (GL)	264.082	264.033	264.056	264.075	264.027	263.972	264.023	264.159	264.014	263.722	263.919	264.030	264.113
EXG GROUND LEVEL AT TOE LOCATION OF DFC TRACK	264.120	263.906	263.798	264.054	264.093	264.006	263.935	263.875	263.804	263.790	263.874	263.886	263.838
DIFFERENCE BETWEEN DFC FORMATION LEVEL AND EXG.FORMATION LEVEL.(PFL-EFL)	1.595	1.601	1.588	1.587	1.567	1.550	1.556	1.571	1.572	1.566	1.561	1.553	1.545
DFC FORMATION LEVEL (PFL)	267.812	267.810	267.804	267.799	267.794	267.789	267.784	267.778	267.773	267.768	267.763	267.758	267.752
EXG. FORMATION LEVEL OF EXG IR DN MAIN LINE (EFL)	266.217	266.209	266.216	266.212	266.227	266.239	266.228	266.207	266.201	266.202	266.202	266.205	266.207
DIFFERENCE BETWEEN DFC RAIL LEVEL AND EXG. RAIL LEVEL (PRL - ERL)	1.636	1.642	1.629	1.628	1.608	1.591	1.596	1.613	1.613	1.606	1.601	1.594	1.586
DFC RAIL LEVEL (PRL)	268.525	268.523	268.517	268.512	268.507	268.502	268.497	268.491	268.486	268.481	268.476	268.471	268.465
EXG.RAIL LEVEL OF NEAREST IR DN MAIN LINE(ERL)	266.889	266.881	266.888	266.884	266.899	266.911	266.900	266.879	266.873	266.874	266.874	266.877	266.879
EQUIVALENT CHAINAGE ON DFC TRACK	1191490.1	1191510.1	1191530.1	1191550.1	1191570.1	1191590.1	1191610.1	1191630.1	1191650.1	1191670.1	1191690.1	1191710.1	1191730.1

EXISTING IR CHAINAGE	302260.0	302280.0	302300.0	302320.0	302340.0	302360.0	302380.0	302400.0	302420.0	302440.0	302460.0	302480.0	302500.0
TRACK DISTANCE FROM EXISTING NEAREST IR DN MAIN LINE TO DFC MAIN LINE	11.544	11.535	11.526	11.510	11.495	11.481	11.472	11.457	11.433	11.411	11.392	11.572	11.350
HEIGHT OF BANKING(+) / DEPTH OF CUTTING(-) (PFL-GL)	+3.491	+3.160	+2.809	+2.982	+3.273	+3.334	+3.507	+3.326	+3.530		+3.725	+3.602	+3.388
EXG GROUND LEVEL AT CENTER LINE OF DFC TRACK (GL)	264.256	264.582	264.928	264.749	264.453	264.387	264.209	264.385	264.175	263.826	263.970	264.088	264.296
EXG GROUND LEVEL AT TOE LOCATION OF DFC TRACK	263.887	263.927	264.347	264.289	264.139	263.864	263.752	263.941	263.818	263.633	263.705	263.557	263.842
DIFFERENCE BETWEEN DFC FORMATION LEVEL AND EXG.FORMATION LEVEL.(PFL-EFL)	1.537	1.522	1.516	1.494	1.476	1.457	1.427	1.408	1.403	1.396	1.381	1.371	1.368
DFC FORMATION LEVEL (PFL)	267.747	267.742	267.737	267.731	267.726	267.721	267.716	267.711	267.705	267.700	267.695	267.690	267.684
EXG. FORMATION LEVEL OF EXG IR DN MAIN LINE (EFL)	266.210	266.220	266.221	266.237	266.250	266.264	266.289	266.303	266.302	266.304	266.314	266.319	266.316
DIFFERENCE BETWEEN DFC RAIL LEVEL AND EXG. RAIL LEVEL (PRL - ERL)	1.578	1.563	1.557	1.535	1.517	1.498	1.468	1.449	1.444	1.437	1.422	1.412	1.410
DFC RAIL LEVEL (PRL)	268.460	268.455	268.450	268.444	268.439	268.434	268.429	268.424	268.418	268.413	268.408	268.403	268.397
EXG.RAIL LEVEL OF NEAREST IR DN MAIN LINE(ERL)	266.882	266.892	266.893	266.909	266.922	266.936	266.961	266.975	266.974	266.976	266.986	266.991	266.988
EQUIVALENT CHAINAGE ON DFC TRACK	1191750.1	1191770.1	1191790.1	1191810.1	1191830.1	1191850.1	1191870.1	1191890.1	1191910.1	1191930.1	1191950.1	1191970.1	1191990.1

L - SECTION

DRG NO.- 301-2/AL/A/1230

NOTE:-

1. DFCC WORKS ARE SHOWN IN RED.
2. IR NEW WORKS ARE SHOWN IN VIOLET.
3. ALL DIMENSIONS ARE SHOWN IN METRES.
4. THIS DRAWING IS PREPARED BASED ON LATEST SURVEY DATA HELD ON APRIL-2022. GTS BENCH MARK OF 261.850M CONSIDERED ON TOP OF CANAL BRIDGE ABUTMENT AT DORAHA VILLAGE ALONG THE NH1.
5. DFC NEW CHAINAGE OF 1075.950M IS WITH REFERENCE TO THE IR KM OF 187.500KM END OF KM OF CP-303(SECTION P-3 PILKHANI END) AGAINST THE EXISTING DFC CHAINAGE. 116277.742M ISSUED VIDE LETTER NO. CGM/DFCC/UMB/SURVEY/2021-301-230116-011173 DT. 17.01.2023
6. BALLAST PROFILE HAS BEEN PROVIDED ACCORDING TO THE CLAUSE 1.11.3 OF STANDARD SCHEDULE OF DIMESION(EASTERN CORRIDOR) & THE BALLAST CUSHION DIMESION SHOWN IN 35CM ON GE-14 PARA 17. SPECIFICATIONS & RECOMMENDATIONS 2. TWO LAYER SYSTEM FIG.10.

REFERENCE DRAWINGS :-


1. FOR KEY PLAN REFER DRAWING NO. 301-2/AL/0001
2. FOR LEGEND AND ABBREVIATIONS REFER DRAWING NO. 301-2/AL1000
3. FOR TYPICAL SECTION OF BALLAST PROFILE (FL-RL) REFFER DRG. NO. 301-2/TK/TFD/-004 (TR.1952)

REV.	DATE	REVISION DETAILS	PURPOSE OF ISSUE
0	07.09.2024	SUBMISSION OF AS-BUILT DRAWING	FOR APPROVAL

SCALE
HOR - 1:1000 (0, 10, 20, 30, 40m)
VER - 1:100 (0, 1, 2, 3, 4m)
SHEET SIZE : A1

LEGEND:

- IR TRACK
- DFCC TRACK
- DFCC FUTURE PROPOSALS
- STRUCTURE / BUILDING
- DFCC TOE LINE
- DFCC FORMATION
- RETAINING WALL
- ROAD
- STREAM, DRAIN, NALA, CANAL.
- FENCE
- POWER LINES
- TBM
- ELECTRIC POLE/OHE MAST
- IR RAILWAY BOUNDARY
- DFCC BOUNDARY

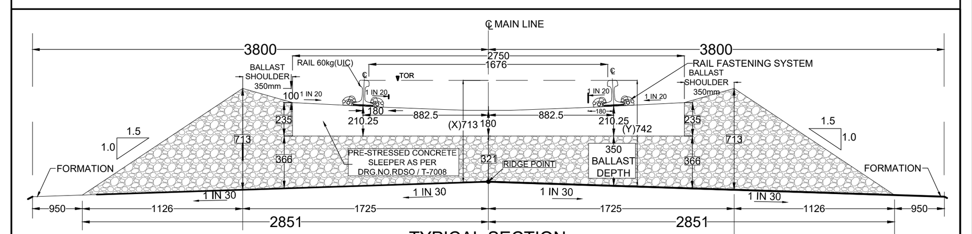

TYPICAL SECTION

TRACK STRUCTURE

	Difference between FL- RL (Below Rail Seat)	
RAIL SECTION: 60Kg/m (UIC 60Kg/m) DFC LINE: 60Kg/m (UIC 60Kg/m) IR MAIN LINE:52Kg/m	IR Line	DFC
	172mm	172mm
RUBBER PAD	6mm	10mm
SLEEPER DEPTH	210mm	210mm
BALLAST CUSHION	300mm	350mm
Total Depth (FL TO RL)	688mm	742mm

OWNER
DEDICATED FREIGHT CORRIDOR CORPORATION OF INDIA LTD.
(A GOVERNMENT OF INDIA ENTERPRISE)
PROJECT OFFICE(AMBALA UNIT): OLD RAILWAY COLONY (NEAR ANAND MARKET),AMBALA CANTT-133001.
CORPORATE IDENTITY NO. : U60232DL2006GOI155068

ENGINEER:
DB Engineering & Consulting GmbH
Deutsche Bahn Engineering & Consulting GmbH

CONTRACTOR:
GIL - TPL JV

SUBMITTED BY	GIL - TPL JV		
	DATED	NAME	SIGNATURE
PREPARED BY			
CHECKED BY	07.09.2024	VIJAY PRATAP	
APPROVED BY	07.09.2024	PARASURAM KOTYADA	

APPROVED BY	DEUTSCHE BAHN ENGINEERING & CONSULTING GMBH		
	DATED	NAME	SIGNATURE
Sr. DE./CHIEF ENGINEER		SURESH K.YALANGI	
CHIEF TRACK ENGINEER		RAJ PAL SINGH	
T.L.		H.D. VIDJAK	

STAMP
A
AS-BUILT DRAWING
TR. Ref.....................
ENGINEER Sign.:

EMPLOYER (DFCCIL): DEDICATED FREIGHT CORRIDOR CORPORATION OF INDIA LTD.

AS BUILT DRAWING

TITLE
AS-BUILT PLAN AND PROFILE
FROM IR KM: 302.000 TO 302.500
DFC KM: 1191.490 TO 1191.990

DFCC APPR. NO. -
ENGG. APPR. NO. -
DRG. NO. - 301-2/AL/A/1230
SHEET NO. : 1 OF 1
DATE : 07.09.2024
STATUS
A

TR.