
PILKHANI ← → SAHNEWAL

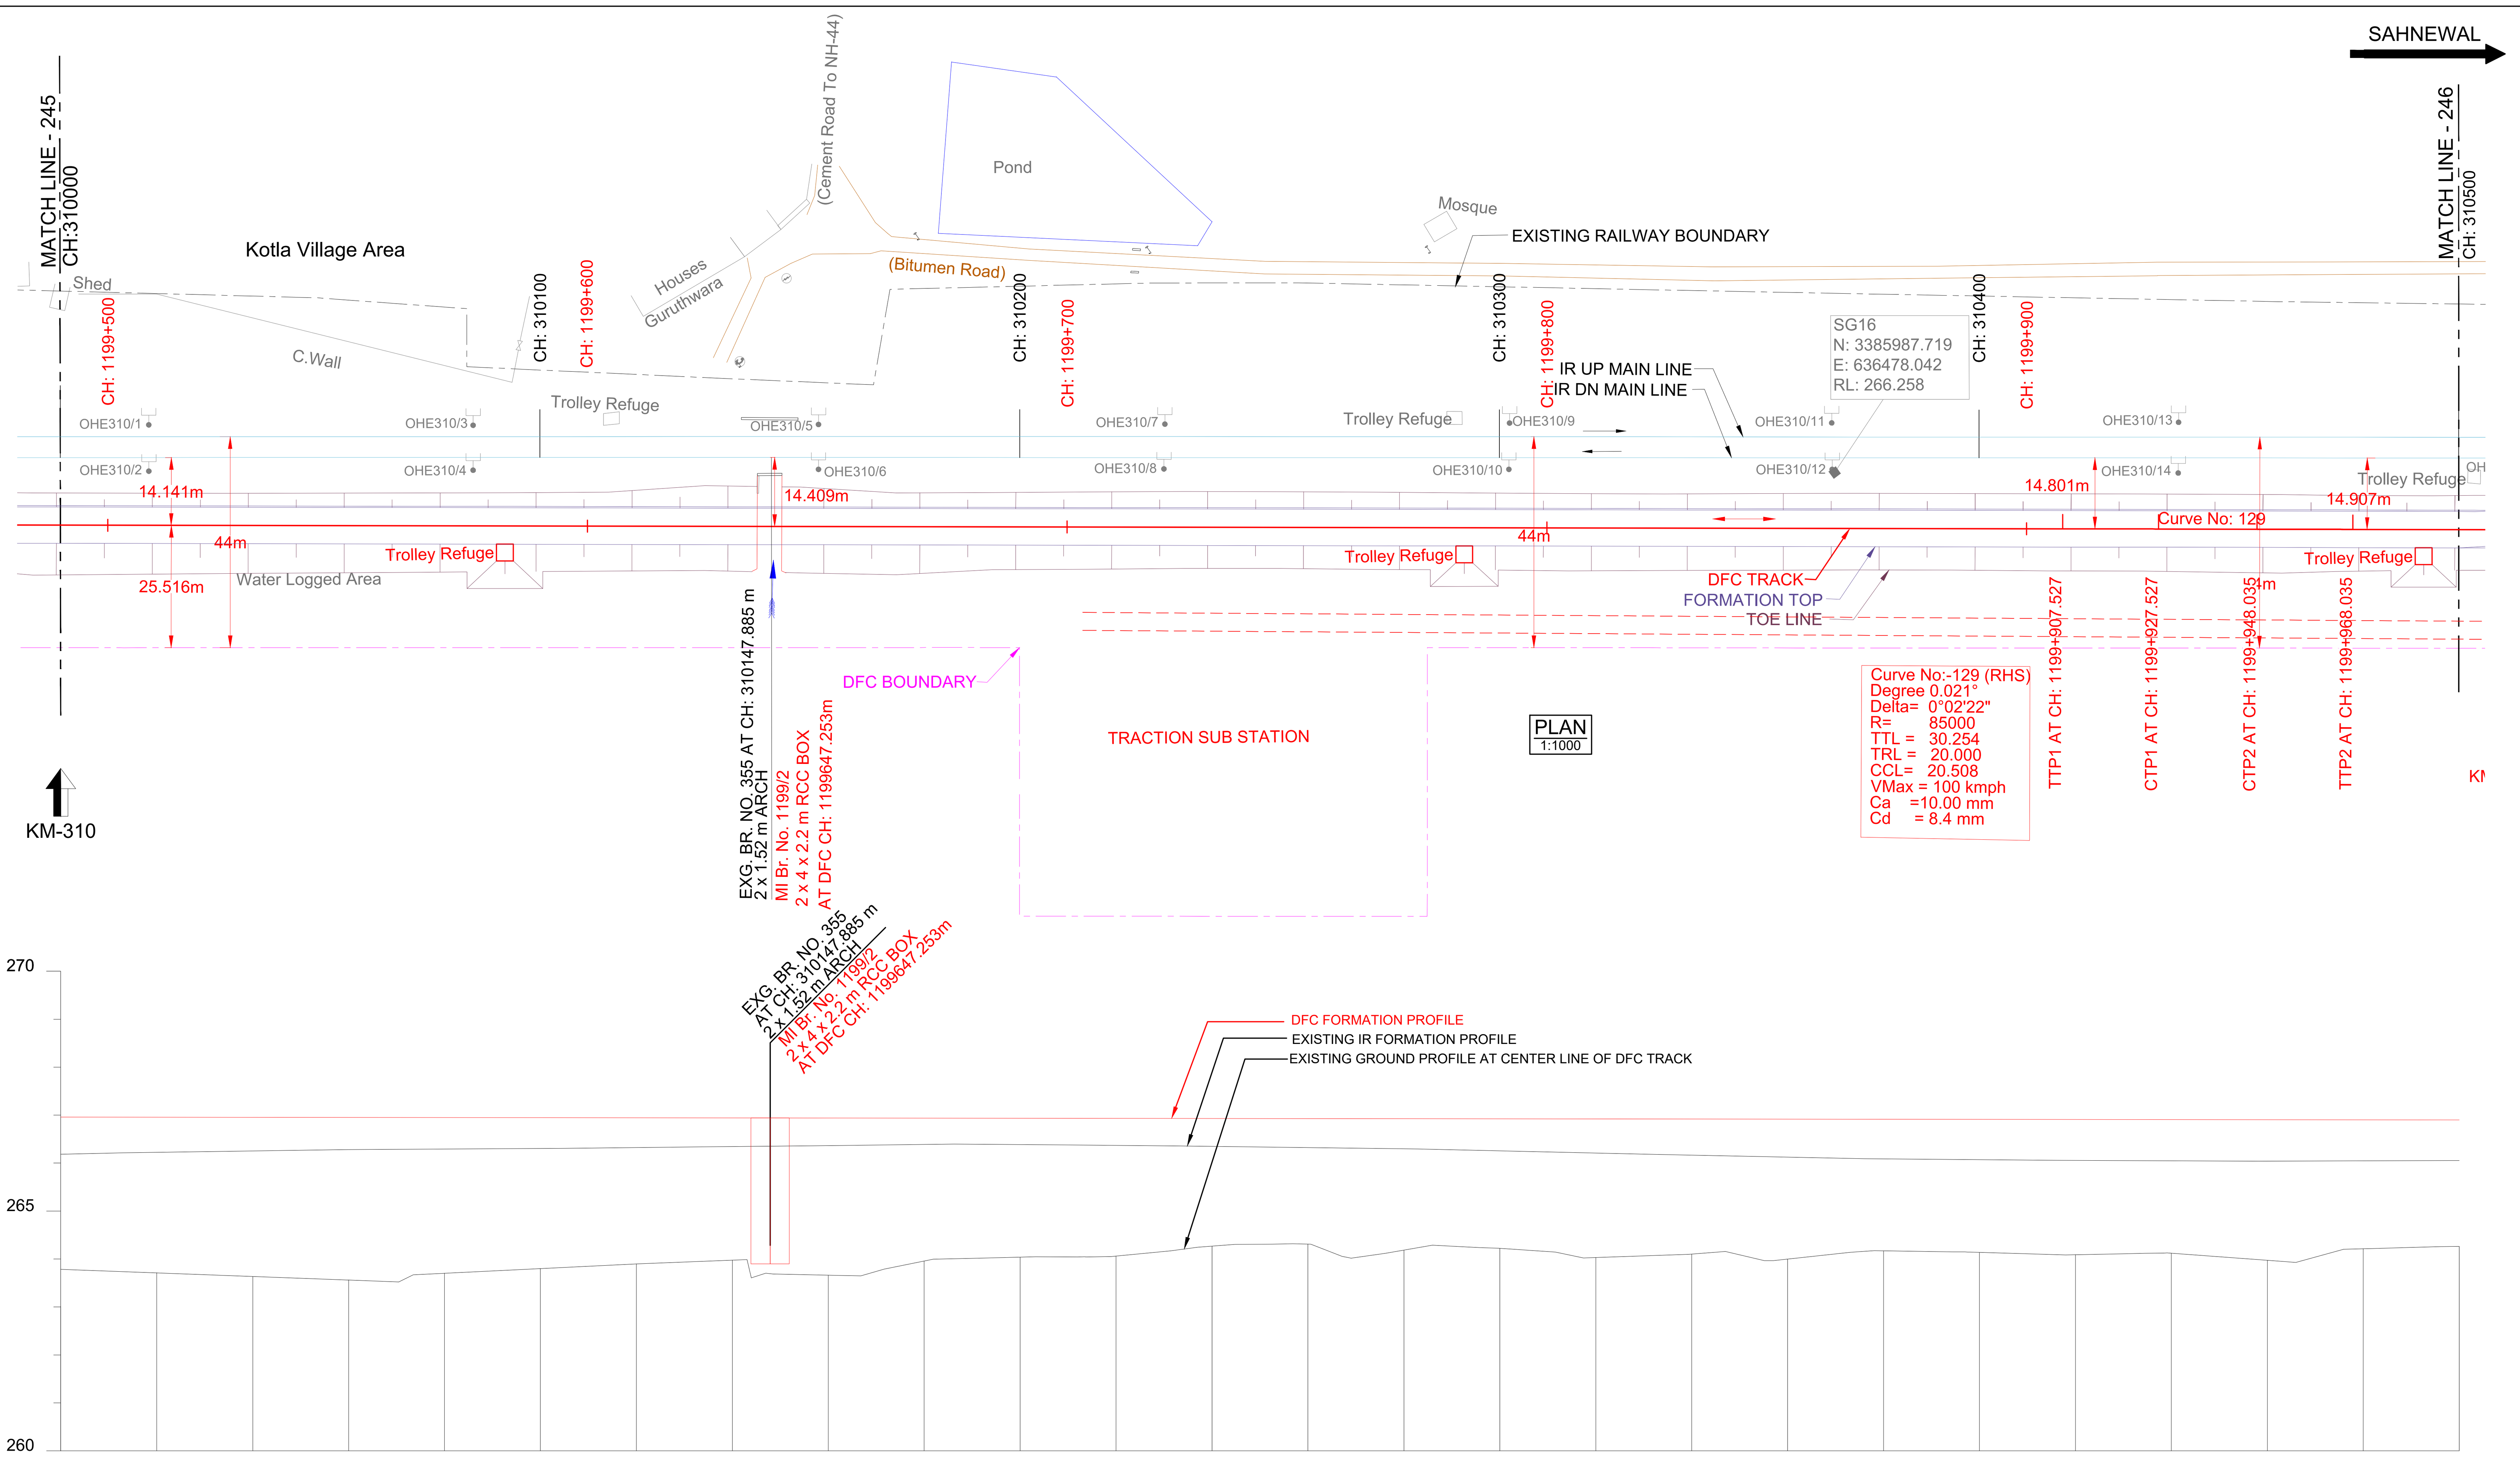

HORIZONTAL ALIGNMENT: TL = 20 — R = 85000, CC = 20.508 — TL = 20

VERTICAL ALIGNMENT: L=1485.963m, 1 IN 8552.720 F

TRACK DISTANCE FROM EXISTING NEAREST IR DN MAIN LINE TO DFC MAIN LINE	14.092	14.136	14.196	14.255	14.277	14.300	14.342	14.390	14.434	14.444	14.466	14.494	14.526
HEIGHT OF BANKING(+) / DEPTH OF CUTTING(-) (PFL-GL)	+3.174	+3.245	+3.317	+3.388	+3.246	+3.146	+3.045	+2.967	+3.279	+2.979	+2.897	+2.871	+2.663
EXG GROUND LEVEL AT CENTER LINE OF DFC TRACK (GL)	263.785	263.711	263.637	263.563	263.703	263.801	263.899	263.975	263.661	263.958	264.038	264.062	264.267
EXG GROUND LEVEL AT TOE LOCATION OF DFC TRACK	263.385	263.481	263.574	263.657	263.733	263.809	263.885	263.873	263.658	263.694	264.098	264.178	264.252
DIFFERENCE BETWEEN DFC FORMATION LEVEL AND EXG.FORMATION LEVEL.(PFL-EFL)	0.774	0.734	0.702	0.670	0.656	0.642	0.620	0.598	0.575	0.548	0.550	0.565	0.582
DFC FORMATION LEVEL (PFL)	266.959	266.956	266.954	266.951	266.949	266.947	266.944	266.942	266.940	266.937	266.935	266.933	266.930
EXG. FORMATION LEVEL OF EXG IR DN MAIN LINE (EFL)	266.185	266.222	266.252	266.281	266.293	266.305	266.324	266.344	266.365	266.389	266.385	266.368	266.348
DIFFERENCE BETWEEN DFC RAIL LEVEL AND EXG. RAIL LEVEL (PRL - ERL)	0.815	0.774	0.743	0.711	0.696	0.682	0.661	0.639	0.615	0.589	0.591	0.605	0.623
DFC RAIL LEVEL (PRL)	267.671	267.669	267.666	267.664	267.662	267.659	267.657	267.655	267.652	267.650	267.648	267.645	267.643
EXG.RAIL LEVEL OF NEAREST IR DN MAIN LINE(ERL)	266.857	266.894	266.924	266.953	266.965	266.977	266.996	267.016	267.037	267.061	267.057	267.040	267.020
EQUIVALENT CHAINAGE ON DFC TRACK	1199490.3	1199510.3	1199530.3	1199550.3	1199570.3	1199590.3	1199610.3	1199630.3	1199650.3	1199670.3	1199690.3	1199710.3	1199730.3
EXISTING IR CHAINAGE	310000.0	310020.0	310040.0	310060.0	310080.0	310100.0	310120.0	310140.0	310160.0	310180.0	310200.0	310220.0	310240.0

TRACK DISTANCE FROM EXISTING NEAREST IR DN MAIN LINE TO DFC MAIN LINE	14.564	14.602	14.639	14.674	14.698	14.708	14.723	14.758	14.793	14.830	14.871	14.903	14.937
HEIGHT OF BANKING(+) / DEPTH OF CUTTING(-) (PFL-GL)	+2.617	+2.742	+2.702	+2.892	+2.817	+2.918	+2.743	+2.775	+2.820	+2.787	+2.932	+2.690	+2.637
EXG GROUND LEVEL AT CENTER LINE OF DFC TRACK (GL)	264.311	264.184	264.221	264.029	264.102	263.998	264.171	264.137	264.089	264.120	263.973	264.212	264.263
EXG GROUND LEVEL AT TOE LOCATION OF DFC TRACK	264.229	264.162	264.129	264.065	264.124	264.159	264.206	264.183	264.129	264.097	263.971	264.179	264.292
DIFFERENCE BETWEEN DFC FORMATION LEVEL AND EXG.FORMATION LEVEL.(PFL-EFL)	0.606	0.630	0.669	0.713	0.754	0.793	0.827	0.841	0.852	0.858	0.864	0.856	0.849
DFC FORMATION LEVEL (PFL)	266.928	266.926	266.923	266.921	266.919	266.916	266.914	266.912	266.909	266.907	266.905	266.902	266.900
EXG. FORMATION LEVEL OF EXG IR DN MAIN LINE (EFL)	266.322	266.296	266.254	266.208	266.165	266.123	266.087	266.071	266.057	266.049	266.041	266.046	266.051
DIFFERENCE BETWEEN DFC RAIL LEVEL AND EXG. RAIL LEVEL (PRL - ERL)	0.646	0.670	0.710	0.753	0.795	0.834	0.868	0.881	0.893	0.899	0.904	0.897	0.890
DFC RAIL LEVEL (PRL)	267.641	267.638	267.636	267.634	267.631	267.629	267.627	267.624	267.622	267.620	267.617	267.615	267.613
EXG.RAIL LEVEL OF NEAREST IR DN MAIN LINE(ERL)	266.994	266.968	266.926	266.880	266.837	266.795	266.759	266.743	266.729	266.721	266.713	266.718	266.723
EQUIVALENT CHAINAGE ON DFC TRACK	1199750.3	1199770.3	1199790.3	1199810.3	1199830.3	1199850.3	1199870.3	1199890.3	1199910.3	1199930.3	1199950.3	1199970.3	1199990.3
EXISTING IR CHAINAGE	310260.0	310280.0	310300.0	310320.0	310340.0	310360.0	310380.0	310400.0	310420.0	310440.0	310460.0	310480.0	310500.0

L - SECTION

DRG NO.- 301-2/AL/A/1246

NOTE:-

1. DFCC WORKS ARE SHOWN IN RED.
2. IR NEW WORKS ARE SHOWN IN VIOLET.
3. ALL DIMENSIONS ARE SHOWN IN METRES.
4. THIS DRAWING IS PREPARED BASED ON LATEST SURVEY DATA HELD ON APRIL-2022. GTS BENCH MARK OF 261.850M CONSIDERED ON TOP OF CANAL BRIDGE ABUTMENT AT DORAHA VILLAGE ALONG THE NH1.
5. DFC NEW CHAINAGE OF 1075.950M IS WITH REFERENCE TO THE IR KM OF 187.500KM END OF KM OF CP-303(SECTION P-3 PILKHANI END) AGAINST THE EXISTING DFC CHAINAGE. 116277.742M ISSUED VIDE LETTER NO. CGM/DFCC/UMB/SURVEY/2021-301-230116-011173 DT. 17.01.2023
6. BALLAST PROFILE HAS BEEN PROVIDED ACCORDING TO THE CLAUSE 1.11.3 OF STANDARD SCHEDULE OF DIMESION(EASTERN CORRIDOR) & THE BALLAST CUSHION DIMESION SHOWN IN 35CM ON GE-14 PARA 17. SPECIFICATIONS & RECOMMENDATIONS 2. TWO LAYER SYSTEM FIG.10.

REFERENCE DRAWINGS :-


1. FOR KEY PLAN REFER DRAWING NO. 301-2/AL/0001
2. FOR LEGEND AND ABBREVIATIONS REFER DRAWING NO. 301-2/AL1000
3. FOR TYPICAL SECTION OF BALLAST PROFILE (FL-RL) REFFER DRG. NO. 301-2/TK/TFD/-004 (TR.1952)

REV.	DATE	REVISION DETAILS	PURPOSE OF ISSUE
0	12.09.2024	SUBMISSION OF AS-BUILT DRAWING	FOR APPROVAL

SCALE
HOR - 1:1000 (0, 10, 20, 30, 40m)
VER - 1:100 (0, 1, 2, 3, 4m)
SHEET SIZE : A1

LEGEND:

- IR TRACK
- DFCC TRACK
- DFCC FUTURE PROPOSALS
- STRUCTURE / BUILDING
- DFCC TOE LINE
- DFCC FORMATION
- RETAINING WALL
- ROAD
- STREAM, DRAIN, NALA, CANAL.
- FENCE
- POWER LINES
- TBM
- ELECTRIC POLE/OHE MAST
- IR RAILWAY BOUNDARY
- DFCC BOUNDARY

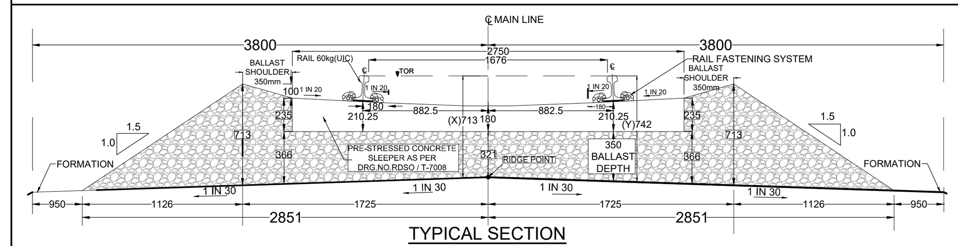

TYPICAL SECTION

TRACK STRUCTURE		
RAIL SECTION: 60Kg/m (UIC 60Kg/m) DFC LINE: 60Kg/m (UIC 60Kg/m) IR MAIN LINE:52Kg/m	Difference between FL- RL (Below Rail Seat)	
	IR Line	DFC
	172mm	172mm
RUBBER PAD	6mm	10mm
SLEEPER DEPTH	210mm	210mm
BALLAST CUSHION	300mm	350mm
Total Depth (FL TO RL)	688mm	742mm

OWNER
DEDICATED FREIGHT CORRIDOR CORPORATION OF INDIA LTD.
(A GOVERNMENT OF INDIA ENTERPRISE)
PROJECT OFFICE(AMBALA UNIT): OLD RAILWAY COLONY (NEAR ANAND MARKET),AMBALA CANTT-133001.
CORPORATE IDENTITY NO. : U60232DL2006GOI155068

ENGINEER:
DB Engineering & Consulting GmbH
Deutsche Bahn Engineering & Consulting GmbH

CONTRACTOR:
GIL - TPL JV

SUBMITTED BY	GIL - TPL JV		
	DATED	NAME	SIGNATURE
PREPARED BY			
CHECKED BY	12.09.2024	VIJAY PRATAP	
APPROVED BY	12.09.2024	PARASURAM KOTYADA	

APPROVED BY	DEUTSCHE BAHN ENGINEERING & CONSULTING GMBH		
	DATED	NAME	SIGNATURE
Sr. DE./CHIEF ENGINEER		SURESH K.YALANGI	
CHIEF TRACK ENGINEER		RAJ PAL SINGH	
T.L.		H.D. VIDJAK	

STAMP
A — AS-BUILT DRAWING
TR. Ref......................
ENGINEER Sign.:

EMPLOYER (DFCCIL): DEDICATED FREIGHT CORRIDOR CORPORATION OF INDIA LTD.

AS BUILT DRAWING

TITLE
AS-BUILT PLAN AND PROFILE
FROM IR KM: 310.000 TO 310.500
DFC KM: 1199.490 TO 1199.990

DFCC APPR. NO. -
ENGG. APPR. NO. -
DRG. NO. - 301-2/AL/A/1246
SHEET NO. : 1 OF 1
DATE : 12.09.2024
STATUS A

TR.