

PILKHANI ← → SAHNEWAL

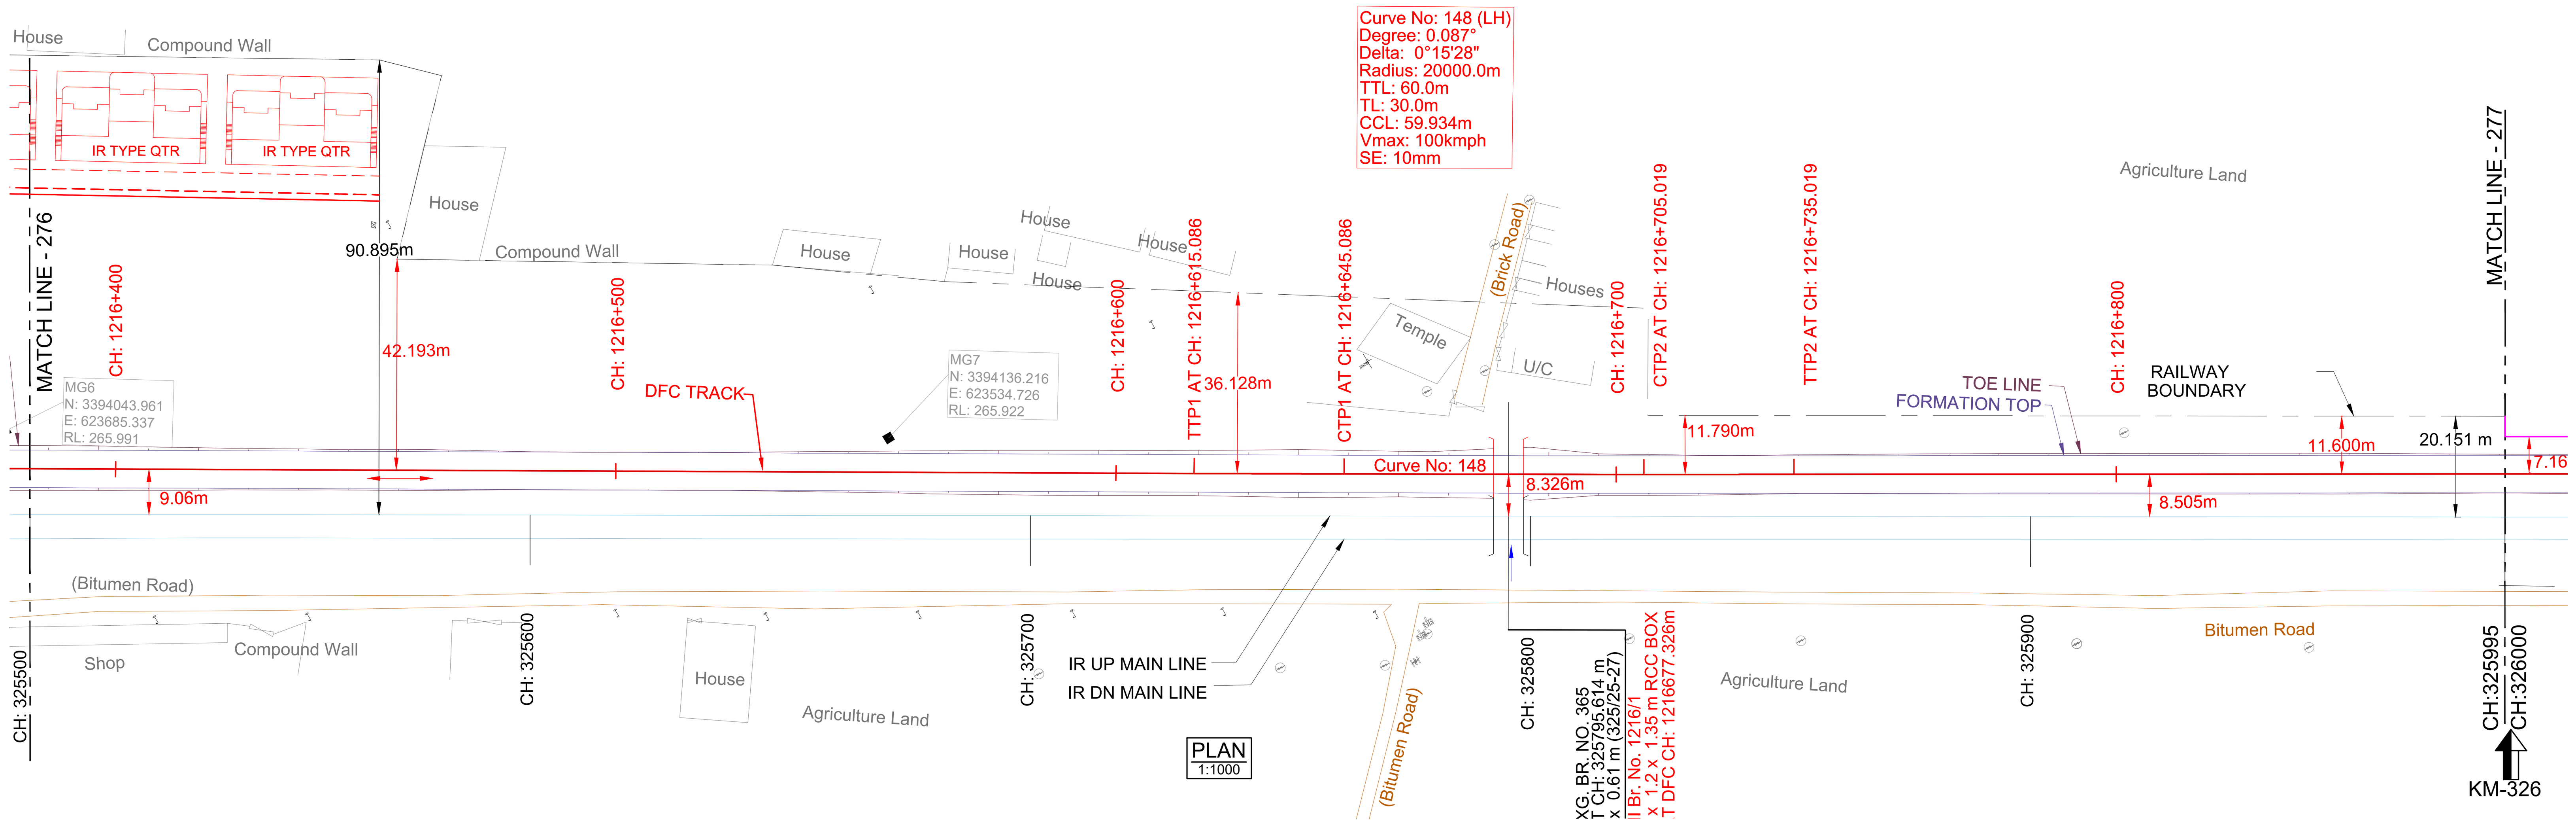

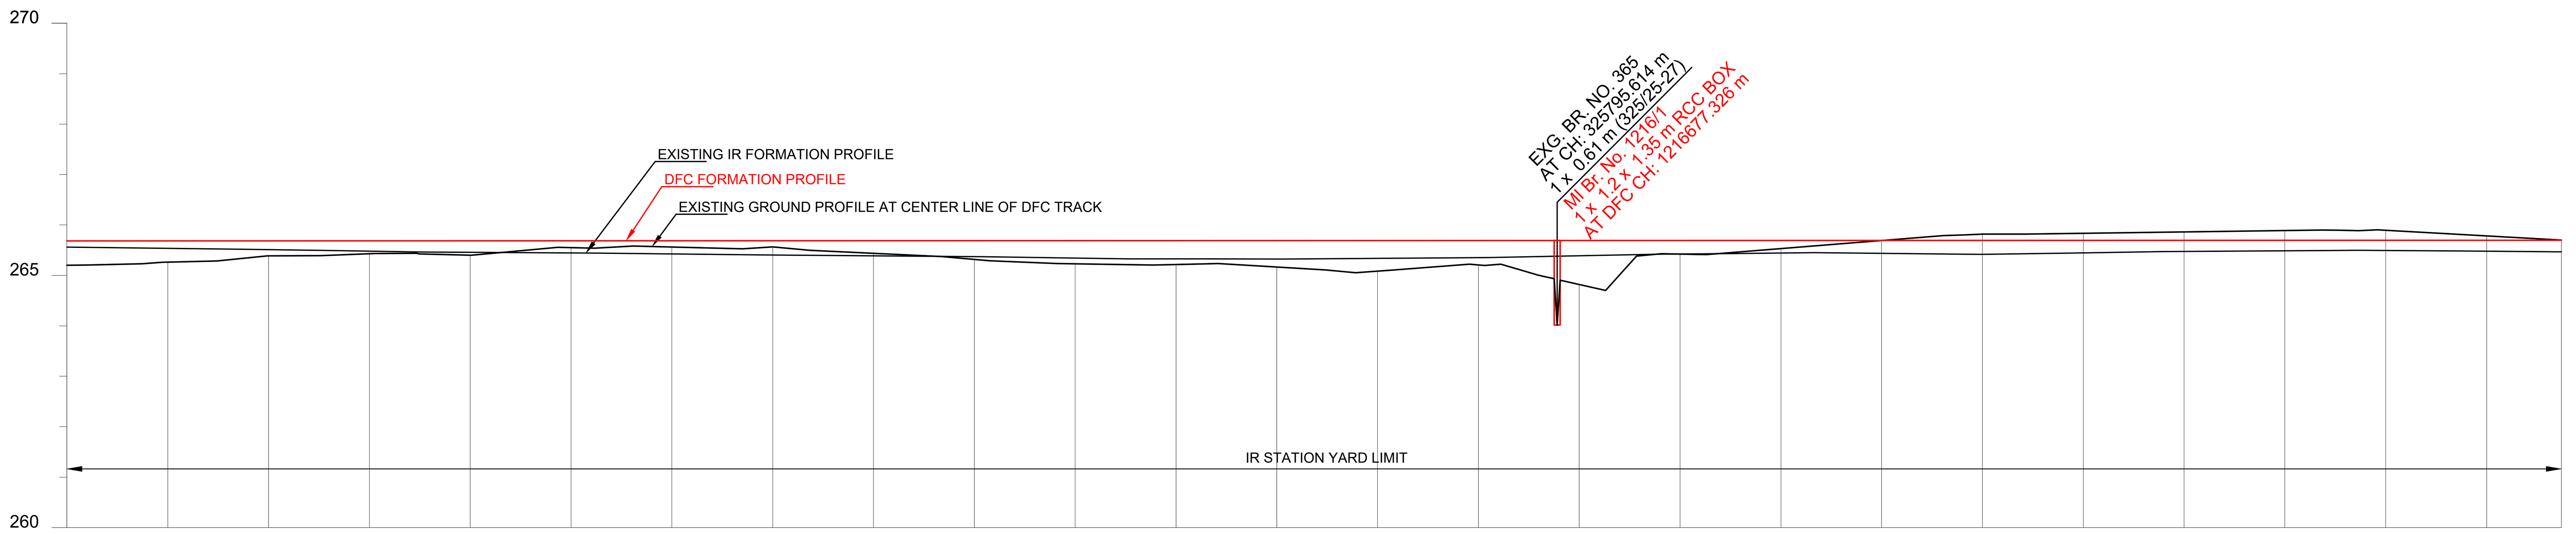

DATUM ABOVE MSL : 260 m

HORIZONTAL ALIGNMENT: L = 467.865m; TL= 30m; R =-20000m; TL= 30m; L = 5592.259m

VERTICAL ALIGNMENT: L=1480.354 m, 1 IN 36972.745 R

EXISTING IR CHAINAGE	325500.0	325520.0	325540.0	325560.0	325580.0	325600.0	325620.0	325640.0	325660.0	325680.0	325700.0	325720.0	325740.0
TRACK DISTANCE FROM EXISTING NEAREST IR UP MAIN LINE TO DFC MAIN LINE	9.166	9.077	8.998	8.945	8.894	8.843	8.808	8.776	8.711	8.646	8.581	8.519	8.461
HEIGHT OF BANKING(+) / DEPTH OF CUTTING(-) (PFL-GL)	+0.481	+0.423	+0.299	+0.254	+0.287	+0.134	+0.123	+0.123	+0.249	+0.371	+0.459	+0.473	+0.523
EXG GROUND LEVEL AT CENTER LINE OF DFC TRACK (GL)	265.202	265.261	265.386	265.431	265.399	265.552	265.564	265.564	265.439	265.317	265.230	265.216	265.167
EXG GROUND LEVEL AT TOE LOCATION OF DFC TRACK	265.134	265.198	265.336	265.392	265.379	265.558	265.554	265.535	265.421	265.309	265.228	265.210	265.132
DIFFERENCE BETWEEN DFC FORMATION LEVEL AND EXG.FORMATION LEVEL.(PFL-EFL)	0.122	0.146	0.173	0.204	0.227	0.241	0.261	0.283	0.300	0.317	0.344	0.361	0.366
DFC FORMATION LEVEL (PFL)	265.683	265.684	265.685	265.685	265.686	265.686	265.687	265.687	265.688	265.688	265.689	265.689	265.690
EXG. FORMATION LEVEL OF EXG IR UP MAIN LINE (EFL)	265.562	265.538	265.512	265.481	265.459	265.445	265.426	265.404	265.388	265.371	265.345	265.329	265.324
DIFFERENCE BETWEEN DFC RAIL LEVEL AND EXG. RAIL LEVEL (PRL - ERL)	0.163	0.187	0.214	0.245	0.268	0.282	0.302	0.324	0.341	0.359	0.386	0.402	0.408
DFC RAIL LEVEL (PRL)	266.397	266.397	266.398	266.398	266.399	266.399	266.400	266.401	266.401	266.402	266.402	266.403	266.403
EXG.RAIL LEVEL OF NEAREST IR UP MAIN LINE(ERL)	266.234	266.210	266.184	266.153	266.131	266.117	266.098	266.076	266.060	266.043	266.017	266.001	265.996
EQUIVALENT CHAINAGE ON DFC TRACK	1216381.7	1216401.7	1216421.7	1216441.7	1216461.7	1216481.7	1216501.7	1216521.7	1216541.7	1216561.7	1216581.7	1216601.7	1216621.7

EXISTING IR CHAINAGE	325760.0	325780.0	325800.0	325820.0	325840.0	325860.0	325880.0	325900.0	325920.0	325940.0	325960.0	325980.0	325994.8 326000.0
TRACK DISTANCE FROM EXISTING NEAREST IR UP MAIN LINE TO DFC MAIN LINE	8.399	8.354	8.320	8.315	8.370	8.392	8.397	8.453	8.501	8.519	8.542	8.576	8.601
HEIGHT OF BANKING(+) / DEPTH OF CUTTING(-) (PFL-GL)	+0.605	+0.483	+0.871	+0.269	+0.161	+0.001	-0.123	-0.141	-0.167	-0.194	-0.200	-0.087	-0.002
EXG GROUND LEVEL AT CENTER LINE OF DFC TRACK (GL)	265.085	265.208	264.821	265.423	265.532	265.692	265.817	265.835	265.862	265.889	265.896	265.783	265.699
EXG GROUND LEVEL AT TOE LOCATION OF DFC TRACK	265.082	265.211	264.743	265.459	265.608	265.771	265.926	265.951	265.979	266.006	265.996	265.881	265.795
DIFFERENCE BETWEEN DFC FORMATION LEVEL AND EXG.FORMATION LEVEL.(PFL-EFL)	0.352	0.337	0.301	0.267	0.248	0.256	0.278	0.247	0.220	0.207	0.201	0.216	0.228
DFC FORMATION LEVEL (PFL)	265.690	265.691	265.692	265.692	265.693	265.693	265.694	265.694	265.695	265.695	265.696	265.696	265.697
EXG. FORMATION LEVEL OF EXG IR UP MAIN LINE (EFL)	265.338	265.354	265.390	265.425	265.445	265.437	265.416	265.447	265.474	265.489	265.495	265.480	265.469
DIFFERENCE BETWEEN DFC RAIL LEVEL AND EXG. RAIL LEVEL (PRL - ERL)	0.393	0.378	0.343	0.308	0.289	0.298	0.319	0.288	0.262	0.248	0.243	0.258	0.269
DFC RAIL LEVEL (PRL)	266.404	266.404	266.405	266.405	266.406	266.406	266.407	266.408	266.408	266.409	266.409	266.410	266.410
EXG.RAIL LEVEL OF NEAREST IR UP MAIN LINE(ERL)	266.010	266.026	266.062	266.097	266.117	266.109	266.088	266.119	266.146	266.161	266.167	266.152	266.141
EQUIVALENT CHAINAGE ON DFC TRACK	1216641.7	1216661.7	1216681.7	1216701.7	1216721.7	1216741.7	1216761.7	1216781.7	1216801.7	1216821.7	1216841.7	1216861.7	1216876.6

L - SECTION

DRG NO.-301-2/AL/A/1277


NOTE:-
1. DFCC WORKS ARE SHOWN IN RED.
2. IR NEW WORKS ARE SHOWN IN VIOLET.
3. ALL DIMENSIONS ARE SHOWN IN METRES.
4. THIS DRAWING IS PREPARED BASED ON LATEST SURVEY DATA HELD ON APRIL-2022. GTS BENCH MARK OF 261.850M CONSIDERED ON TOP OF CANAL BRIDGE ABUTMENT AT DORAHA VILLAGE ALONG THE NH1.
5. DFC NEW CHAINAGE OF 1075.950M IS WITH REFERENCE TO THE IR KM OF 187.500KM END OF KM OF CP-303(SECTION P-3 PILKHANI END) AGAINST THE EXISTING DFC CHAINAGE. 116277.742M ISSUED VIDE LETTER NO. CGM/DFCC/UMB/SURVEY/2021-301-230116-011173 DT. 17.01.2023
6. BALLAST PROFILE HAS BEEN PROVIDED ACCORDING TO THE CLAUSE 1.11.3 OF STANDARD SCHEDULE OF DIMESION(EASTERN CORRIDOR) & THE BALLAST CUSHION DIMESION SHOWN IN 35CM ON GE-14 PARA 17. SPECIFICATIONS & RECOMMENDATIONS 2. TWO LAYER SYSTEM FIG.10.

REFERENCE DRAWINGS :-
1. FOR KEY PLAN REFER DRAWING NO. 301-2/AL/0001
2. FOR LEGEND AND ABBREVIATIONS REFER DRAWING NO. 301-2/AL1000
3. FOR TYPICAL SECTION OF BALLAST PROFILE (FL-RL) REFFER DRG. NO. 301-2/TK/TFD/-004 (TR.1952)

REV.	DATE	REVISION DETAILS	PURPOSE OF ISSUE
0	26.09.2024	SUBMISSION OF AS-BUILT DRAWING	FOR APPROVAL

SCALE
HOR - 1:1000 (0 10 20 30 40m)
VER - 1:100 (0 1 2 3 4m)
SHEET SIZE : A1

LEGEND:
- IR TRACK
- DFCC TRACK
- DFCC FUTURE PROPOSALS
- STRUCTURE / BUILDING
- DFCC TOE LINE
- DFCC FORMATION
- RETAINING WALL
- ROAD
- STREAM, DRAIN, NALA, CANAL.
- FENCE
- POWER LINES
- TBM
- ELECTRIC POLE/OHE MAST
- IR RAILWAY BOUNDARY
- DFCC BOUNDARY

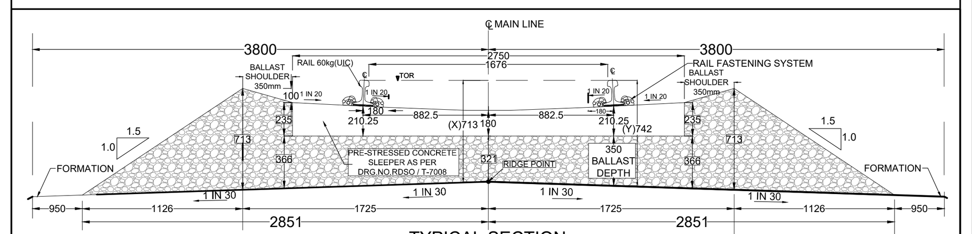

TYPICAL SECTION

TRACK STRUCTURE

	Difference between FL- RL (Below Rail Seat)	
RAIL SECTION: 60Kg/m (UIC 60Kg/m) DFC LINE: 60Kg/m (UIC 60Kg/m) IR MAIN LINE:52Kg/m	IR Line	DFC
	172mm	172mm
RUBBER PAD	6mm	10mm
SLEEPER DEPTH	210mm	210mm
BALLAST CUSHION	300mm	350mm
Total Depth (FL TO RL)	688mm	742mm

OWNER
DEDICATED FREIGHT CORRIDOR CORPORATION OF INDIA LTD.
(A GOVERNMENT OF INDIA ENTERPRISE)
PROJECT OFFICE(AMBALA UNIT): OLD RAILWAY COLONY (NEAR ANAND MARKET),AMBALA CANTT-133001.
CORPORATE IDENTITY NO. : U60232DL2006GOI155068

ENGINEER:
DB Engineering & Consulting GmbH
Deutsche Bahn Engineering & Consulting GmbH

CONTRACTOR:
GIL - TPL JV

SUBMITTED BY	GIL - TPL JV		
	DATED	NAME	SIGNATURE
PREPARED BY			
CHECKED BY	26.09.2024	VIJAY PRATAP	
APPROVED BY	26.09.2024	PARASURAM KOTYADA	

APPROVED BY	DEUTSCHE BAHN ENGINEERING & CONSULTING GMBH		
	DATED	NAME	SIGNATURE
Sr. DE./CHIEF ENGINEER		SURESH K.YALANGI	
CHIEF TRACK ENGINEER		RAJ PAL SINGH	
T.L.		H.D. VIDJAK	

STAMP
A — AS-BUILT DRAWING
TR. Ref......................
ENGINEER Sign.:

EMPLOYER (DFCCIL): DEDICATED FREIGHT CORRIDOR CORPORATION OF INDIA LTD.

AS BUILT DRAWING

TITLE
AS-BUILT PLAN AND PROFILE
FROM IR KM: 325.500 TO 326.000
DFC KM:1216.381 TO 1216.877

DFCC APPR. NO. -
ENGG. APPR. NO. -
DRG. NO. - 301-2/AL/A/1277
SHEET NO. : 1 OF 1
DATE : 26.09.2024
STATUS A

TR.