

PILKHANI ← → SAHNEWAL

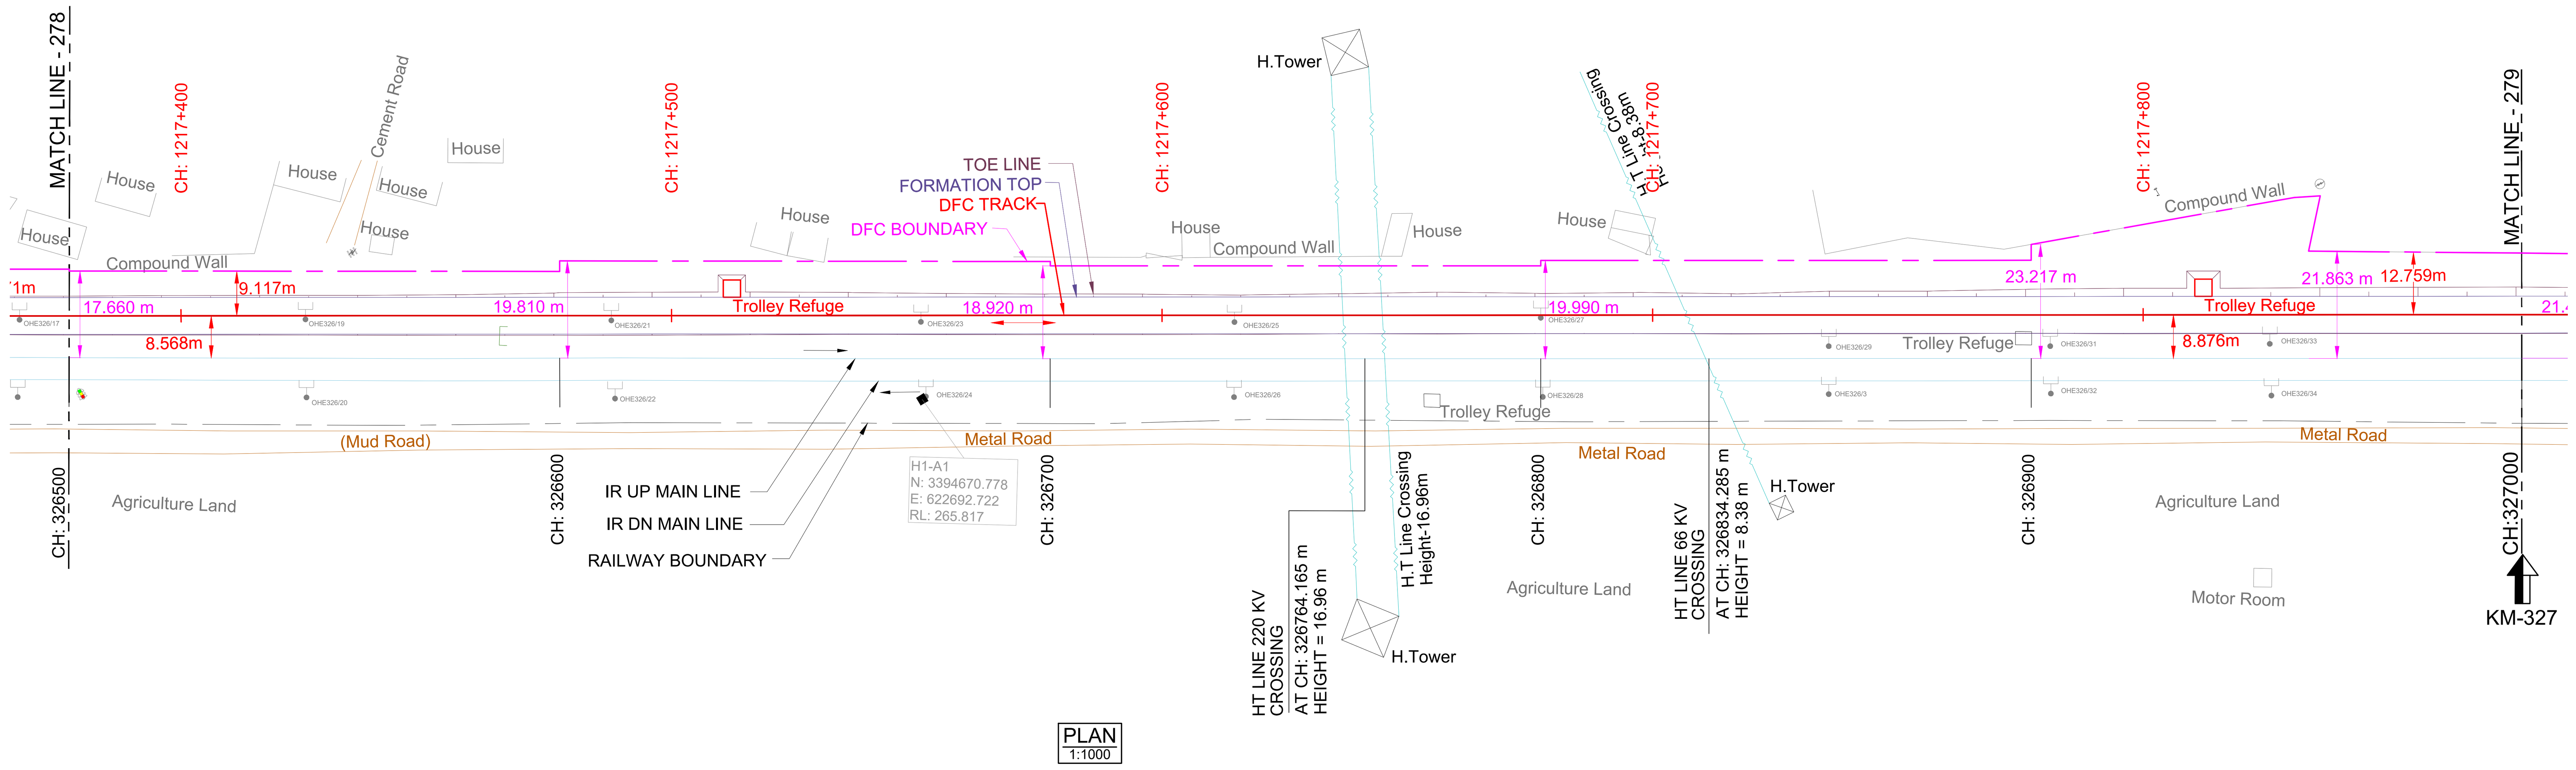

PLAN
1:1000

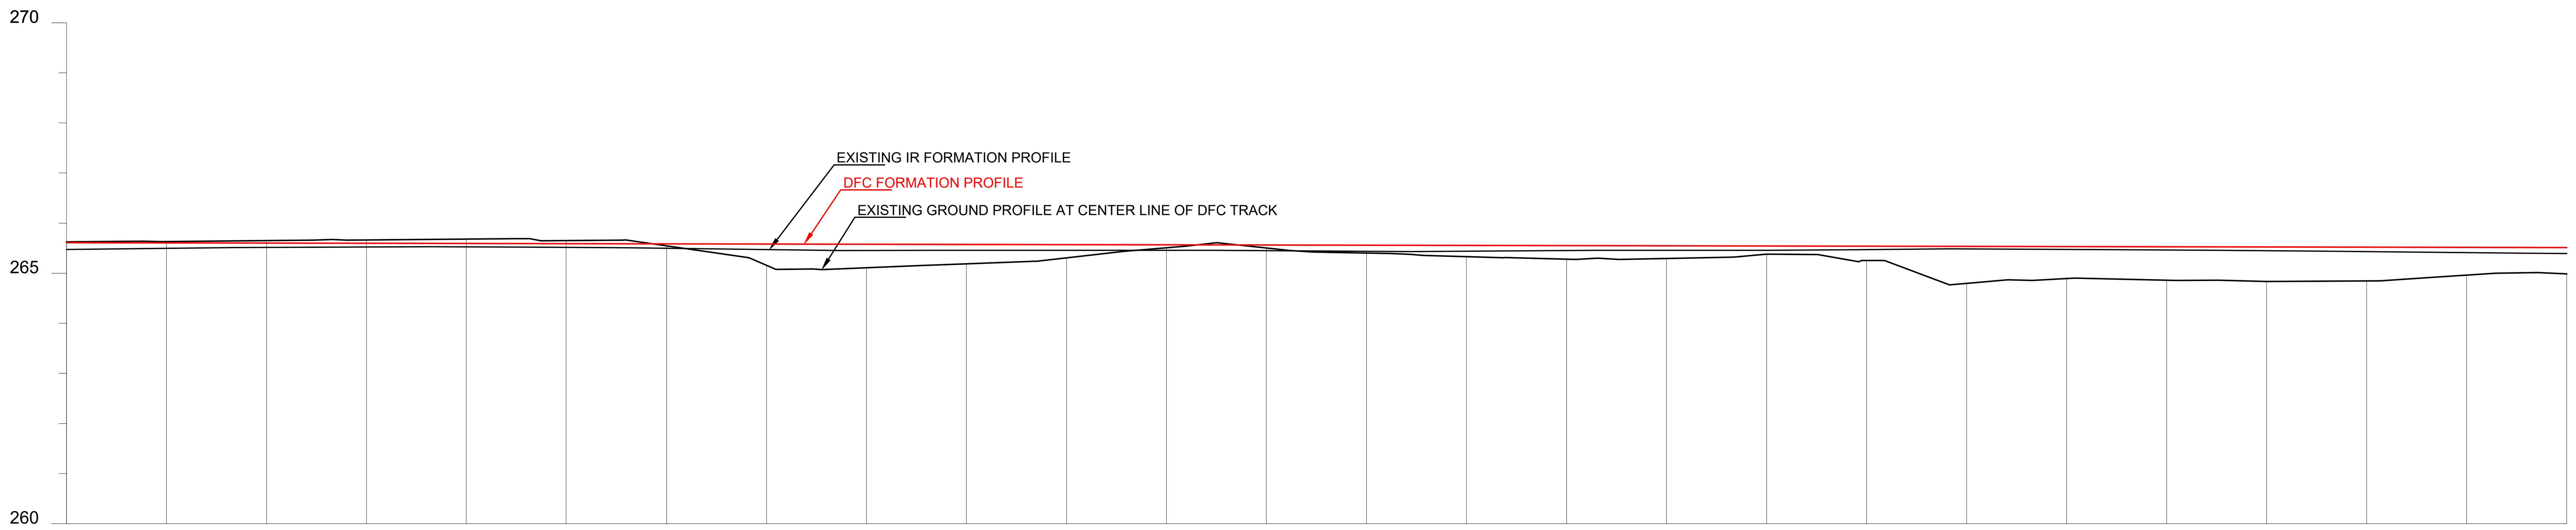

DATUM ABOVE MSL : 260 m

HORIZONTAL ALIGNMENT: L = 5592.259m

VERTICAL ALIGNMENT: L=1479.996 m, 1 IN 5071.478 F

EXISTING IR CHAINAGE	326500.0	326520.0	326540.0	326560.0	326580.0	326600.0	326620.0	326640.0	326660.0	326680.0	326700.0	326720.0	326740.0
TRACK DISTANCE FROM EXISTING NEAREST IR UP MAIN LINE TO DFC MAIN LINE	8.490	8.544	8.607	8.691	8.720	8.643	8.631	8.723	8.795	8.811	8.825	8.836	8.842
HEIGHT OF BANKING(+) / DEPTH OF CUTTING(-) (PFL-GL)	-0.014	-0.026	-0.049	-0.065	-0.087	-0.058	+0.041	+0.426	+0.470	+0.386	+0.264	+0.059	+0.059
EXG GROUND LEVEL AT CENTER LINE OF DFC TRACK (GL)	265.624	265.632	265.651	265.663	265.681	265.649	265.546	265.157	265.109	265.189	265.307	265.508	265.504
EXG GROUND LEVEL AT TOE LOCATION OF DFC TRACK	265.371	265.300	265.286	265.286	265.221	265.024	264.966	264.953	265.015	265.110	265.158	265.188	265.265
DIFFERENCE BETWEEN DFC FORMATION LEVEL AND EXG.FORMATION LEVEL.(PFL-EFL)	0.138	0.110	0.087	0.075	0.070	0.076	0.089	0.111	0.124	0.118	0.113	0.111	0.114
DFC FORMATION LEVEL (PFL)	265.610	265.606	265.602	265.598	265.594	265.591	265.587	265.583	265.579	265.575	265.571	265.567	265.563
EXG. FORMATION LEVEL OF EXG IR UP MAIN LINE (EFL)	265.472	265.496	265.515	265.523	265.525	265.514	265.497	265.472	265.454	265.457	265.458	265.456	265.449
DIFFERENCE BETWEEN DFC RAIL LEVEL AND EXG. RAIL LEVEL (PRL - ERL)	0.179	0.151	0.128	0.116	0.110	0.117	0.130	0.151	0.165	0.158	0.154	0.151	0.155
DFC RAIL LEVEL (PRL)	266.323	266.319	266.315	266.311	266.307	266.303	266.299	266.295	266.292	266.288	266.284	266.280	266.276
EXG.RAIL LEVEL OF NEAREST IR UP MAIN LINE(ERL)	266.144	266.168	266.187	266.195	266.197	266.186	266.169	266.144	266.126	266.129	266.130	266.128	266.121
EQUIVALENT CHAINAGE ON DFC TRACK	1217376.6	1217396.6	1217416.6	1217436.6	1217456.5	1217476.5	1217496.6	1217516.6	1217536.5	1217556.5	1217576.5	1217596.5	1217616.5

EXISTING IR CHAINAGE	326760.0	326780.0	326800.0	326820.0	326840.0	326860.0	326880.0	326900.0	326920.0	326940.0	326960.0	326980.0	327000.0
TRACK DISTANCE FROM EXISTING NEAREST IR UP MAIN LINE TO DFC MAIN LINE	8.844	8.847	8.853	8.863	8.873	8.871	8.868	8.864	8.869	8.885	8.896	8.900	8.906
HEIGHT OF BANKING(+) / DEPTH OF CUTTING(-) (PFL-GL)	+0.157	+0.225	+0.273	+0.254	+0.163	+0.285	+0.738	+0.637	+0.669	+0.688	+0.674	+0.553	+0.527
EXG GROUND LEVEL AT CENTER LINE OF DFC TRACK (GL)	265.402	265.330	265.278	265.293	265.380	265.254	264.797	264.894	264.858	264.835	264.846	264.963	264.985
EXG GROUND LEVEL AT TOE LOCATION OF DFC TRACK	265.133	264.980	265.107	265.019	265.151	264.896	264.876	264.684	264.586	264.588	264.532	264.496	264.481
DIFFERENCE BETWEEN DFC FORMATION LEVEL AND EXG.FORMATION LEVEL.(PFL-EFL)	0.122	0.116	0.100	0.090	0.087	0.068	0.052	0.056	0.064	0.076	0.090	0.106	0.119
DFC FORMATION LEVEL (PFL)	265.559	265.555	265.551	265.547	265.543	265.539	265.535	265.531	265.527	265.523	265.520	265.516	265.512
EXG. FORMATION LEVEL OF EXG IR UP MAIN LINE (EFL)	265.437	265.439	265.451	265.457	265.457	265.472	265.483	265.476	265.463	265.447	265.430	265.410	265.393
DIFFERENCE BETWEEN DFC RAIL LEVEL AND EXG. RAIL LEVEL (PRL - ERL)	0.162	0.157	0.141	0.131	0.127	0.108	0.093	0.097	0.105	0.117	0.131	0.146	0.159
DFC RAIL LEVEL (PRL)	266.272	266.268	266.264	266.260	266.256	266.252	266.248	266.244	266.240	266.236	266.232	266.228	266.224
EXG.RAIL LEVEL OF NEAREST IR UP MAIN LINE(ERL)	266.109	266.111	266.123	266.129	266.129	266.144	266.155	266.148	266.135	266.119	266.102	266.082	266.065
EQUIVALENT CHAINAGE ON DFC TRACK	1217636.5	1217656.5	1217676.5	1217696.5	1217716.5	1217736.5	1217756.5	1217776.5	1217796.5	1217816.5	1217836.5	1217856.5	1217876.5

L - SECTION

DRG NO.301-2/AL/A/1279

NOTE:-

1. DFCC WORKS ARE SHOWN IN RED.
2. IR NEW WORKS ARE SHOWN IN VIOLET.
3. ALL DIMENSIONS ARE SHOWN IN METRES.
4. THIS DRAWING IS PREPARED BASED ON LATEST SURVEY DATA HELD ON APRIL-2022. GTS BENCH MARK OF 261.850M CONSIDERED ON TOP OF CANAL BRIDGE ABUTMENT AT DORAHA VILLAGE ALONG THE NH1.
5. DFC NEW CHAINAGE OF 1075.950M IS WITH REFERENCE TO THE IR KM OF 187.500KM END OF KM OF CP-303(SECTION P-3 PILKHANI END) AGAINST THE EXISTING DFC CHAINAGE. 116277.742M ISSUED VIDE LETTER NO. CGM/DFCC/UMB/SURVEY/2021-301-230116-011173 DT. 17.01.2023
6. BALLAST PROFILE HAS BEEN PROVIDED ACCORDING TO THE CLAUSE 1.11.3 OF STANDARD SCHEDULE OF DIMESION(EASTERN CORRIDOR) & THE BALLAST CUSHION DIMESION SHOWN IN 35CM ON GE-14 PARA 17. SPECIFICATIONS & RECOMMENDATIONS 2. TWO LAYER SYSTEM FIG.10.

REFERENCE DRAWINGS :-


1. FOR KEY PLAN REFER DRAWING NO. 301-2/AL/0001
2. FOR LEGEND AND ABBREVIATIONS REFER DRAWING NO. 301-2/AL1000
3. FOR TYPICAL SECTION OF BALLAST PROFILE (FL-RL) REFFER DRG. NO. 301-2/TK/TFD/-004 (TR.1952)

REV.	DATE	REVISION DETAILS	PURPOSE OF ISSUE
0	26.09.2024	SUBMISSION OF AS-BUILT DRAWING	FOR APPROVAL

SCALE
HOR - 1:1000 (0, 10, 20, 30, 40m)
VER - 1:100 (0, 1, 2, 3, 4m)
SHEET SIZE : A1

LEGEND:

- IR TRACK
- DFCC TRACK
- DFCC FUTURE PROPOSALS
- STRUCTURE / BUILDING
- DFCC TOE LINE
- DFCC FORMATION
- RETAINING WALL
- ROAD
- STREAM, DRAIN, NALA, CANAL.
- FENCE
- POWER LINES
- TBM
- ELECTRIC POLE/OHE MAST
- IR RAILWAY BOUNDARY
- DFCC BOUNDARY

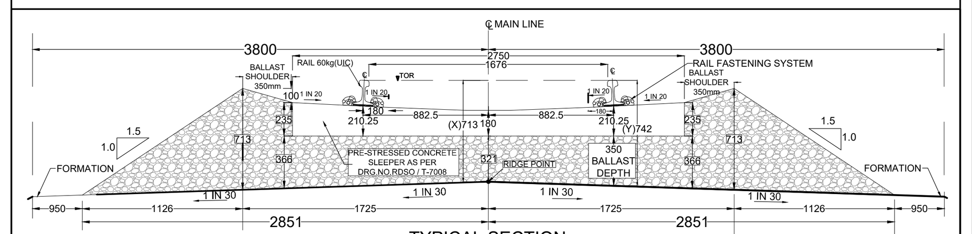

TYPICAL SECTION

TRACK STRUCTURE

	Difference between FL- RL (Below Rail Seat)	
RAIL SECTION: 60Kg/m (UIC 60Kg/m) DFC LINE: 60Kg/m (UIC 60Kg/m) IR MAIN LINE:52Kg/m	IR Line	DFC
	172mm	172mm
RUBBER PAD	6mm	10mm
SLEEPER DEPTH	210mm	210mm
BALLAST CUSHION	300mm	350mm
Total Depth (FL TO RL)	688mm	742mm

OWNER
DEDICATED FREIGHT CORRIDOR CORPORATION OF INDIA LTD.
(A GOVERNMENT OF INDIA ENTERPRISE)
PROJECT OFFICE(AMBALA UNIT): OLD RAILWAY COLONY (NEAR ANAND MARKET),AMBALA CANTT-133001.
CORPORATE IDENTITY NO. : U60232DL2006GOI155068

ENGINEER:
DB Engineering & Consulting GmbH
Deutsche Bahn Engineering & Consulting GmbH

CONTRACTOR:
GIL - TPL JV

SUBMITTED BY	GIL - TPL JV		
	DATED	NAME	SIGNATURE
PREPARED BY			
CHECKED BY	26.09.2024	VIJAY PRATAP	
APPROVED BY	26.09.2024	PARASURAM KOTYADA	

APPROVED BY	DEUTSCHE BAHN ENGINEERING & CONSULTING GMBH		
	DATED	NAME	SIGNATURE
Sr. DE./CHIEF ENGINEER		SURESH K.YALANGI	
CHIEF TRACK ENGINEER		RAJ PAL SINGH	
T.L.		H.D. VIDJAK	

STAMP
A
AS-BUILT DRAWING
TR. Ref.....................
ENGINEER Sign.:

EMPLOYER (DFCCIL): DEDICATED FREIGHT CORRIDOR CORPORATION OF INDIA LTD.

AS BUILT DRAWING

TITLE
AS-BUILT PLAN AND PROFILE
FROM IR KM: 326.500 TO 327.000
DFC KM:1217.377 TO 1217.876

DFCC APPR. NO. -
ENGG. APPR. NO. -
DRG. NO. - 301-2/AL/A/1279
SHEET NO. : 1 OF 1
DATE : 26.09.2024
STATUS: A

TR.