

DRG NO.301-2/AL/A/1285

PILKHANI ← → SAHNEWAL

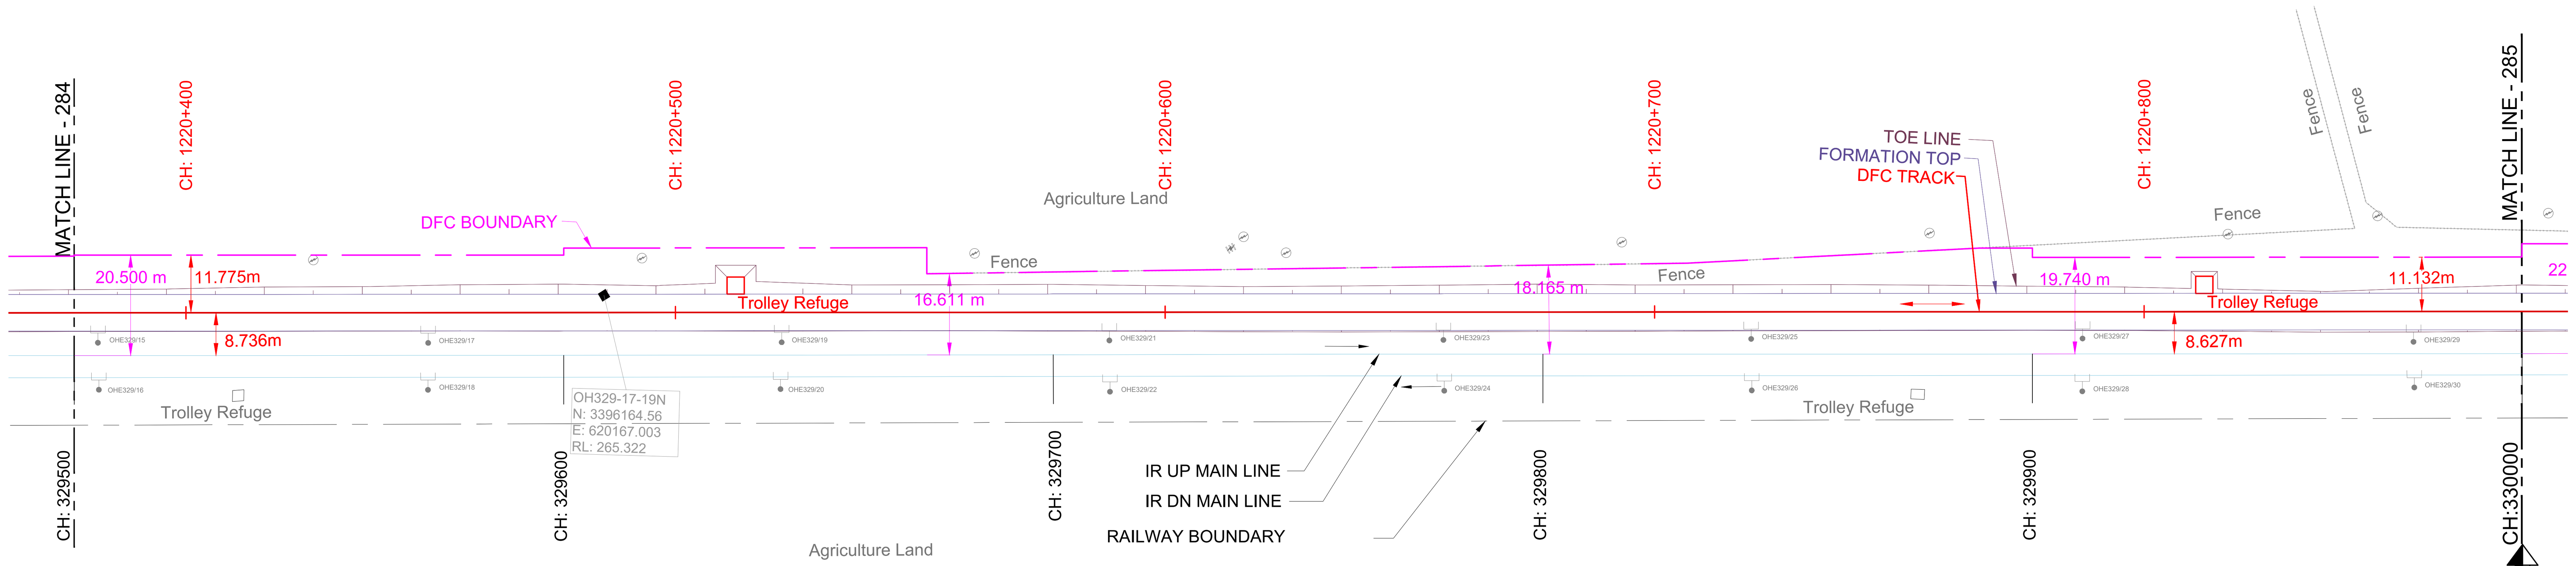

PLAN
1:1000

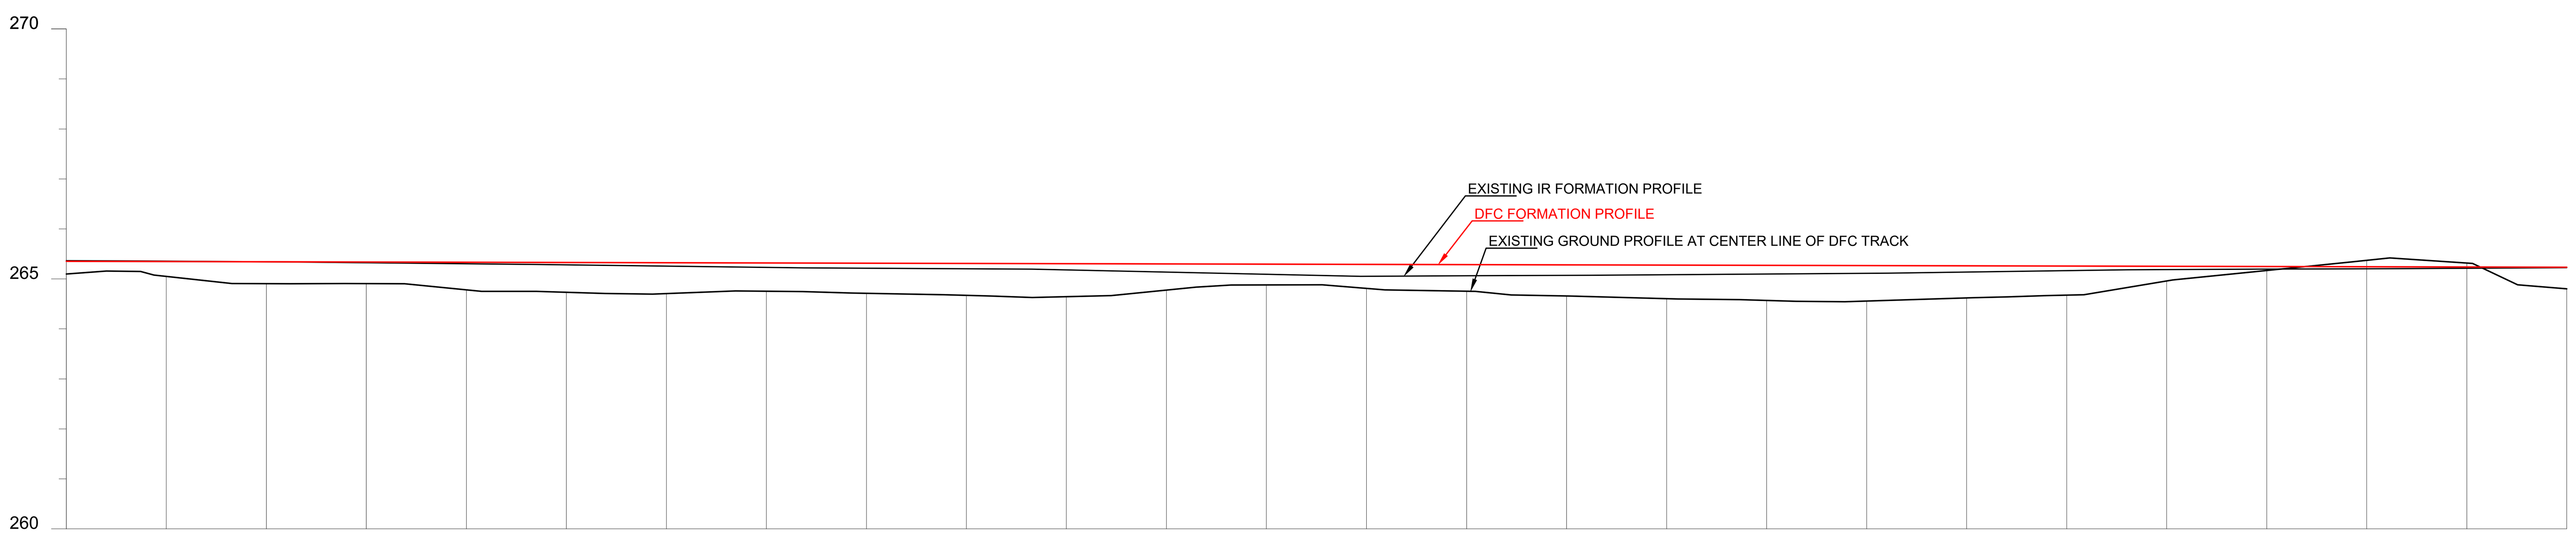

DATUM ABOVE MSL : 260 m

HORIZONTAL ALIGNMENT: L = 5592.259m

VERTICAL ALIGNMENT: L=1479.968 m, 1 IN 4276.874 F

EXISTING IR CHAINAGE	329500.0	329520.0	329540.0	329560.0	329580.0	329600.0	329620.0	329640.0	329660.0	329680.0	329700.0	329720.0	329740.0
TRACK DISTANCE FROM EXISTING NEAREST IR UP MAIN LINE TO DFC MAIN LINE	8.719	8.731	8.743	8.745	8.745	8.743	8.737	8.730	8.719	8.706	8.687	8.655	8.624
HEIGHT OF BANKING(+) / DEPTH OF CUTTING(-) (PFL-GL)	+0.253	+0.296	+0.439	+0.432	+0.552	+0.596	+0.618	+0.565	+0.603	+0.639	+0.661	+0.525	+0.416
EXG GROUND LEVEL AT CENTER LINE OF DFC TRACK (GL)	265.099	265.051	264.904	264.906	264.781	264.733	264.706	264.754	264.712	264.671	264.644	264.776	264.880
EXG GROUND LEVEL AT TOE LOCATION OF DFC TRACK	264.770	264.682	264.491	264.441	264.250	264.201	264.328	263.943	264.286	264.255	264.228	264.355	264.460
DIFFERENCE BETWEEN DFC FORMATION LEVEL AND EXG.FORMATION LEVEL.(PFL-EFL)	-0.012	-0.007	0.002	0.016	0.030	0.047	0.068	0.090	0.102	0.108	0.126	0.165	0.204
DFC FORMATION LEVEL (PFL)	265.352	265.347	265.343	265.338	265.333	265.329	265.324	265.319	265.315	265.310	265.305	265.301	265.296
EXG. FORMATION LEVEL OF EXG IR UP MAIN LINE (EFL)	265.364	265.354	265.340	265.322	265.303	265.282	265.256	265.230	265.213	265.202	265.179	265.136	265.092
DIFFERENCE BETWEEN DFC RAIL LEVEL AND EXG. RAIL LEVEL (PRL - ERL)	0.029	0.034	0.043	0.056	0.071	0.087	0.109	0.130	0.142	0.149	0.167	0.206	0.245
DFC RAIL LEVEL (PRL)	266.065	266.060	266.055	266.051	266.046	266.041	266.037	266.032	266.027	266.023	266.018	266.013	266.009
EXG.RAIL LEVEL OF NEAREST IR UP MAIN LINE(ERL)	266.036	266.026	266.012	265.994	265.975	265.954	265.928	265.902	265.885	265.874	265.851	265.808	265.764
EQUIVALENT CHAINAGE ON DFC TRACK	1220376.5	1220396.5	1220416.5	1220436.5	1220456.5	1220476.5	1220496.5	1220516.5	1220536.5	1220556.5	1220576.5	1220596.5	1220616.5

EXISTING IR CHAINAGE	329760.0	329780.0	329800.0	329820.0	329840.0	329860.0	329880.0	329900.0	329920.0	329940.0	329960.0	329980.0	330000.0
TRACK DISTANCE FROM EXISTING NEAREST IR UP MAIN LINE TO DFC MAIN LINE	8.594	8.595	8.595	8.601	8.608	8.616	8.623	8.631	8.632	8.622	8.612	8.606	8.602
HEIGHT OF BANKING(+) / DEPTH OF CUTTING(-) (PFL-GL)	+0.481	+0.530	+0.623	+0.673	+0.702	+0.712	+0.643	+0.584	+0.296	+0.080	-0.128	-0.076	+0.431
EXG GROUND LEVEL AT CENTER LINE OF DFC TRACK (GL)	264.810	264.756	264.659	264.604	264.570	264.556	264.620	264.674	264.958	265.169	265.372	265.316	264.804
EXG GROUND LEVEL AT TOE LOCATION OF DFC TRACK	264.393	264.310	264.203	264.280	264.276	264.246	264.317	264.414	264.518	264.725	264.966	264.614	264.303
DIFFERENCE BETWEEN DFC FORMATION LEVEL AND EXG.FORMATION LEVEL.(PFL-EFL)	0.240	0.225	0.210	0.192	0.173	0.154	0.124	0.092	0.067	0.053	0.043	0.028	0.012
DFC FORMATION LEVEL (PFL)	265.291	265.286	265.282	265.277	265.272	265.268	265.263	265.258	265.254	265.249	265.244	265.240	265.235
EXG. FORMATION LEVEL OF EXG IR UP MAIN LINE (EFL)	265.051	265.062	265.072	265.085	265.099	265.114	265.139	265.167	265.187	265.196	265.202	265.212	265.223
DIFFERENCE BETWEEN DFC RAIL LEVEL AND EXG. RAIL LEVEL (PRL - ERL)	0.281	0.266	00.25	0.233	0.214	0.195	0.165	0.132	0.107	0.094	0.084	0.069	0.053
DFC RAIL LEVEL (PRL)	266.004	265.999	265.995	265.990	265.985	265.981	265.976	265.971	265.967	265.962	265.957	265.953	265.948
EXG.RAIL LEVEL OF NEAREST IR UP MAIN LINE(ERL)	265.723	265.734	265.744	265.757	265.771	265.786	265.811	265.839	265.859	265.868	265.874	265.884	265.895
EQUIVALENT CHAINAGE ON DFC TRACK	1220636.5	1220656.5	1220676.5	1220696.5	1220716.5	1220736.5	1220756.5	1220776.5	1220796.5	1220816.5	1220836.5	1220856.5	1220876.5

L - SECTION

NOTE:-

1. DFCC WORKS ARE SHOWN IN RED.
2. IR NEW WORKS ARE SHOWN IN VIOLET.
3. ALL DIMENSIONS ARE SHOWN IN METRES.
4. THIS DRAWING IS PREPARED BASED ON LATEST SURVEY DATA HELD ON APRIL-2022. GTS BENCH MARK OF 261.850M CONSIDERED ON TOP OF CANAL BRIDGE ABUTMENT AT DORAHA VILLAGE ALONG THE NH1.
5. DFC NEW CHAINAGE OF 1075.950M IS WITH REFERENCE TO THE IR KM OF 187.500KM END OF KM OF CP-303(SECTION P-3 PILKHANI END) AGAINST THE EXISTING DFC CHAINAGE. 116277.742M ISSUED VIDE LETTER NO. CGM/DFCC/UMB/SURVEY/2021-301-230116-011173 DT. 17.01.2023
6. BALLAST PROFILE HAS BEEN PROVIDED ACCORDING TO THE CLAUSE 1.11.3 OF STANDARD SCHEDULE OF DIMESION(EASTERN CORRIDOR) & THE BALLAST CUSHION DIMESION SHOWN IN 35CM ON GE-14 PARA 17. SPECIFICATIONS & RECOMMENDATIONS 2. TWO LAYER SYSTEM FIG.10.


REFERENCE DRAWINGS :-

1. FOR KEY PLAN REFER DRAWING NO. 301-2/AL/0001
2. FOR LEGEND AND ABBREVIATIONS REFER DRAWING NO. 301-2/AL1000
3. FOR TYPICAL SECTION OF BALLAST PROFILE (FL-RL) REFFER DRG. NO. 301-2/TK/TFD/-004 (TR.1952)

REV.	DATE	REVISION DETAILS	PURPOSE OF ISSUE
0	26.09.2024	SUBMISSION OF AS-BUILT DRAWING	FOR APPROVAL

SCALE
HOR - 1:1000
VER - 1:100
SHEET SIZE : A1

LEGEND:
IR TRACK
DFCC TRACK
DFCC FUTURE PROPOSALS
STRUCTURE / BUILDING
DFCC TOE LINE
DFCC FORMATION
RETAINING WALL
ROAD
STREAM, DRAIN, NALA, CANAL.
FENCE
POWER LINES
TBM
ELECTRIC POLE/OHE MAST
IR RAILWAY BOUNDARY
DFCC BOUNDARY

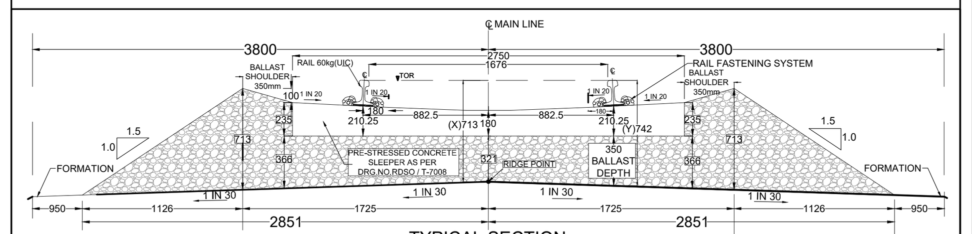

TYPICAL SECTION

TRACK STRUCTURE		
RAIL SECTION: 60Kg/m (UIC 60Kg/m) DFC LINE: 60Kg/m (UIC 60Kg/m) IR MAIN LINE:52Kg/m	Difference between FL- RL (Below Rail Seat)	
	IR Line	DFC
	172mm	172mm
RUBBER PAD	6mm	10mm
SLEEPER DEPTH	210mm	210mm
BALLAST CUSHION	300mm	350mm
Total Depth (FL TO RL)	688mm	742mm

OWNER
DEDICATED FREIGHT CORRIDOR CORPORATION OF INDIA LTD.
(A GOVERNMENT OF INDIA ENTERPRISE)
PROJECT OFFICE(AMBALA UNIT): OLD RAILWAY COLONY (NEAR ANAND MARKET),AMBALA CANTT-133001.
CORPORATE IDENTITY NO. : U60232DL2006GOI155068

ENGINEER:
DB Engineering & Consulting GmbH
Deutsche Bahn Engineering & Consulting GmbH

CONTRACTOR:
GIL - TPL JV

SUBMITTED BY	GIL - TPL JV		
	DATED	NAME	SIGNATURE
PREPARED BY			
CHECKED BY	26.09.2024	VIJAY PRATAP	
APPROVED BY	26.09.2024	PARASURAM KOTYADA	

APPROVED BY	DEUTSCHE BAHN ENGINEERING & CONSULTING GMBH		
	DATED	NAME	SIGNATURE
Sr. DE./CHIEF ENGINEER		SURESH K.YALANGI	
CHIEF TRACK ENGINEER		RAJ PAL SINGH	
T.L.		H.D. VIDJAK	

STAMP
A
AS-BUILT DRAWING
TR. Ref......................
ENGINEER Sign.:

EMPLOYER (DFCCIL): DEDICATED FREIGHT CORRIDOR CORPORATION OF INDIA LTD.

AS BUILT DRAWING

TITLE
AS-BUILT PLAN AND PROFILE
FROM IR KM: 329.500 TO 330.000
DFC KM:1220.376 TO 1220.876

DFCC APPR. NO. -
ENGG. APPR. NO. -
DRG. NO. - 301-2/AL/A/1285
SHEET NO. : 1 OF 1
DATE : 26.09.2024
STATUS A

TR.