

PILKHANI

SAHNEWAL

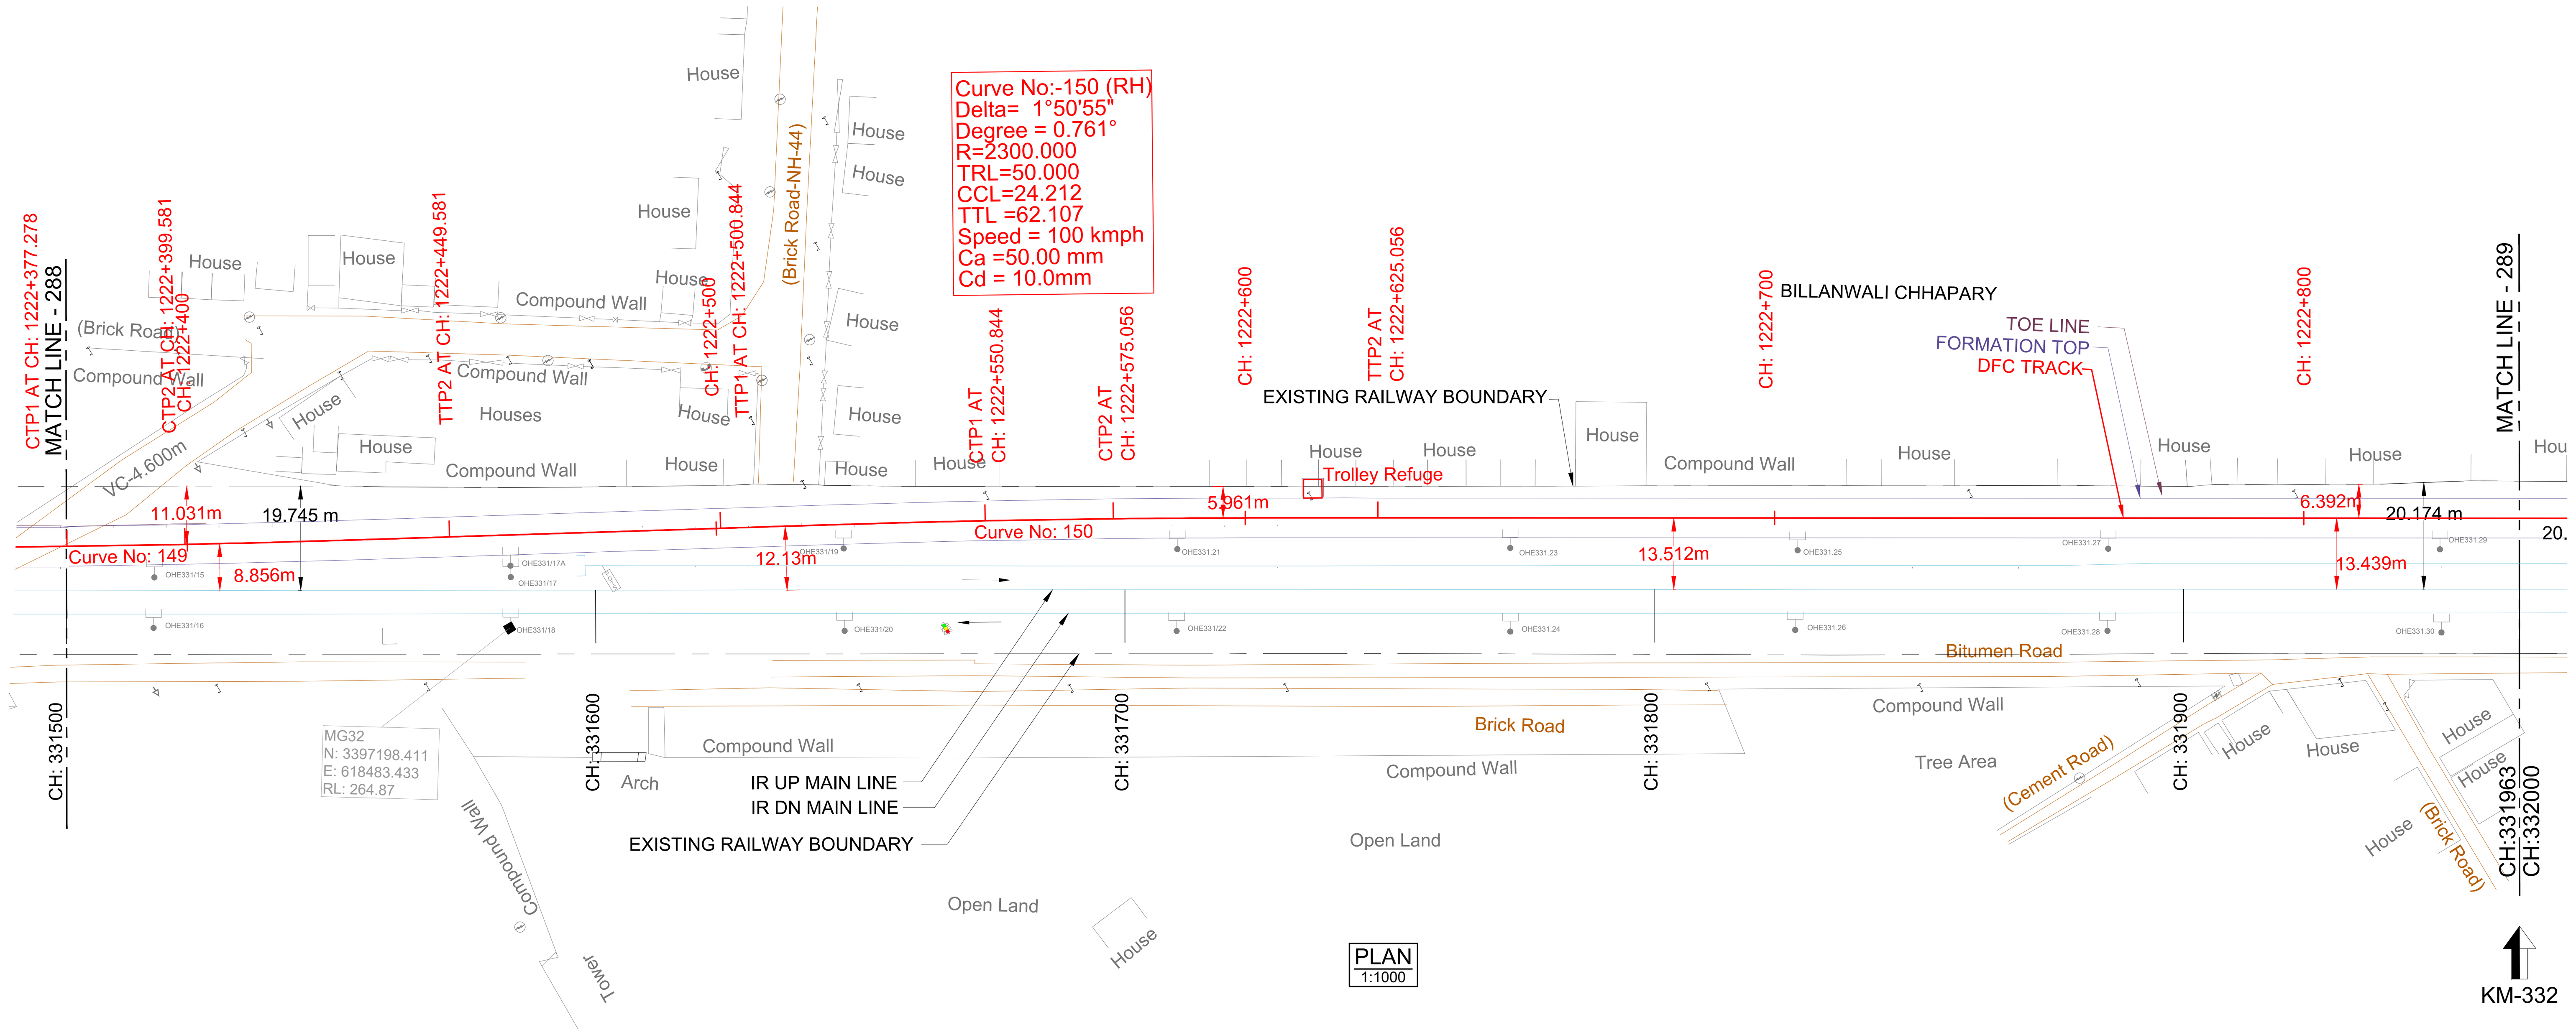

PLAN
1:1000

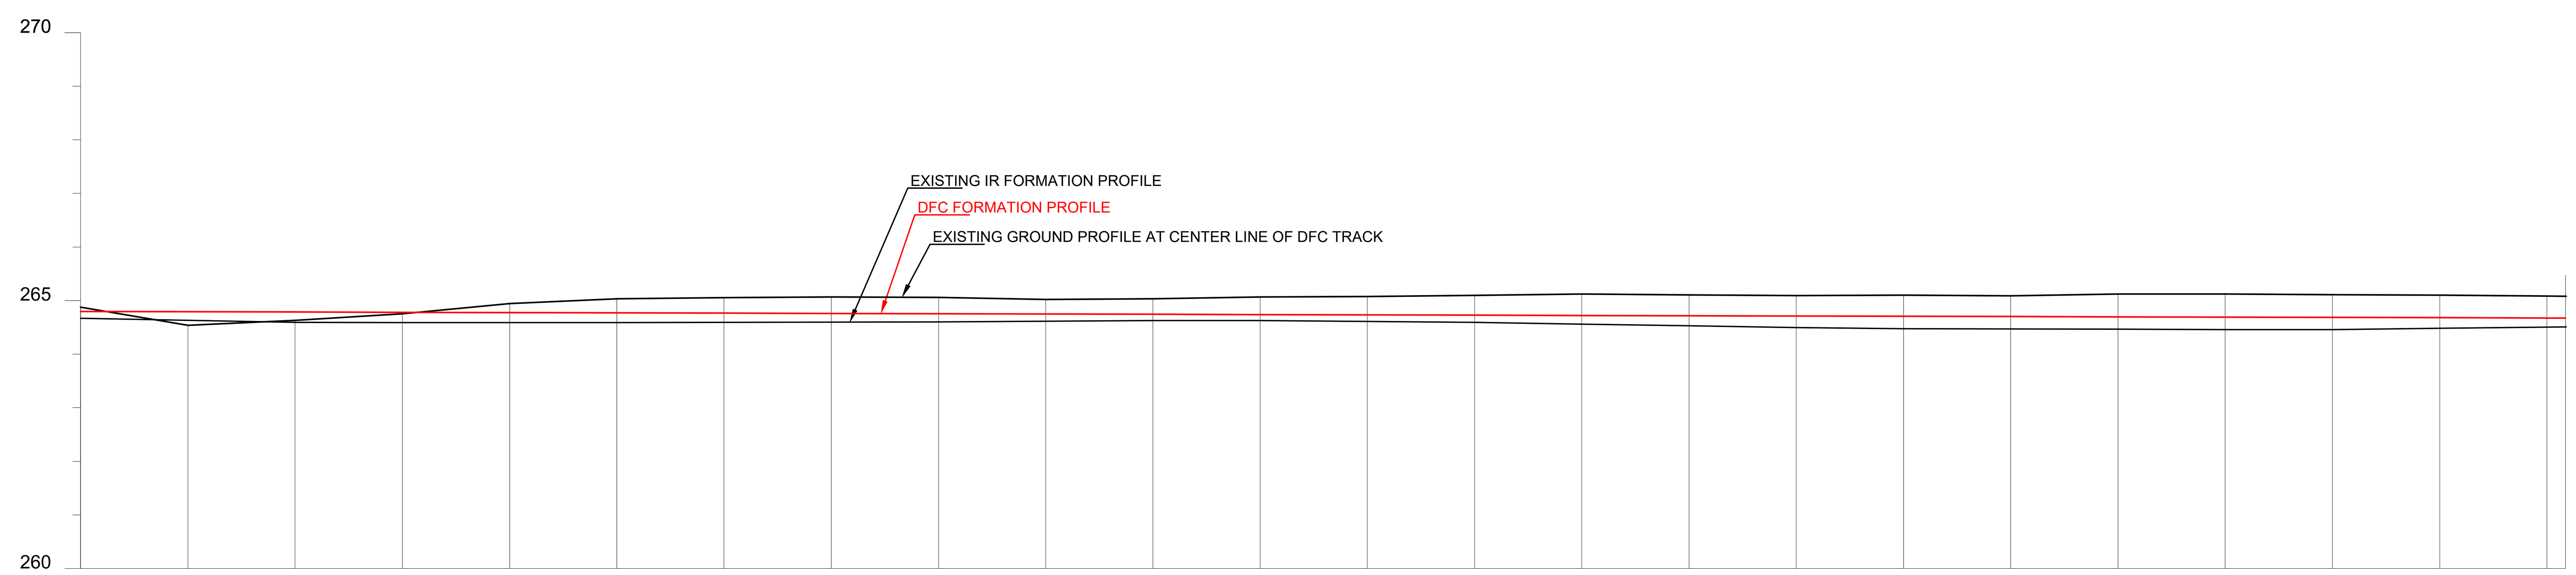

DATUM ABOVE MSL : 260 m

HORIZONTAL ALIGNMENT	R =-2300m TL= 50m L = 51.263 m TL= 50m R =-2300m TL= 50m L = 395.442 m																						
VERTICAL ALIGNMENT	L=1480.269 m 1 IN 3770.373 F																						
TRACK DISTANCE FROM EXISTING NEAREST IR UP MAIN LINE TO DFC MAIN LINE	8.397	8.679	9.127	9.698	10.316	10.936	11.556	12.174	12.740	13.177	13.440	13.546	13.560	13.544	13.530	13.516	13.500	13.486	13.474	13.460	13.446	13.436	13.441	13.442 13.439
HEIGHT OF BANKING(+) / DEPTH OF CUTTING(-) (PFL-GL)	-0.078	0.252	0.156	0.026	-0.170	-0.262	-0.288	-0.308	-0.306	-0.272	-0.289	-0.329	-0.341	-0.369	-0.400	-0.388	-0.380	-0.396	-0.386	-0.425	-0.434	-0.426	-0.423	-0.410 -0.407
EXG GROUND LEVEL AT CENTER LINE OF DFC TRACK (GL)	264.875	264.539	264.630	264.755	264.945	265.032	265.053	265.067	265.060	265.021	265.033	265.067	265.074	265.097	265.122	265.105	265.092	265.102	265.087	265.121	265.124	265.111	265.103	265.085 265.081
EXG GROUND LEVEL AT TOE LOCATION OF DFC TRACK	264.950	264.423	264.357	264.442	264.429	264.509	264.691	264.301	264.482	264.804	264.944	264.894	264.941	264.988	265.122	265.139	265.106	265.065	265.092	265.124	265.172	265.049	265.007	264.989 264.986
DIFFERENCE BETWEEN DFC FORMATION LEVEL AND EXG.FORMATION LEVEL.(PFL-EFL)	0.128	0.160	0.193	0.192	0.185	0.180	0.173	0.163	0.151	0.136	0.118	0.112	0.121	0.136	0.161	0.189	0.216	0.233	0.231	0.230	0.231	0.228	0.199	0.171 0.164
DFC FORMATION LEVEL (PFL) AT CENTER LINE	264.797	264.791	264.786	264.781	264.775	264.770	264.765	264.759	264.754	264.749	264.744	264.738	264.733	264.728	264.722	264.717	264.712	264.706	264.701	264.696	264.690	264.685	264.680	264.675 264.674
EXG. FORMATION LEVEL OF EXG IR UP MAIN LINE (EFL)	264.669	264.631	264.593	264.589	264.590	264.590	264.592	264.596	264.603	264.613	264.626	264.626	264.612	264.592	264.561	264.528	264.496	264.473	264.470	264.466	264.459	264.457	264.481	264.504 264.510
DIFFERENCE BETWEEN DFC RAIL LEVEL AND EXG. RAIL LEVEL (PRL - ERL)	0.227	0.260	0.292	0.291	0.285	0.279	0.273	0.263	0.251	0.235	0.217	0.212	0.221	0.235	0.261	0.289	0.315	0.333	0.330	0.329	0.331	0.328	0.299	0.270 0.263
DFC RAIL LEVEL (PRL) AT INNER RAIL TOP	265.568	265.563	265.558	265.552	265.547	265.542	265.536	265.531	265.526	265.520	265.515	265.510	265.504	265.499	265.494	265.489	265.483	265.478	265.473	265.467	265.462	265.457	265.451	265.446 265.445
EXG.RAIL LEVEL OF NEAREST IR UP MAIN LINE(ERL)	265.341	265.303	265.265	265.261	265.262	265.262	265.264	265.268	265.275	265.285	265.298	265.298	265.284	265.264	265.233	265.200	265.168	265.145	265.142	265.138	265.131	265.129	265.153	265.176 265.182
EQUIVALENT CHAINAGE ON DFC TRACK	1222376.5	1222396.5	1222416.5	1222436.6	1222456.6	1222476.6	1222496.6	1222516.6	1222536.6	1222556.6	1222576.6	1222596.6	1222616.6	1222636.6	1222656.6	1222676.6	1222696.6	1222716.6	1222736.6	1222756.6	1222776.6	1222796.6	1222816.6	1222836.6 1222840.1
EXISTING IR CHAINAGE	331500.0	331520.0	331540.0	331560.0	331580.0	331600.0	331620.0	331640.0	331660.0	331680.0	331700.0	331720.0	331740.0	331760.0	331780.0	331800.0	331820.0	331840.0	331860.0	331880.0	331900.0	331920.0	331940.0	331960.0 331963.5 332000.0

L - SECTION

NOTE:-

DRG NO.- 301-2/AL/A/1289

1. DFCC WORKS ARE SHOWN IN RED.
2. IR NEW WORKS ARE SHOWN IN VIOLET.
3. ALL DIMENSIONS ARE SHOWN IN METRES.
4. THIS DRAWING IS PREPARED BASED ON LATEST SURVEY DATA HELD ON APRIL-2022. GTS BENCH MARK OF 261.850M CONSIDERED ON TOP OF CANAL BRIDGE ABUTMENT AT DORAHA VILLAGE ALONG THE NH1.
5. DFC NEW CHAINAGE OF 1075.950M IS WITH REFERENCE TO THE IR KM OF 187.500KM END OF KM OF CP-303(SECTION P-3 PILKHANI END) AGAINST THE EXISTING DFC CHAINAGE. 116277.742M ISSUED VIDE LETTER NO. CGM/DFCC/UMB/SURVEY/2021-301-230116-011173 DT. 17.01.2023
6. BALLAST PROFILE HAS BEEN PROVIDED ACCORDING TO THE CLAUSE 1.11.3 OF STANDARD SCHEDULE OF DIMESION(EASTERN CORRIDOR) & THE BALLAST CUSHION DIMESION SHOWN IN 35CM ON GE-14 PARA 17. SPECIFICATIONS & RECOMMENDATIONS 2. TWO LAYER SYSTEM FIG.10.

REFERENCE DRAWINGS :-


1. FOR KEY PLAN REFER DRAWING NO. 301-2/AL/0001
2. FOR LEGEND AND ABBREVIATIONS REFER DRAWING NO. 301-2/AL1000
3. FOR TYPICAL SECTION OF BALLAST PROFILE (FL-RL) REFFER DRG. NO. 301-2/TK/TFD/-004 (TR.1952)

REV.	DATE	REVISION DETAILS	PURPOSE OF ISSUE
0	30.09.2024	SUBMISSION OF AS-BUILT DRAWING	FOR APPROVAL

SCALE
HOR - 1:1000
0 10 20 30 40m
0 1 2 3 4m
VER - 1:100
SHEET SIZE : A1

LEGEND:

- IR TRACK
- DFCC TRACK
- DFCC FUTURE PROPOSALS
- STRUCTURE / BUILDING
- DFCC TOE LINE
- DFCC FORMATION
- RETAINING WALL
- ROAD
- STREAM, DRAIN, NALA, CANAL.
- FENCE
- POWER LINES
- TBM
- ELECTRIC POLE/OHE MAST
- IR RAILWAY BOUNDARY
- DFCC BOUNDARY

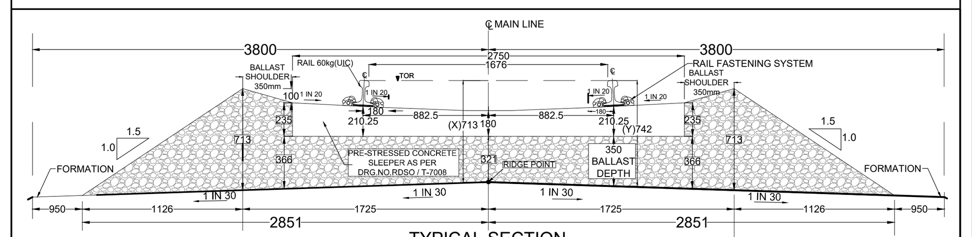

TYPICAL SECTION

TRACK STRUCTURE		
RAIL SECTION: 60Kg/m (UIC 60Kg/m) DFC LINE: 60Kg/m (UIC 60Kg/m) IR MAIN LINE:52Kg/m	Difference between FL- RL (Below Rail Seat)	
	IR Line	DFC
	172mm	172mm
RUBBER PAD	6mm	10mm
SLEEPER DEPTH	210mm	210mm
BALLAST CUSHION	300mm	350mm
Total Depth (FL TO RL)	688mm	742mm

OWNER
DEDICATED FREIGHT CORRIDOR CORPORATION OF INDIA LTD.
(A GOVERNMENT OF INDIA ENTERPRISE)
PROJECT OFFICE(AMBALA UNIT): OLD RAILWAY COLONY (NEAR ANAND MARKET),AMBALA CANTT-133001.
CORPORATE IDENTITY NO. : U60232DL2006GOI155068

ENGINEER:
DB Engineering & Consulting GmbH
Deutsche Bahn Engineering & Consulting GmbH

CONTRACTOR:
GIL - TPL JV

SUBMITTED BY	GIL - TPL JV		
	DATED	NAME	SIGNATURE
PREPARED BY			
CHECKED BY	30.09.2024	VIJAY PRATAP	
APPROVED BY	30.09.2024	PARASURAM KOTYADA	

APPROVED BY	DEUTSCHE BAHN ENGINEERING & CONSULTING GMBH		
	DATED	NAME	SIGNATURE
Sr. DE./CHIEF ENGINEER		SURESH K.YALANGI	
CHIEF TRACK ENGINEER		RAJ PAL SINGH	
T.L.		H.D. VIDJAK	

STAMP
A
AS-BUILT DRAWING
TR. Ref......................
ENGINEER Sign.:

EMPLOYER (DFCCIL): DEDICATED FREIGHT CORRIDOR CORPORATION OF INDIA LTD.

AS BUILT DRAWING

TITLE
AS-BUILT PLAN AND PROFILE
FROM IR KM: 331.500 TO 332.000
FROM DFC KM: 1222.376 TO 1222.840

DFCC APPR. NO. -
ENGG. APPR. NO. -
DRG. NO. -301-2/AL/A/1289
SHEET NO. : 1 OF 1
DATE : 30.09.2024
STATUS
A

TR.