
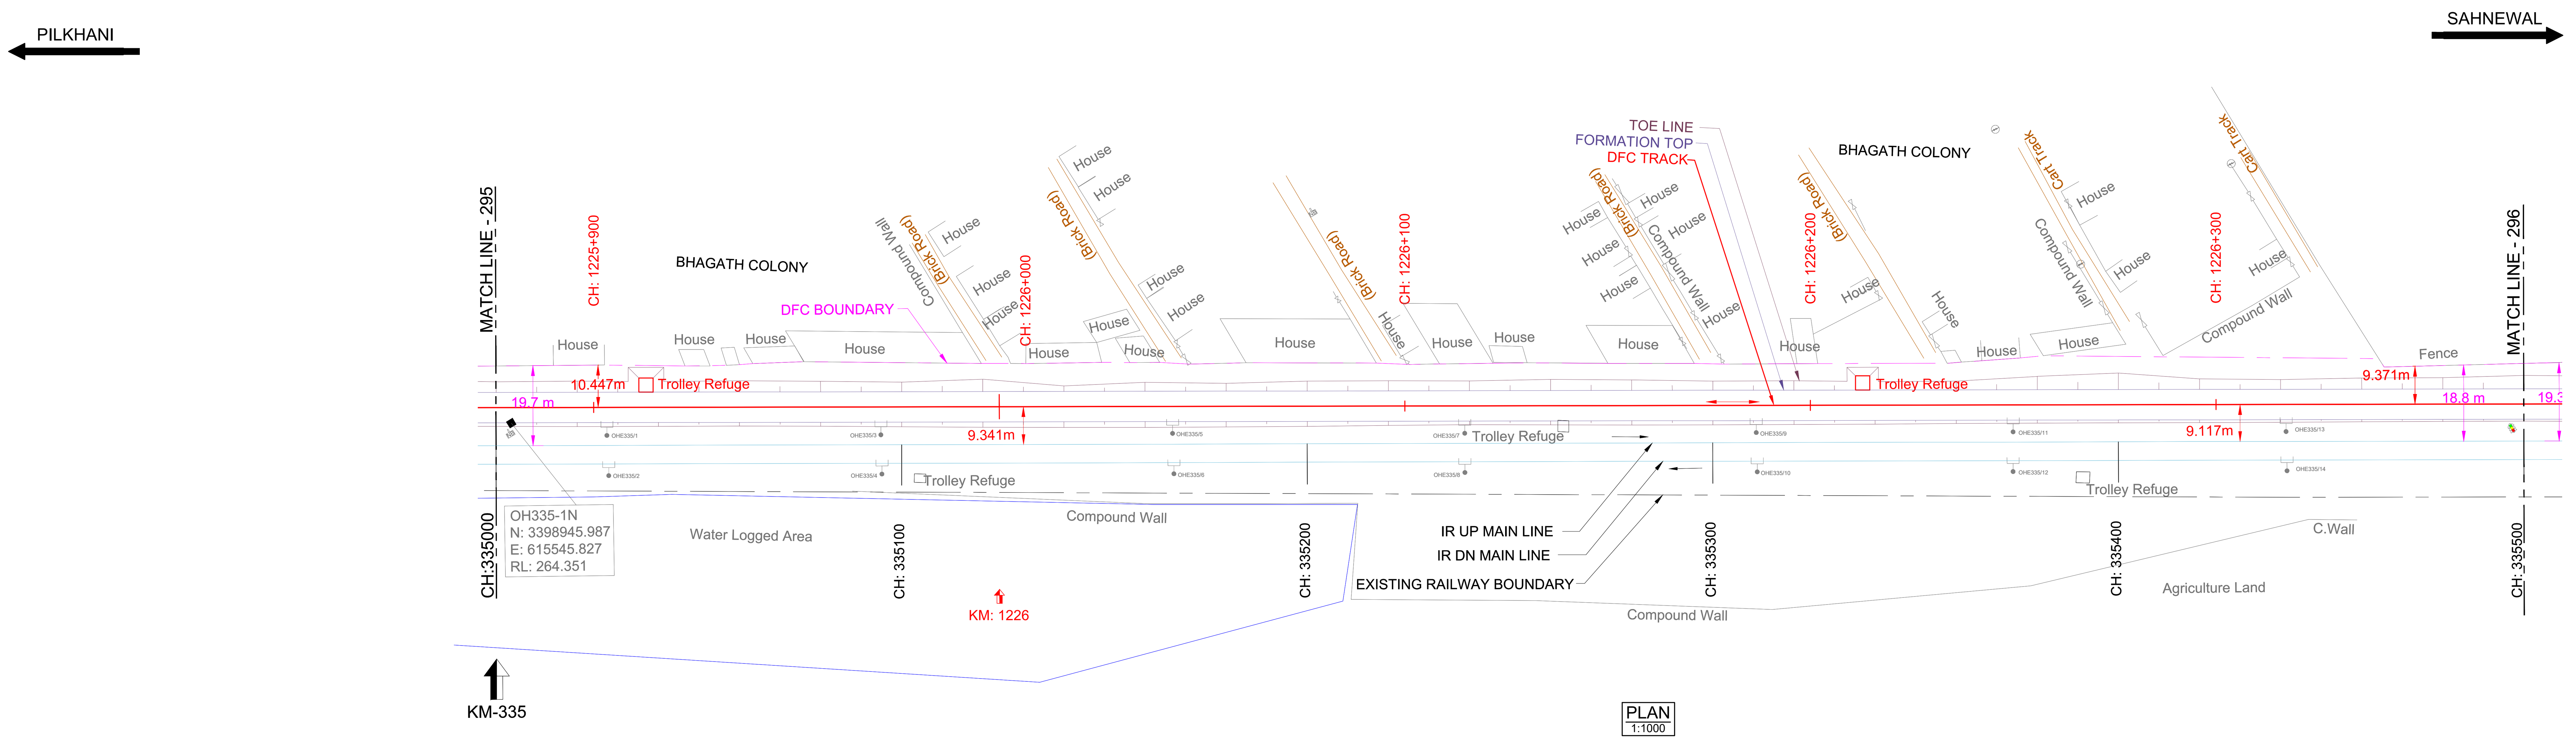


PLAN
1:1000

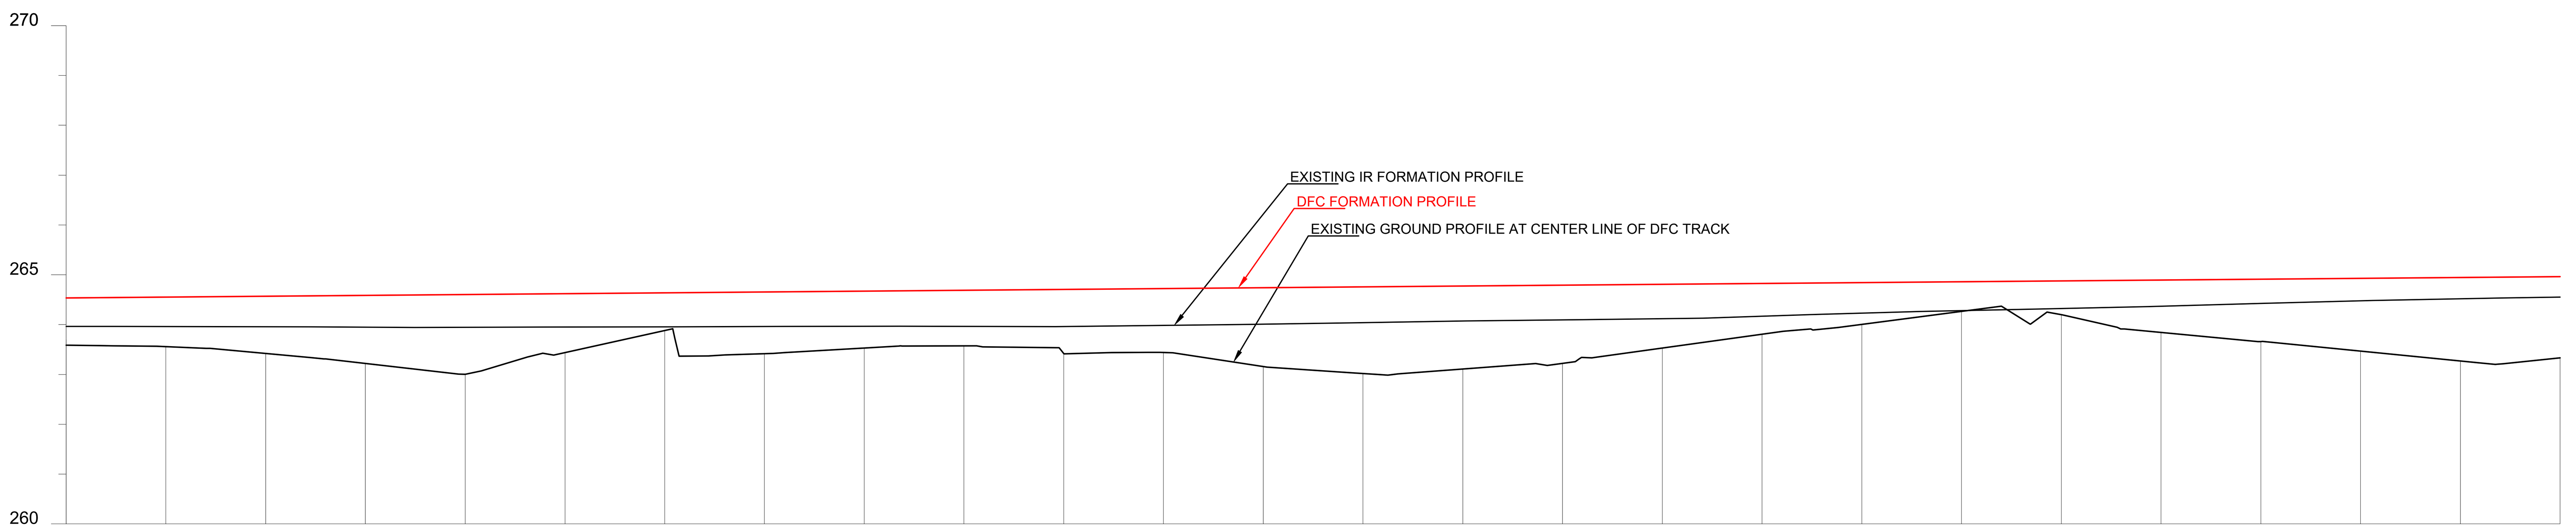

DATUM ABOVE MSL : 260 m

HORIZONTAL ALIGNMENT: L = 1774.686m

VERTICAL ALIGNMENT: L=1312.594 m, 1 IN 1173.620 R

TRACK DISTANCE FROM EXISTING NEAREST IR UP MAIN LINE TO DFC MAIN LINE	9.398	9.378	9.355	9.330	9.324	9.335	9.346	9.335	9.322	9.292	9.253	9.237	9.225
HEIGHT OF BANKING(+) / DEPTH OF CUTTING(-) (PFL-GL)	+0.951	+0.995	+1.149	+1.367	+1.601	+1.183	+0.759	+1.239	+1.143	+1.117	+1.286	+1.285	+1.585
EXG GROUND LEVEL AT CENTER LINE OF DFC TRACK (GL)	263.586	263.559	263.422	263.221	263.004	263.440	263.881	263.418	263.531	263.574	263.422	263.440	263.157
EXG GROUND LEVEL AT TOE LOCATION OF DFC TRACK	263.132	263.083	263.169	263.108	263.197	263.345	263.016	263.877	263.462	263.628	263.381	263.375	263.427
DIFFERENCE BETWEEN DFC FORMATION LEVEL AND EXG.FORMATION LEVEL.(PFL-EFL)	0.573	0.595	0.615	0.641	0.661	0.671	0.683	0.694	0.706	0.725	0.745	0.740	0.734
DFC FORMATION LEVEL (PFL)	264.537	264.554	264.571	264.588	264.605	264.623	264.640	264.657	264.674	264.691	264.708	264.725	264.742
EXG. FORMATION LEVEL OF EXG IR UP MAIN LINE (EFL)	263.964	263.960	263.956	263.948	263.945	263.951	263.957	263.963	263.967	263.966	263.963	263.984	264.008
DIFFERENCE BETWEEN DFC RAIL LEVEL AND EXG. RAIL LEVEL (PRL - ERL)	0.615	0.636	0.656	0.682	0.702	0.712	0.724	0.735	0.747	0.766	0.786	0.782	0.775
DFC RAIL LEVEL (PRL)	265.250	265.267	265.284	265.302	265.319	265.336	265.353	265.370	265.387	265.404	265.421	265.438	265.455
EXG.RAIL LEVEL OF NEAREST IR UP MAIN LINE(ERL)	264.636	264.632	264.628	264.620	264.617	264.623	264.629	264.635	264.639	264.638	264.635	264.656	264.680
EQUIVALENT CHAINAGE ON DFC TRACK	1225875.3	1225895.3	1225915.3	1225935.3	1225955.3	1225975.3	1225995.3	1226015.3	1226035.3	1226055.3	1226075.3	1226095.3	1226115.3
EXISTING IR CHAINAGE	335000.0	335020.0	335040.0	335060.0	335080.0	335100.0	335120.0	335140.0	335160.0	335180.0	335200.0	335220.0	335240.0

TRACK DISTANCE FROM EXISTING NEAREST IR UP MAIN LINE TO DFC MAIN LINE	9.230	9.234	9.200	9.165	9.156	9.164	9.159	9.132	9.110	9.124	9.138	9.132	9.123
HEIGHT OF BANKING(+) / DEPTH OF CUTTING(-) (PFL-GL)	+1.741	+1.668	+1.571	+1.280	+1.019	+0.840	+0.595	+0.677	+1.050	+1.252	+1.461	+1.675	+1.628
EXG GROUND LEVEL AT CENTER LINE OF DFC TRACK (GL)	263.018	263.108	263.222	263.530	263.808	264.004	264.266	264.201	263.845	263.660	263.468	263.271	263.335
EXG GROUND LEVEL AT TOE LOCATION OF DFC TRACK	263.286	263.378	263.555	263.558	263.691	263.673	263.119	262.732	263.484	263.619	263.460	263.451	263.206
DIFFERENCE BETWEEN DFC FORMATION LEVEL AND EXG.FORMATION LEVEL.(PFL-EFL)	0.721	0.705	0.698	0.691	0.660	0.614	0.579	0.554	0.527	0.487	0.452	0.429	0.410
DFC FORMATION LEVEL (PFL)	264.759	264.776	264.793	264.810	264.827	264.844	264.861	264.878	264.895	264.912	264.929	264.946	264.963
EXG. FORMATION LEVEL OF EXG IR UP MAIN LINE (EFL)	264.037	264.071	264.095	264.119	264.167	264.230	264.282	264.324	264.368	264.425	264.477	264.517	264.553
DIFFERENCE BETWEEN DFC RAIL LEVEL AND EXG. RAIL LEVEL (PRL - ERL)	0.762	0.746	0.739	0.732	0.701	0.656	0.620	0.595	0.568	0.528	0.493	0.470	0.451
DFC RAIL LEVEL (PRL)	265.472	265.489	265.506	265.523	265.540	265.557	265.574	265.591	265.608	265.625	265.642	265.659	265.676
EXG.RAIL LEVEL OF NEAREST IR UP MAIN LINE(ERL)	264.709	264.743	264.767	264.791	264.839	264.902	264.954	264.996	265.040	265.097	265.149	265.189	265.225
EQUIVALENT CHAINAGE ON DFC TRACK	1226135.3	1226155.3	1226175.3	1226195.3	1226215.3	1226235.3	1226255.3	1226275.3	1226295.3	1226315.3	1226335.3	1226355.3	1226375.3
EXISTING IR CHAINAGE	335260.0	335280.0	335300.0	335320.0	335340.0	335360.0	335380.0	335400.0	335420.0	335440.0	335460.0	335480.0	335500.0

L - SECTION

DRG NO.- 301-2/AL/A/1296

NOTE:-

1. DFCC WORKS ARE SHOWN IN RED.
2. IR NEW WORKS ARE SHOWN IN VIOLET.
3. ALL DIMENSIONS ARE SHOWN IN METRES.
4. THIS DRAWING IS PREPARED BASED ON LATEST SURVEY DATA HELD ON APRIL-2022. GTS BENCH MARK OF 261.850M CONSIDERED ON TOP OF CANAL BRIDGE ABUTMENT AT DORAHA VILLAGE ALONG THE NH1.
5. DFC NEW CHAINAGE OF 1075.950M IS WITH REFERENCE TO THE IR KM OF 187.500KM END OF KM OF CP-303(SECTION P-3 PILKHANI END) AGAINST THE EXISTING DFC CHAINAGE. 116277.742M ISSUED VIDE LETTER NO. CGM/DFCC/UMB/SURVEY/2021-301-230116-011173 DT. 17.01.2023
6. BALLAST PROFILE HAS BEEN PROVIDED ACCORDING TO THE CLAUSE 1.11.3 OF STANDARD SCHEDULE OF DIMESION(EASTERN CORRIDOR) & THE BALLAST CUSHION DIMESION SHOWN IN 35CM ON GE-14 PARA 17. SPECIFICATIONS & RECOMMENDATIONS 2. TWO LAYER SYSTEM FIG.10.

REFERENCE DRAWINGS :-


1. FOR KEY PLAN REFER DRAWING NO. 301-2/AL/0001
2. FOR LEGEND AND ABBREVIATIONS REFER DRAWING NO. 301-2/AL1000
3. FOR TYPICAL SECTION OF BALLAST PROFILE (FL-RL) REFFER DRG. NO. 301-2/TK/TFD/-004 (TR.1952)

REV.	DATE	REVISION DETAILS	PURPOSE OF ISSUE
0	03.10.2024	SUBMISSION OF AS-BUILT DRAWING	FOR APPROVAL

SCALE
HOR - 1:1000 (0, 10, 20, 30, 40m)
VER - 1:100 (0, 1, 2, 3, 4m)
SHEET SIZE : A1

LEGEND:

- IR TRACK
- DFCC TRACK
- DFCC FUTURE PROPOSALS
- STRUCTURE / BUILDING
- DFCC TOE LINE
- DFCC FORMATION
- RETAINING WALL
- ROAD
- STREAM, DRAIN, NALA, CANAL.
- FENCE
- POWER LINES
- TBM
- ELECTRIC POLE/OHE MAST
- IR RAILWAY BOUNDARY
- DFCC BOUNDARY

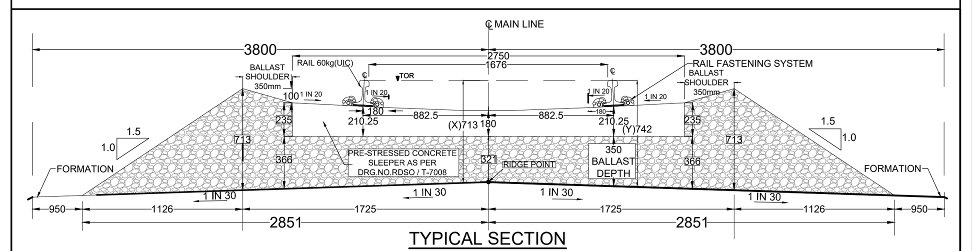

TYPICAL SECTION

TRACK STRUCTURE		
RAIL SECTION: 60Kg/m (UIC 60Kg/m) DFC LINE: 60Kg/m (UIC 60Kg/m) IR MAIN LINE:52Kg/m	Difference between FL- RL (Below Rail Seat)	
	IR Line	DFC
	172mm	172mm
RUBBER PAD	6mm	10mm
SLEEPER DEPTH	210mm	210mm
BALLAST CUSHION	300mm	350mm
Total Depth (FL TO RL)	688mm	742mm

OWNER
DEDICATED FREIGHT CORRIDOR CORPORATION OF INDIA LTD.
(A GOVERNMENT OF INDIA ENTERPRISE)
PROJECT OFFICE(AMBALA UNIT): OLD RAILWAY COLONY (NEAR ANAND MARKET),AMBALA CANTT-133001.
CORPORATE IDENTITY NO. : U60232DL2006GOI155068

ENGINEER:
DB Engineering & Consulting GmbH
Deutsche Bahn Engineering & Consulting GmbH

CONTRACTOR:
GIL - TPL JV

SUBMITTED BY	GIL - TPL JV		
	DATED	NAME	SIGNATURE
PREPARED BY			
CHECKED BY	03.10.2024	VIJAY PRATAP	
APPROVED BY	03.10.2024	PARASURAM KOTYADA	

APPROVED BY	DEUTSCHE BAHN ENGINEERING & CONSULTING GMBH		
	DATED	NAME	SIGNATURE
Sr. DE./CHIEF ENGINEER		SURESH K.YALANGI	
CHIEF TRACK ENGINEER		RAJ PAL SINGH	
T.L.		H.D. VIDJAK	

STAMP
A AS-BUILT DRAWING
TR. Ref......................
ENGINEER Sign.:

EMPLOYER (DFCCIL): DEDICATED FREIGHT CORRIDOR CORPORATION OF INDIA LTD.

AS BUILT DRAWING

TITLE
AS-BUILT PLAN AND PROFILE
FROM IR KM: 335.000 TO 335.500
FROM DFC KM: 1225.875 to 1226.375

DFCC APPR. NO. -
ENGG. APPR. NO. -
DRG. NO. -301-2/AL/A/1296
SHEET NO. : 1 OF 1
DATE : 03.10.2024
STATUS A

TR.