

PILKHANI ← → SAHNEWAL

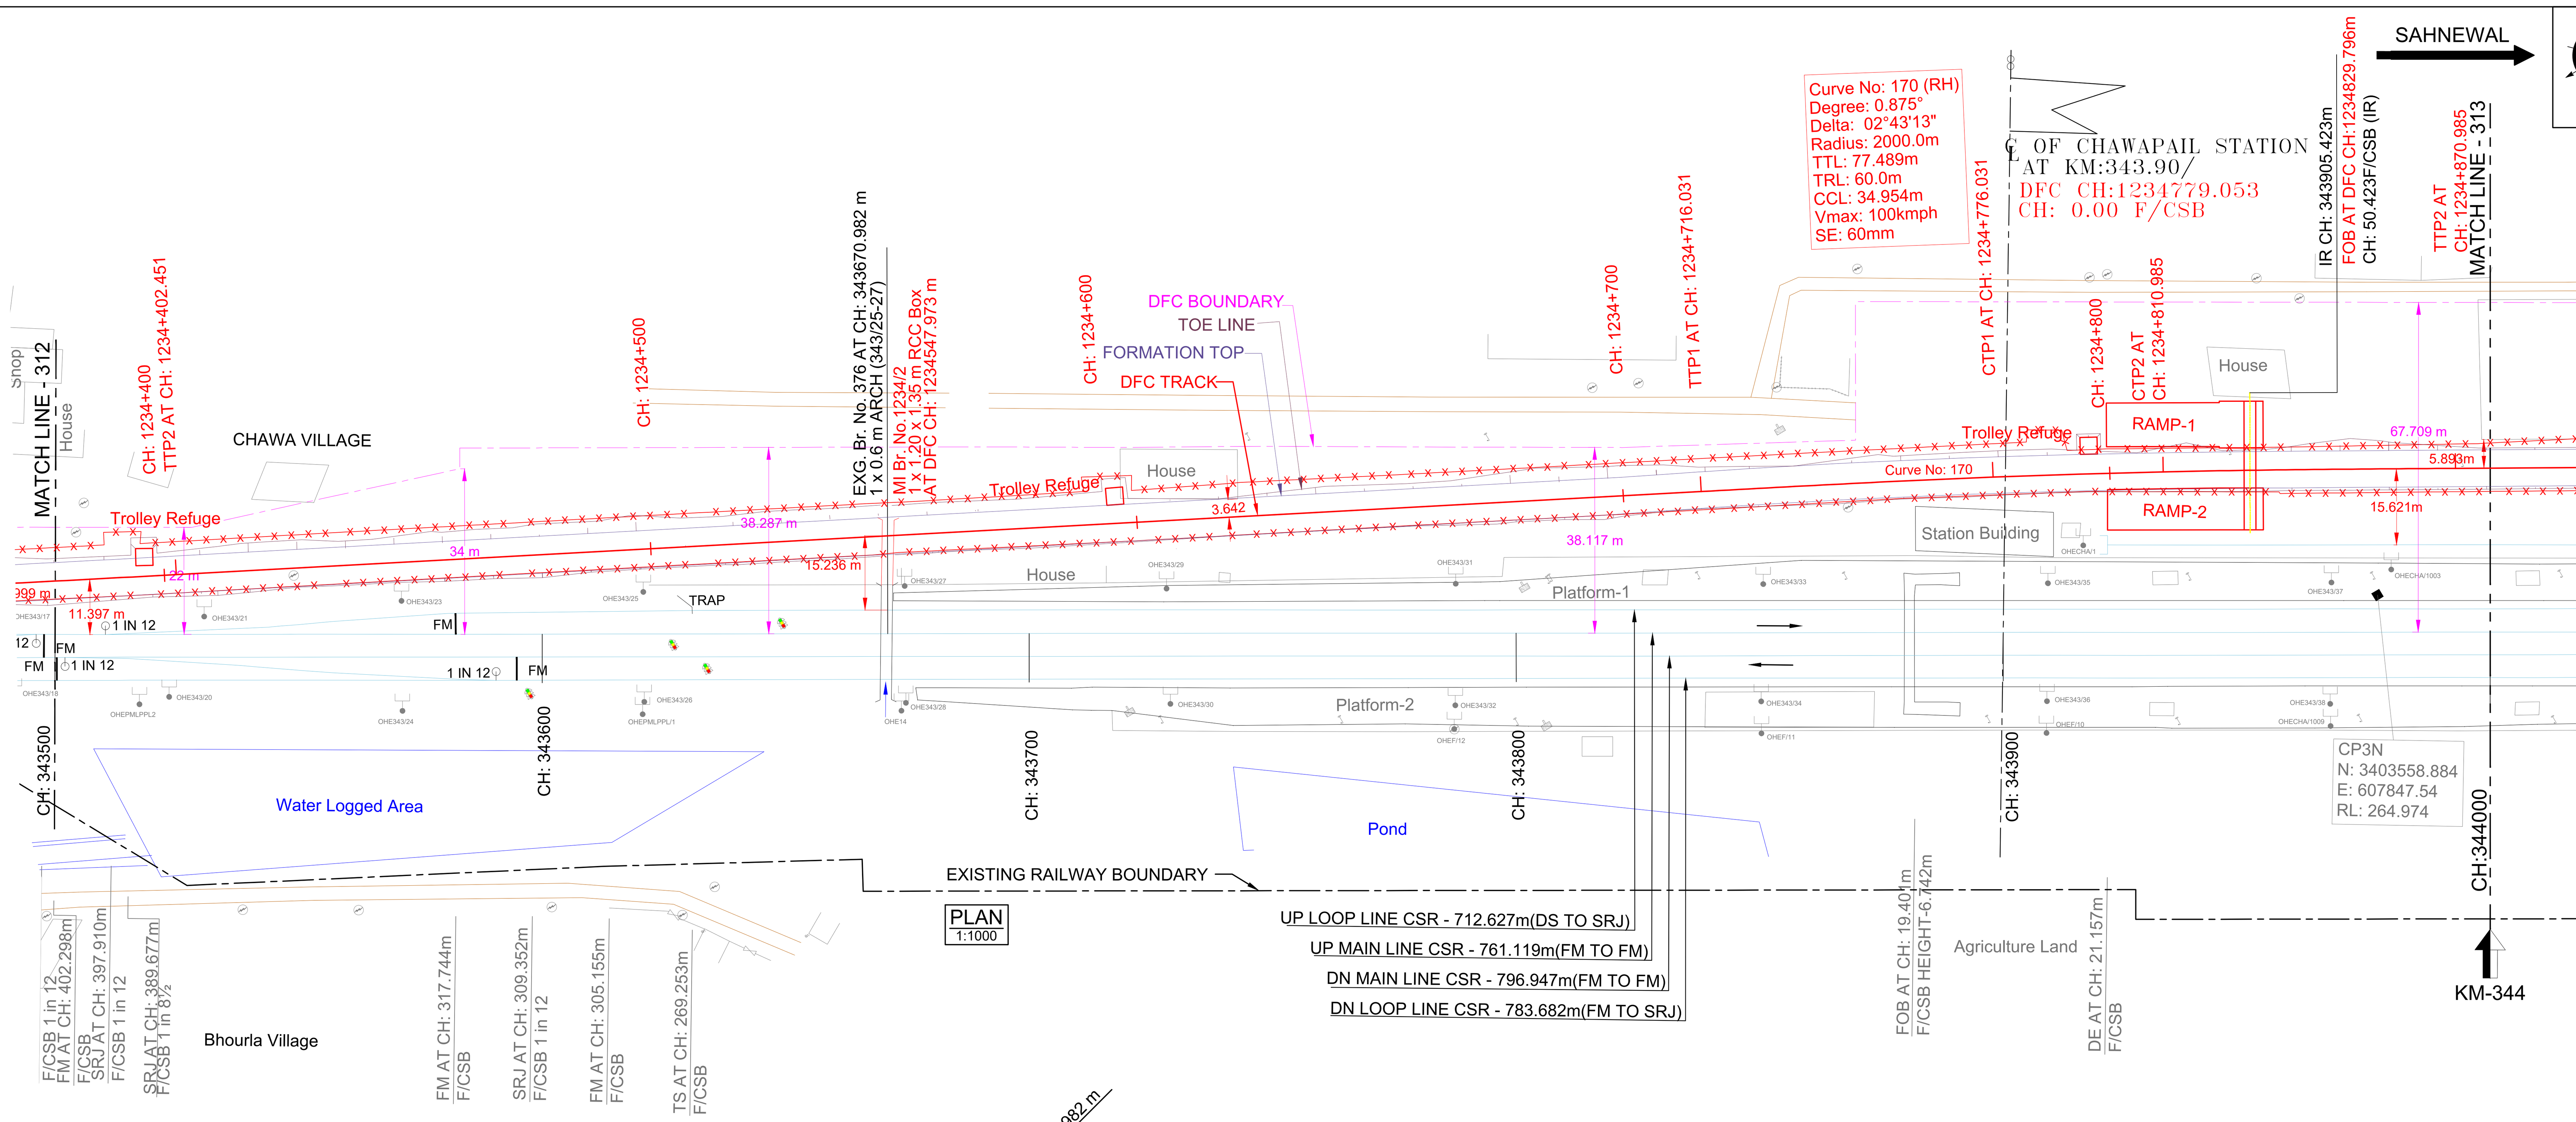

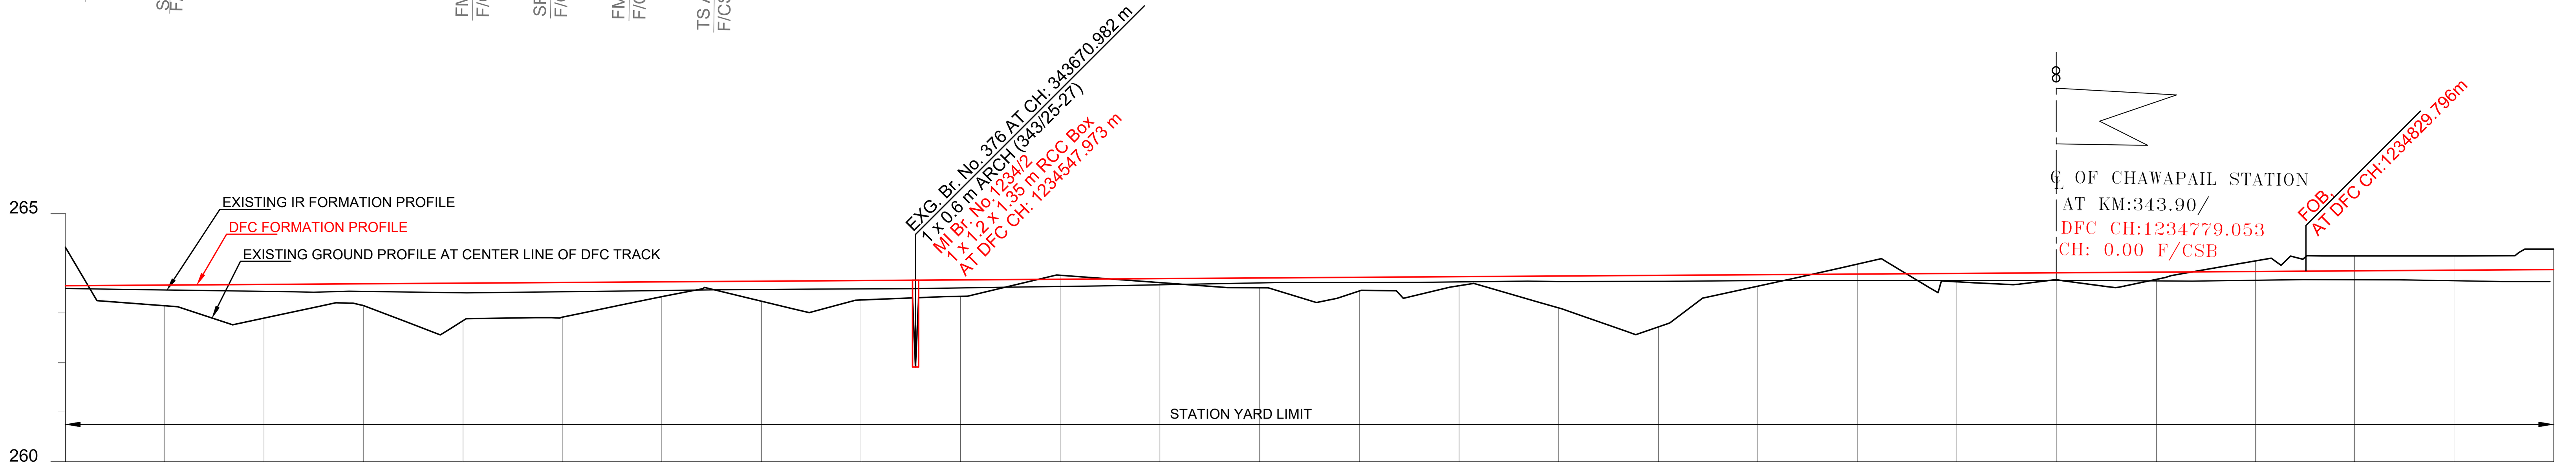

DATUM ABOVE MSL : 260 m

HORIZONTAL ALIGNMENT: TL=70m — L=313.580m — TL=60m — R=2000m — TL=60m — L=367.588m

VERTICAL ALIGNMENT: L=1481.016 m, 1 IN 1523.161 R

EXISTING IR CHAINAGE	343500.0	343520.0	343540.0	343560.0	343580.0	343600.0	343620.0	343640.0	343660.0	343680.0	343700.0	343720.0	343740.0
TRACK DISTANCE FROM EXISTING NEAREST IR UP MAIN LINE TO DFC MAIN LINE	10.961	12.043	13.093	14.167	15.273	16.329	17.382	18.444	19.518	20.579	21.627	22.686	23.752
HEIGHT OF BANKING(+) / DEPTH OF CUTTING(-) (PFL-GL)	-0.777	+0.414	+0.678	+0.441	+0.755	+0.699	+0.298	+0.400	+0.392	+0.330	-0.080	+0.080	+0.199
EXG GROUND LEVEL AT CENTER LINE OF DFC TRACK (GL)	264.320	263.142	262.891	263.141	262.840	262.909	263.323	263.234	263.256	263.331	263.754	263.607	263.501
EXG GROUND LEVEL AT TOE LOCATION OF DFC TRACK	263.680	263.020	262.067	262.005	261.949	262.179	262.655	263.154	263.147	263.228	263.593	263.451	263.374
DIFFERENCE BETWEEN DFC FORMATION LEVEL AND EXG.FORMATION LEVEL.(PFL-EFL)	0.052	0.098	0.138	0.152	0.193	0.184	0.173	0.165	0.166	0.160	0.144	0.123	0.099
DFC FORMATION LEVEL (PFL)	263.543	263.556	263.569	263.582	263.595	263.608	263.621	263.634	263.648	263.661	263.674	263.687	263.700
EXG. FORMATION LEVEL OF EXG IR UP MAIN LINE (EFL)	263.491	263.458	263.431	263.430	263.402	263.424	263.448	263.469	263.482	263.501	263.530	263.564	263.601
DIFFERENCE BETWEEN DFC RAIL LEVEL AND EXG. RAIL LEVEL (PRL - ERL)	0.093	0.138	0.179	0.193	0.234	0.225	0.214	0.207	0.207	0.201	0.185	0.164	0.140
DFC RAIL LEVEL (PRL)	264.255	264.268	264.282	264.295	264.308	264.321	264.334	264.347	264.360	264.374	264.387	264.400	264.413
EXG.RAIL LEVEL OF NEAREST IR UP MAIN LINE(ERL)	264.163	264.130	264.103	264.102	264.074	264.096	264.120	264.141	264.154	264.173	264.202	264.236	264.273
EQUIVALENT CHAINAGE ON DFC TRACK	1234376.9	1234396.9	1234416.9	1234437.0	1234457.0	1234477.0	1234497.0	1234517.1	1234537.1	1234557.1	1234577.1	1234597.2	1234617.2

EXISTING IR CHAINAGE	343760.0	343780.0	343800.0	343820.0	343840.0	343860.0	343880.0	343900.0	343920.0	343940.0	343960.0	343980.0	344000.0
TRACK DISTANCE FROM EXISTING NEAREST IR UP MAIN LINE TO DFC MAIN LINE	24.824	25.904	26.993	28.078	29.140	30.175	31.127	31.950	32.633	33.116	33.389	33.549	33.676
HEIGHT OF BANKING(+) / DEPTH OF CUTTING(-) (PFL-GL)	+0.273	+0.184	+0.644	+1.037	+0.231	-0.200	+0.169	+0.142	+0.149	-0.211	-0.299	-0.288	-0.411
EXG GROUND LEVEL AT CENTER LINE OF DFC TRACK (GL)	263.440	263.543	263.096	262.716	263.535	263.979	263.623	263.664	263.670	264.043	264.144	264.146	264.282
EXG GROUND LEVEL AT TOE LOCATION OF DFC TRACK	262.852	263.322	262.867	262.414	263.249	263.716	263.242	263.119	263.469	263.045	263.182	262.954	264.127
DIFFERENCE BETWEEN DFC FORMATION LEVEL AND EXG.FORMATION LEVEL.(PFL-EFL)	0.104	0.107	0.112	0.120	0.119	0.127	0.141	0.157	0.177	0.178	0.181	0.214	0.242
DFC FORMATION LEVEL (PFL)	263.713	263.727	263.740	263.753	263.766	263.779	263.792	263.806	263.819	263.832	263.845	263.858	263.871
EXG. FORMATION LEVEL OF EXG IR UP MAIN LINE (EFL)	263.609	263.620	263.628	263.633	263.647	263.652	263.651	263.649	263.642	263.654	263.664	263.644	263.629
DIFFERENCE BETWEEN DFC RAIL LEVEL AND EXG. RAIL LEVEL (PRL - ERL)	0.145	0.148	0.152	0.160	0.160	0.168	0.182	0.197	0.217	0.219	0.222	0.254	0.283
DFC RAIL LEVEL (PRL)	264.426	264.439	264.453	264.466	264.479	264.492	264.505	264.518	264.531	264.545	264.558	264.571	264.584
EXG.RAIL LEVEL OF NEAREST IR UP MAIN LINE(ERL)	264.281	264.292	264.300	264.305	264.319	264.324	264.323	264.321	264.314	264.326	264.336	264.316	264.301
EQUIVALENT CHAINAGE ON DFC TRACK	1234637.3	1234657.3	1234677.3	1234697.4	1234717.3	1234737.4	1234757.4	1234777.4	1234797.5	1234817.5	1234837.4	1234857.5	1234877.5

L - SECTION

DRG NO.- 301-2/AL/A/1313

NOTE:-

1. DFCC WORKS ARE SHOWN IN RED.
2. IR NEW WORKS ARE SHOWN IN VIOLET.
3. ALL DIMENSIONS ARE SHOWN IN METRES.
4. THIS DRAWING IS PREPARED BASED ON LATEST SURVEY DATA HELD ON APRIL-2022. GTS BENCH MARK OF 261.850M CONSIDERED ON TOP OF CANAL BRIDGE ABUTMENT AT DORAHA VILLAGE ALONG THE NH1.
5. DFC NEW CHAINAGE OF 1075.950M IS WITH REFERENCE TO THE IR KM OF 187.500KM END OF KM OF CP-303(SECTION P-3 PILKHANI END) AGAINST THE EXISTING DFC CHAINAGE. 116277.742M ISSUED VIDE LETTER NO. CGM/DFCC/UMB/SURVEY/2021-301-230116-011173 DT. 17.01.2023
6. BALLAST PROFILE HAS BEEN PROVIDED ACCORDING TO THE CLAUSE 1.11.3 OF STANDARD SCHEDULE OF DIMESION(EASTERN CORRIDOR) & THE BALLAST CUSHION DIMESION SHOWN IN 35CM ON GE-14 PARA 17. SPECIFICATIONS & RECOMMENDATIONS 2. TWO LAYER SYSTEM FIG.10.


REFERENCE DRAWINGS :-

1. FOR KEY PLAN REFER DRAWING NO. 301-2/AL/0001
2. FOR LEGEND AND ABBREVIATIONS REFER DRAWING NO. 301-2/AL1000
3. FOR TYPICAL SECTION OF BALLAST PROFILE (FL-RL) REFFER DRG. NO. 301-2/TK/TFD/-004 (TR.1952)

REV.	DATE	REVISION DETAILS	PURPOSE OF ISSUE
0	10.10.2024	SUBMISSION OF AS-BUILT DRAWING	FOR APPROVAL

SCALE
HOR - 1:1000 (0, 10, 20, 30, 40m)
VER - 1:100 (0, 1, 2, 3, 4m)
SHEET SIZE : A1

LEGEND:
IR TRACK
DFCC TRACK
DFCC FUTURE PROPOSALS
STRUCTURE / BUILDING
DFCC TOE LINE
DFCC FORMATION
RETAINING WALL
ROAD
STREAM, DRAIN, NALA, CANAL.
FENCE
POWER LINES
TBM
ELECTRIC POLE/OHE MAST
IR RAILWAY BOUNDARY
DFCC BOUNDARY

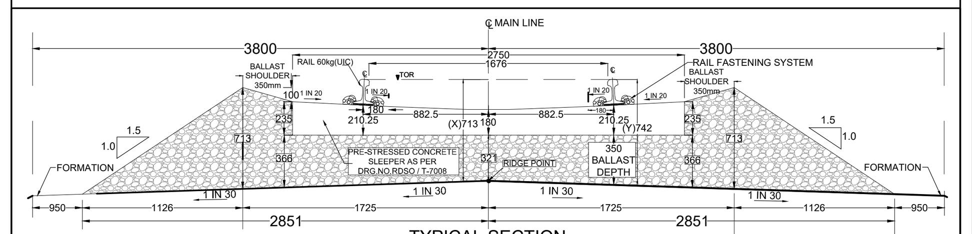

TYPICAL SECTION

TRACK STRUCTURE		
RAIL SECTION: 60Kg/m (UIC 60Kg/m) DFC LINE: 60Kg/m (UIC 60Kg/m) IR MAIN LINE:52Kg/m	Difference between FL- RL (Below Rail Seat)	
	IR Line	DFC
	172mm	172mm
RUBBER PAD	6mm	10mm
SLEEPER DEPTH	210mm	210mm
BALLAST CUSHION	300mm	350mm
Total Depth (FL TO RL)	688mm	742mm

OWNER
DEDICATED FREIGHT CORRIDOR CORPORATION OF INDIA LTD.
(A GOVERNMENT OF INDIA ENTERPRISE)
PROJECT OFFICE(AMBALA UNIT): OLD RAILWAY COLONY (NEAR ANAND MARKET),AMBALA CANTT-133001.
CORPORATE IDENTITY NO. : U60232DL2006GOI155068

ENGINEER:
DB Engineering & Consulting GmbH
Deutsche Bahn Engineering & Consulting GmbH

CONTRACTOR:
GIL - TPL JV

SUBMITTED BY	GIL - TPL JV		
	DATED	NAME	SIGNATURE
PREPARED BY			
CHECKED BY	10.10.2024	VIJAY PRATAP	
APPROVED BY	10.10.2024	PARASURAM KOTYADA	

APPROVED BY	DEUTSCHE BAHN ENGINEERING & CONSULTING GMBH		
	DATED	NAME	SIGNATURE
Sr. DE./CHIEF ENGINEER		SURESH K.YALANGI	
CHIEF TRACK ENGINEER		RAJ PAL SINGH	
T.L.		H.D. VIDJAK	

STAMP
A — AS-BUILT DRAWING
TR. Ref.......................
ENGINEER Sign.:

EMPLOYER (DFCCIL): DEDICATED FREIGHT CORRIDOR CORPORATION OF INDIA LTD.

AS BUILT DRAWING

TITLE
AS-BUILT PLAN AND PROFILE
FROM IR KM: 343.500 TO 344.000
FROM DFC KM: 1234.377 to 1234.877

DFCC APPR. NO. -
ENGG. APPR. NO. -
DRG. NO. -301-2/AL/A/1313
SHEET NO. : 1 OF 1
DATE : 10.10.2024
STATUS A

TR.